

PANELBOARD TAG:
PNL.X###
PCS EQUIPMENT ID
H: 277/480V; L:120/240V
PANELBOARD

- KEYED NOTES:
1. ALL EQUIPMENT, COMPONENTS AND DEVICES SHOWN WITHIN THIS DASHED LINE ARE PROVIDED WITH, AND INTEGRAL TO, THE INVERTER.
 2. SIZE DETERMINED BY MANUFACTURER.
 3. REFER TO E-500 FOR MET STATION LOCATIONS AT PCS201, PCS203, PCS307, PCS502, PCS507, PCS704, PCS1105, PCS1308, AND PCS1407.

- NOTES:
- A. PROVIDE BRANCH CIRCUITING AND ASSOCIATED TERMINATIONS SHOWN ON THIS DRAWING.

FastGrid, LLC
225 E Germann Road
Suite 301
Gilbert, AZ 85297

REV	DESCRIPTION	DATE
4	RECORD DRAWINGS	06/08/2023

PROJECT NAME:

EAGLE SHADOW MOUNTAIN
PV SOLAR POWER
GENERATION FACILITY

PROJECT ADDRESS:

I-15
CRYSTAL, NV
CLARK COUNTY

SEAL:

DATE:
10/16/2020

PROJECT #:
190067.03

DRAWN BY:
NK

CHECKED BY:
EL








SHEET NAME:

LV WIRING DIAGRAM

SHEET #:
E-280

REV #:
4

RECORD DRAWING

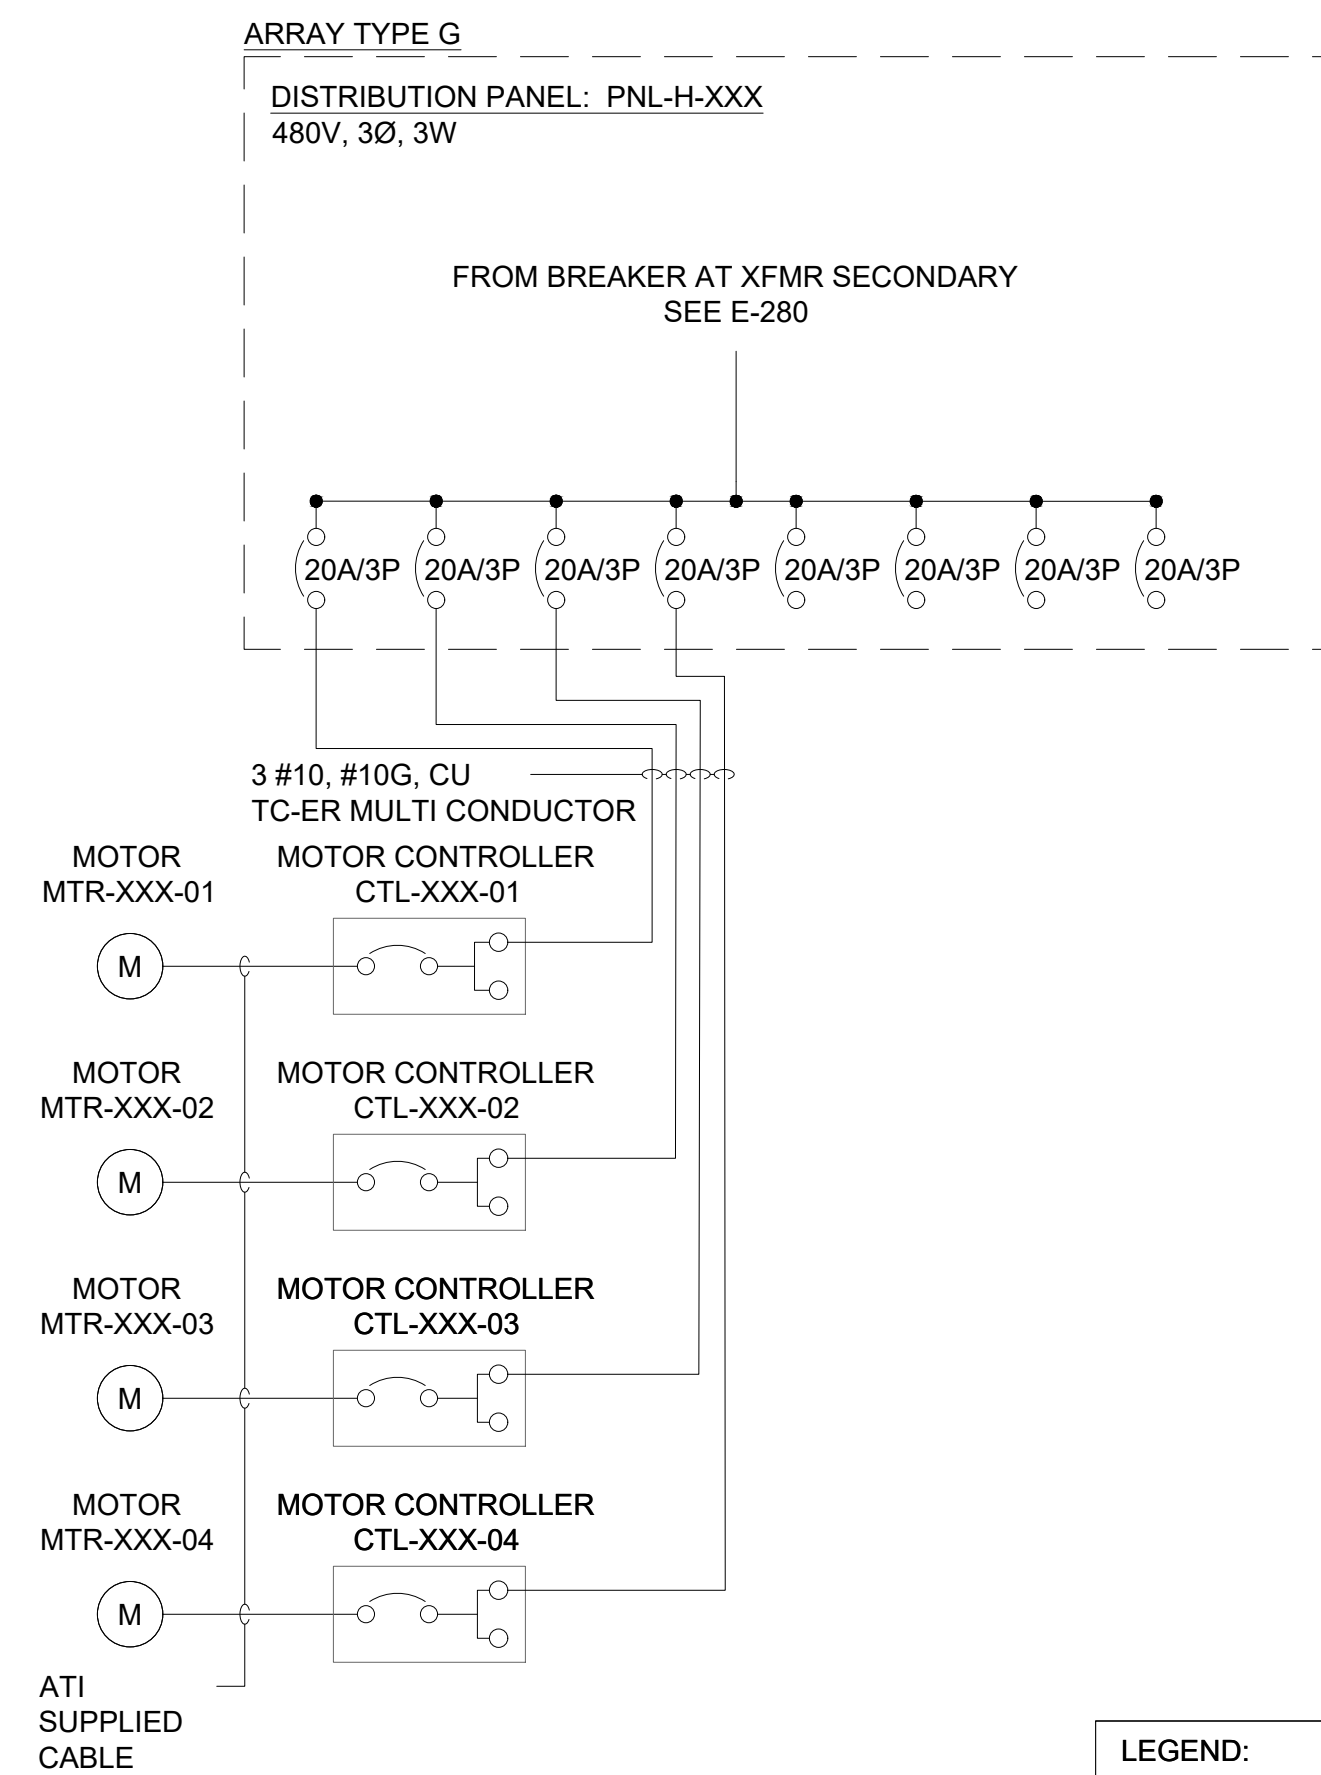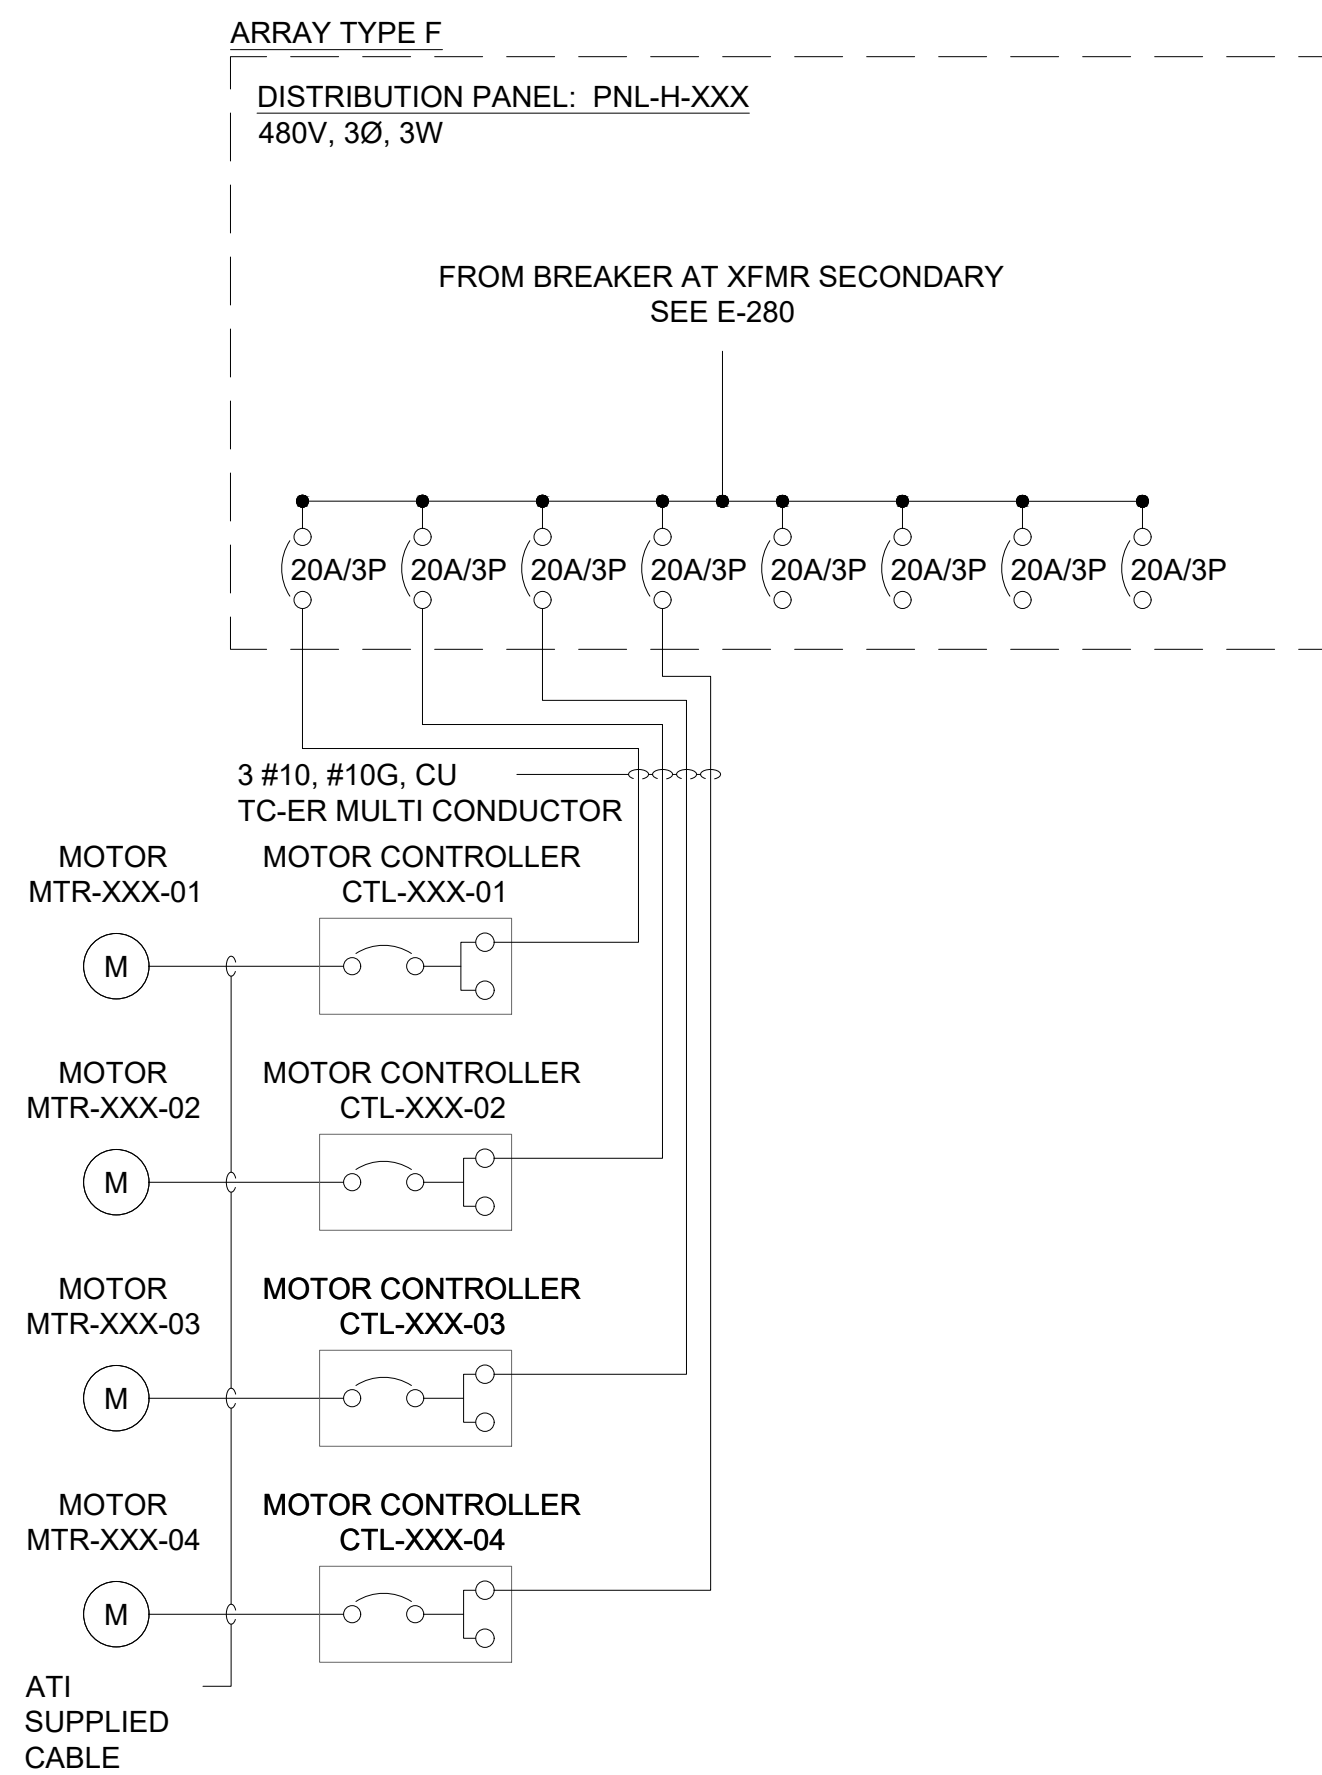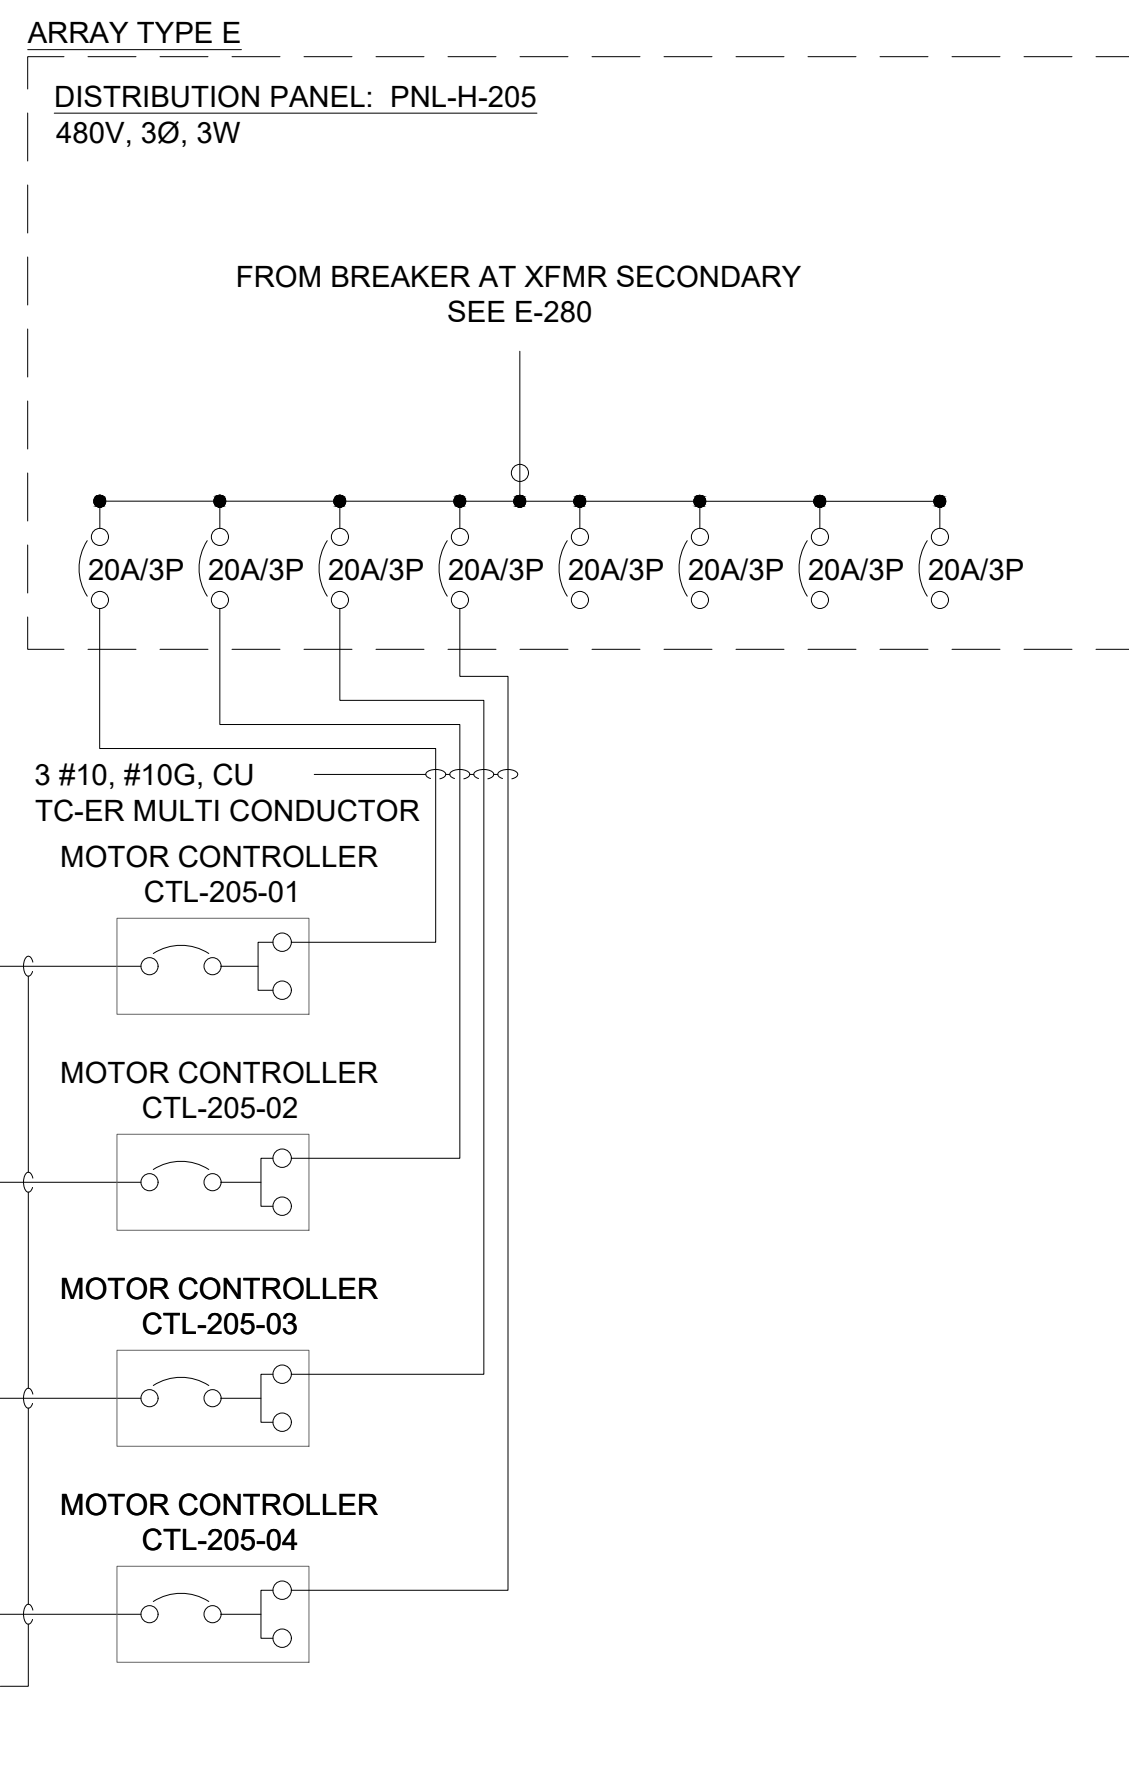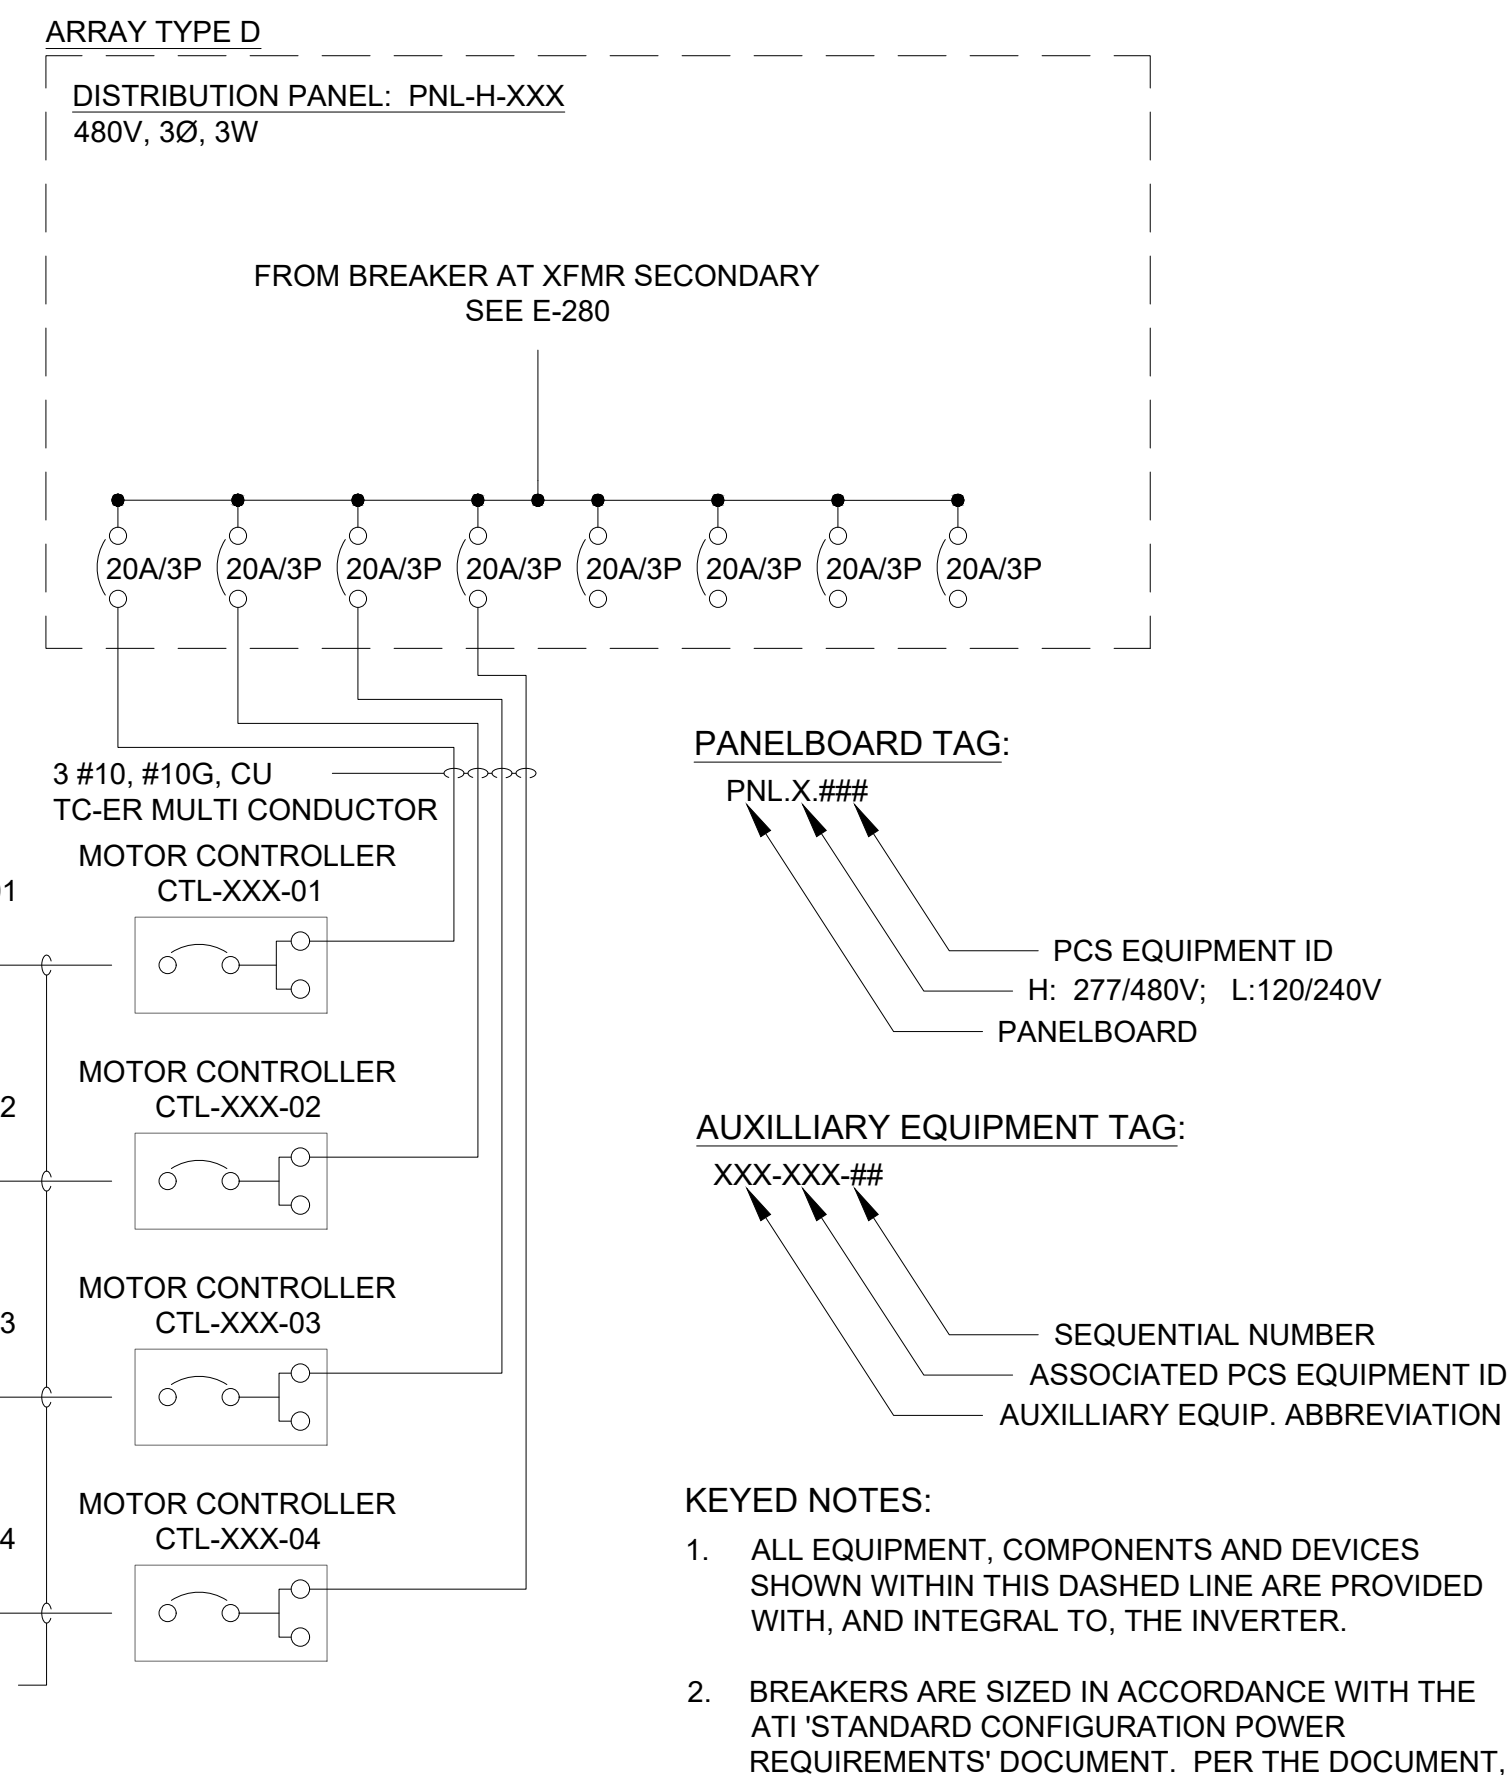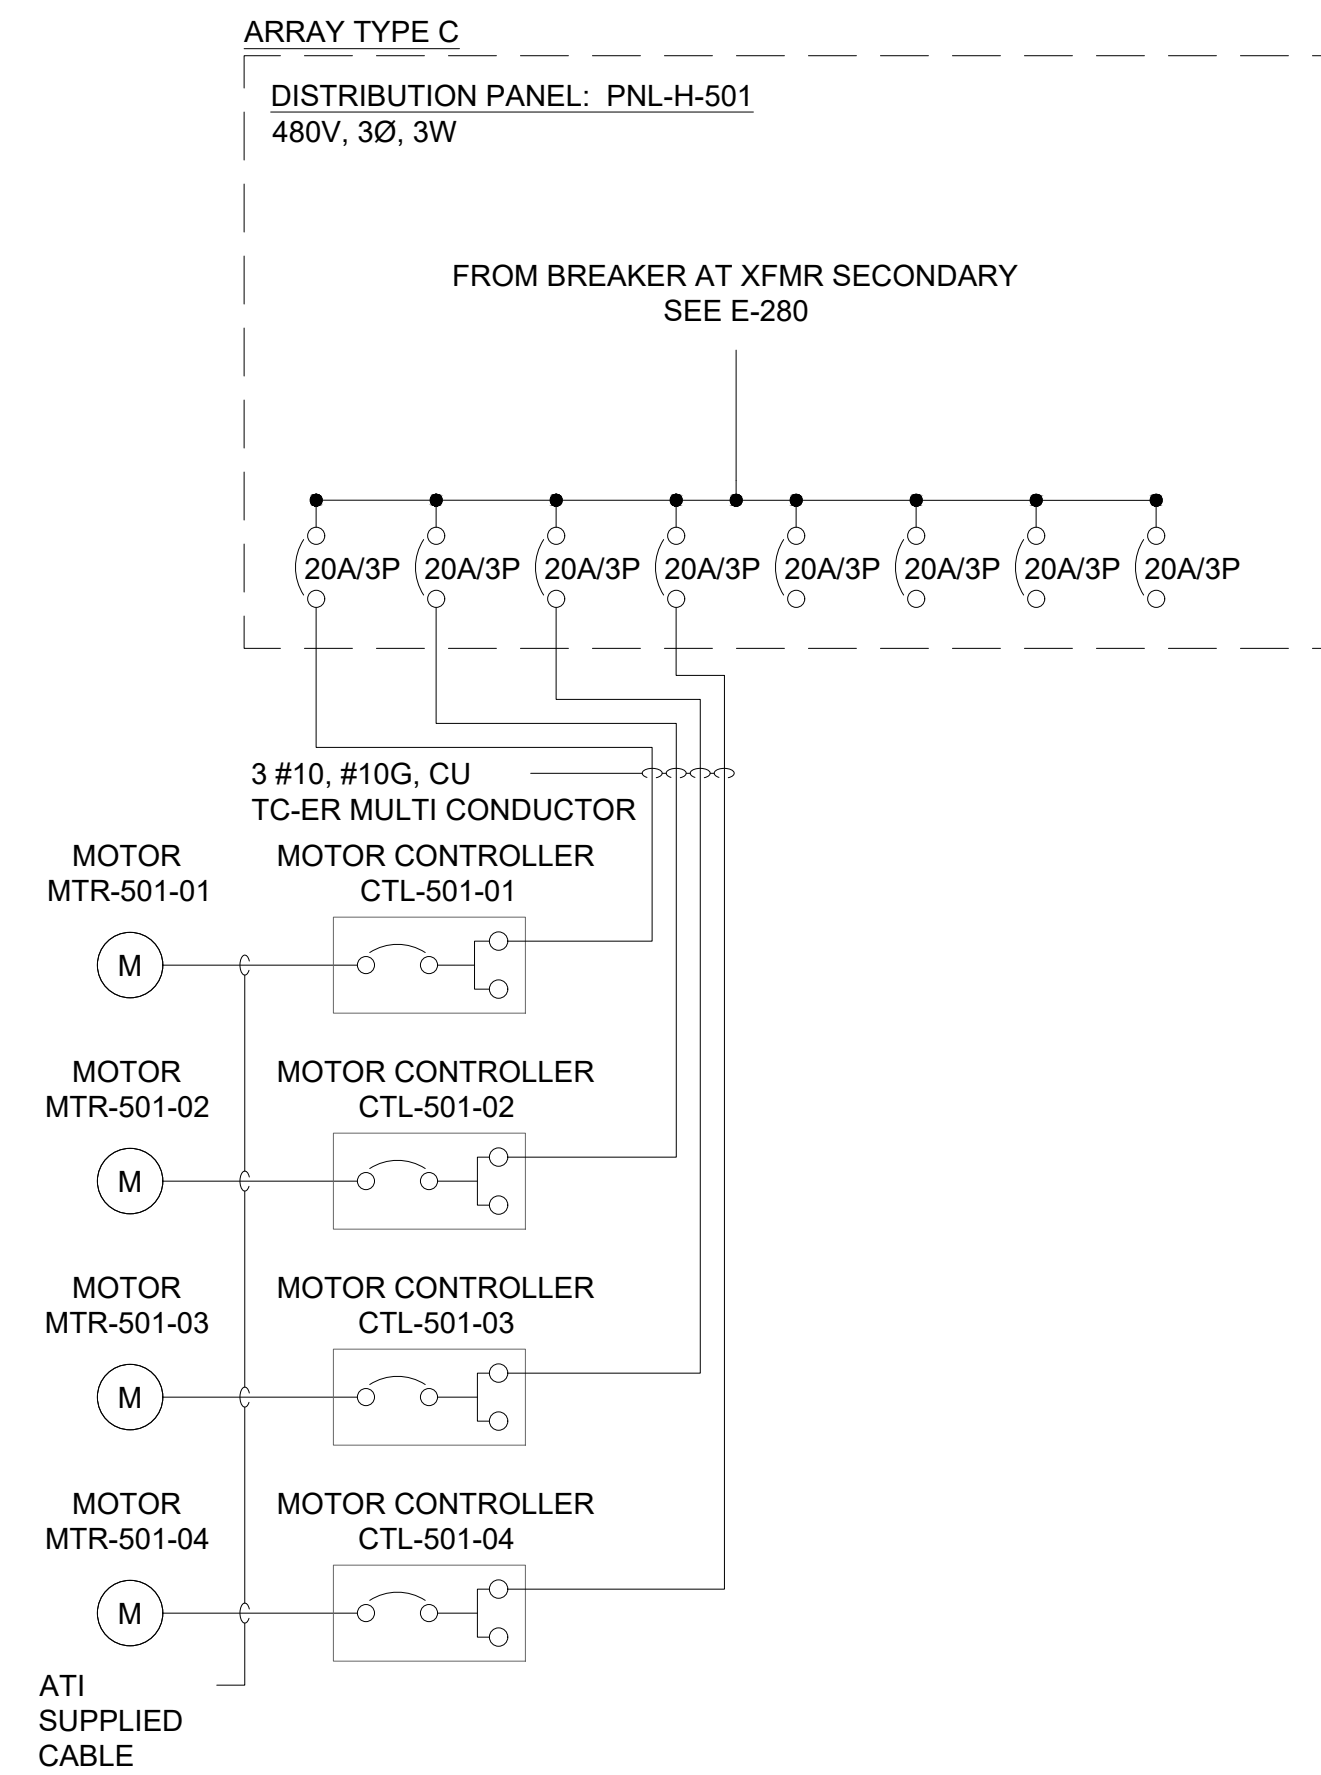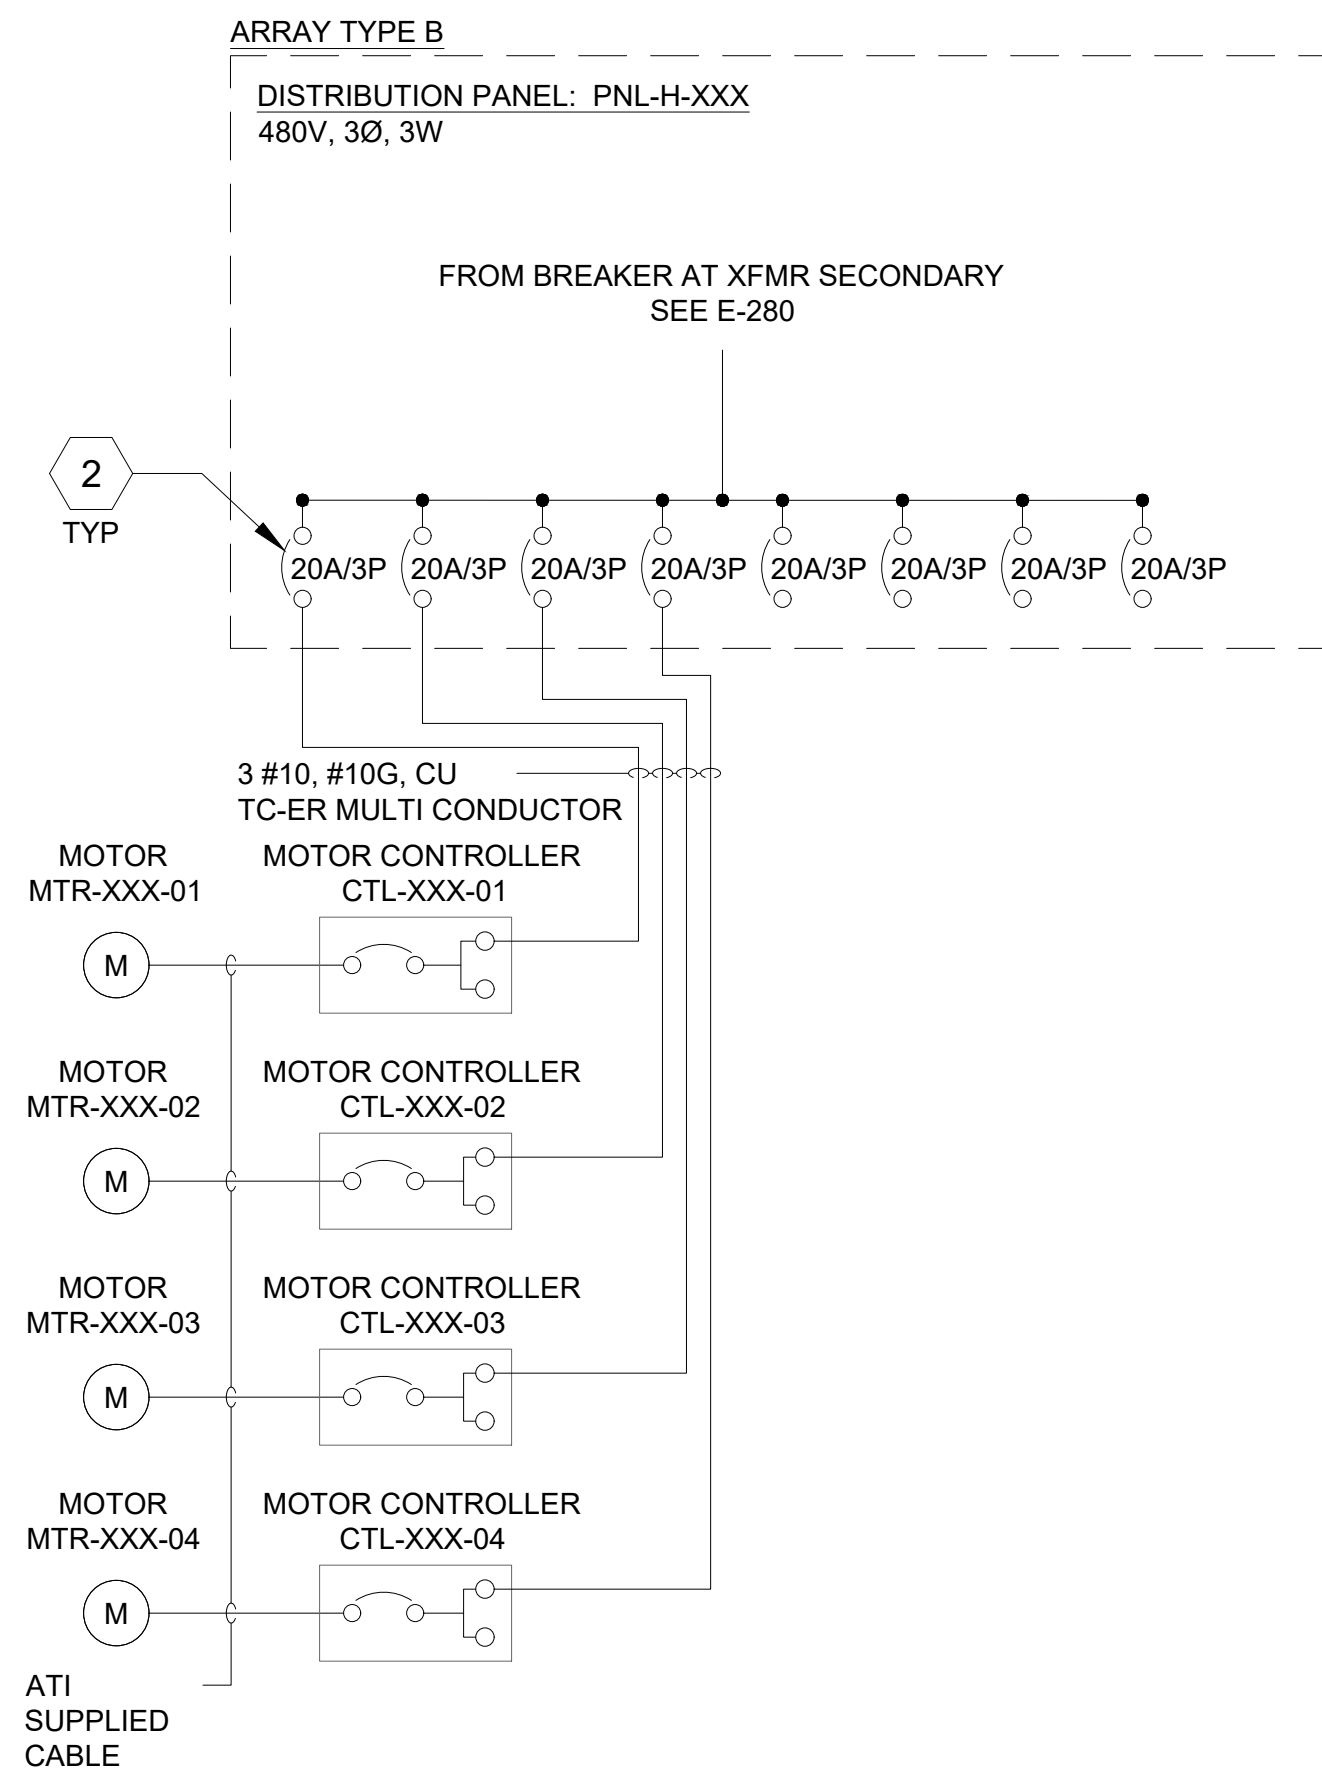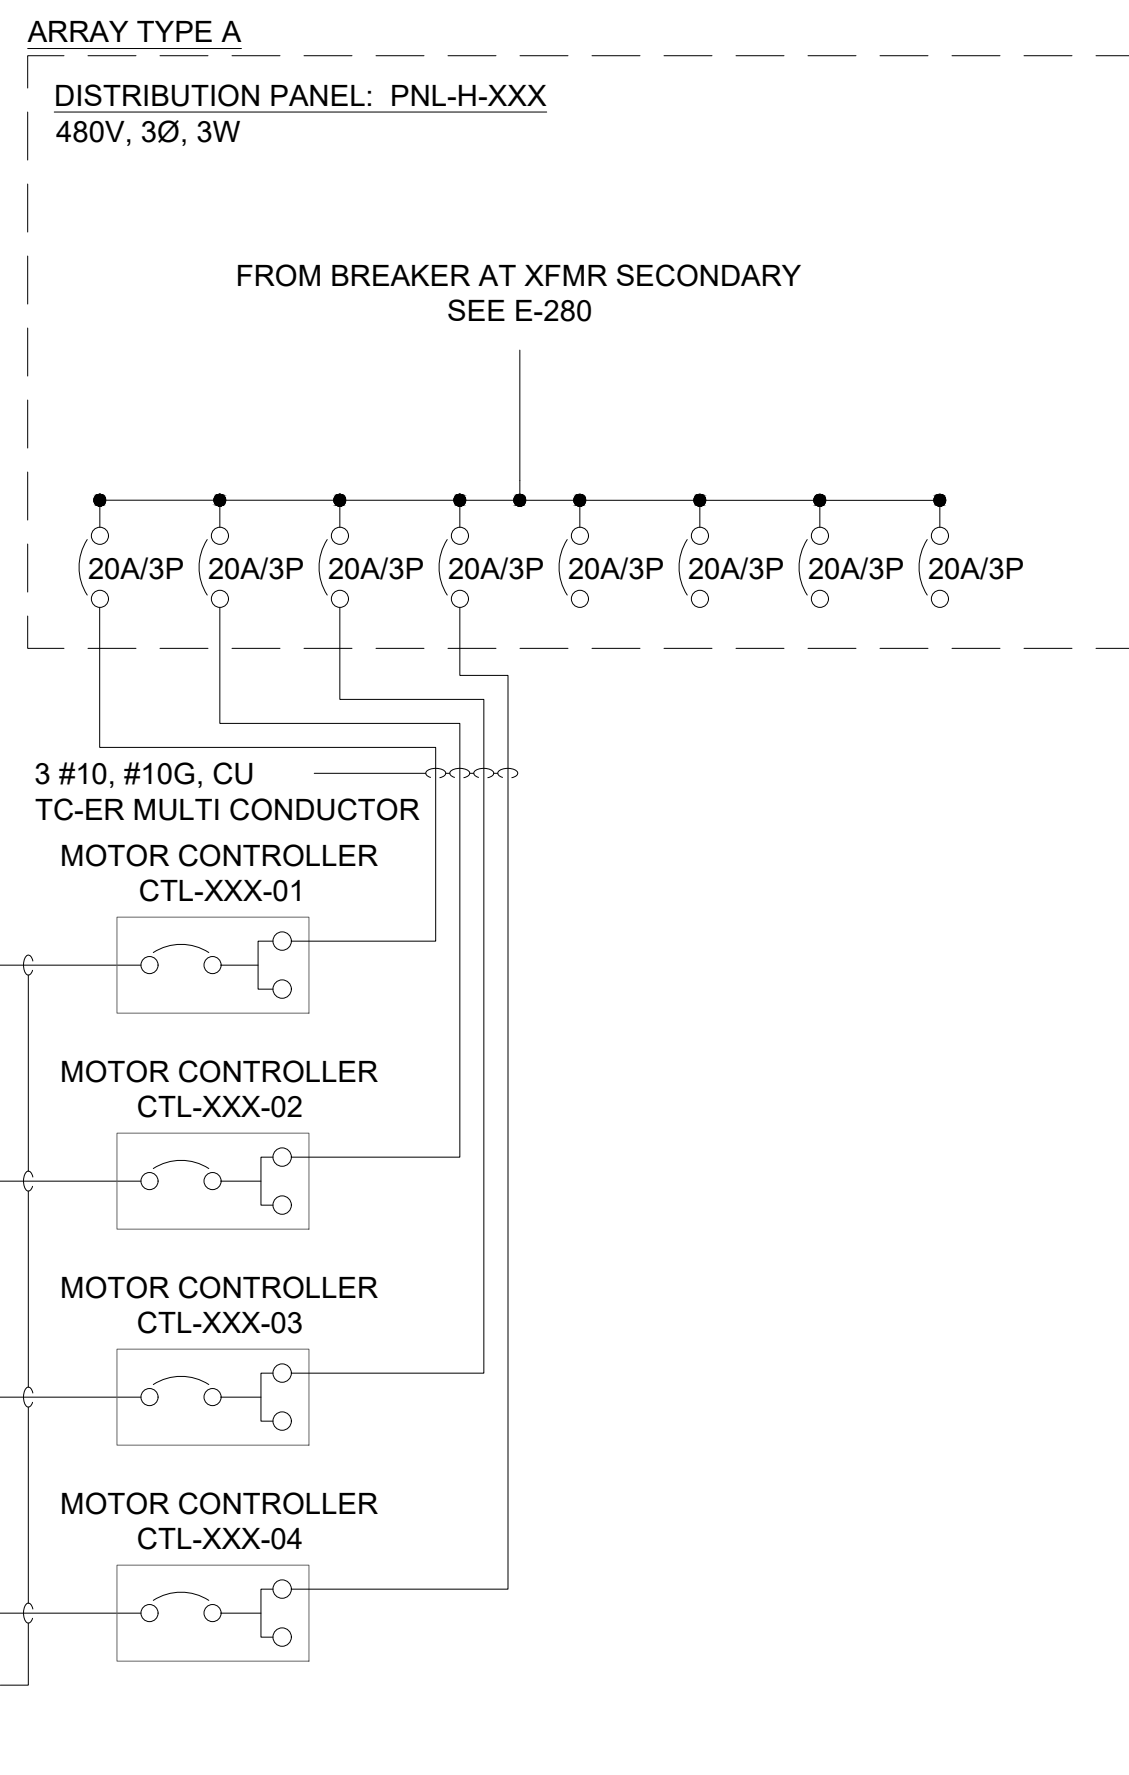

ARRAY TYPE	ASSOCIATED PCS
A	PCS104 PCS105 PCS106 PCS107 PCS201 PCS207 PCS301 PCS302 PCS303 PCS304 PCS401 PCS402 PCS403 PCS404 PCS405 PCS406 PCS502 PCS503 PCS504 PCS505 PCS506
B	PCS204 PCS507
C	PCS501
D	PCS202 PCS206
E	PCS205
F	PCS103 PCS907 PCS1007 PCS1101 PCS1102 PCS1103 PCS1104 PCS1106 PCS1107 PCS1108 PCS1201 PCS1202 PCS1204 PCS1205 PCS1206 PCS1207 PCS1301 PCS1302 PCS1303 PCS1304 PCS1306 PCS1307 PCS1402 PCS1404 PCS1405 PCS1406
G	PCS101 PCS906 PCS1203
H	PCS1208
I	PCS1305
J	PCS102 PCS1401
K	PCS1408
L	PCS1407
M	PCS1105
N	PCS604
O	PCS606
P	PCS607
Q	PCS1308
R	PCS305 PCS306 PCS307 PCS407 PCS705 PCS706 PCS707 PCS803 PCS804 PCS805 PCS806 PCS807 PCS902 PCS903 PCS904 PCS905 PCS1001 PCS1002 PCS1003 PCS1004 PCS1005
S	PCS1006
T	PCS802 PCS901
U	PCS203
V	PCS704
W	PCS701 PCS702 PCS703 PCS801
X	PCS601 PCS602 PCS603 PCS605
Y	PCS1403
Z	PCS1008

		FastGrid, LLC 225 E Germann Road Suite 301 Gilbert, AZ 85297
FastGrid		

REV	DESCRIPTION	DATE
4	RECORD DRAWINGS	06/08/2023

PROJECT NAME:

EAGLE SHADOW MOUNTAIN PV SOLAR POWER GENERATION FACILITY

PROJECT ADDRESS:

I-15 CRYSTAL, NV CLARK COUNTY

SEAL:	DATE: <div style="text-align: center; font-size: 1.2em;">10/16/2020</div>
	PROJECT #: <div style="text-align: center; font-size: 1.2em;">190067.03</div>
	DRAWN BY: <div style="text-align: center; font-size: 1.2em;">LR</div>
	CHECKED BY: <div style="text-align: center; font-size: 1.2em;">EL</div>

SHEET NAME:

TRACKER MOTOR SLD

SHEET #: E-290	REV #: <div style="text-align: center; font-size: 1.5em;">4</div>
---	--







AS BUILT T

LOCATION: K:\08 PROJECTS\180067 03 - PRIMORIS - EAGLE SHADOW MOI\IN\05 ENGINEERING\ADWG\IE-290 TRACKER MOTOR SLD

SAVED BY: areag looney





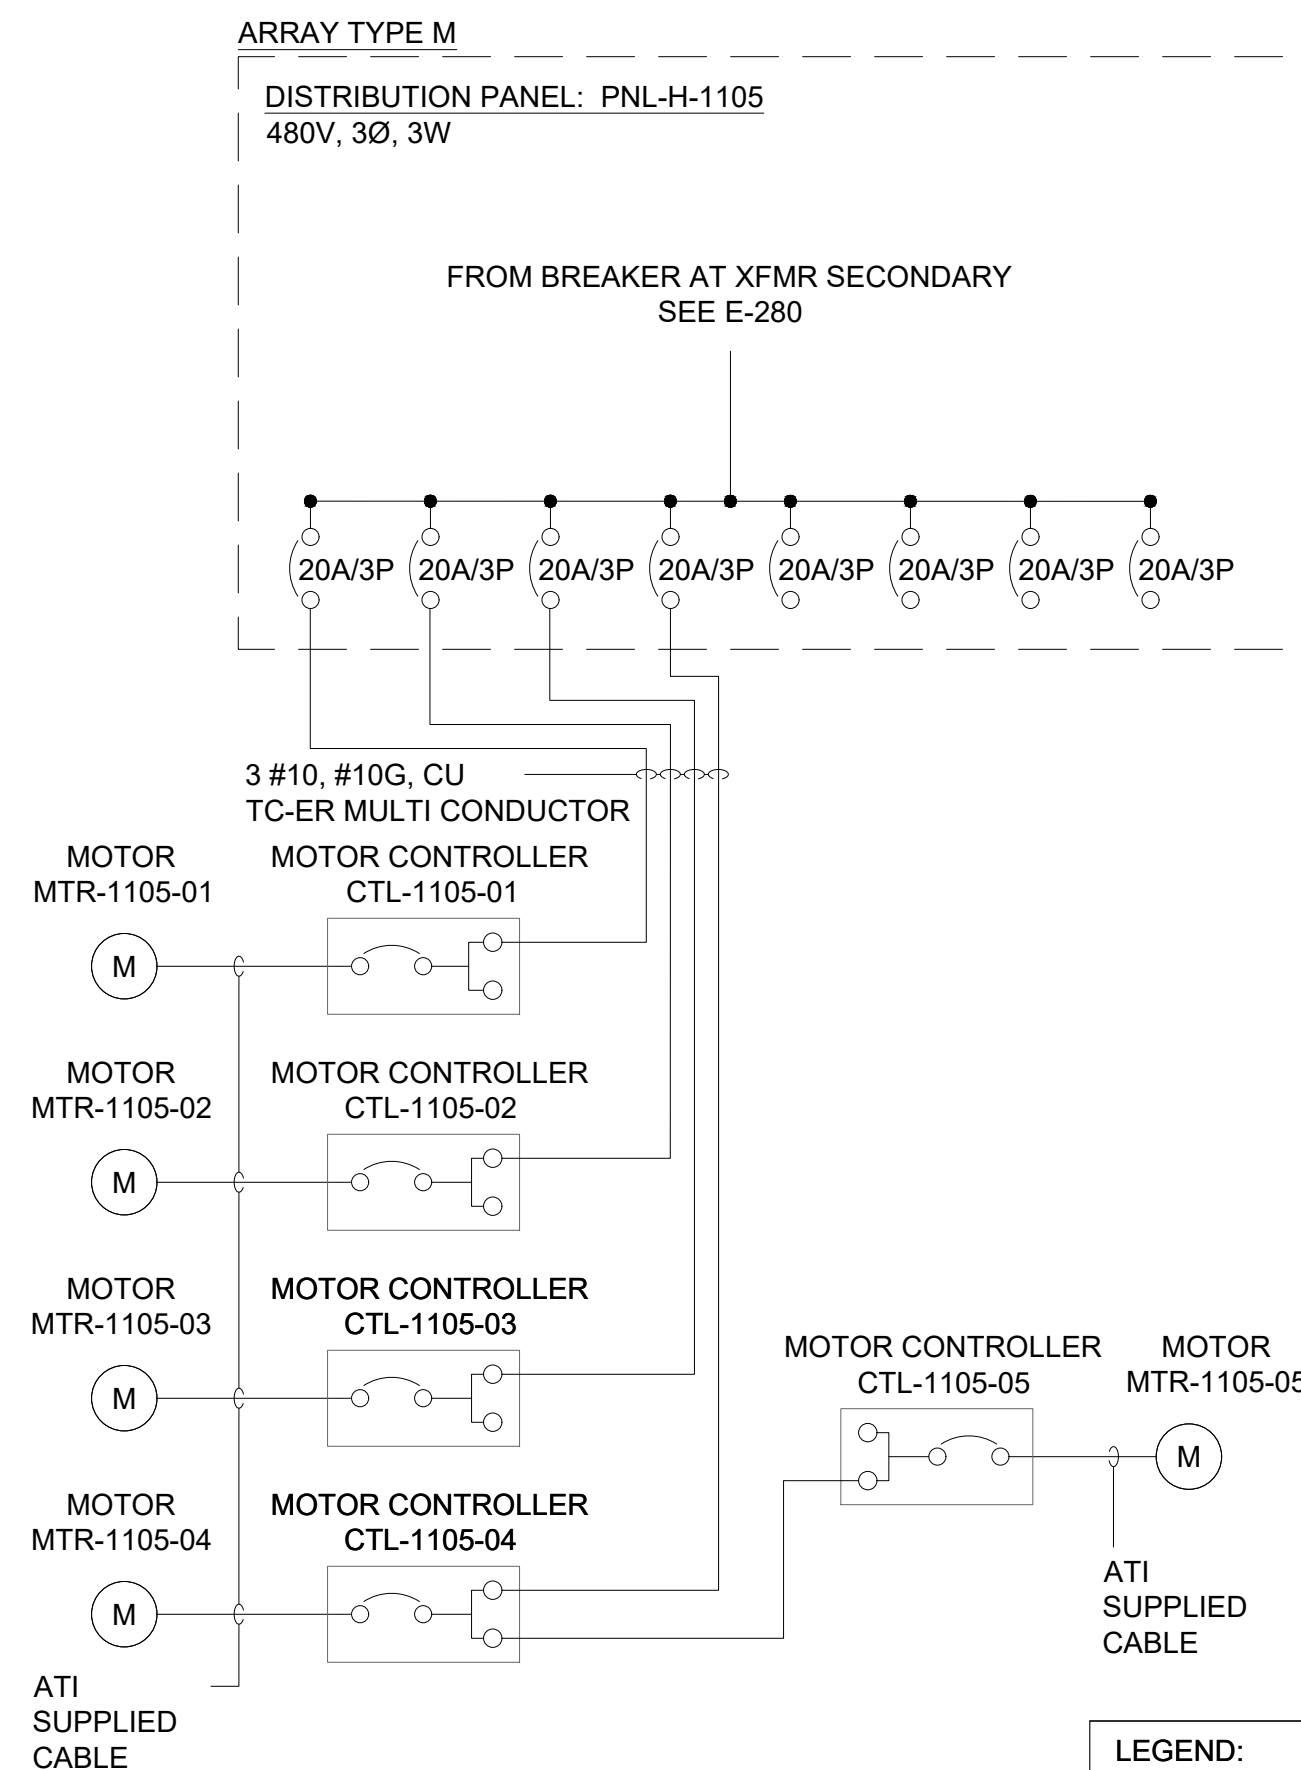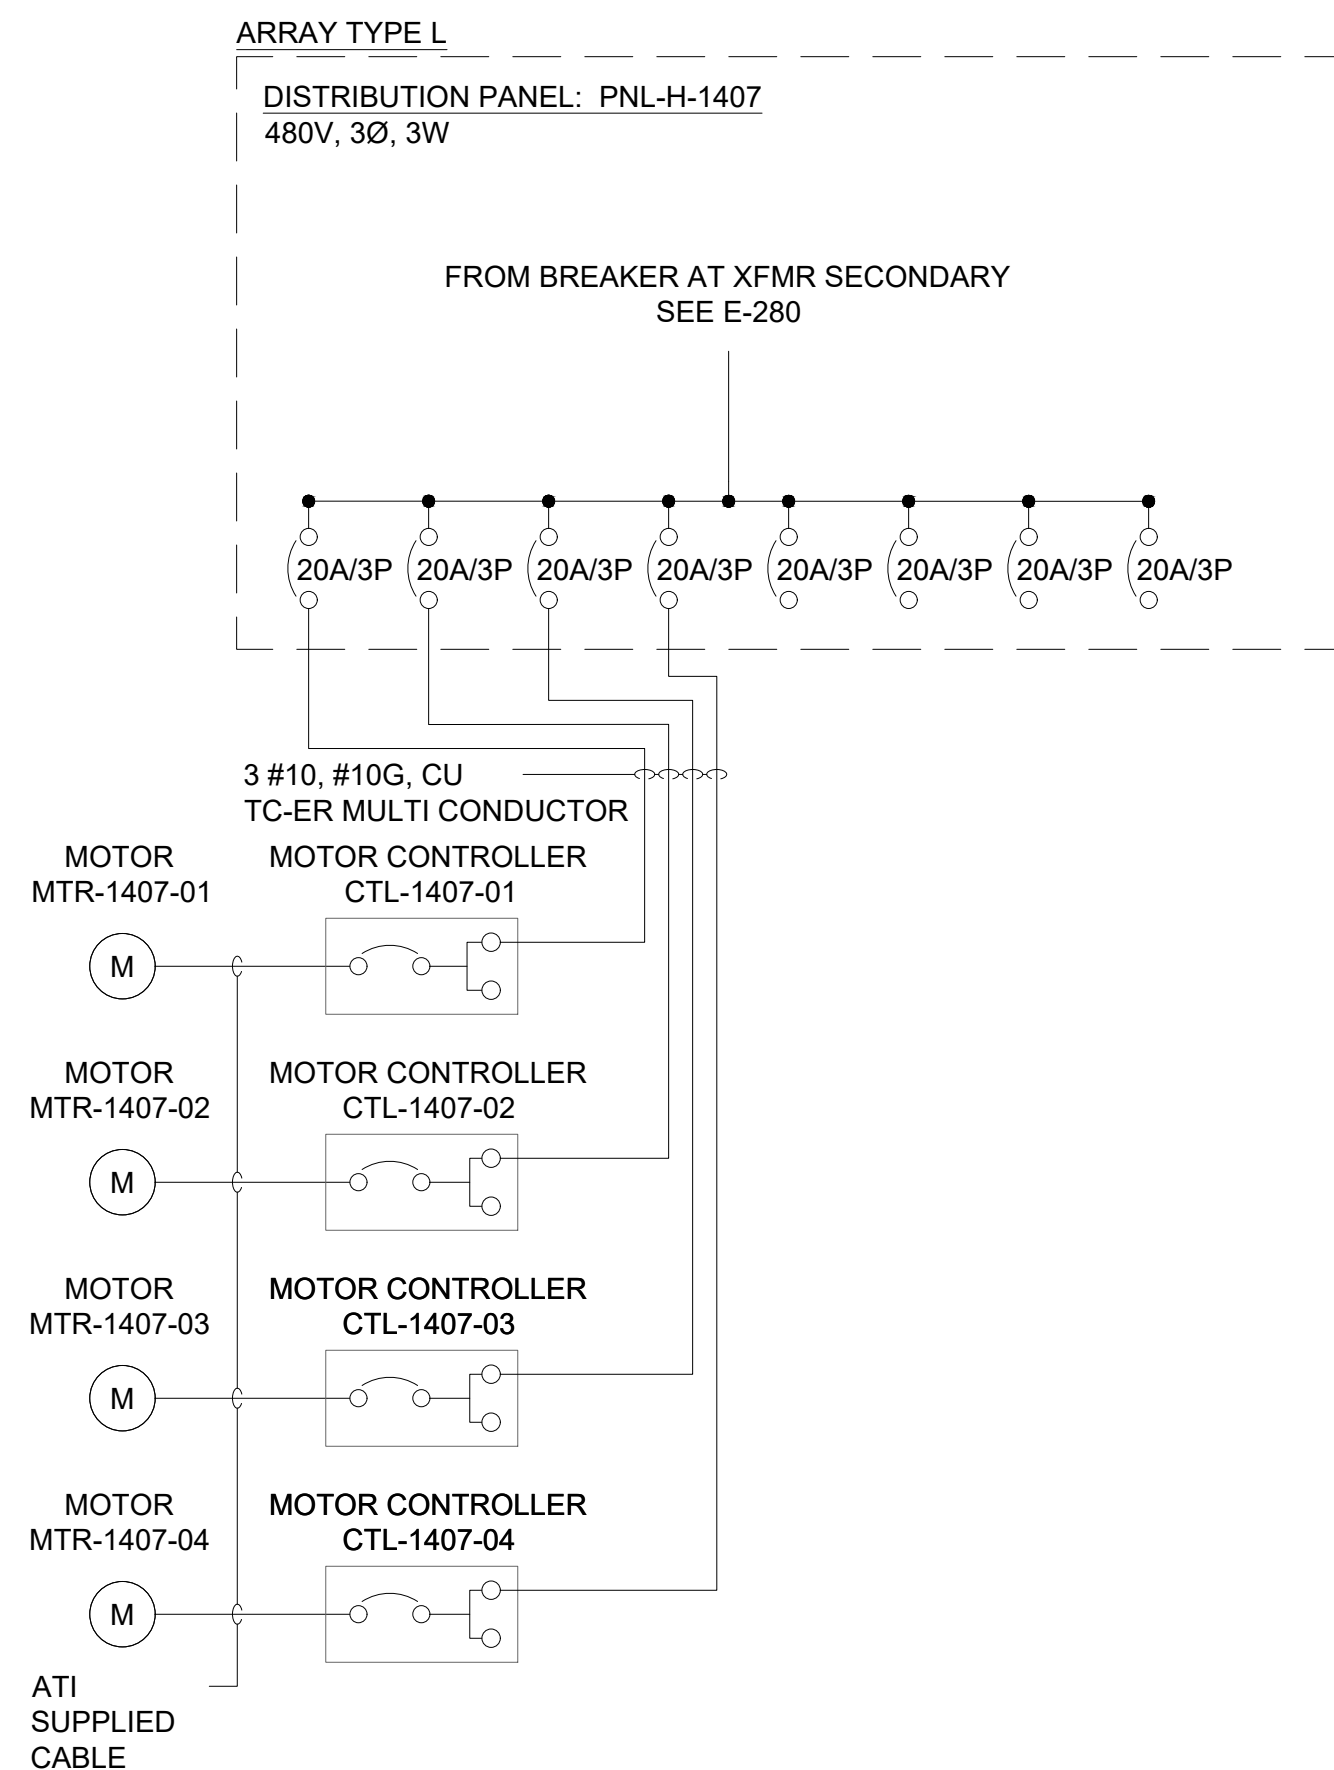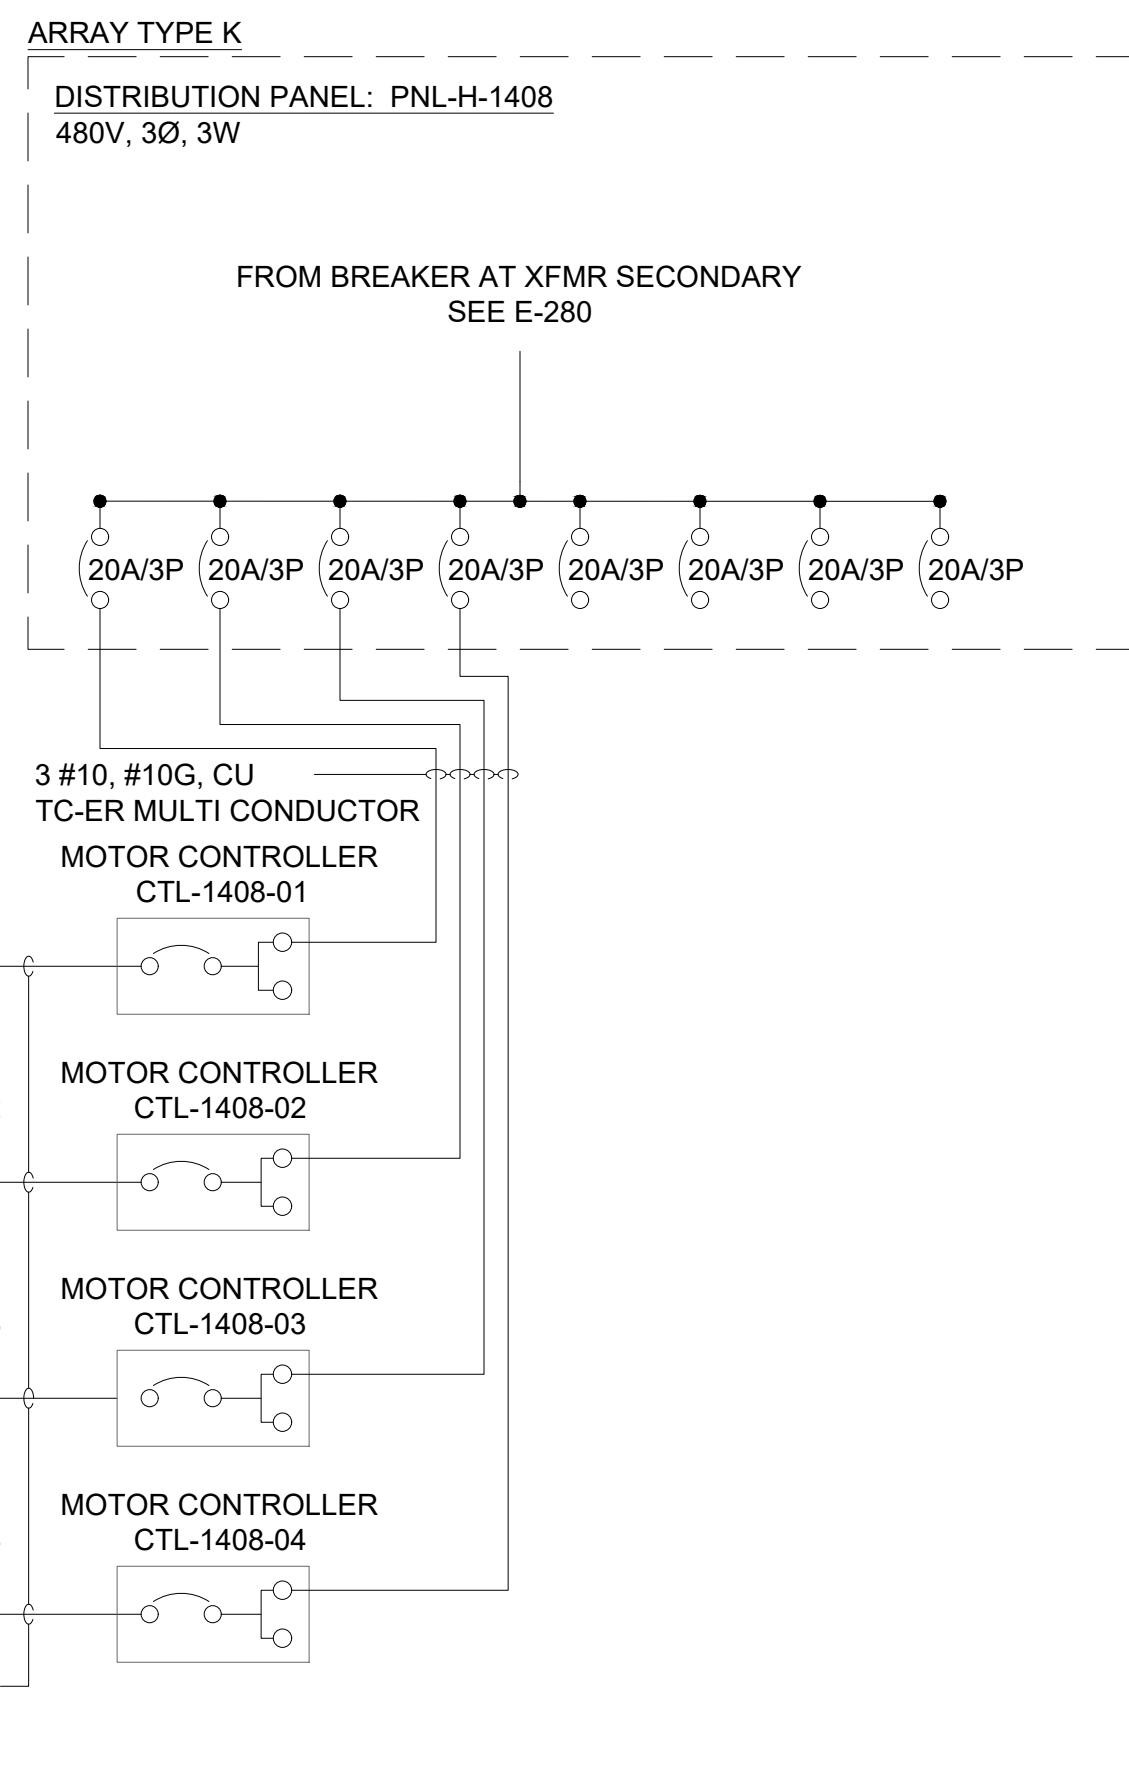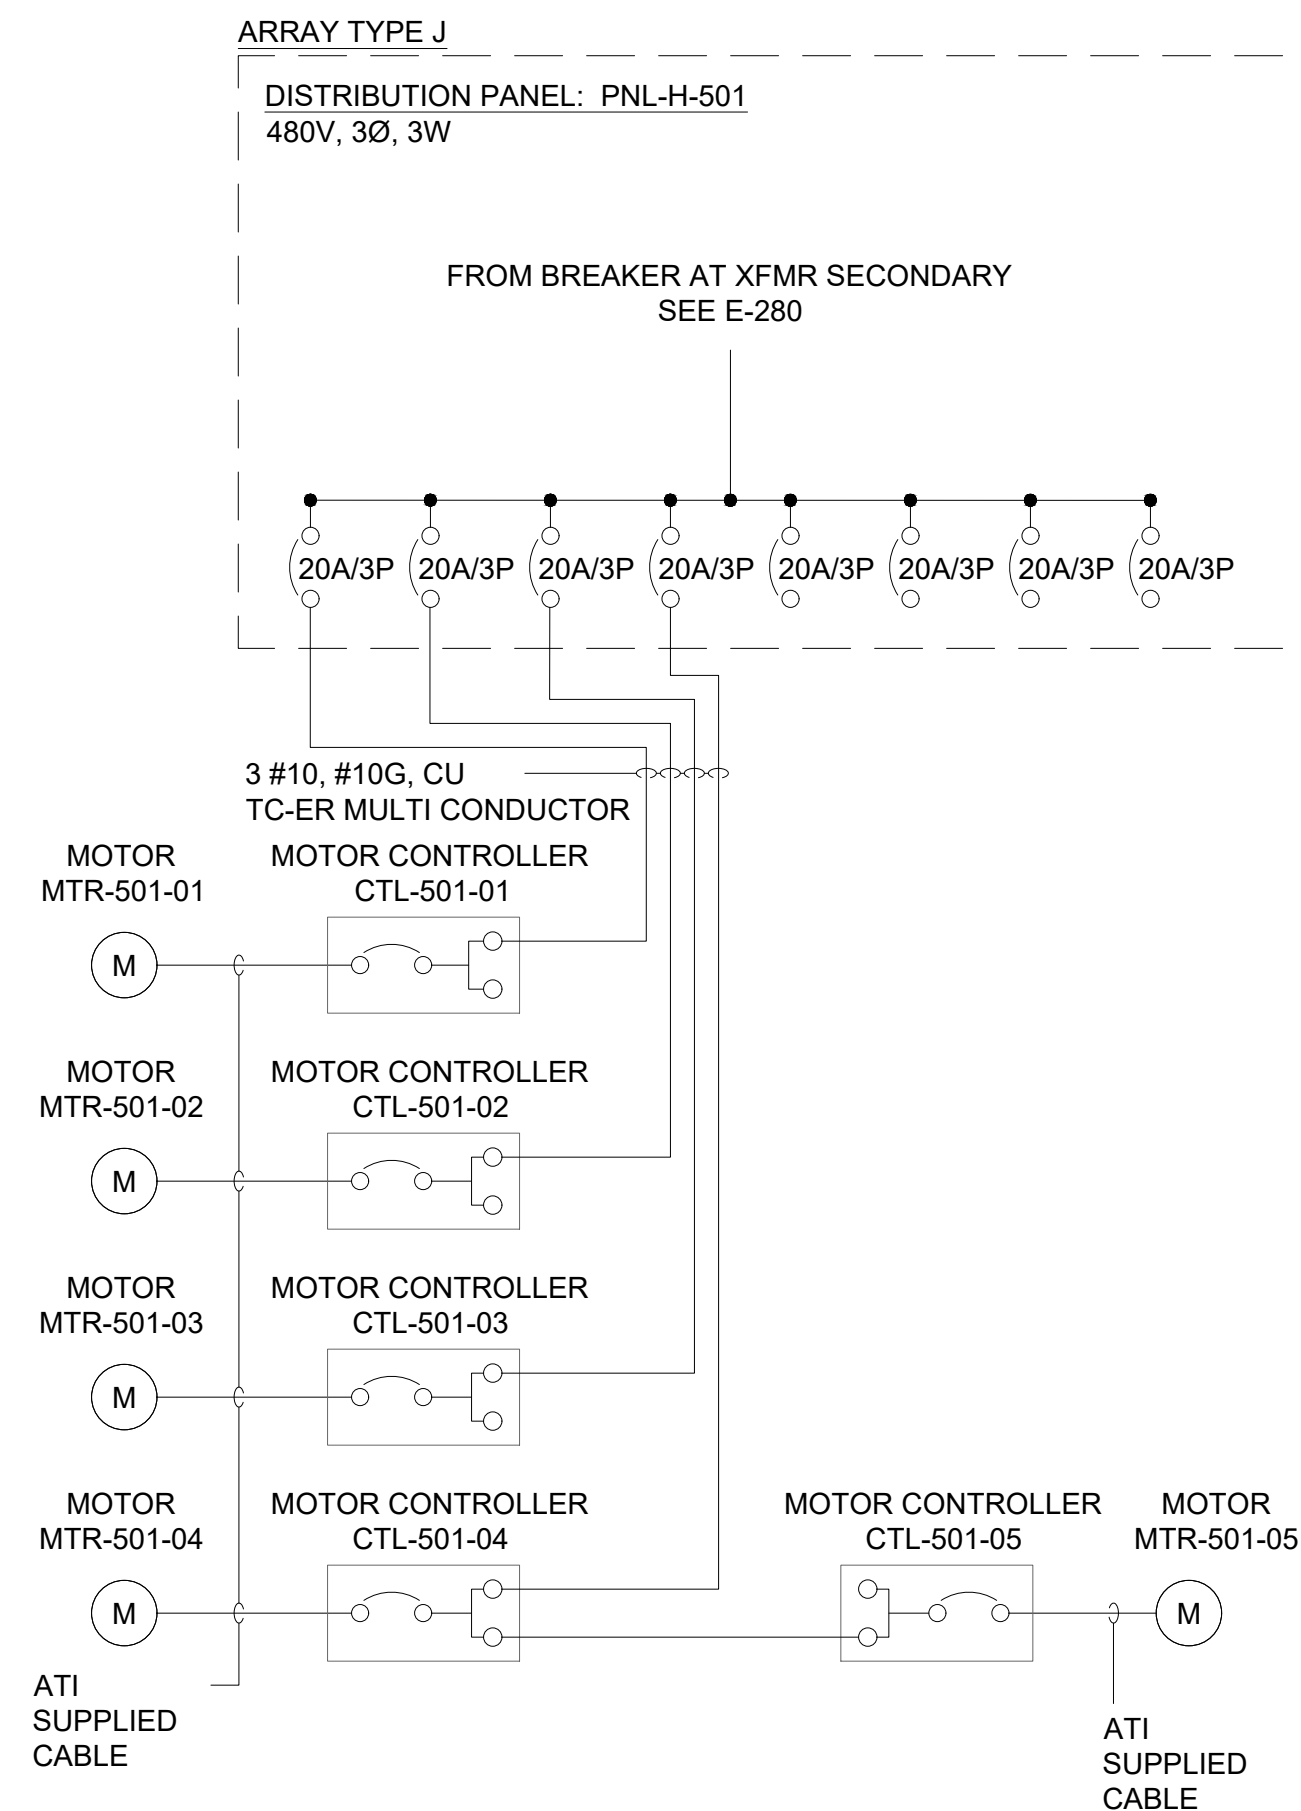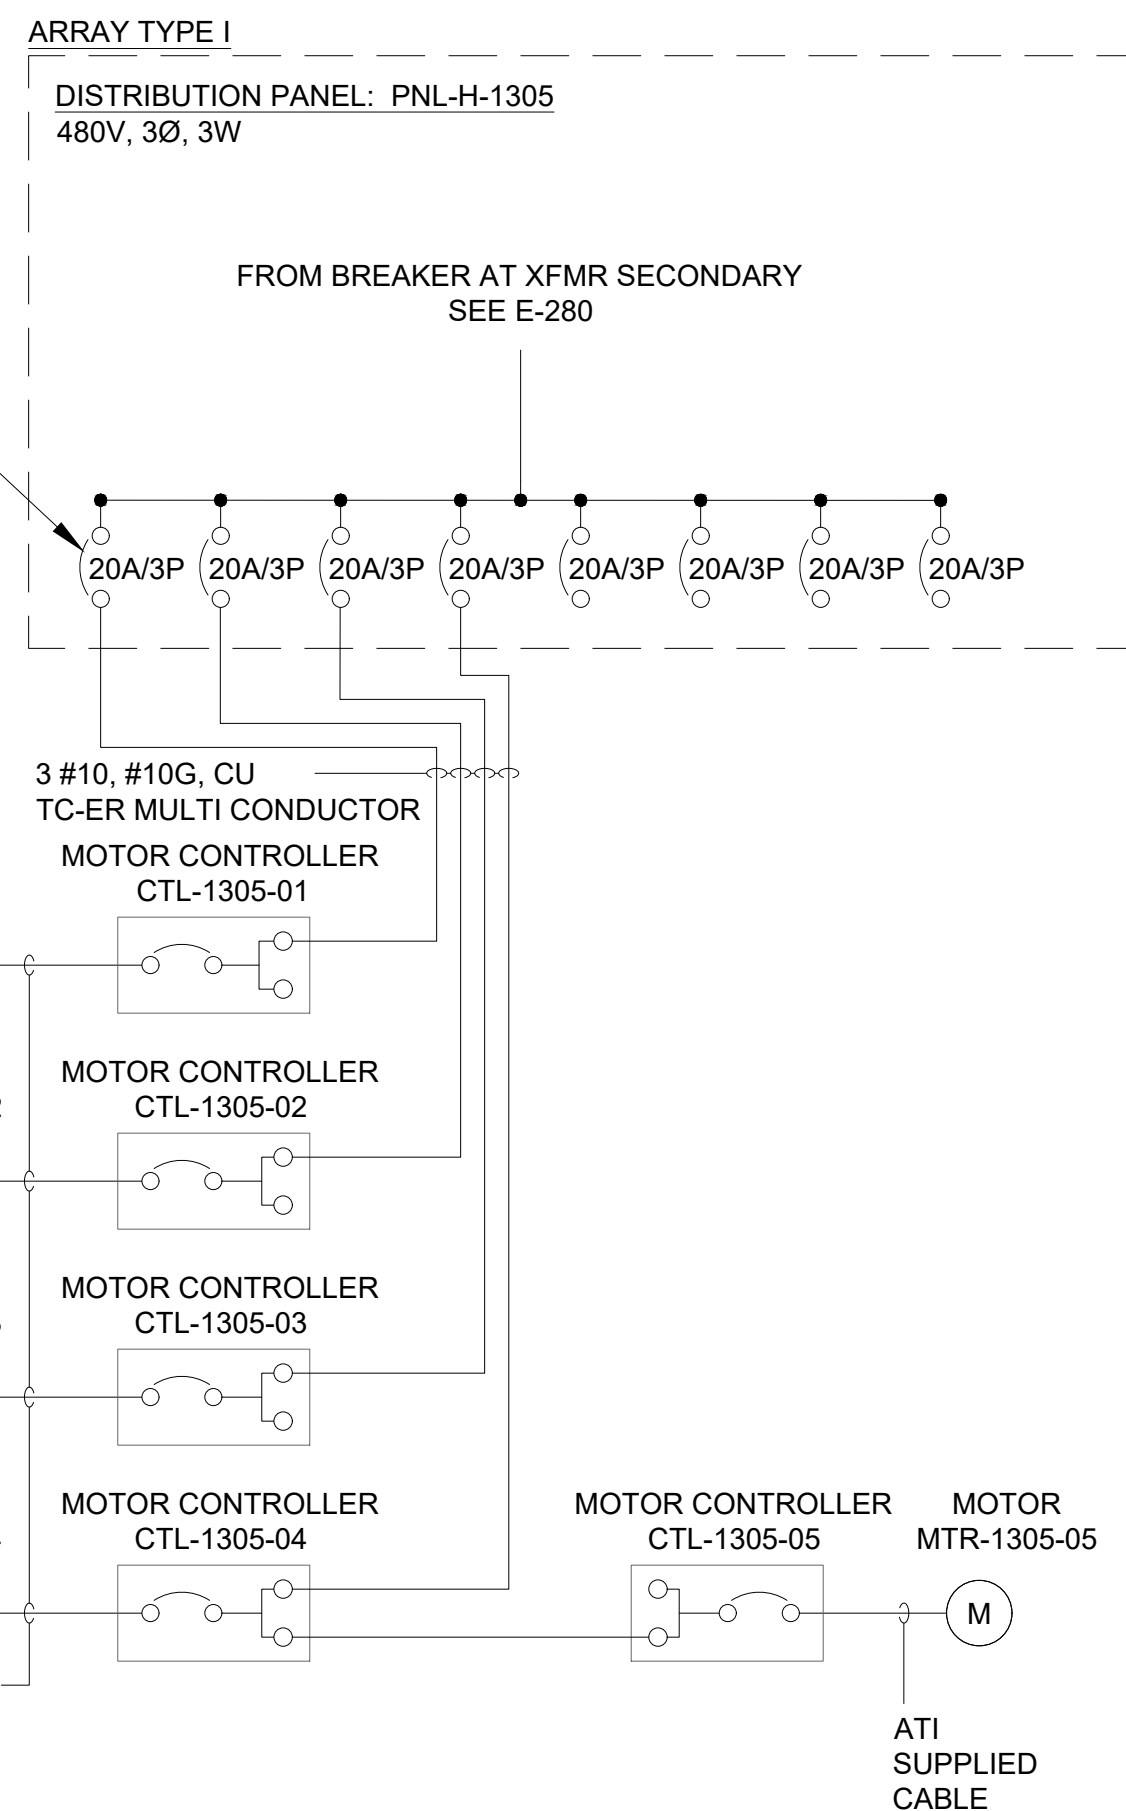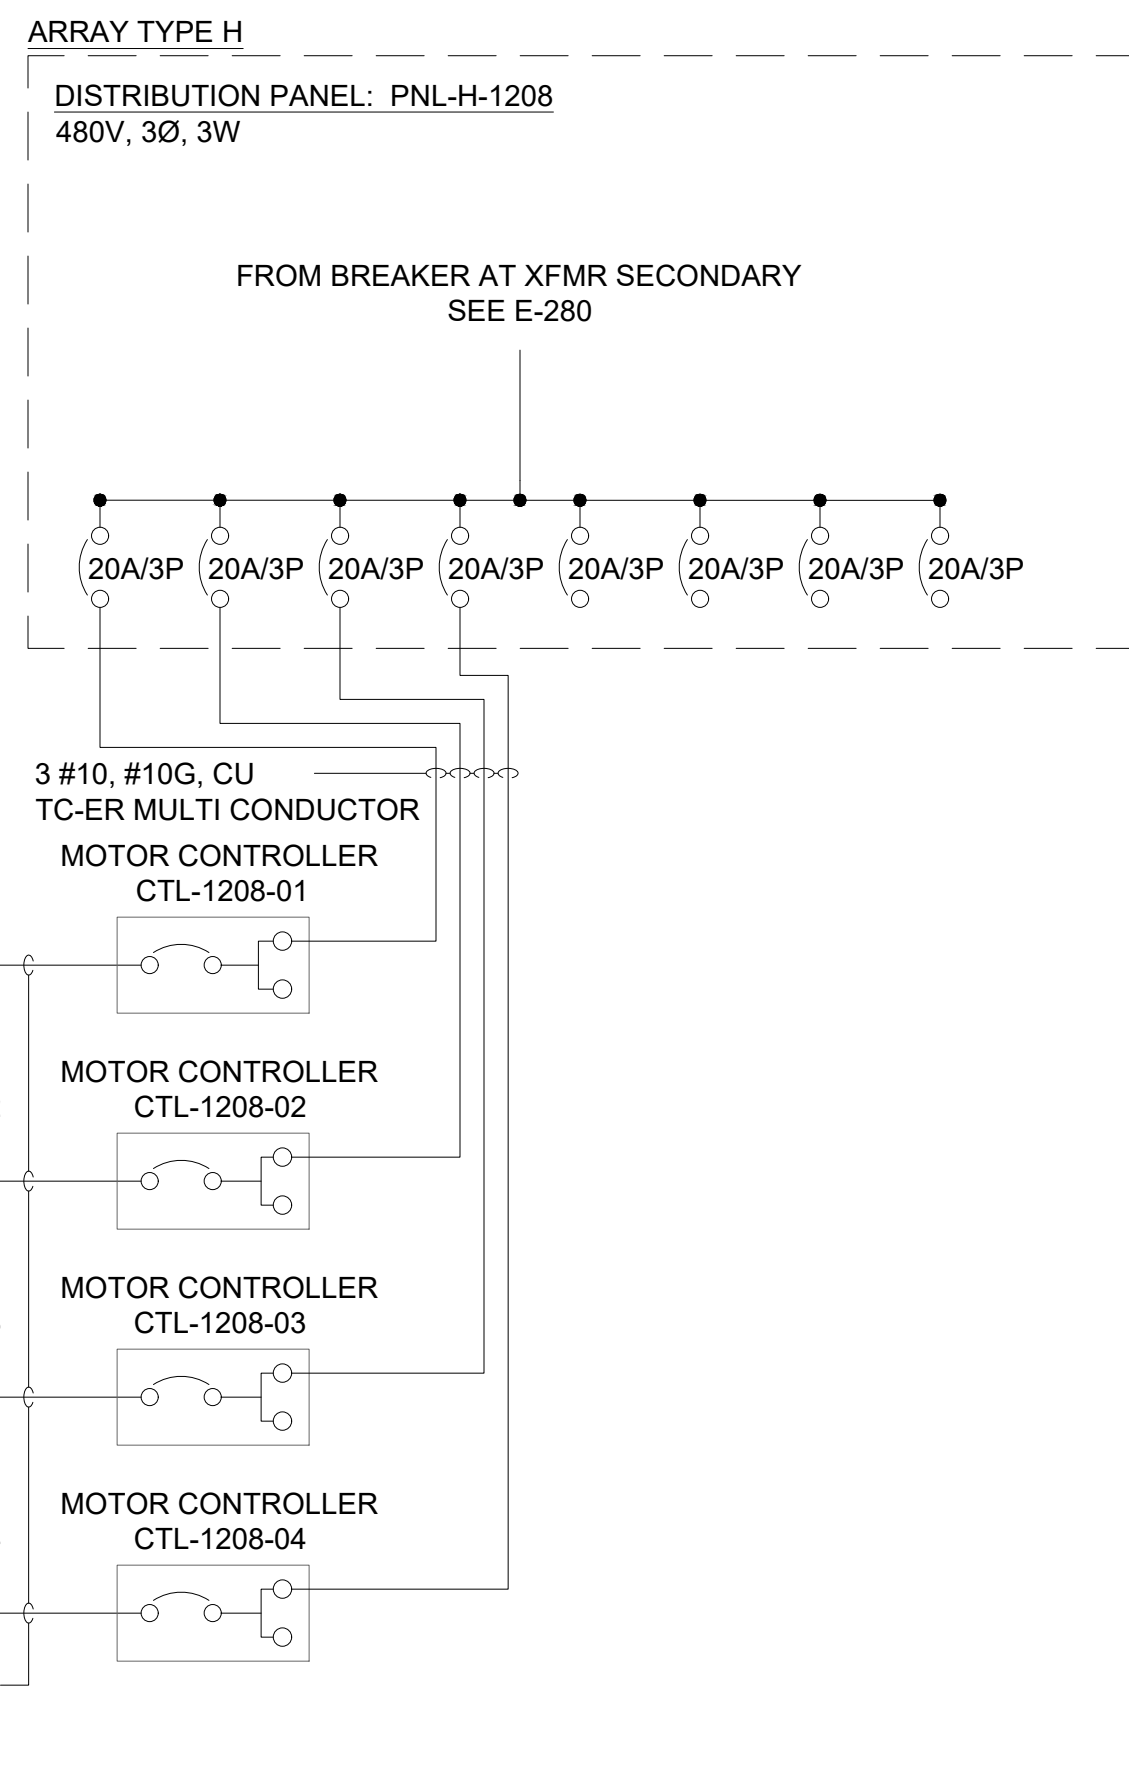

PI QT BV: Brady Burdason

PILOT DATE: Thursday, June 08, 2023

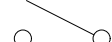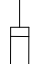

ARRAY TYPE	ASSOCIATED PCS
A	PCS104 PCS105 PCS106 PCS107 PCS201 PCS207 PCS301 PCS302 PCS303 PCS304 PCS401 PCS402 PCS403 PCS404 PCS405 PCS406 PCS502 PCS503 PCS504 PCS505 PCS506
B	PCS204 PCS507
C	PCS501
D	PCS202 PCS206
E	PCS205
F	PCS103 PCS907 PCS1007 PCS1101 PCS1102 PCS1103 PCS1104 PCS1106 PCS1107 PCS1108 PCS1201 PCS1202 PCS1204 PCS1205 PCS1206 PCS1207 PCS1301 PCS1302 PCS1303 PCS1304 PCS1306 PCS1307 PCS1402 PCS1404 PCS1405 PCS1406
G	PCS101 PCS906 PCS1203
H	PCS1208
I	PCS1305
J	PCS102 PCS1401
K	PCS1408
L	PCS1407
M	PCS1105
N	PCS604
O	PCS606
P	PCS607
Q	PCS1308
R	PCS305 PCS306 PCS307 PCS407 PCS705 PCS706 PCS707 PCS803 PCS804 PCS805 PCS806 PCS807 PCS902 PCS903 PCS904 PCS905 PCS1001 PCS1002 PCS1003 PCS1004 PCS1005
S	PCS1006
T	PCS802 PCS901
U	PCS203
V	PCS704
W	PCS701 PCS702 PCS703 PCS801
X	PCS601 PCS602 PCS603 PCS605
Y	PCS1403
Z	PCS1008

LEGEND:

	SWITCH		FUSE		MOTOR
	CIRCUIT PHASE /AC CABLES		AC CIRCUIT BREAKER		TRANSFORMER

PANELBOARD TAG:

PNL X ###

PCS EQUIPMENT ID
H: 277/480V; L:120/240V
PANELBOARD

AUXILIARY EQUIPMENT TAG:
XXX-XXX-##


ASSOCIATED PCS EQUIPMENT ID
 AUXILIARY EQUIP. ABBREVIATION
 SEQUENTIAL NUMBER

KEYED NOTES:

1. ALL EQUIPMENT, COMPONENTS AND DEVICES SHOWN WITHIN THIS DASHED LINE ARE PROVIDED WITH, AND INTEGRAL TO, THE INVERTER.
2. BREAKERS ARE SIZED IN ACCORDANCE WITH THE ATI STANDARD CONFIGURATION POWER REQUIREMENTS DOCUMENT. PER THE DOCUMENT THE MAXIMUM CONTINUOUS CURRENT PER MOTOR IS $3A @ 480V-3\Phi$. IN-RUSH CURRENT IS AS FOLLOWS:
$$I = 3A^*6 + 3A = 21A$$







THE TRIP CURVE OF THE CIRCUIT BREAKER PROVIDED BY THE INVERTER MUST BE ABLE TO SUSTAIN THE IN-RUSH AS INDICATED TO AVOID ANY NUISANCE TRIPPING INCLUDING ANY TEMPERATURE DERATIONS. ADDITIONAL COORDINATION WITH ATI MAY BE REQUIRED TO UNDERSTAND THE MAXIMUM TIME LENGTH OF THE INRUSH CURRENT.

1. REFER TO DRAWINGS E-401 THROUGH E-426 FOR MOTOR LOCATIONS AND ASSOCIATED FEEDER ROUTING.

		FastGrid, LLC 225 E Germann Road Suite 301 Gilbert, AZ 85297
REV	DESCRIPTION	DATE
4	RECORD DRAWINGS	06/08/2020
PROJECT NAME:		
EAGLE SHADOW MOUNTAIN PV SHADING POWER GENERATION FACILITY		
PROJECT ADDRESS:		
I-15 CRYSTAL, NV CLARK COUNTY		
SEAL:	DATE:	10/16/2020
	PROJECT #:	190067.03
	DRAWN BY:	LR
	CHECKED BY:	EL
SHEET NAME:		
TRACKER MOTOR SLD		
SHEET #:	REV	#:
E-291		4

7
6
5
4
3
2
1


A B C D E F G H I J

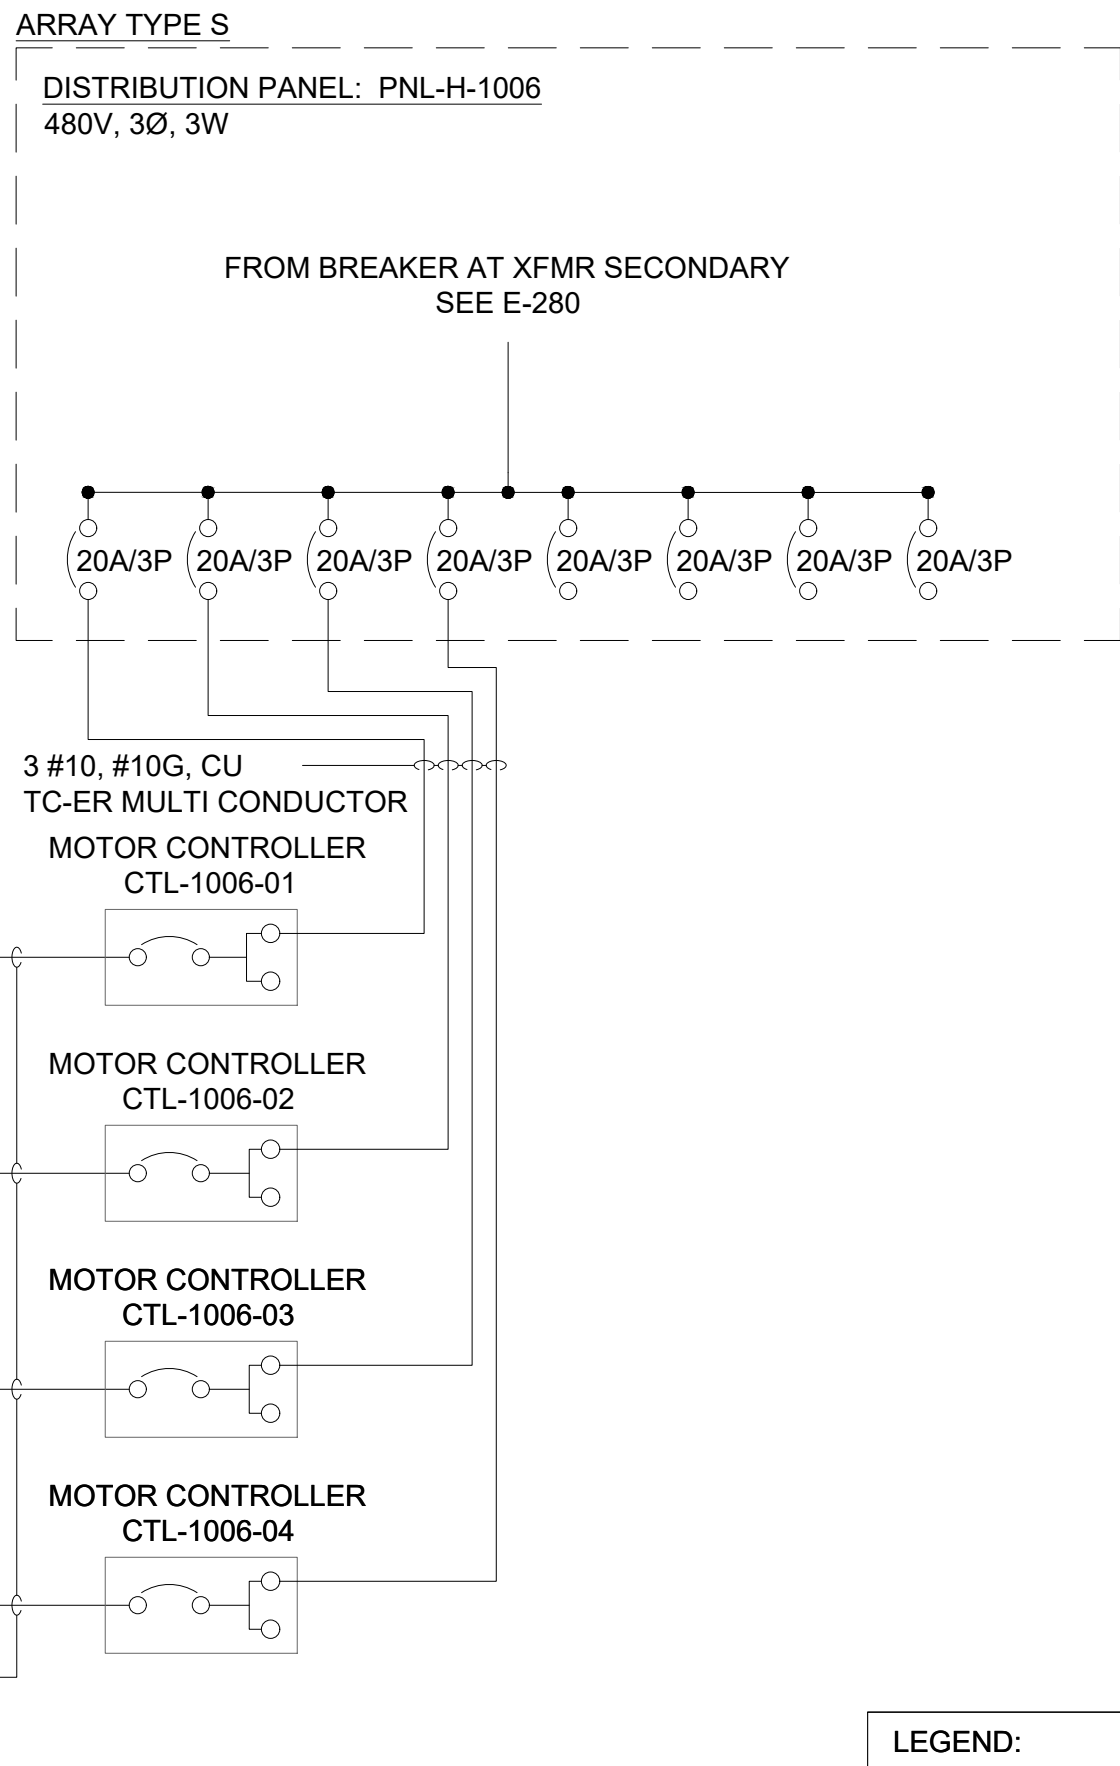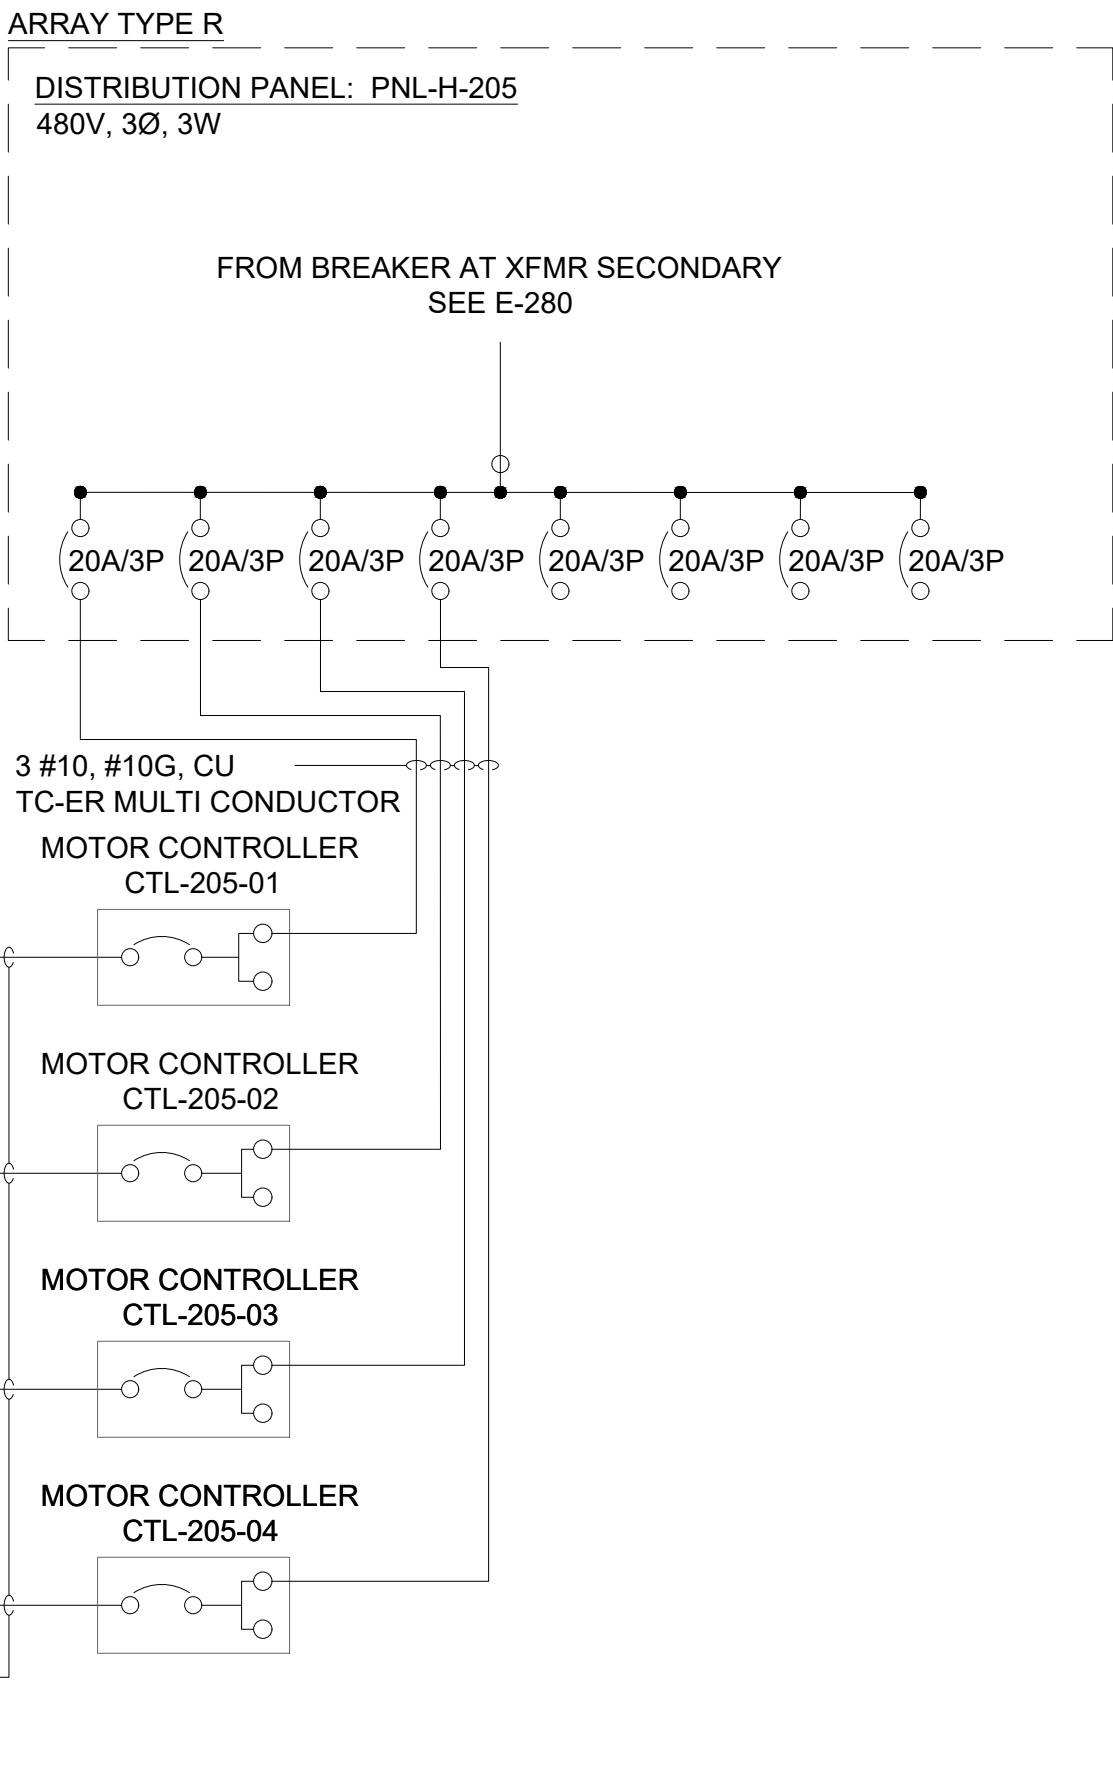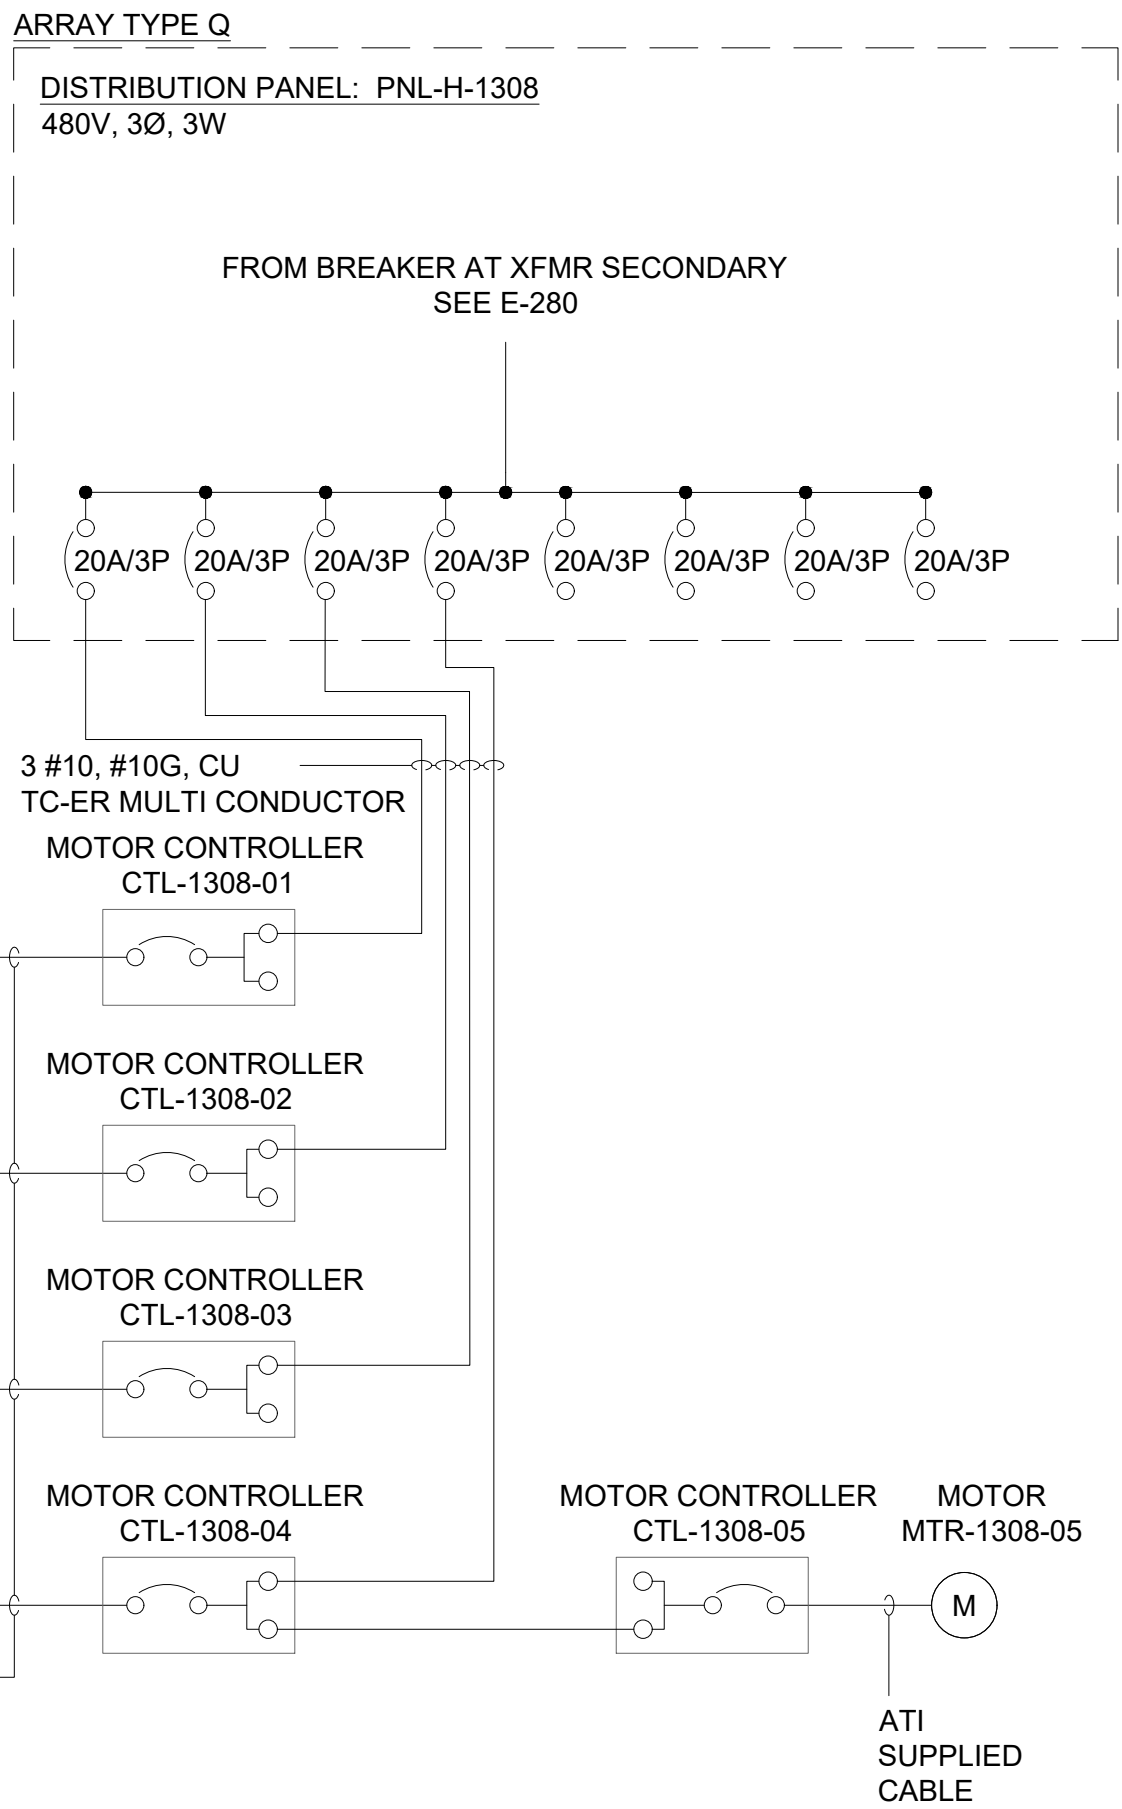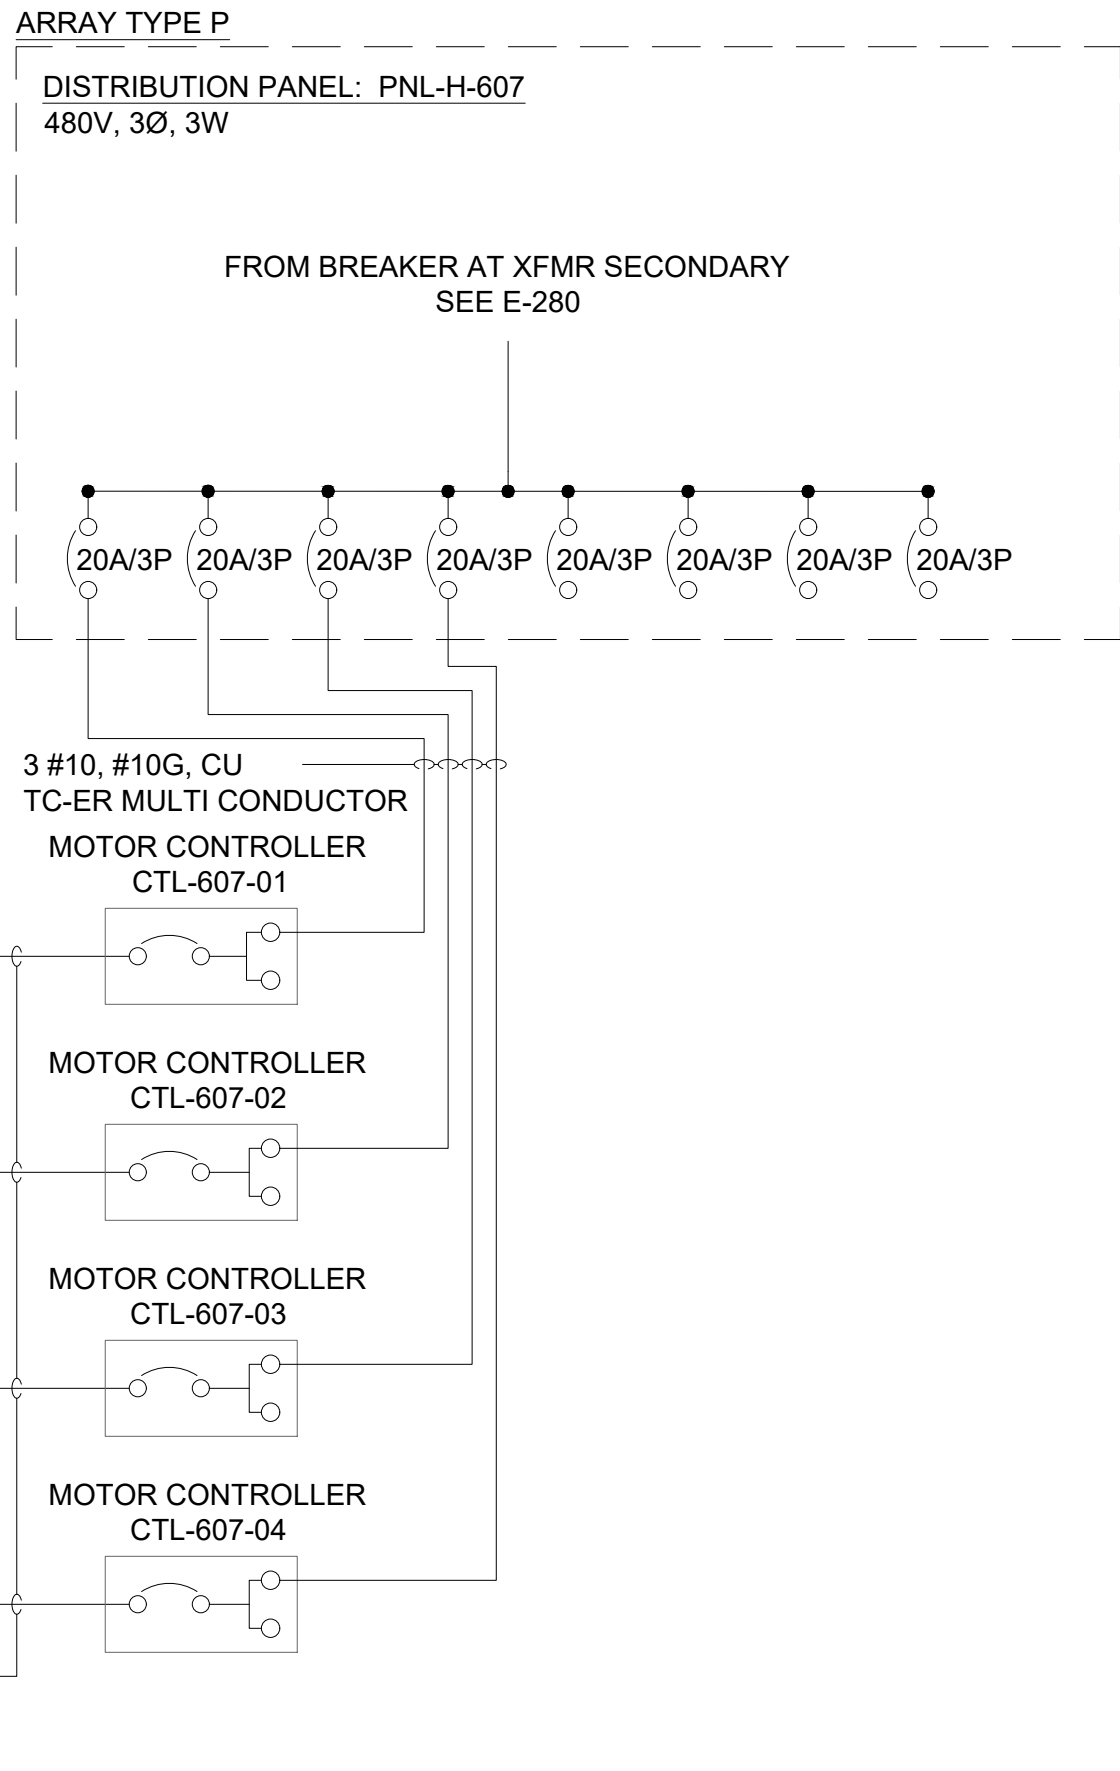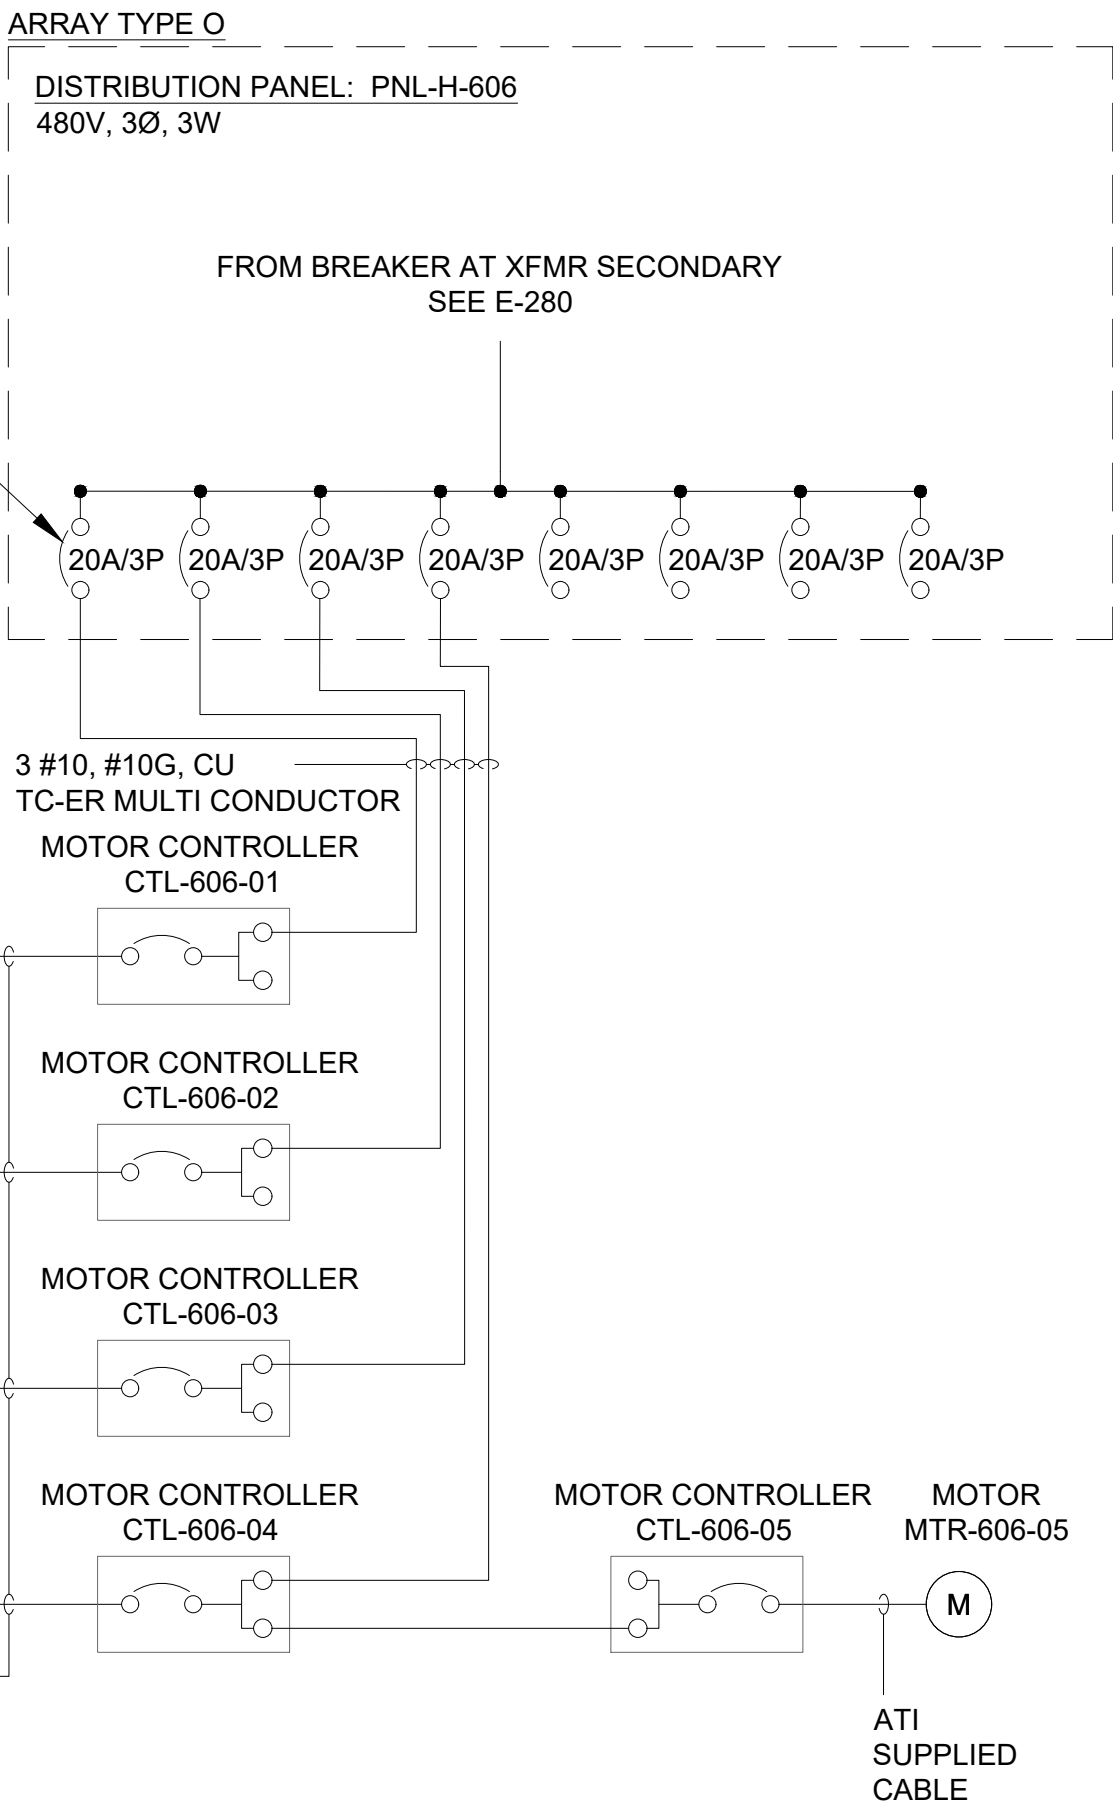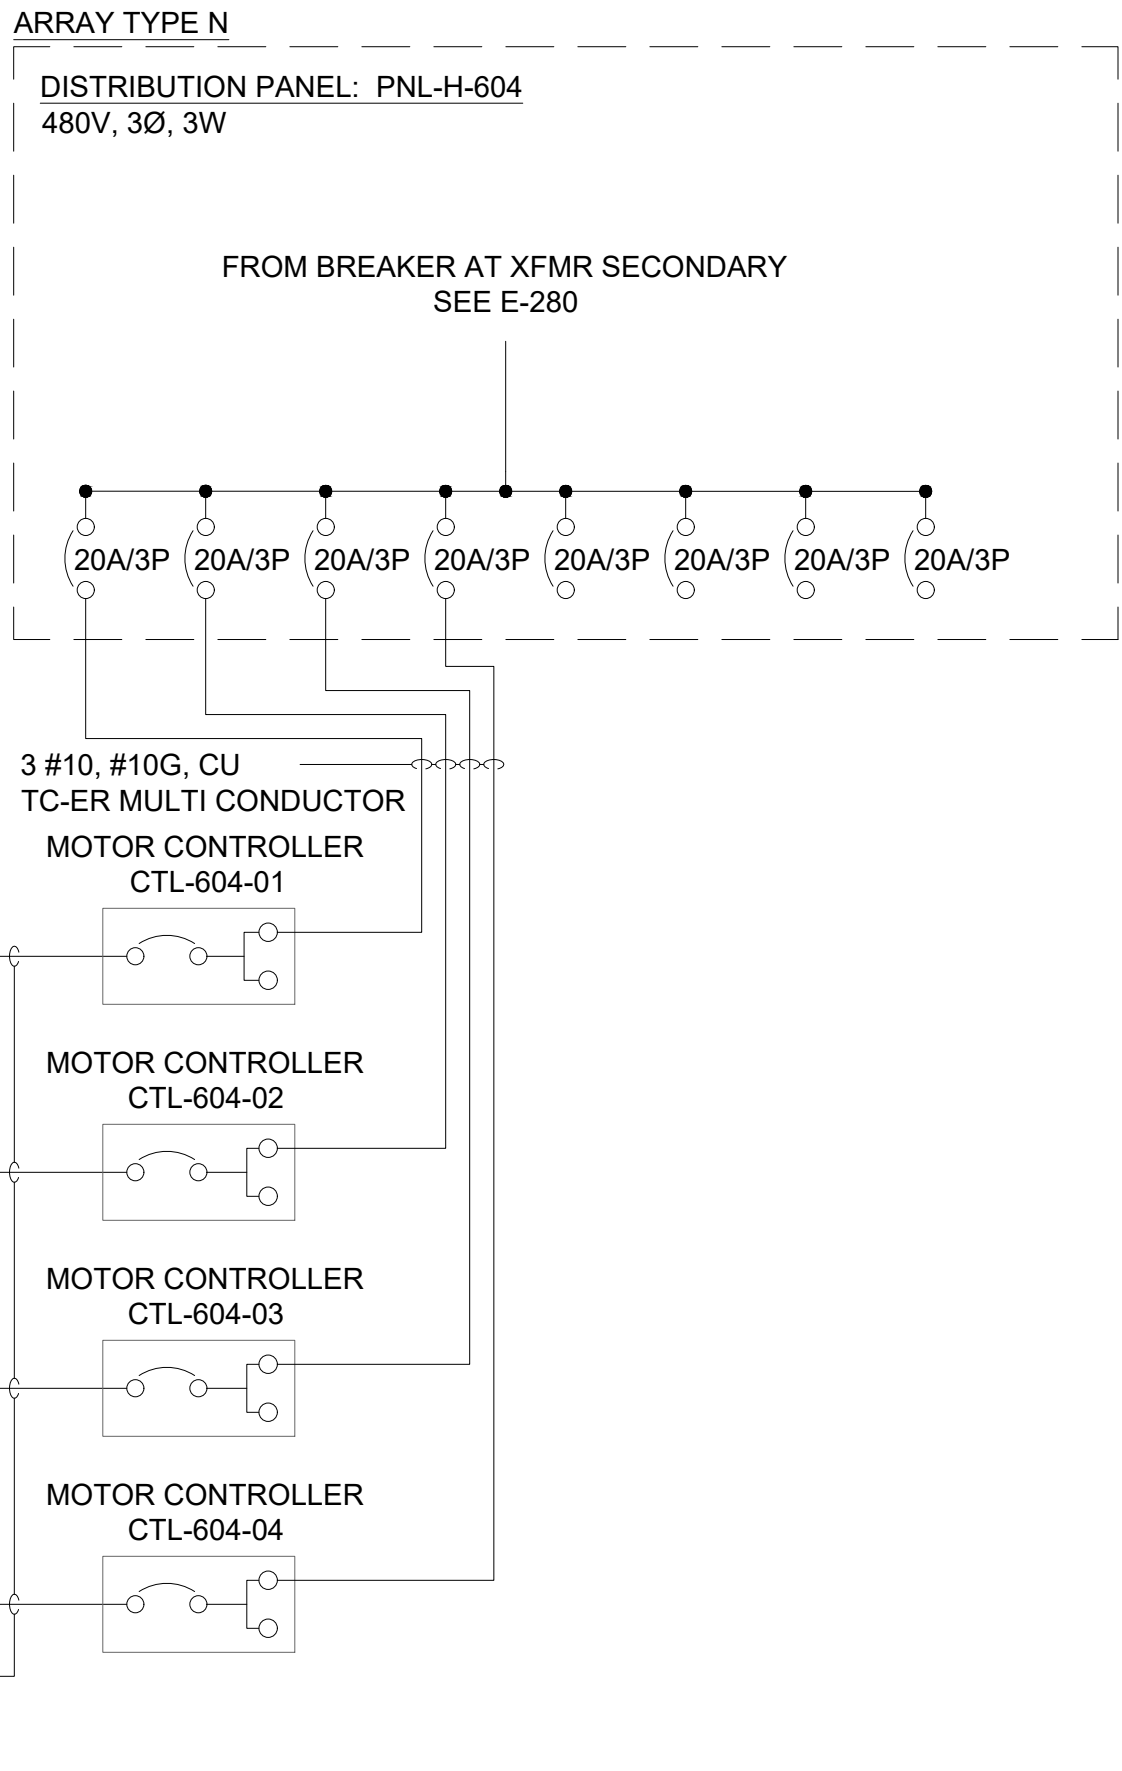

AUXILLIARY EQUIPMENT ABBREVIATIONS:

MTR MOTOR
CTL MOTOR CONTROLLER

ARRAY TYPE	ASSOCIATED PCS
A	PCS104 PCS105 PCS106 PCS107 PCS201 PCS207 PCS301 PCS302 PCS303 PCS304 PCS401 PCS402 PCS403 PCS404 PCS405 PCS406 PCS502 PCS503 PCS504 PCS505 PCS506
B	PCS204 PCS507
C	PCS501
D	PCS202 PCS206
E	PCS205
F	PCS103 PCS907 PCS1007 PCS1101 PCS1102 PCS1103 PCS1104 PCS1106 PCS1107 PCS1108 PCS1201 PCS1202 PCS1204 PCS1205 PCS1206 PCS1207 PCS1301 PCS1302 PCS1303 PCS1304 PCS1306 PCS1307 PCS1402 PCS1404 PCS1405 PCS1406
G	PCS101 PCS906 PCS1203
H	PCS1208
I	PCS1305
J	PCS102 PCS1401
K	PCS1408
L	PCS1407
M	PCS1105
N	PCS604
O	PCS606
P	PCS607
Q	PCS1308
R	PCS305 PCS306 PCS307 PCS407 PCS705 PCS706 PCS707 PCS803 PCS804 PCS805 PCS806 PCS807 PCS902 PCS903 PCS904 PCS905 PCS1001 PCS1002 PCS1003 PCS1004 PCS1005
S	PCS1006
T	PCS802 PCS901
U	PCS203
V	PCS704
W	PCS701 PCS702 PCS703 PCS801
X	PCS601 PCS602 PCS603 PCS605
Y	PCS1403

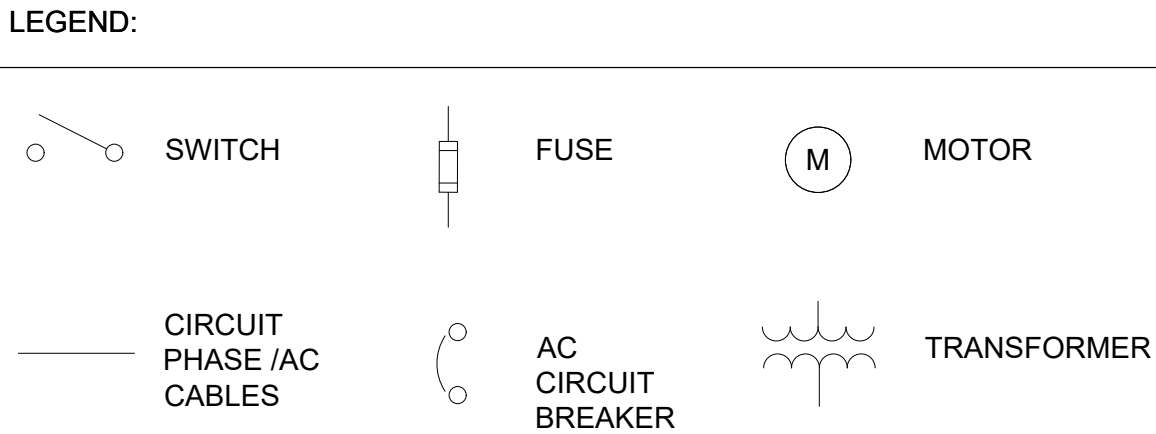

PANELBOARD TAG:

PNLX-###

PCS EQUIPMENT ID
H: 277/480V; L:120/240V
PANELBOARD

AUXILLIARY EQUIPMENT TAG:

XXX-XXX-##

SEQUENTIAL NUMBER
ASSOCIATED PCS EQUIPMENT ID
AUXILLIARY EQUIP. ABBREVIATION

- KEYED NOTES:
- ALL EQUIPMENT, COMPONENTS AND DEVICES SHOWN WITHIN THIS DASHED LINE ARE PROVIDED WITH, AND INTEGRAL TO, THE INVERTER.
 - BREAKERS ARE SIZED IN ACCORDANCE WITH THE ATI 'STANDARD CONFIGURATION POWER REQUIREMENTS' DOCUMENT. PER THE DOCUMENT, THE MAXIMUM CONTINUOUS CURRENT PER MOTOR IS 3A @ 480V-3PH. IN-RUSH CURRENT IS AS FOLLOWS: $I = 3A \times 6 + 3A = 21A$. THE TRIP CURVE OF THE CIRCUIT BREAKER PROVIDED BY THE INVERTER MUST BE ABLE TO SUSTAIN THE IN-RUSH AS INDICATED TO AVOID ANY NUISANCE TRIPPING INCLUDING ANY TEMPERATURE DERATIONS. ADDITIONAL COORDINATION WITH ATI MAY BE REQUIRED TO UNDERSTAND THE MAXIMUM TIME LENGTH OF THE INRUSH CURRENT.

- REFER TO DRAWINGS E-401 THROUGH E-426 FOR MOTOR LOCATIONS AND ASSOCIATED FEEDER ROUTING.

FastGrid, LLC
225 E Germann Road
Suite 301
Gilbert, AZ 85297

REV	DESCRIPTION	DATE
4	RECORD DRAWINGS	06/08/2023

PROJECT NAME:
**EAGLE SHADOW MOUNTAIN
PV SOLAR POWER
GENERATION FACILITY**

PROJECT ADDRESS:
**I-15
CRYSTAL, NV
CLARK COUNTY**

SEAL:

DATE:
10/16/2020

PROJECT #:
190067.03

DRAWN BY:
LR

CHECKED BY:
EL

SHEET NAME:
TRACKER MOTOR SLD

SHEET #:
E-292

REV #:
4

AS BUILT

7

6

5

4

3

2

1

A

B

C

D

E







F

G

H


I

J

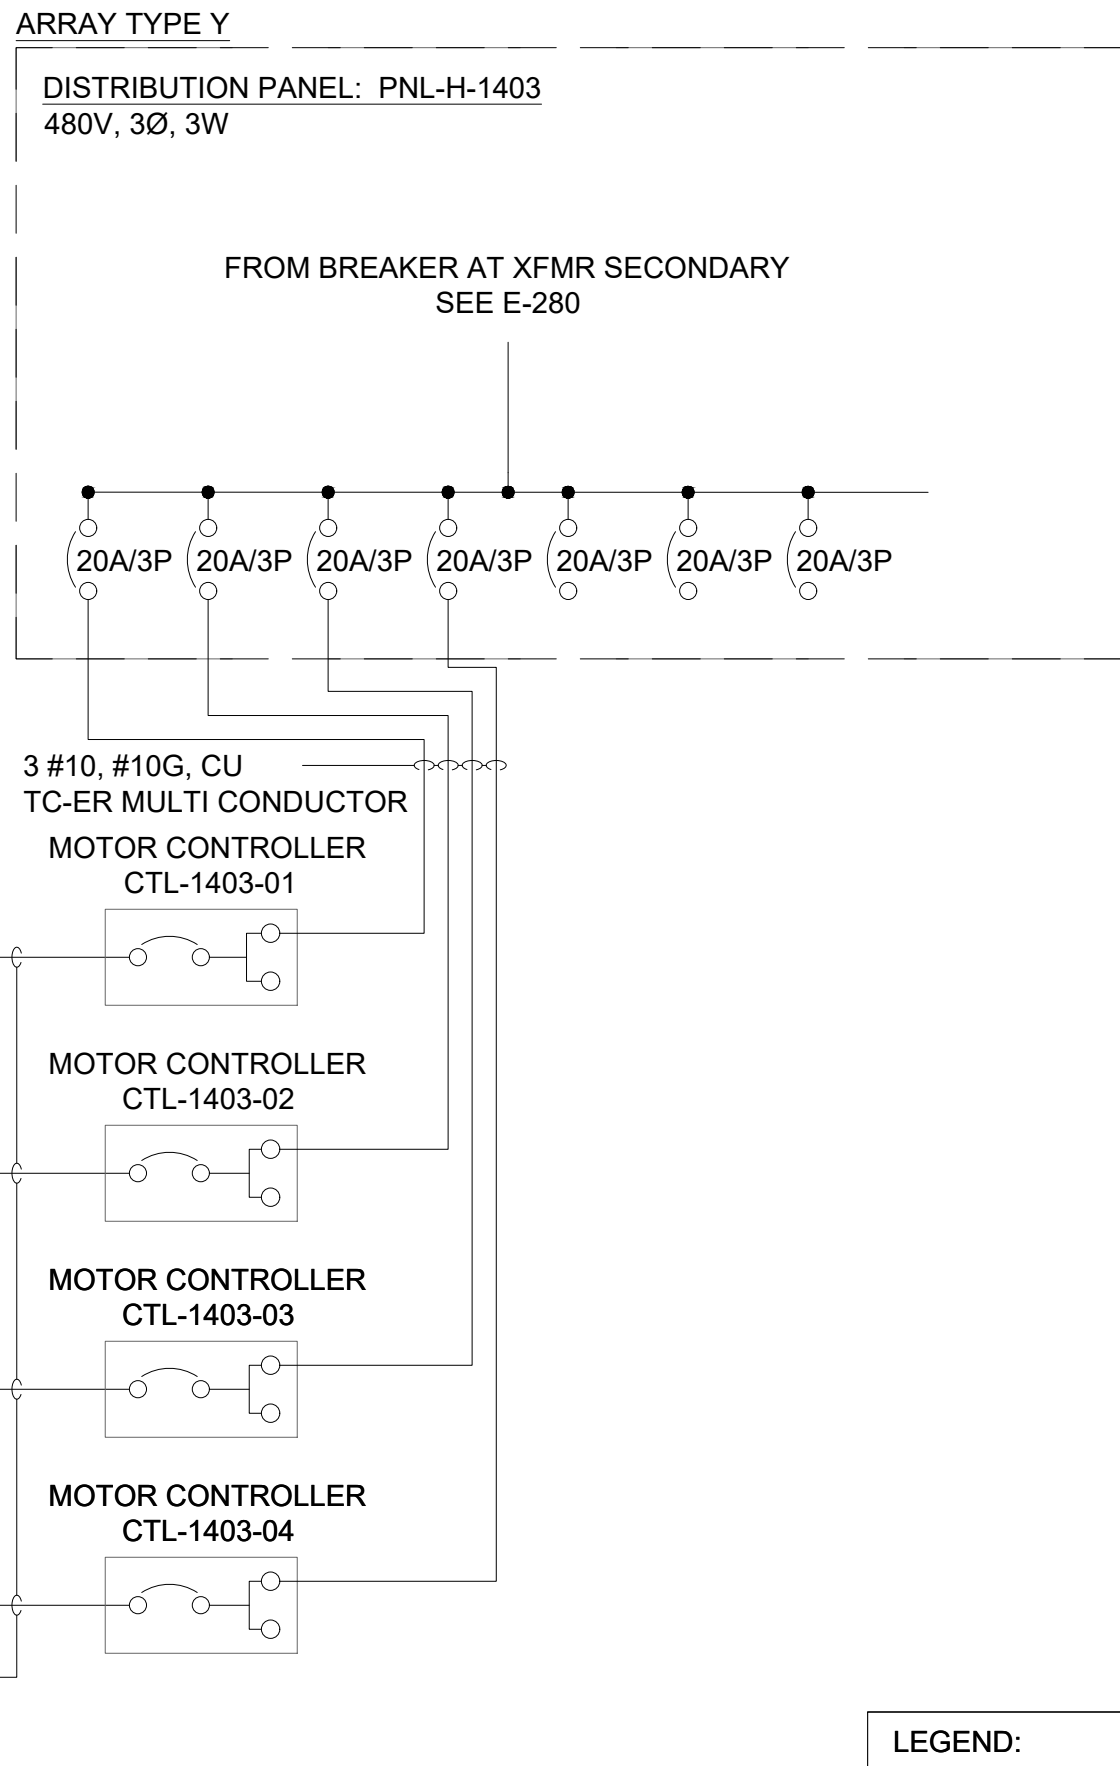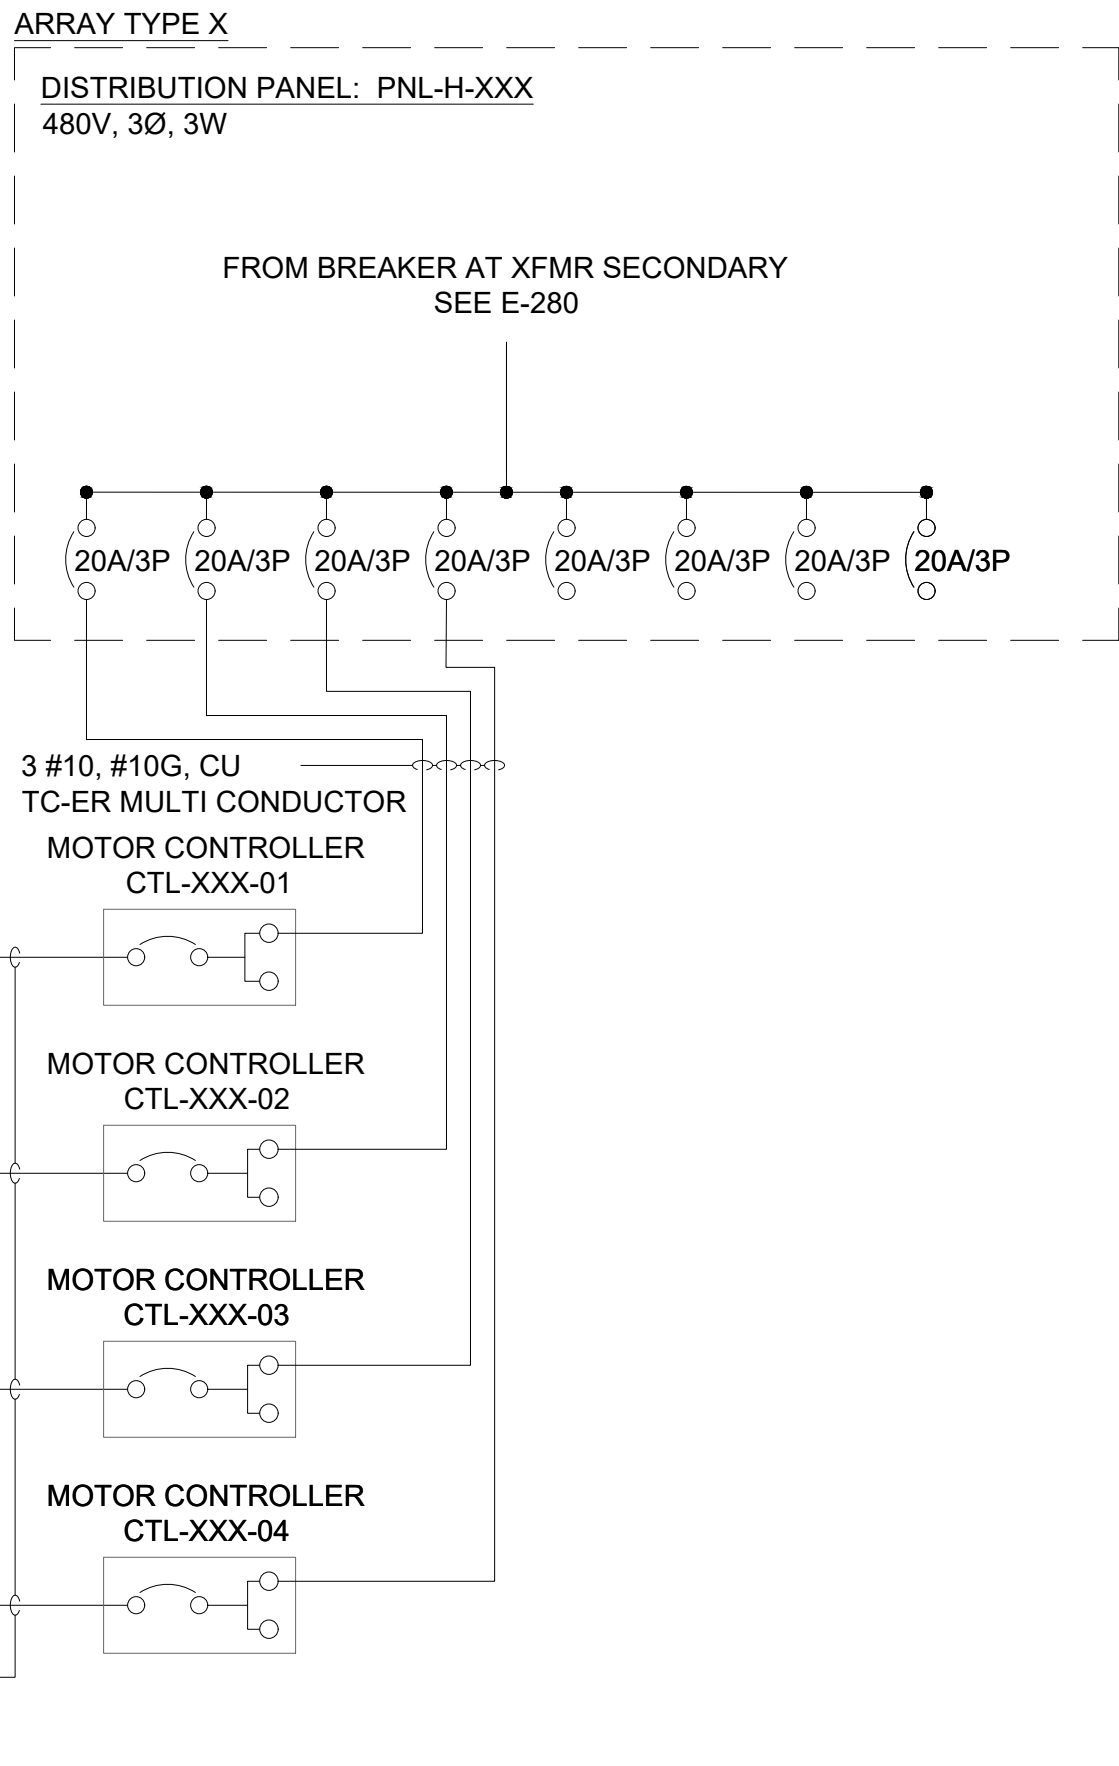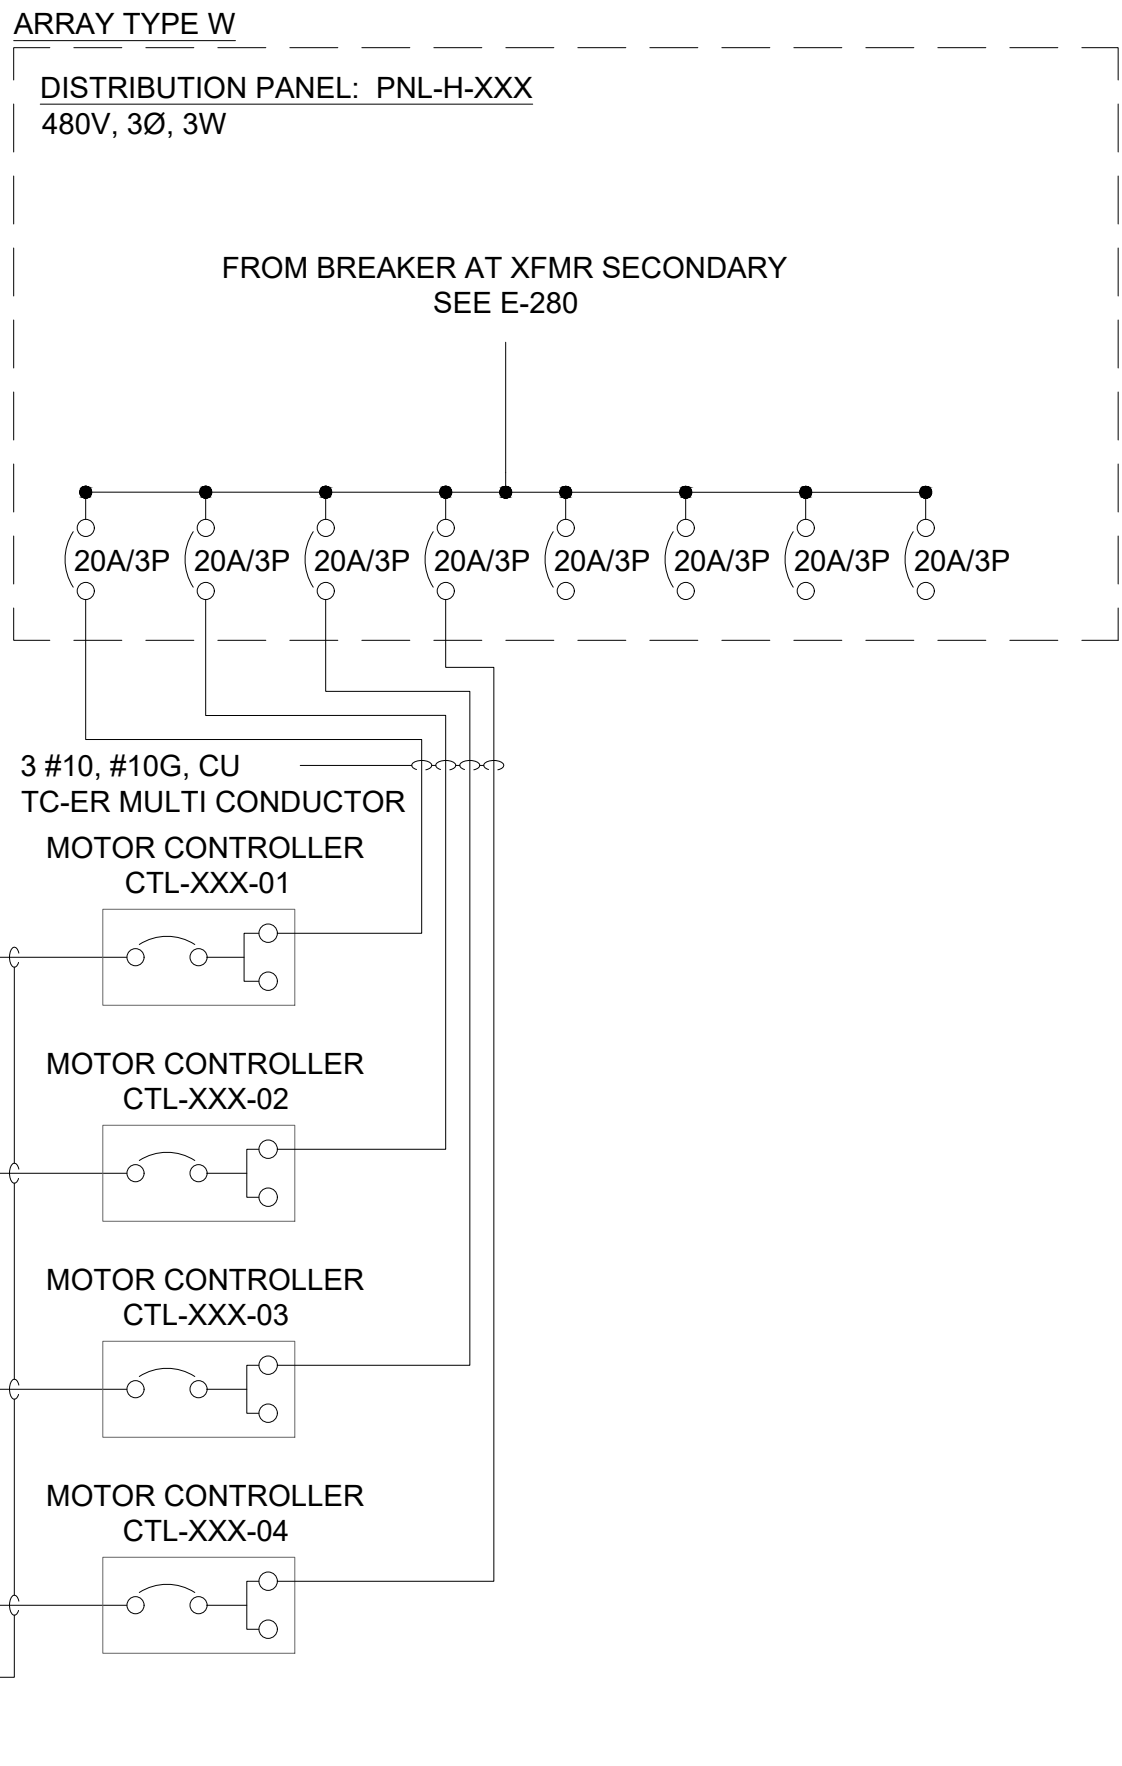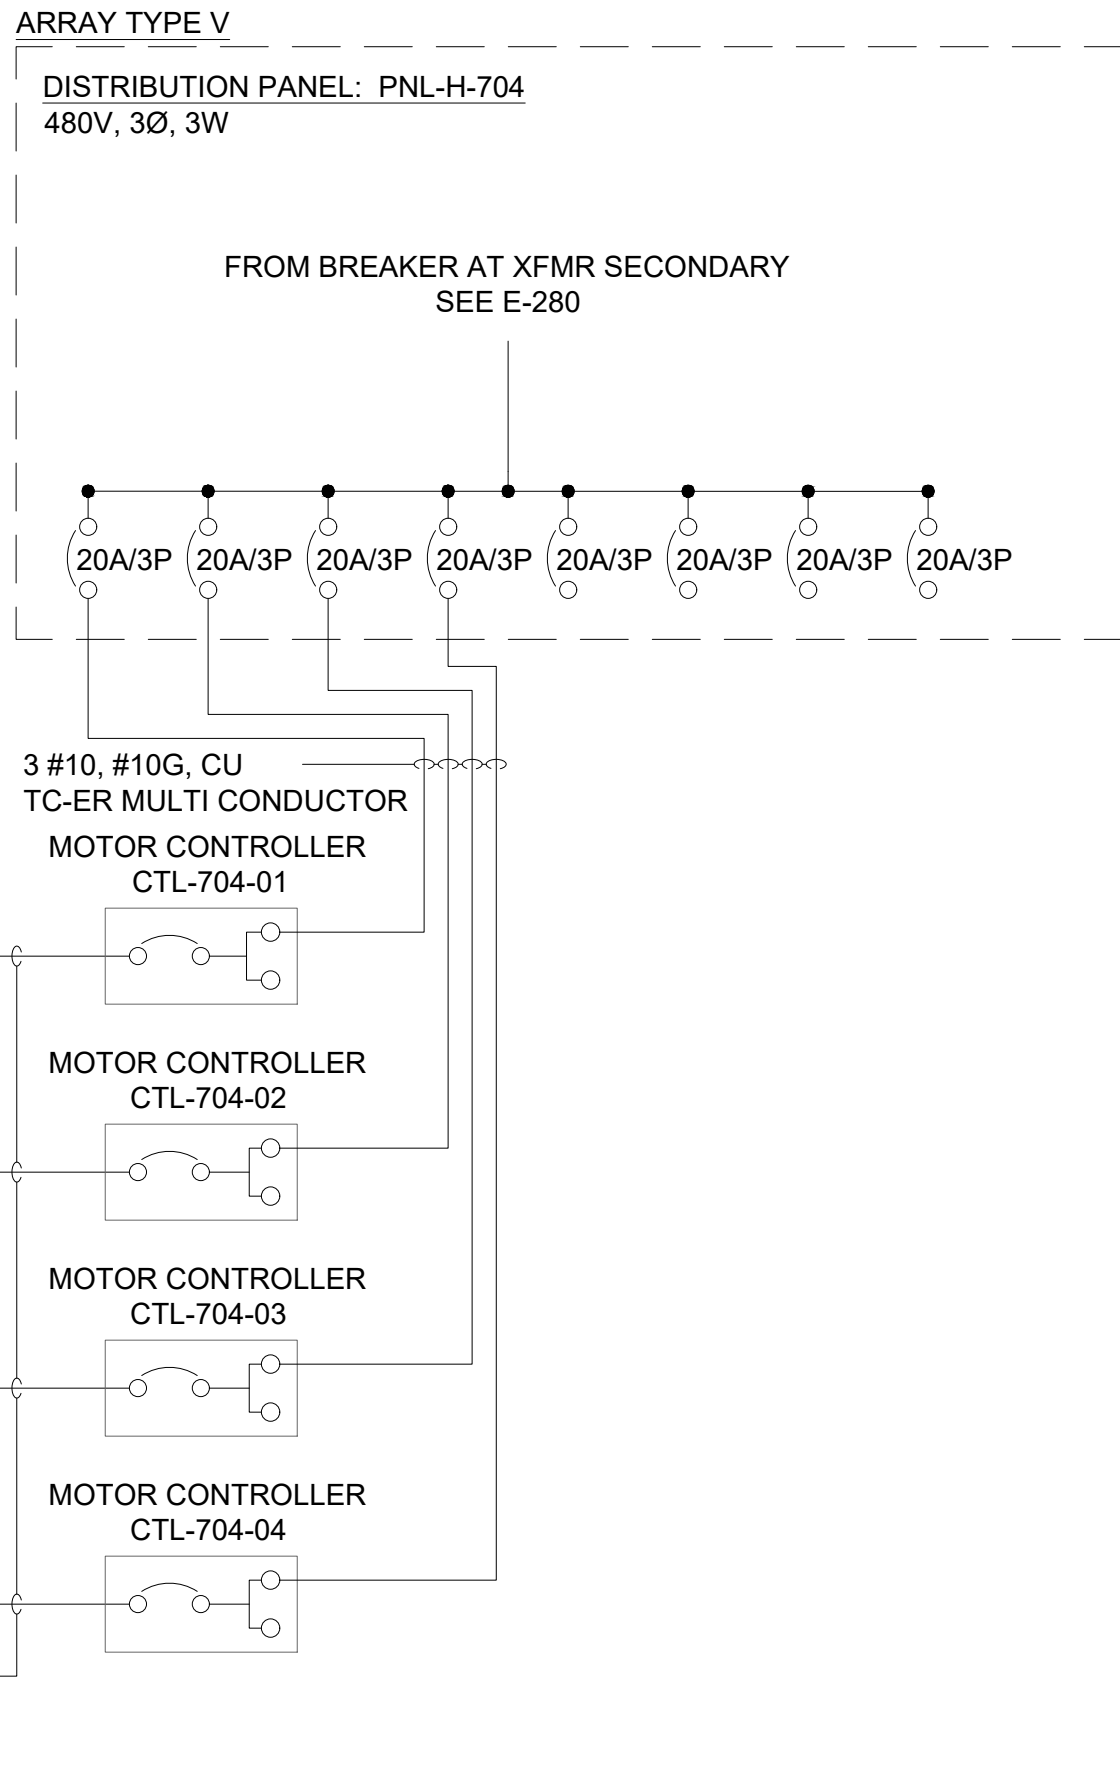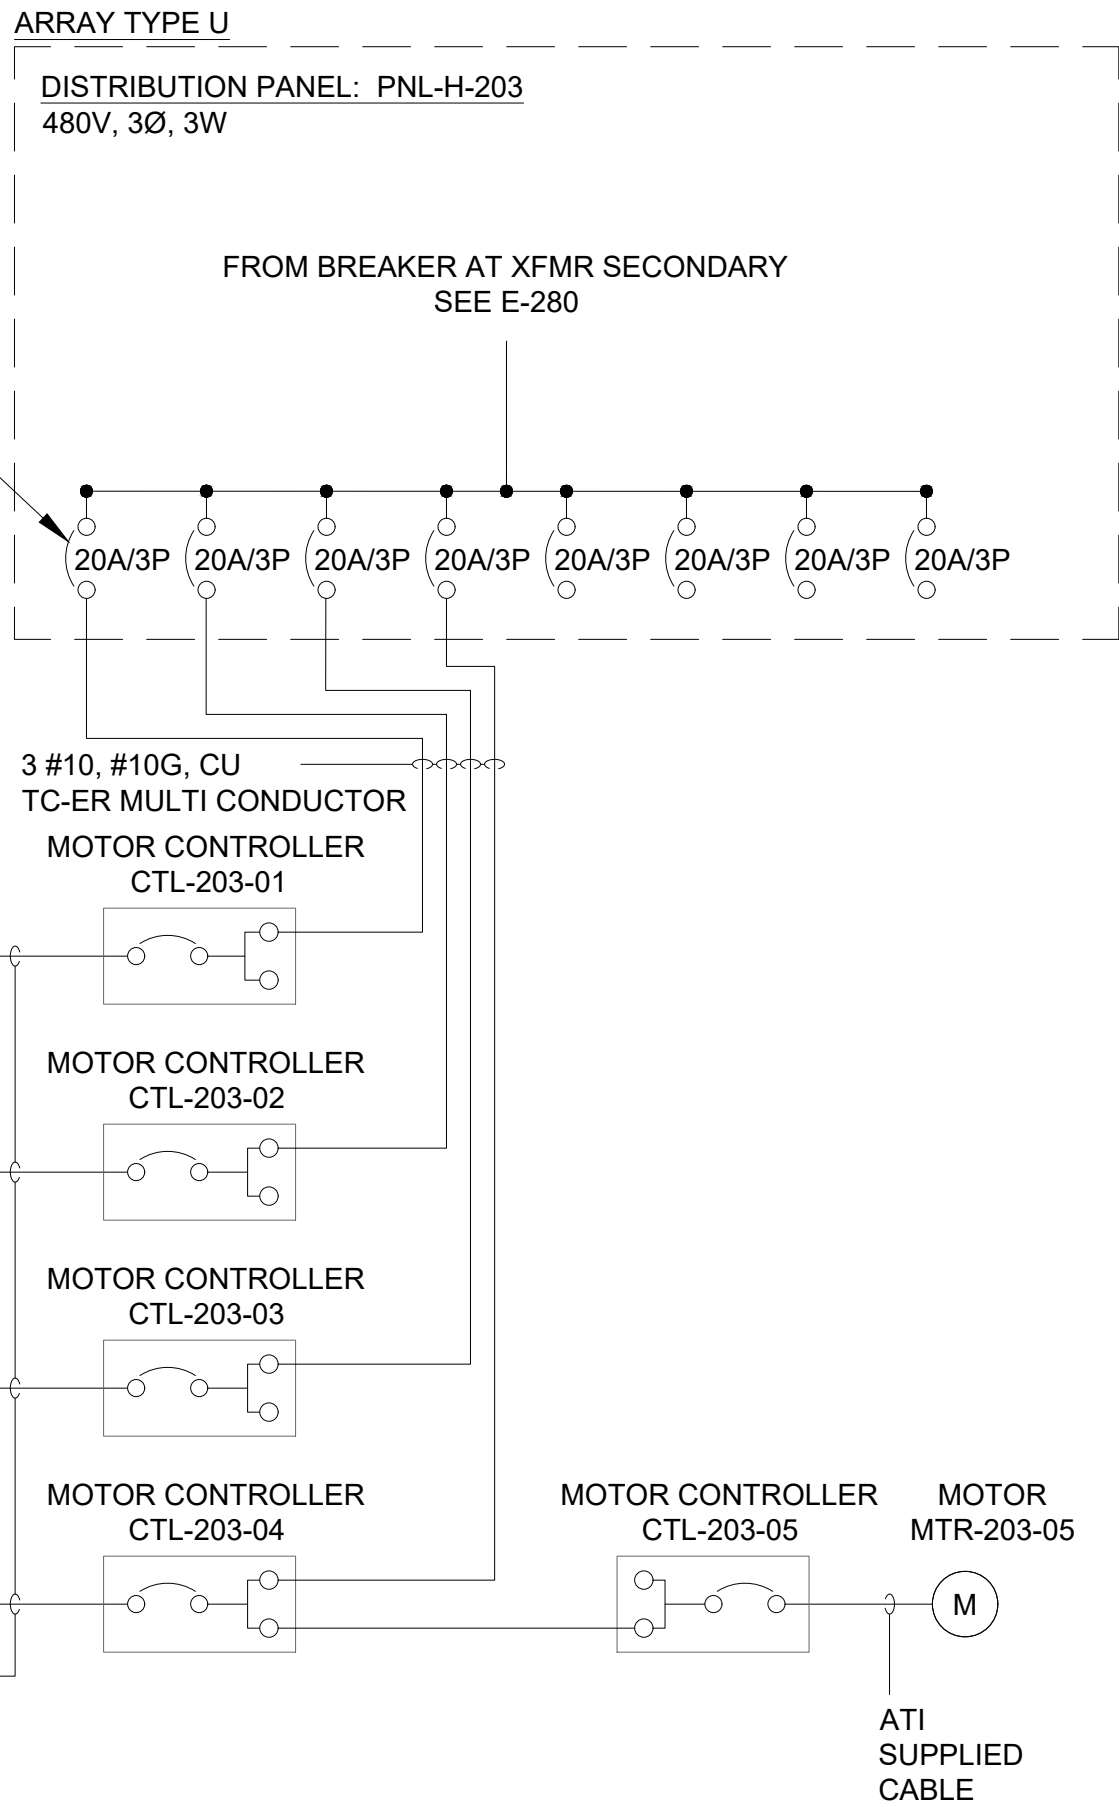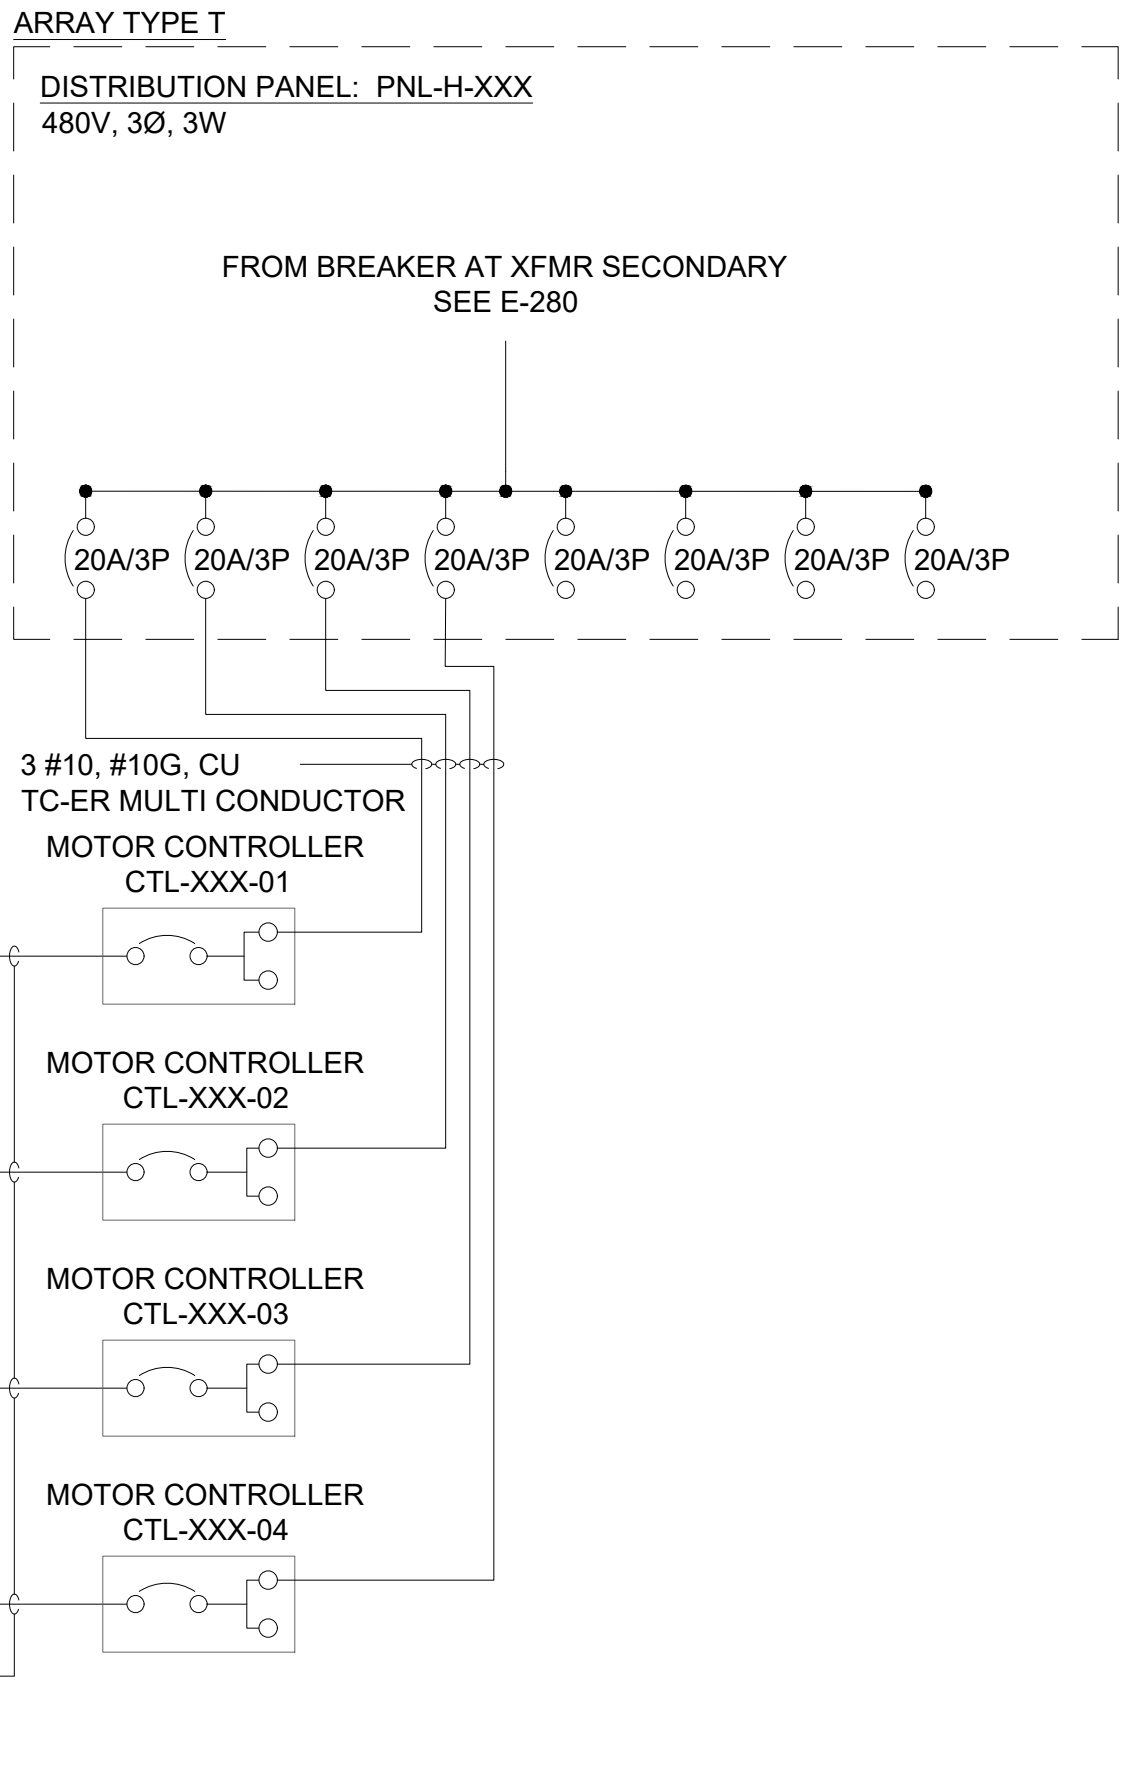

AUXILLIARY EQUIPMENT ABBREVIATIONS:
MTR MOTOR
CTL MOTOR CONTROLLER

ARRAY TYPE	ASSOCIATED PCS
A	PCS104 PCS105 PCS106 PCS107 PCS201 PCS207 PCS301 PCS302 PCS303 PCS304 PCS401 PCS402 PCS403 PCS404 PCS405 PCS406 PCS502 PCS503 PCS504 PCS505 PCS506
B	PCS204 PCS507
C	PCS501
D	PCS202 PCS206
E	PCS205
F	PCS103 PCS907 PCS1007 PCS1101 PCS1102 PCS1103 PCS1104 PCS1106 PCS1107 PCS1108 PCS1201 PCS1202 PCS1204 PCS1205 PCS1206 PCS1207 PCS1301 PCS1302 PCS1303 PCS1304 PCS1306 PCS1307 PCS1402 PCS1404 PCS1405 PCS1406
G	PCS101 PCS906 PCS1203
H	PCS1208
I	PCS1305
J	PCS102 PCS1401
K	PCS1408
L	PCS1407
M	PCS1105
N	PCS604
O	PCS606
P	PCS607
Q	PCS1308
R	PCS305 PCS306 PCS307 PCS407 PCS705 PCS706 PCS707 PCS803 PCS804 PCS805 PCS806 PCS807 PCS902 PCS903 PCS904 PCS905 PCS1001 PCS1002 PCS1003 PCS1004 PCS1005
S	PCS1006
T	PCS802 PCS901
U	PCS203
V	PCS704
W	PCS701 PCS702 PCS703 PCS801
X	PCS601 PCS602 PCS603 PCS605
Y	PCS1403

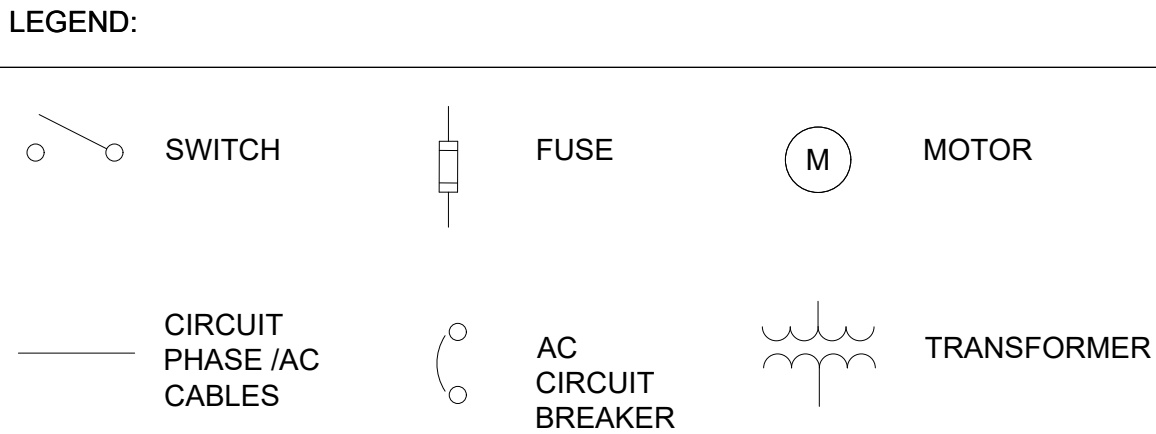

PANELBOARD TAG:
PNL X ###

PCS EQUIPMENT ID
H: 277/480V; L:120/240V
PANELBOARD

AUXILLIARY EQUIPMENT TAG:
XXX-XXX-##

SEQUENTIAL NUMBER
ASSOCIATED PCS EQUIPMENT ID
AUXILLIARY EQUIP. ABBREVIATION

- KEYED NOTES:
- ALL EQUIPMENT, COMPONENTS AND DEVICES SHOWN WITHIN THIS DASHED LINE ARE PROVIDED WITH, AND INTEGRAL TO, THE INVERTER.
 - BREAKERS ARE SIZED IN ACCORDANCE WITH THE ATI 'STANDARD CONFIGURATION POWER REQUIREMENTS' DOCUMENT. PER THE DOCUMENT, THE MAXIMUM CONTINUOUS CURRENT PER MOTOR IS 3A @ 480V-3PH. IN-RUSH CURRENT IS AS FOLLOWS: $I = 3A \times 6 + 3A = 21A$. THE TRIP CURVE OF THE CIRCUIT BREAKER PROVIDED BY THE INVERTER MUST BE ABLE TO SUSTAIN THE IN-RUSH AS INDICATED TO AVOID ANY NUISANCE TRIPPING INCLUDING ANY TEMPERATURE DERATIONS. ADDITIONAL COORDINATION WITH ATI MAY BE REQUIRED TO UNDERSTAND THE MAXIMUM TIME LENGTH OF THE INRUSH CURRENT.

- REFER TO DRAWINGS E-401 THROUGH E-426 FOR MOTOR LOCATIONS AND ASSOCIATED FEEDER ROUTING.

FastGrid, LLC
225 E Germann Road
Suite 301
Gilbert, AZ 85297

REV	DESCRIPTION	DATE
4	RECORD DRAWINGS	06/08/2023

PROJECT NAME:
**EAGLE SHADOW MOUNTAIN
PV SOLAR POWER
GENERATION FACILITY**


PROJECT ADDRESS:
**I-15
CRYSTAL, NV
CLARK COUNTY**

SEAL:	DATE: 10/16/2020
	PROJECT #: 190067.03
	DRAWN BY: LR
	CHECKED BY: EL

SHEET NAME:
TRACKER MOTOR SLD

SHEET #: E-293	REV #: 4
--------------------------	--------------------

AS BUILT

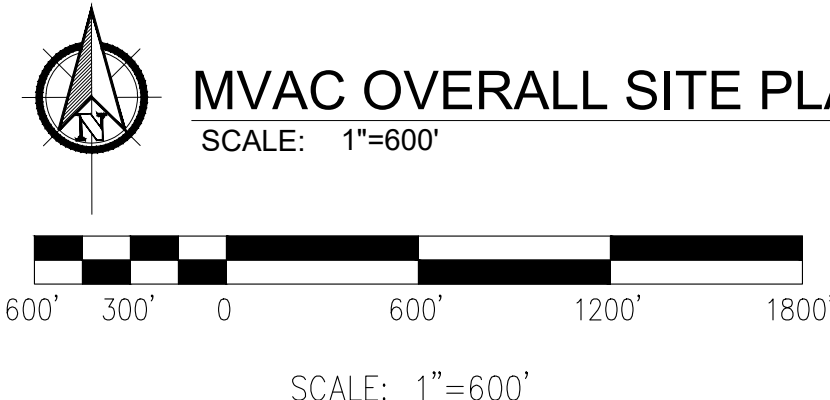

- FastGrid**
- FastGrid, LLC
225 E Germann Road
Suite 301
Gilbert, AZ 85297

PROJECT NAME:
EAGLE SHADOW MOUNTAIN
PV SOLAR POWER
GENERATION FACILITY

SEAL:	DATE:
	10/16/2020
	PROJECT #:
	190067.03
	DRAWN BY:
	TLR
	CHECKED BY:
	EL

SHEET #:	REV
E-300	#:
	4


RECORD DRAWING

LOCATION: K\ 09 PROJECTS\190087 03 - PRIMORIS - EAGLE SHADOW MOUNTAIN\INUS ENGINEERING\DWG\E-300 MVAC OVERALL SITE PLAN
 SAVED BY: brady.burgason
 PLOT BY: Brady Burgason
 PLOT DATE: Thursday, June 08, 2023 08:30


CAB MESSENGER
SUPPORT SYSTEM
REFER TO E-492
(TYP)

FOR PCS104 ONLY:
INSTALL 405W
MODULES AT THIS
LOCATION.

FOR PCS104 ONLY:
SEE MODULE
ALLOCATIONS
INDICATED

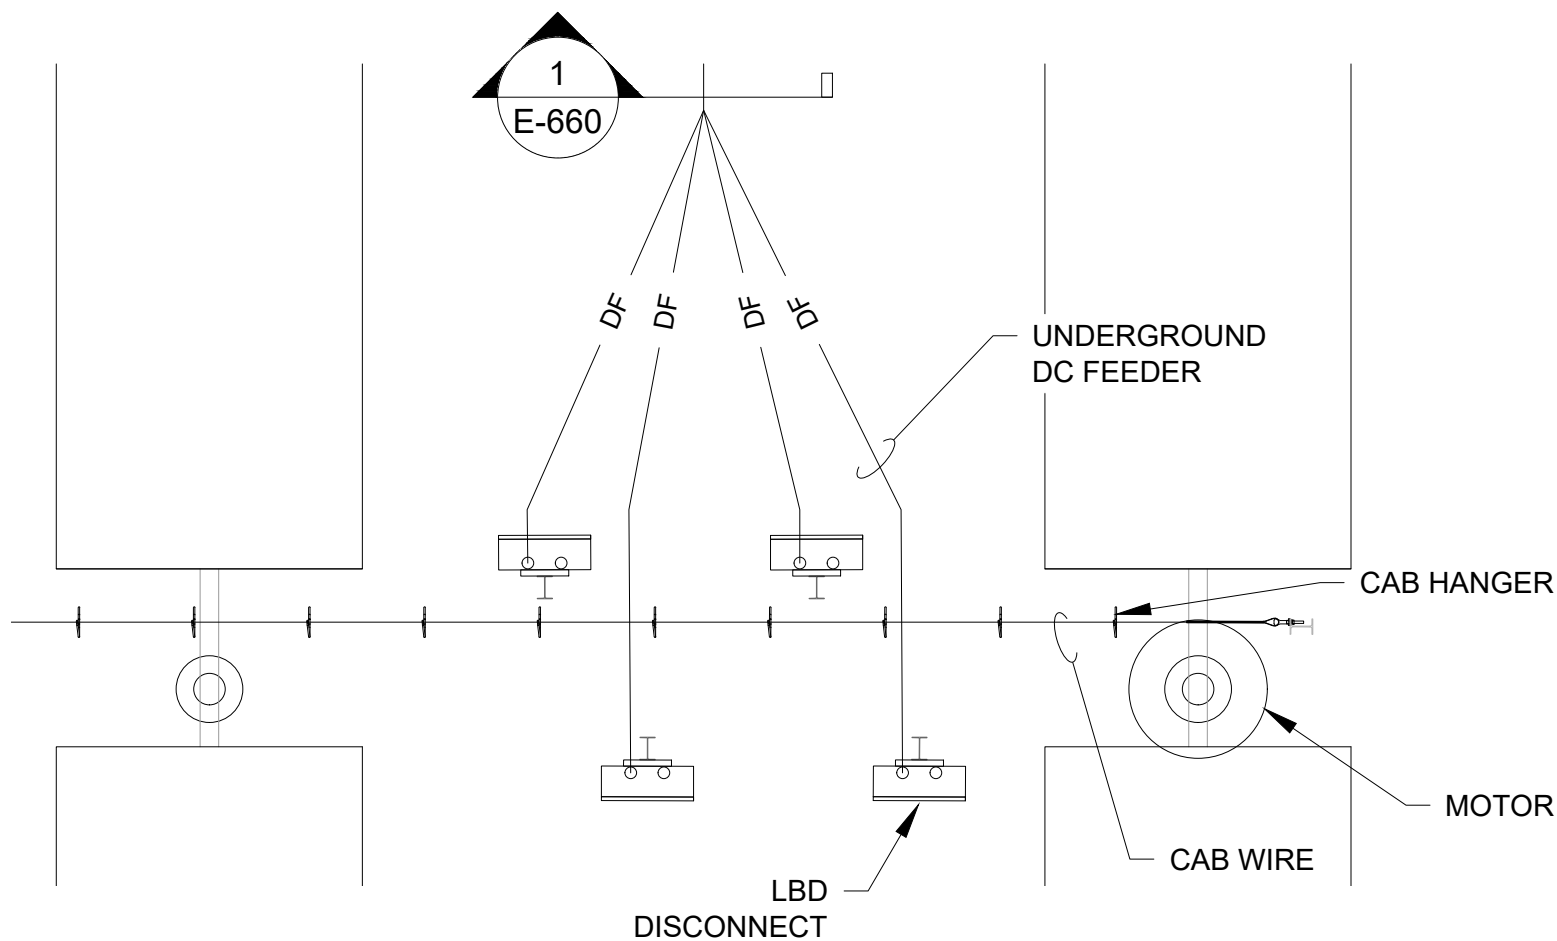


1 LBD LAYOUT DETAIL

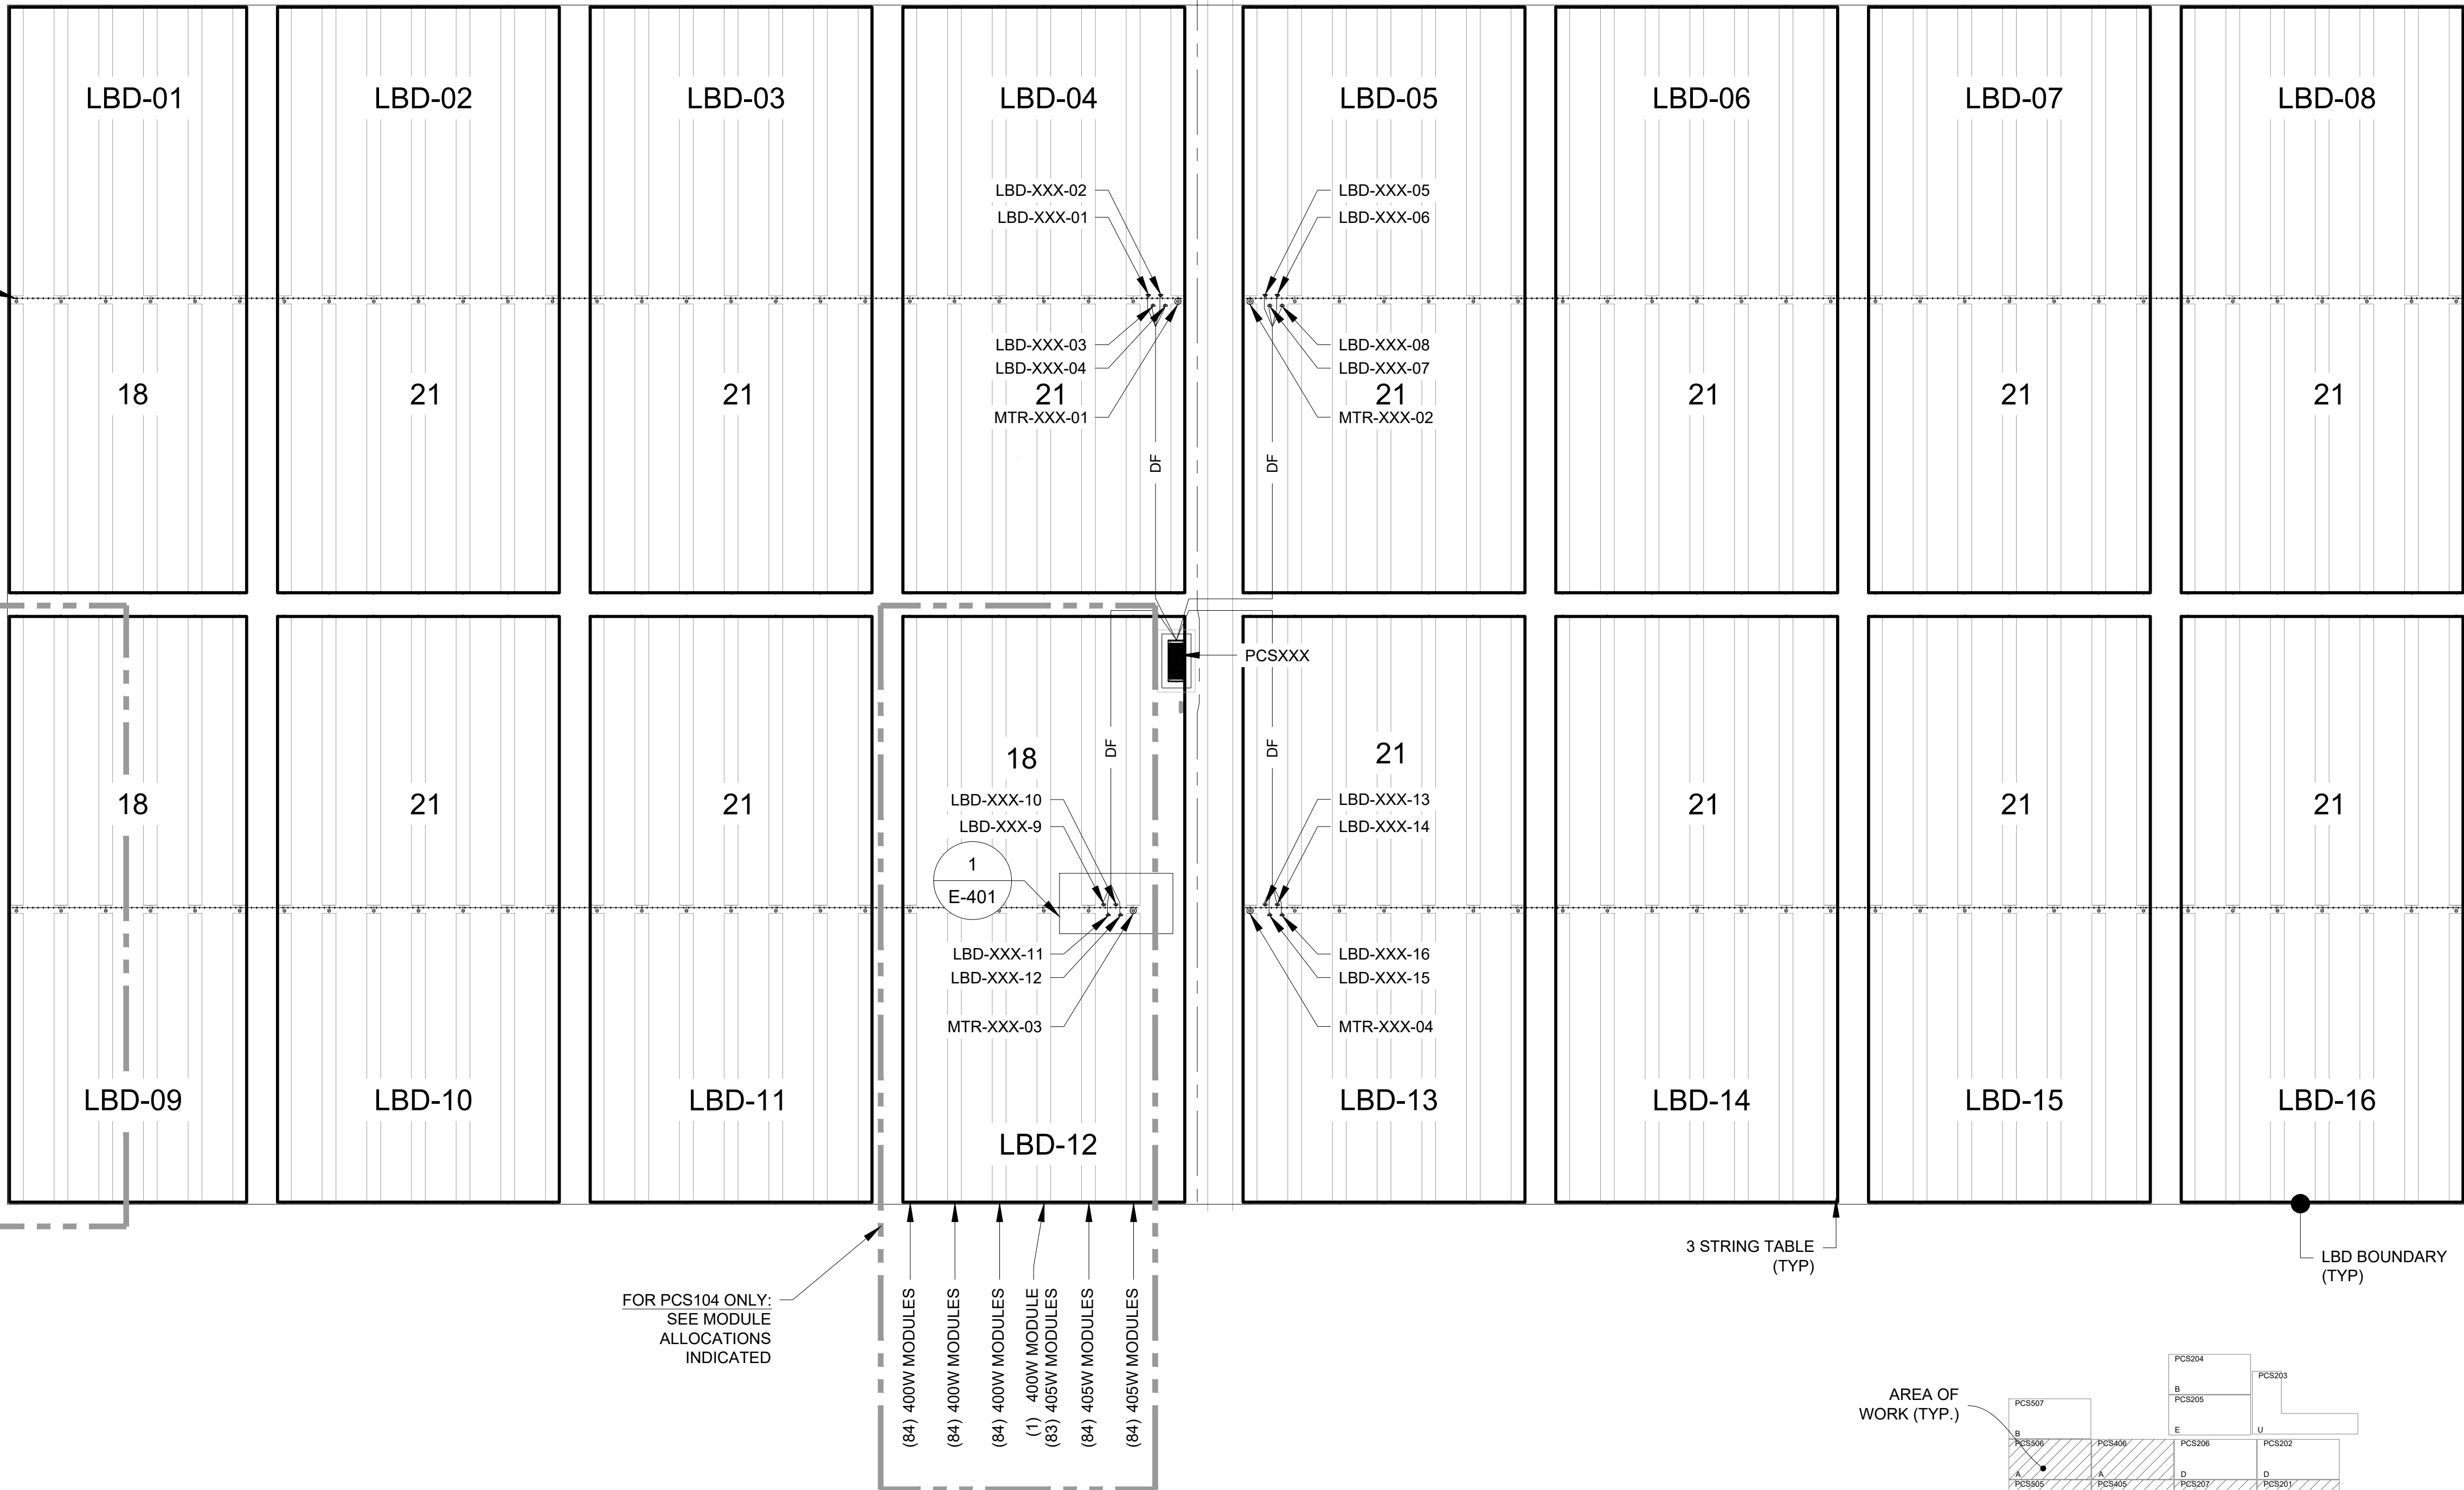

DC PLAN - ARRAY TYPE - A (TRINA)
SCALE: 1"=50'

AREA OF
WORK (TYP.)

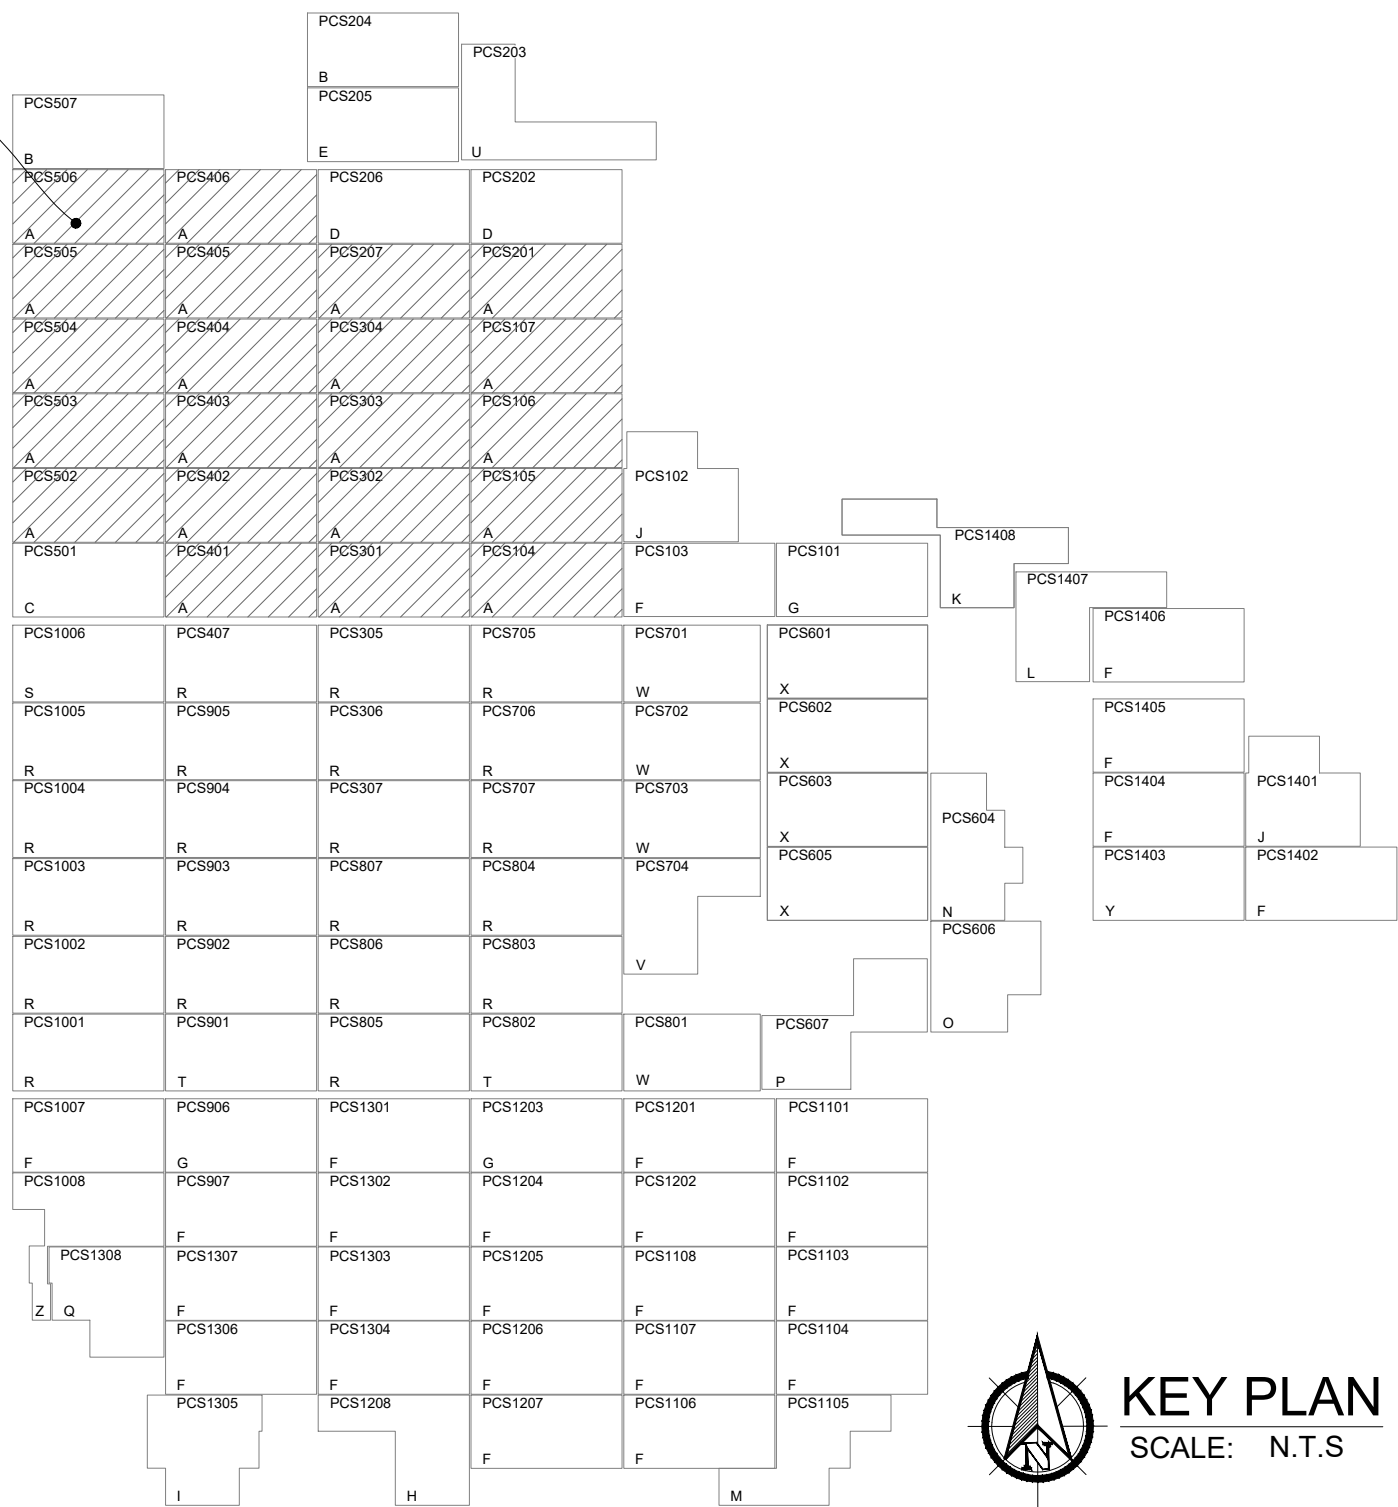

KEY PLAN
SCALE: N.T.S

- NOTES:
- DC FEEDER TAGS ARE SAME AS LBD TAGS EXCEPT SUBSTITUTING 'DF' IN PLACE OF 'LBD'.
 - REFER TO SHEET E-005 - BLOCK SCHEDULE AND SHEET E-011 - MODULE ALLOCATION PLAN FOR SPECIFIC INFORMATION REGARDING MODULE QUANTITIES ASSOCIATED WITH PCS-SPECIFIC ARRAY TYPES.

LEGEND:

— DF — DC FEEDER

— | — HANGER SYSTEM

ARRAY TYPE	ASSOCIATED PCS
A	PCS104 PCS105 PCS106 PCS107 PCS201 PCS207 PCS301 PCS302 PCS303 PCS304 PCS401 PCS402 PCS403 PCS404 PCS405 PCS406 PCS502 PCS503 PCS504 PCS505 PCS506
B	PCS204 PCS507
C	PCS501
D	PCS202 PCS206
E	PCS205
F	PCS103 PCS907 PCS1007 PCS1101 PCS1102 PCS1103 PCS1104 PCS1106 PCS1107 PCS1108 PCS1201 PCS1202 PCS1204 PCS1205 PCS1206 PCS1207 PCS1301 PCS1302 PCS1303 PCS1304 PCS1306 PCS1307 PCS1402 PCS1404 PCS1405 PCS1406
G	PCS101 PCS906 PCS1203
H	PCS1208
I	PCS1305
J	PCS102 PCS1401
K	PCS1408
L	PCS1407
M	PCS1105
N	PCS604
O	PCS606
P	PCS607
Q	PCS1308
R	PCS305 PCS306 PCS307 PCS407 PCS705 PCS706 PCS707 PCS803 PCS804 PCS805 PCS806 PCS807 PCS902 PCS903 PCS904 PCS905 PCS1001 PCS1002 PCS1003 PCS1004 PCS1005
S	PCS1006
T	PCS802 PCS901
U	PCS203
V	PCS704
W	PCS701 PCS702 PCS703 PCS801
X	PCS601 PCS602 PCS603 PCS605
Y	PCS1403
Z	PCS1008



REV	DESCRIPTION	DATE
4	RECORD DRAWINGS	06/08/2023

PROJECT NAME:
**EAGLE SHADOW MOUNTAIN
PV SOLAR POWER
GENERATION FACILITY**

PROJECT ADDRESS:
**I-15
CRYSTAL, NV
CLARK COUNTY**

SEAL:

DATE:
10/16/2020

PROJECT #:
190067.03

DRAWN BY:
NK


CHECKED BY:
EL

SHEET NAME:
**DC PLAN - ARRAY TYPE A
(TRINA)**



SHEET #:
E-401

REV #:
4

RECORD DRAWING

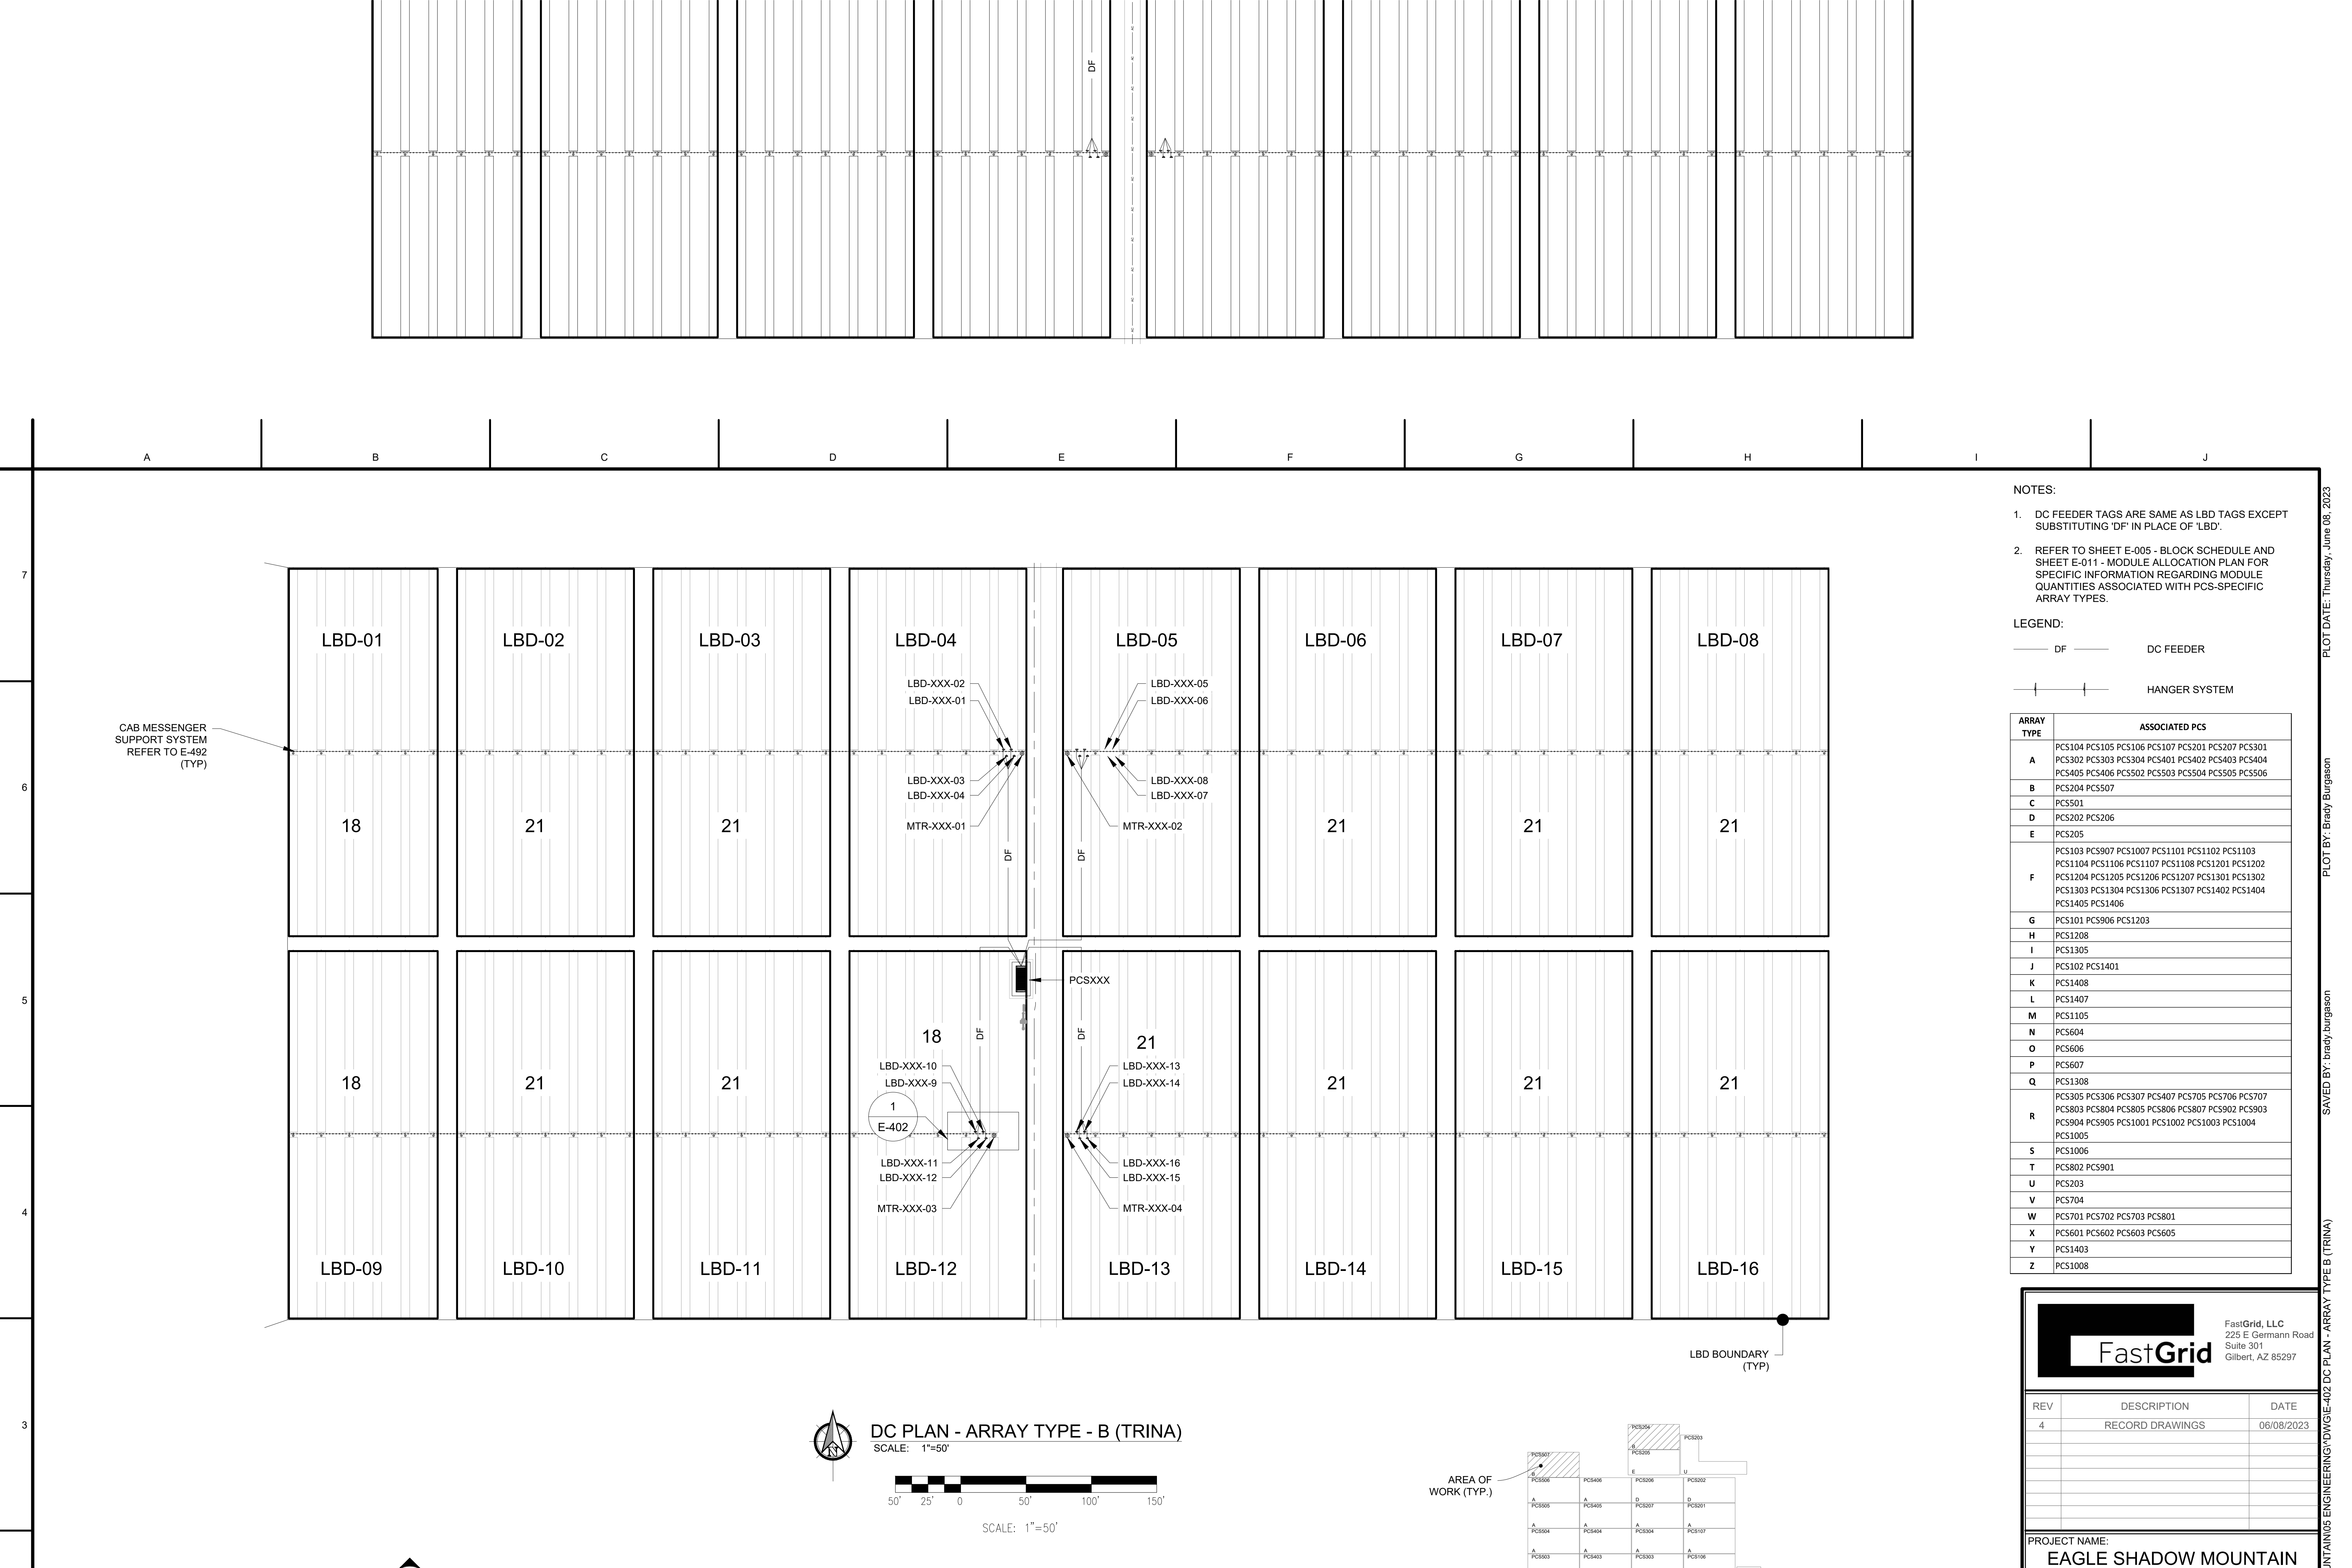


CAB MESSENGER
SUPPORT SYSTEM
REFER TO E-492
(TYP)

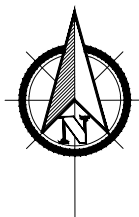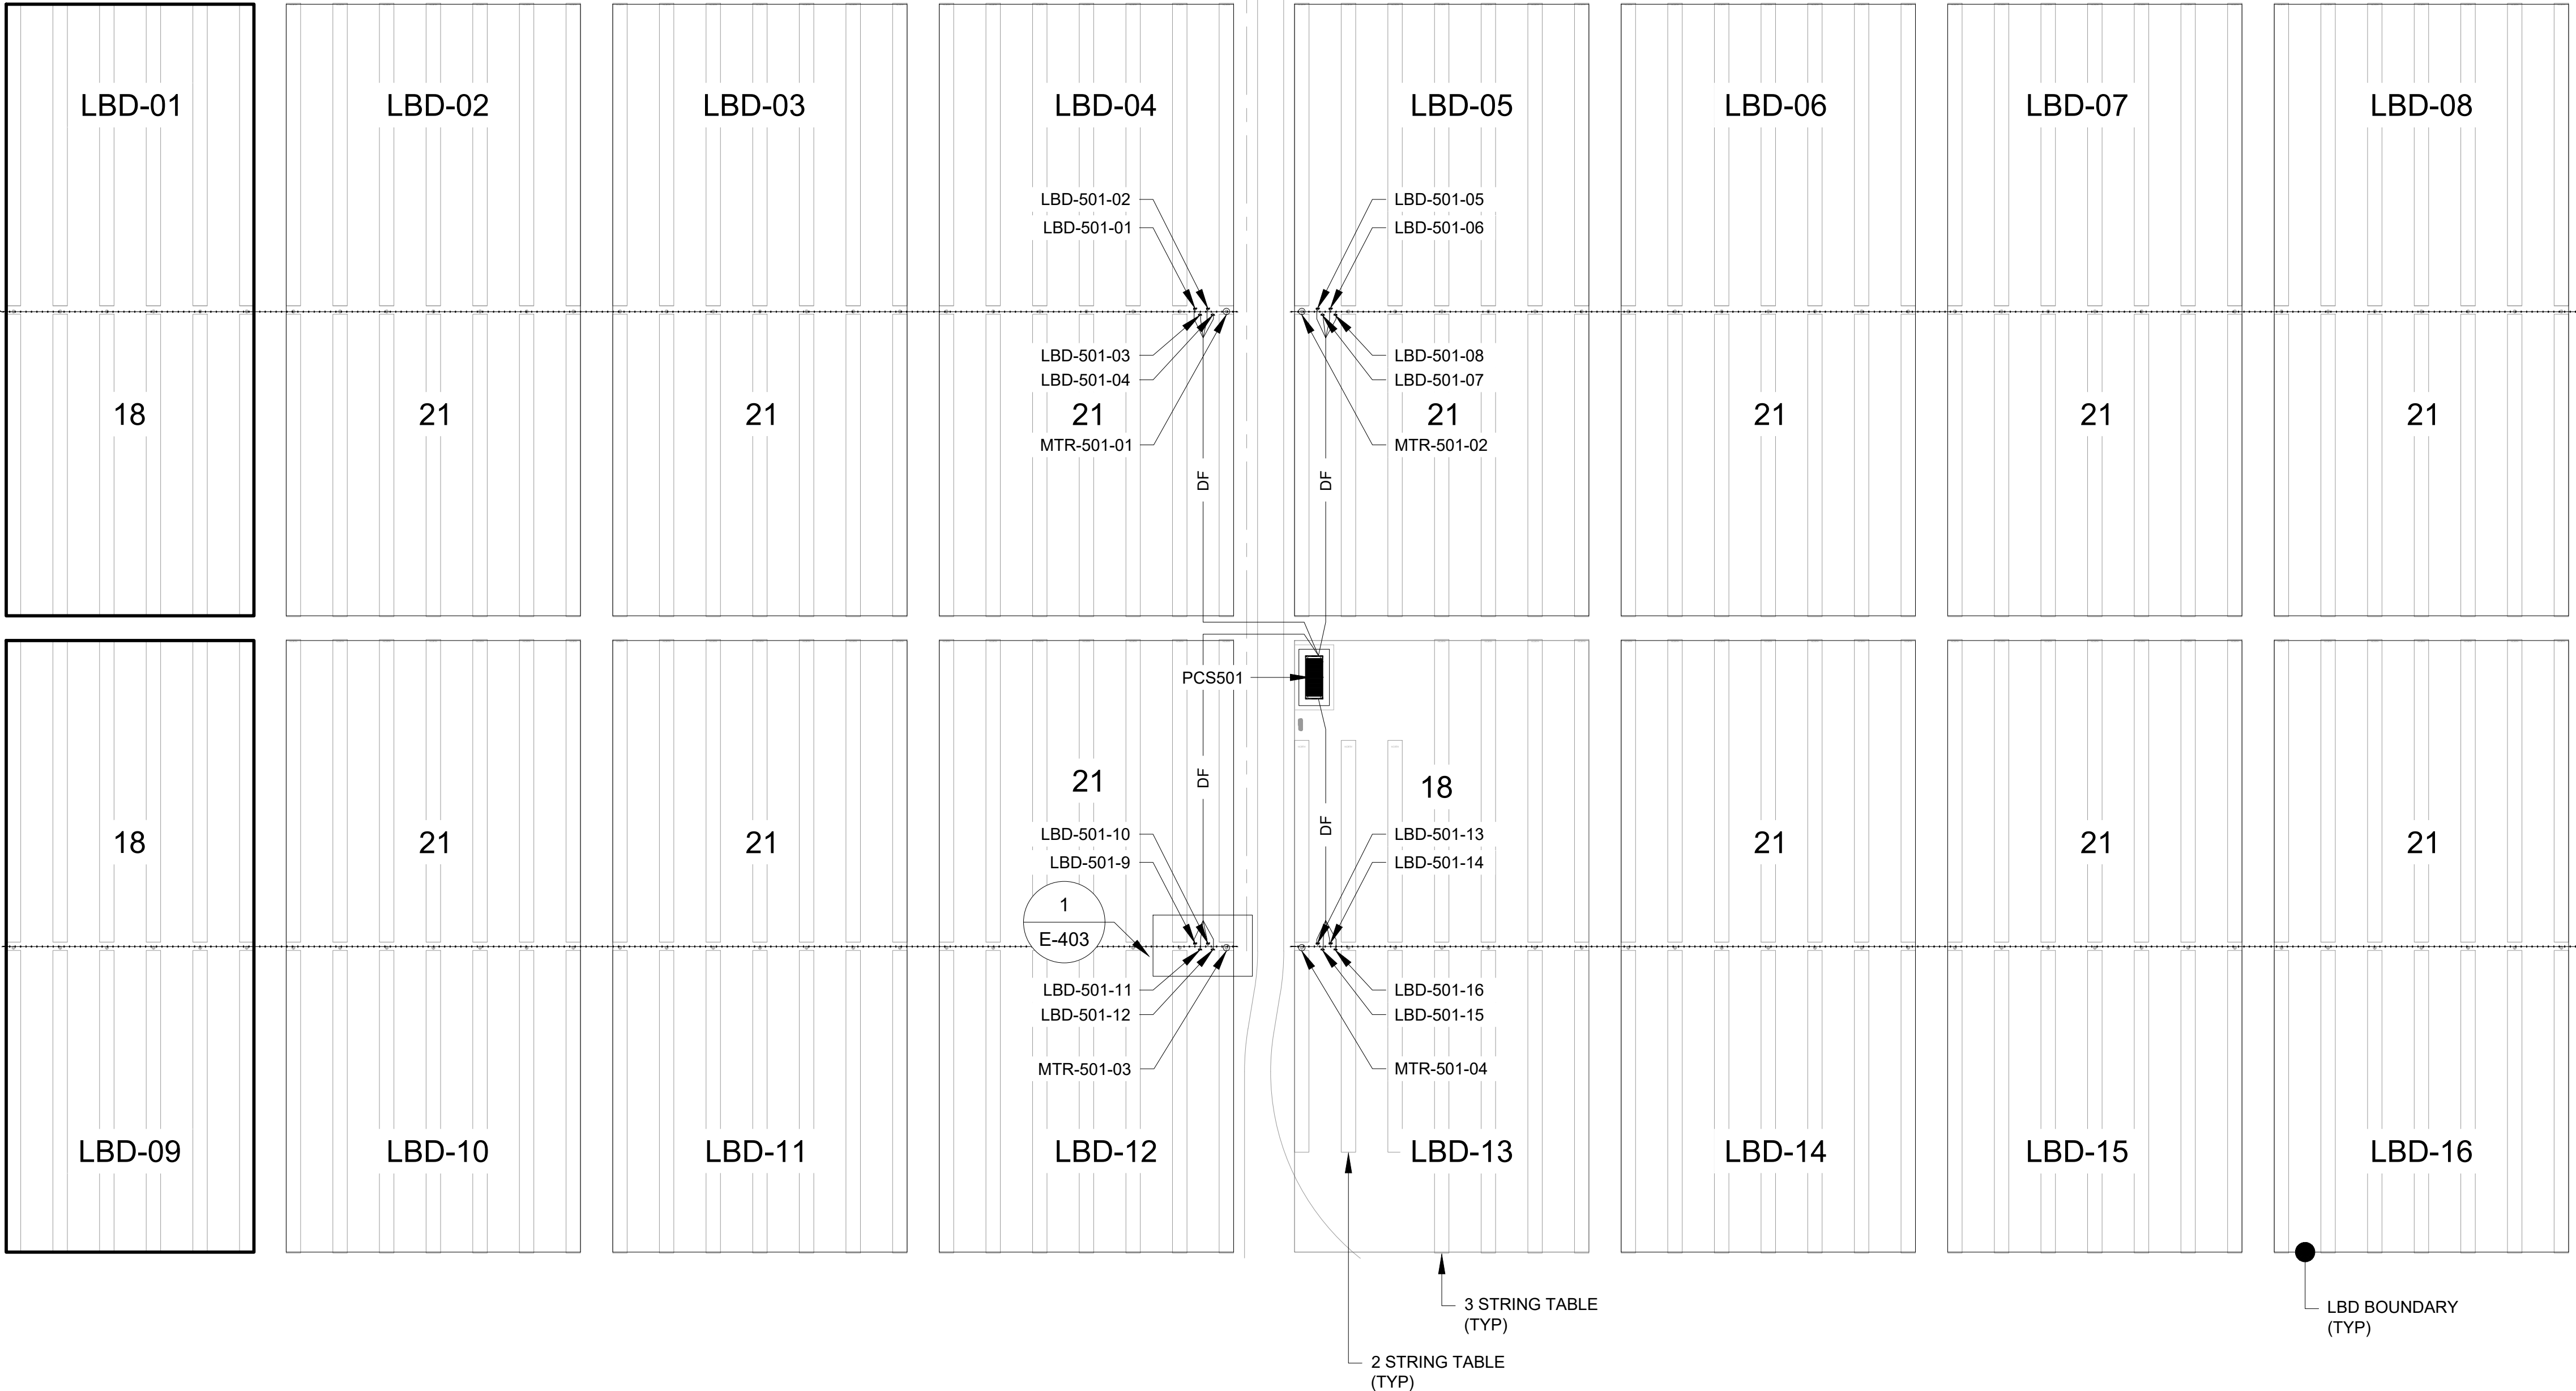


DC PLAN - ARRAY TYPE - C (TRINA)

SCALE: 1"=50'


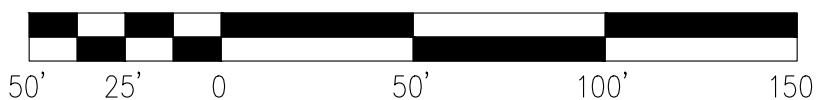


SCALE: 1"=50'

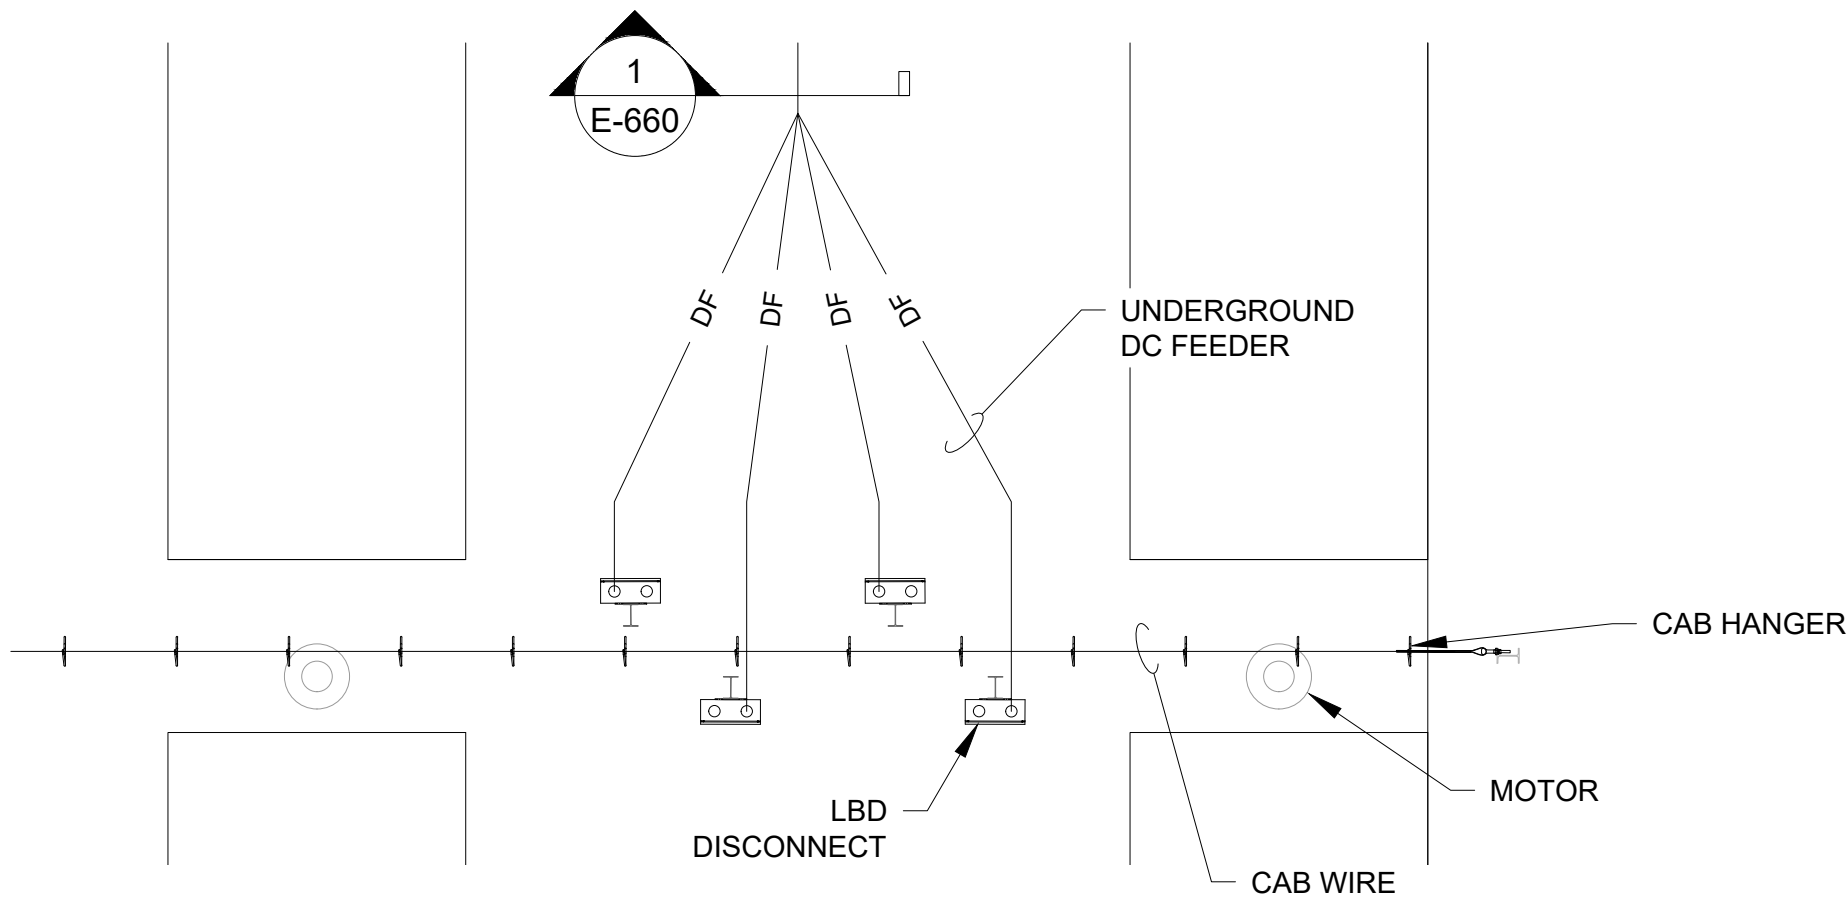

1 LBD LAYOUT DETAIL

AREA OF
WORK (TYP.)

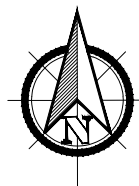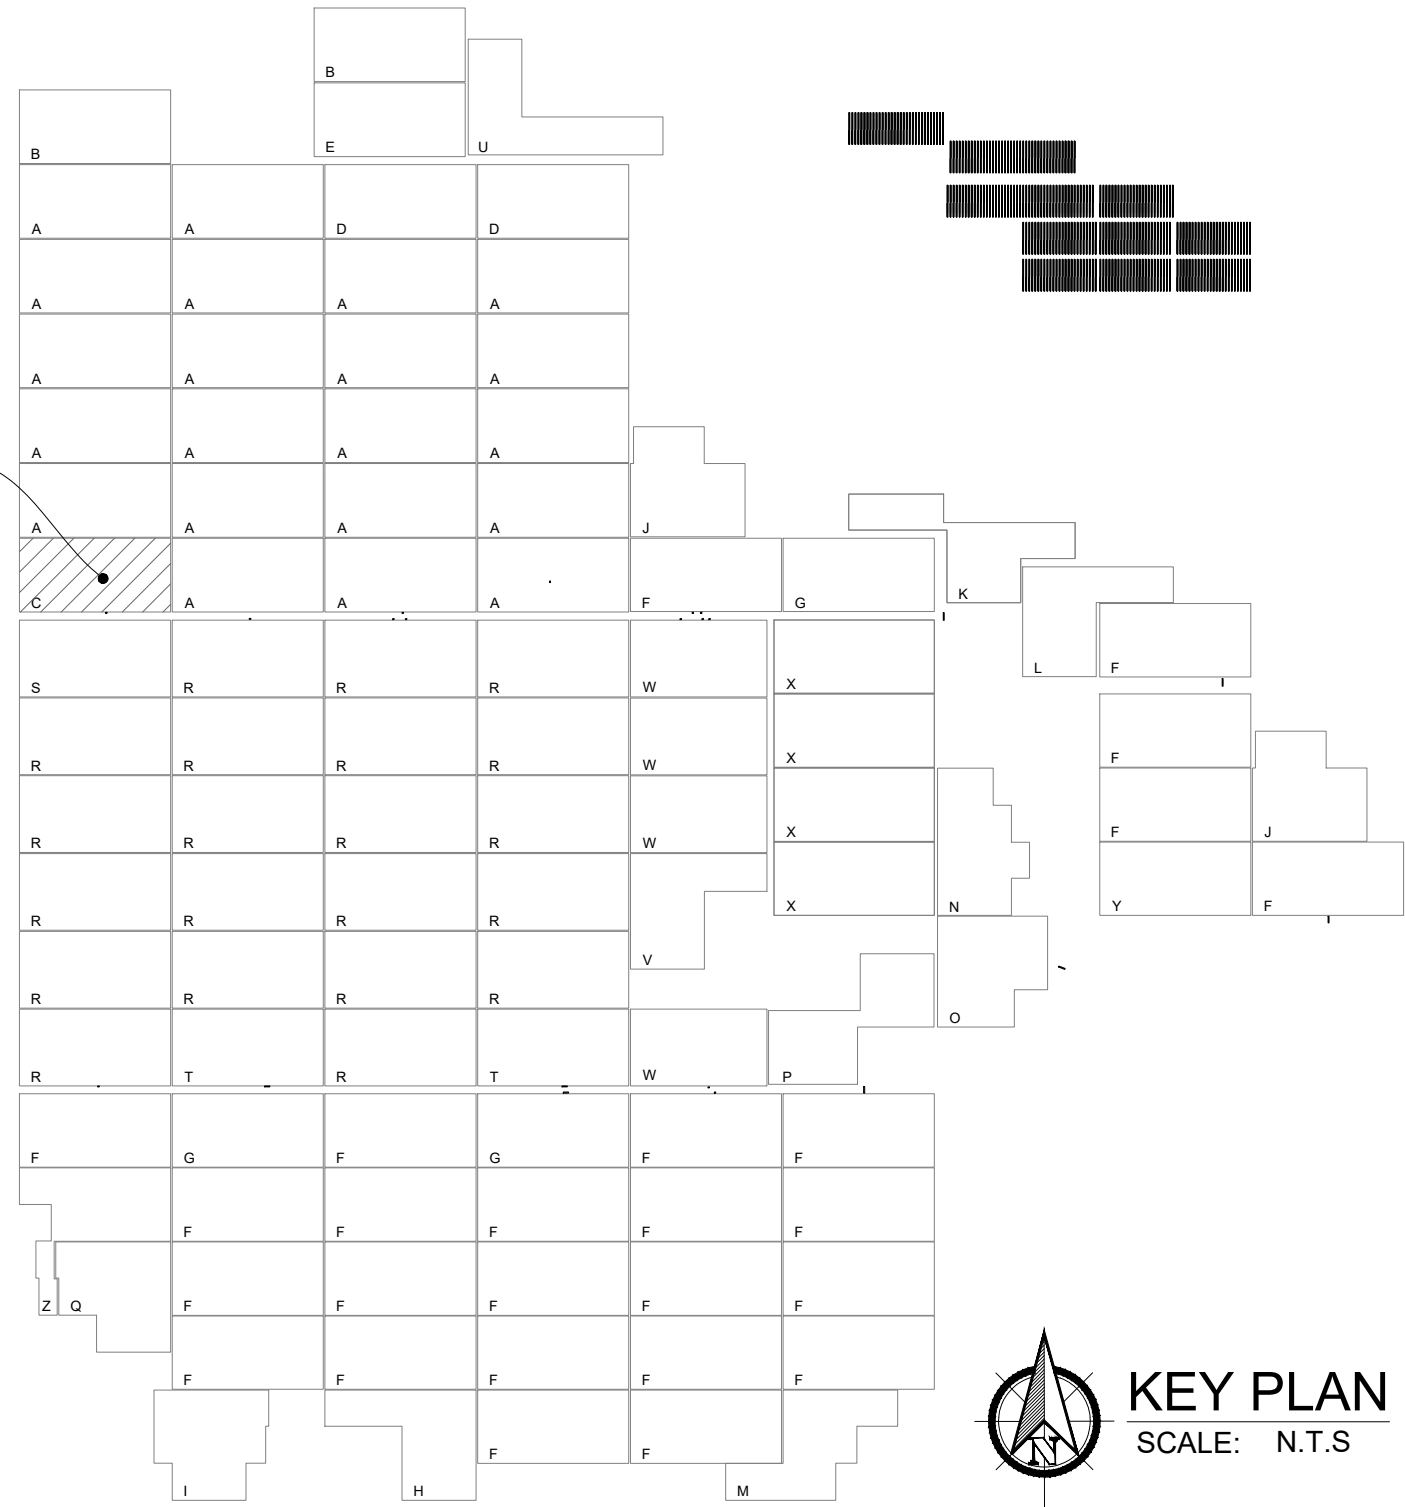

KEY PLAN
SCALE: N.T.S

NOTES:

- DC FEEDER TAGS ARE SAME AS LBD TAGS EXCEPT SUBSTITUTING 'DF' IN PLACE OF 'LBD'.
- REFER TO SHEET E-005 - BLOCK SCHEDULE AND SHEET E-011 - MODULE ALLOCATION PLAN FOR SPECIFIC INFORMATION REGARDING MODULE QUANTITIES ASSOCIATED WITH PCS-SPECIFIC ARRAY TYPES.

LEGEND:

— DF —

ARRAY TYPE	ASSOCIATED PCS
A	PCS104 PCS105 PCS106 PCS107 PCS201 PCS207 PCS301 PCS302 PCS303 PCS304 PCS401 PCS402 PCS403 PCS404 PCS405 PCS406 PCS502 PCS503 PCS504 PCS505 PCS506
B	PCS204 PCS507
C	PCS501
D	PCS202 PCS206
E	PCS205
F	PCS103 PCS907 PCS1007 PCS1101 PCS1102 PCS1103 PCS1104 PCS1106 PCS1107 PCS1108 PCS1201 PCS1202 PCS1204 PCS1205 PCS1206 PCS1207 PCS1301 PCS1302 PCS1303 PCS1304 PCS1306 PCS1307 PCS1402 PCS1404 PCS1405 PCS1406
G	PCS101 PCS906 PCS1203
H	PCS1208
I	PCS1305
J	PCS102 PCS1401
K	PCS1408
L	PCS1407
M	PCS1105
N	PCS604
O	PCS606
P	PCS607
Q	PCS1308
R	PCS305 PCS306 PCS307 PCS407 PCS705 PCS706 PCS707 PCS803 PCS804 PCS805 PCS806 PCS807 PCS902 PCS903 PCS904 PCS905 PCS1001 PCS1002 PCS1003 PCS1004 PCS1005
S	PCS1006
T	PCS802 PCS901
U	PCS203
V	PCS704
W	PCS701 PCS702 PCS703 PCS801
X	PCS601 PCS602 PCS603 PCS605
Y	PCS1403
Z	PCS1008



FastGrid, LLC
225 E Germann Road
Suite 301
Gilbert, AZ 85297

REV	DESCRIPTION	DATE
4	RECORD DRAWINGS	06/08/2023

PROJECT NAME:
**EAGLE SHADOW MOUNTAIN
PV SOLAR POWER
GENERATION FACILITY**

PROJECT ADDRESS:
**I-15
CRYSTAL, NV
CLARK COUNTY**



SEAL:	DATE: 10/16/2020
	PROJECT #: 190067.03
	DRAWN BY: NK
	CHECKED BY: EL

SHEET NAME:
DC PLAN - ARRAY TYPE C (TRINA)

SHEET #: E-403	REV #: 4
--------------------------	--------------------


RECORD DRAWING

CAB MESSENGER
SUPPORT SYSTEM
REFER TO E-492
(TYP)

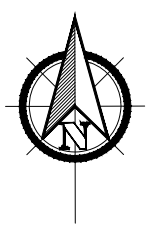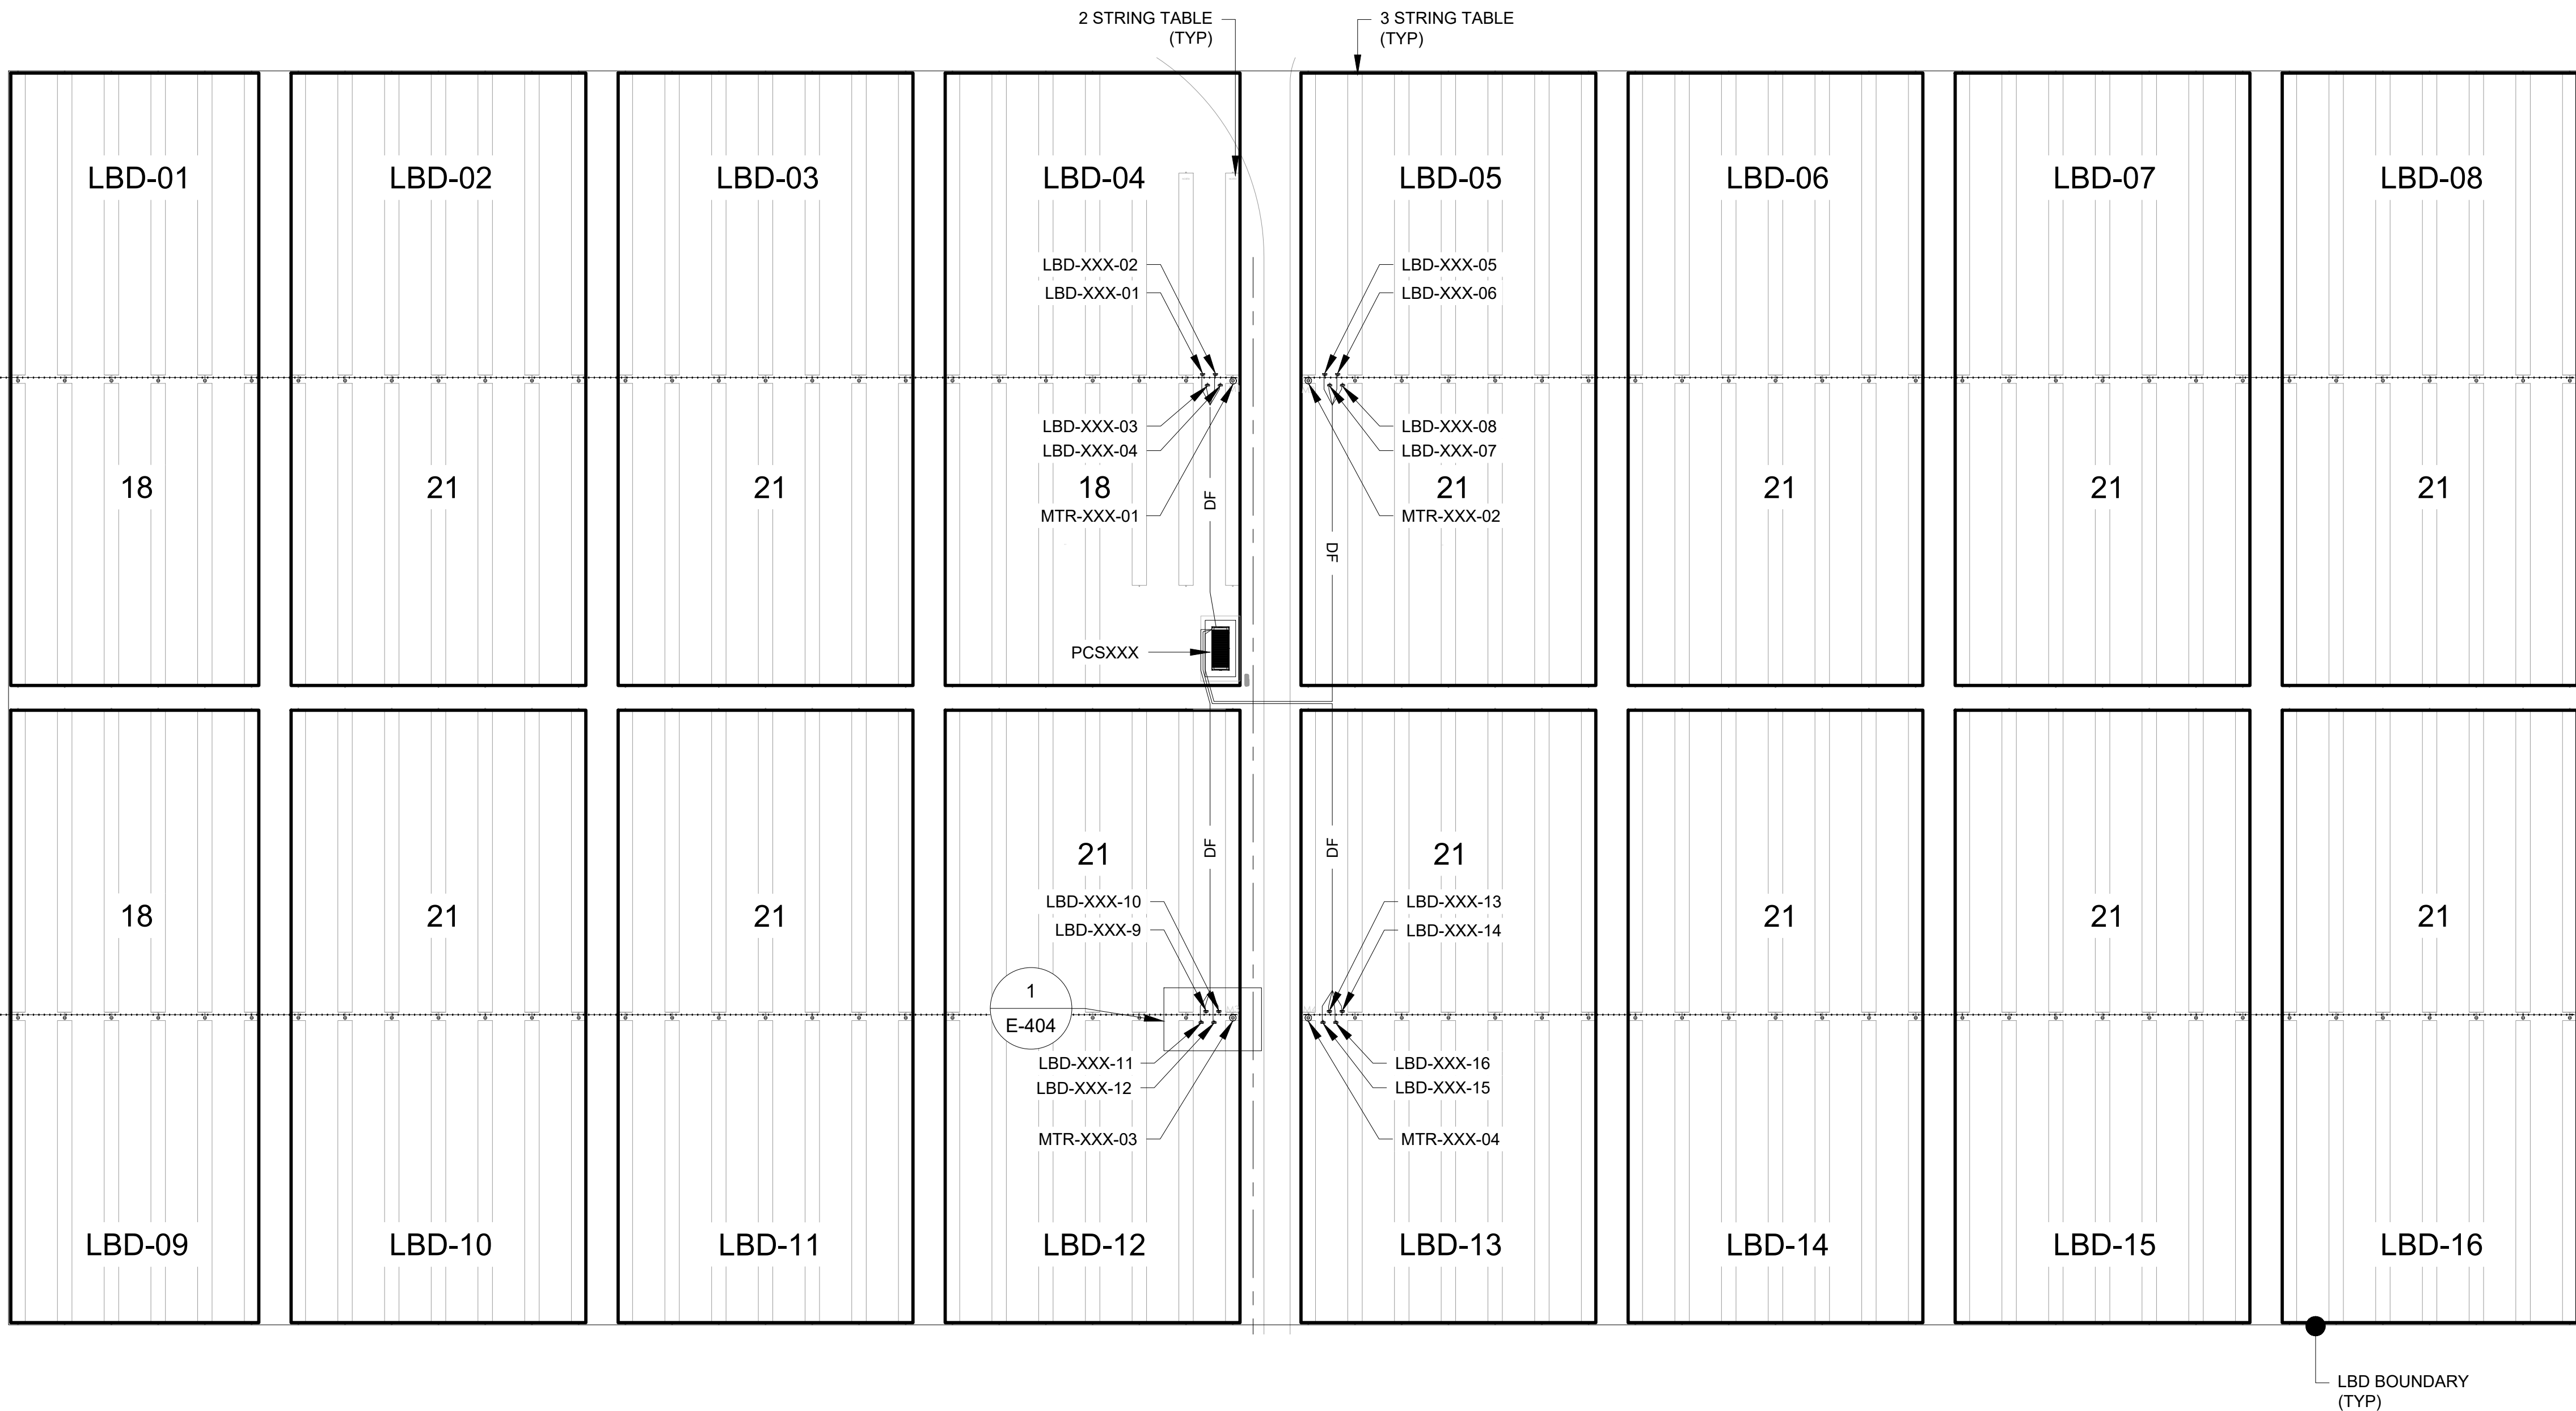


DC PLAN - ARRAY TYPE - D (TRINA)

SCALE: 1"=50'

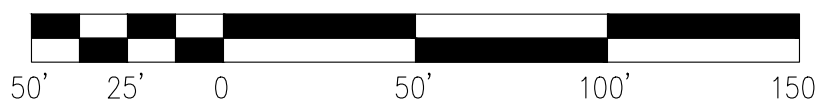

SCALE: 1"=50'

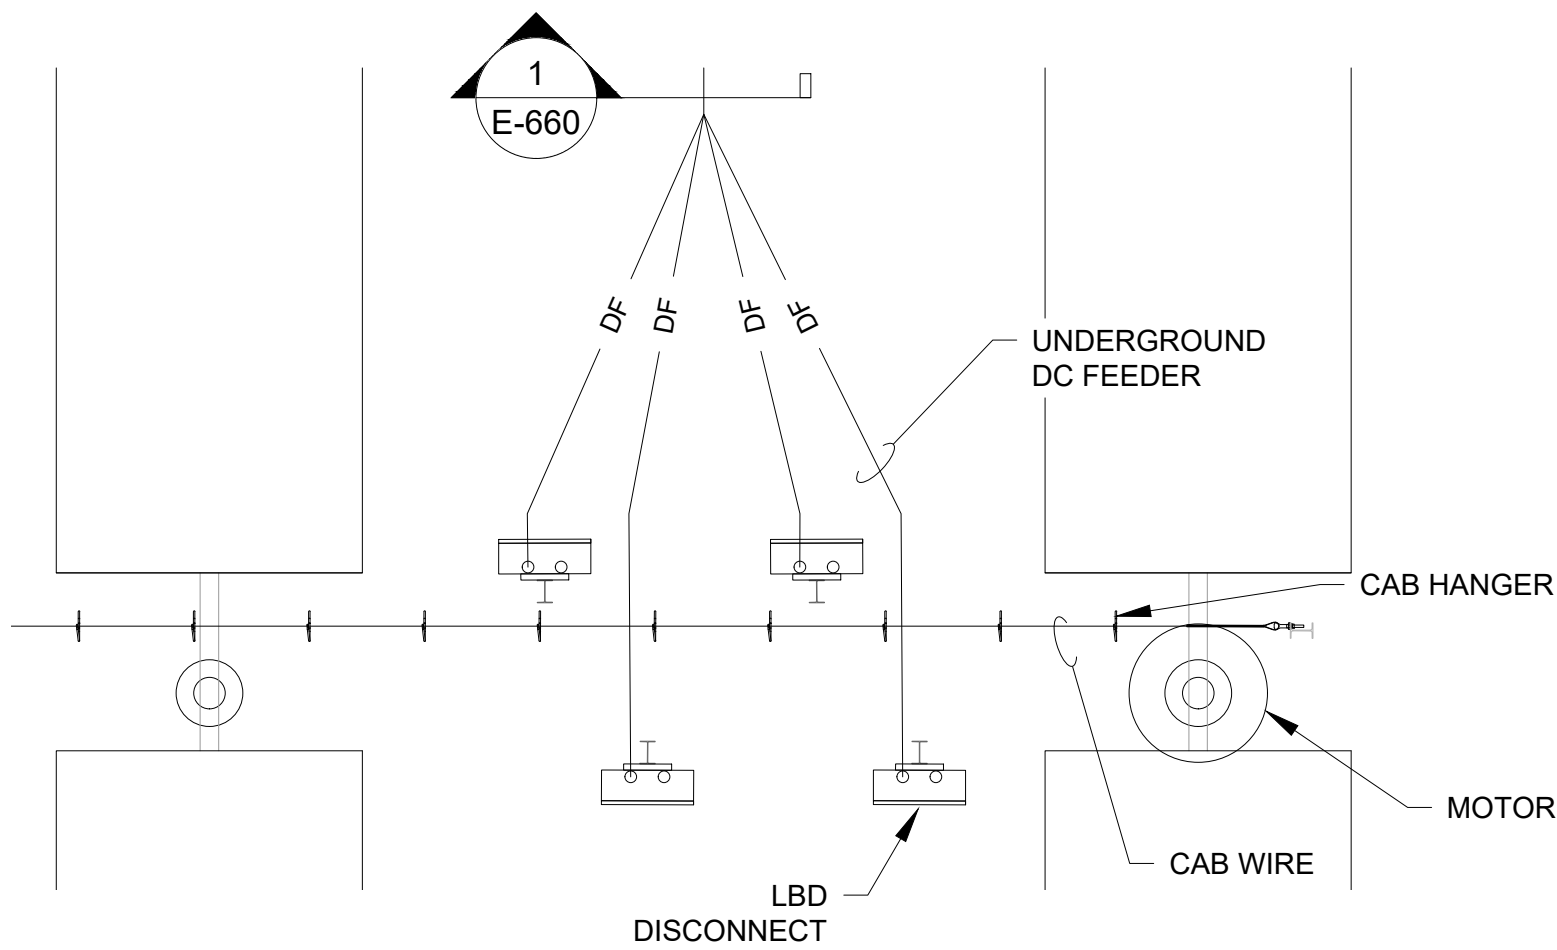

1 LBD LAYOUT DETAIL

NOTES:

- DC FEEDER TAGS ARE SAME AS LBD TAGS EXCEPT SUBSTITUTING 'DF' IN PLACE OF 'LBD'.
- REFER TO SHEET E-005 - BLOCK SCHEDULE AND SHEET E-011 - MODULE ALLOCATION PLAN FOR SPECIFIC INFORMATION REGARDING MODULE QUANTITIES ASSOCIATED WITH PCS-SPECIFIC ARRAY TYPES.

LEGEND:

DF DC FEEDER

HANGER SYSTEM

ARRAY TYPE	ASSOCIATED PCS
A	PCS104 PCS105 PCS106 PCS107 PCS201 PCS207 PCS301 PCS302 PCS303 PCS304 PCS401 PCS402 PCS403 PCS404 PCS405 PCS406 PCS502 PCS503 PCS504 PCS505 PCS506
B	PCS204 PCS507
C	PCS501
D	PCS202 PCS206
E	PCS205
F	PCS103 PCS907 PCS1007 PCS1101 PCS1102 PCS1103 PCS1104 PCS1106 PCS1107 PCS1108 PCS1201 PCS1202 PCS1204 PCS1205 PCS1206 PCS1207 PCS1301 PCS1302 PCS1303 PCS1304 PCS1306 PCS1307 PCS1402 PCS1404 PCS1405 PCS1406
G	PCS101 PCS906 PCS1203
H	PCS1208
I	PCS1305
J	PCS102 PCS1401
K	PCS1408
L	PCS1407
M	PCS1105
N	PCS604
O	PCS606
P	PCS607
Q	PCS1308
R	PCS305 PCS306 PCS307 PCS407 PCS705 PCS706 PCS707 PCS803 PCS804 PCS805 PCS806 PCS807 PCS902 PCS903 PCS904 PCS905 PCS1001 PCS1002 PCS1003 PCS1004 PCS1005
S	PCS1006
T	PCS802 PCS901
U	PCS203
V	PCS704
W	PCS701 PCS702 PCS703 PCS801
X	PCS601 PCS602 PCS603 PCS605
Y	PCS1403
Z	PCS1008



FastGrid, LLC
225 E Germann Road
Suite 301
Gilbert, AZ 85297

REV	DESCRIPTION	DATE
4	RECORD DRAWINGS	06/08/2023

PROJECT NAME:
**EAGLE SHADOW MOUNTAIN
PV SOLAR POWER
GENERATION FACILITY**


PROJECT ADDRESS:
**I-15
CRYSTAL, NV
CLARK COUNTY**

SEAL: DATE: **10/16/2020**
PROJECT #:
190067.03
DRAWN BY:
NK
CHECKED BY:
EL

SHEET NAME:
DC PLAN - ARRAY TYPE D (TRINA)



SHEET #:
E-404

REV #:
4

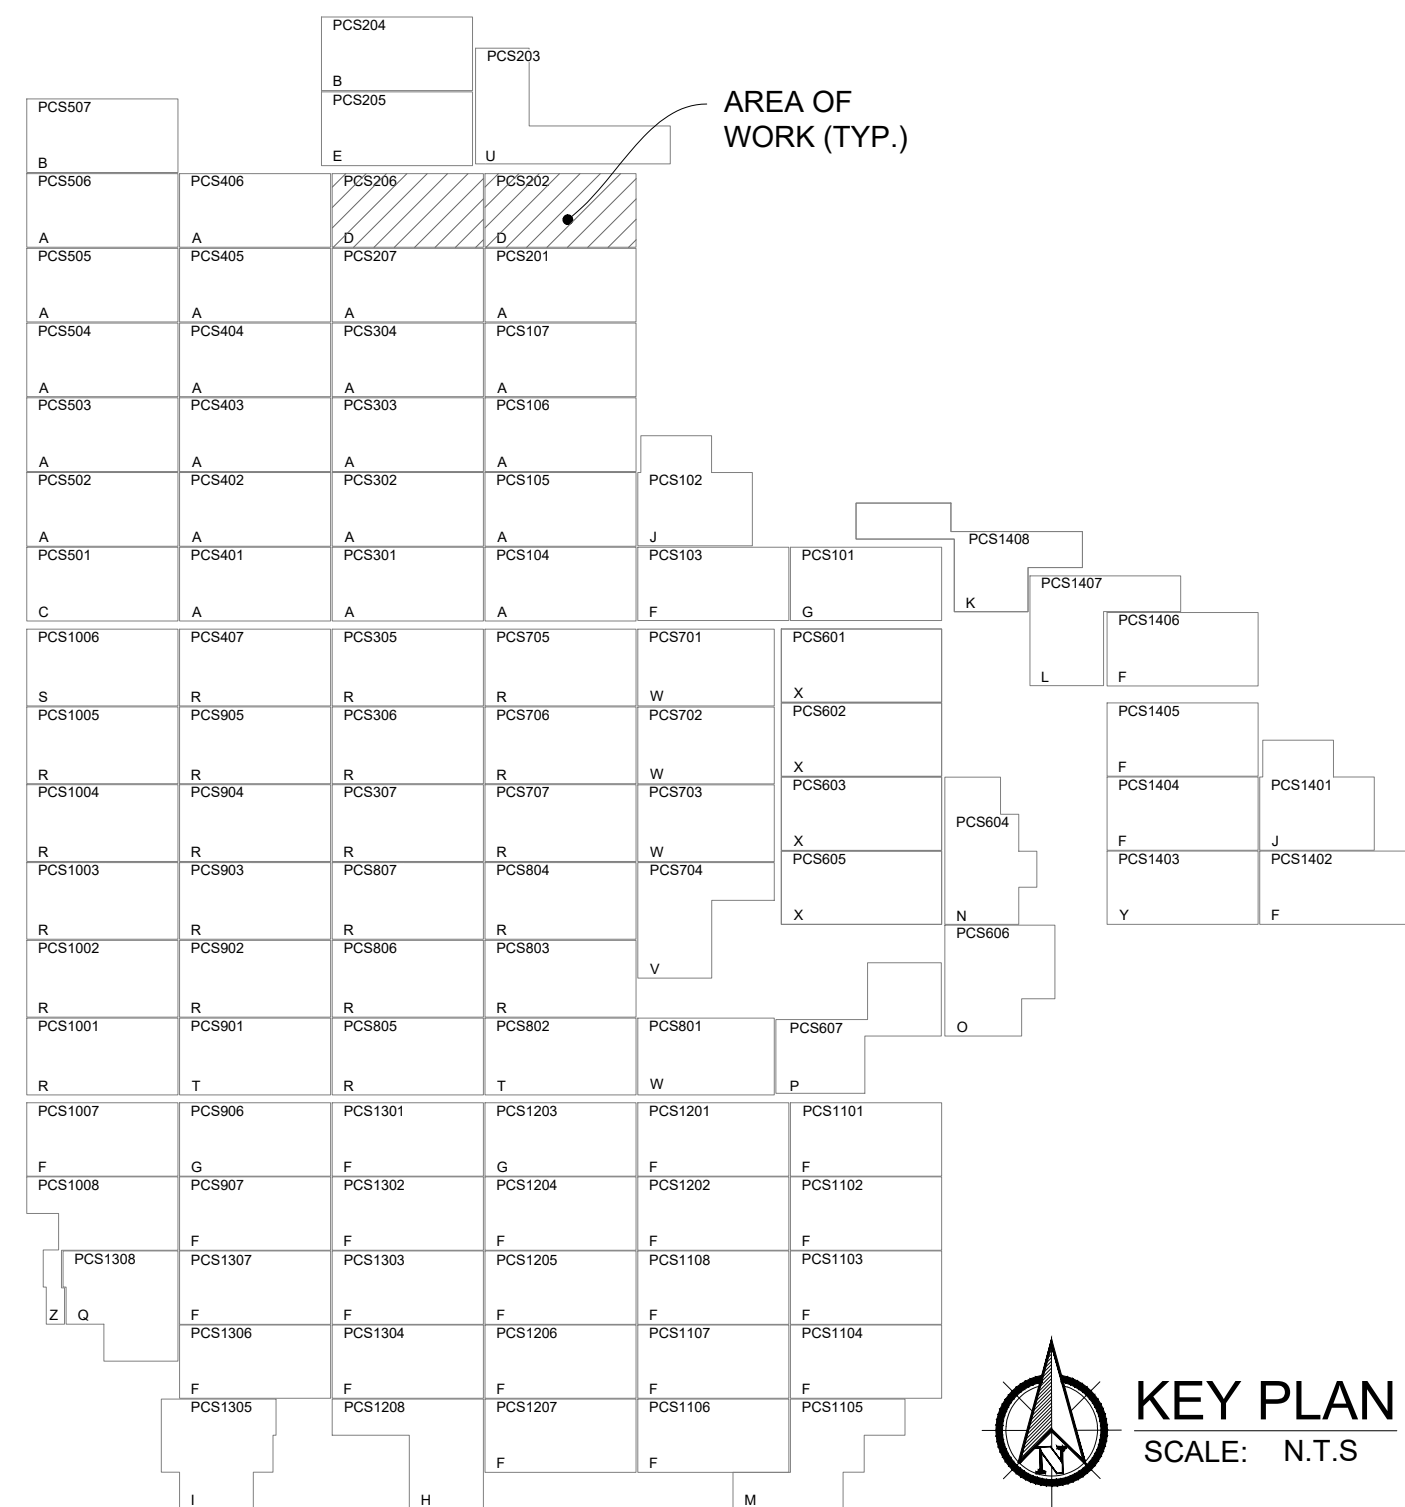


KEY PLAN
SCALE: N.T.S


RECORD DRAWING

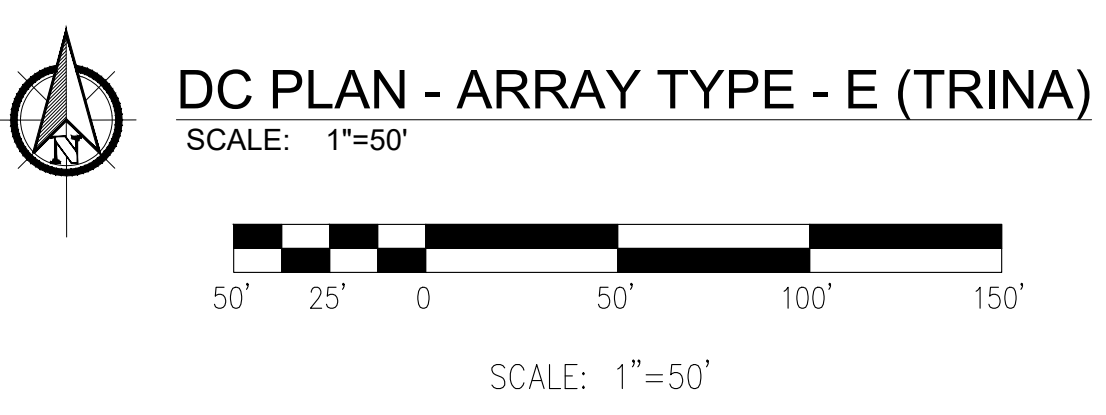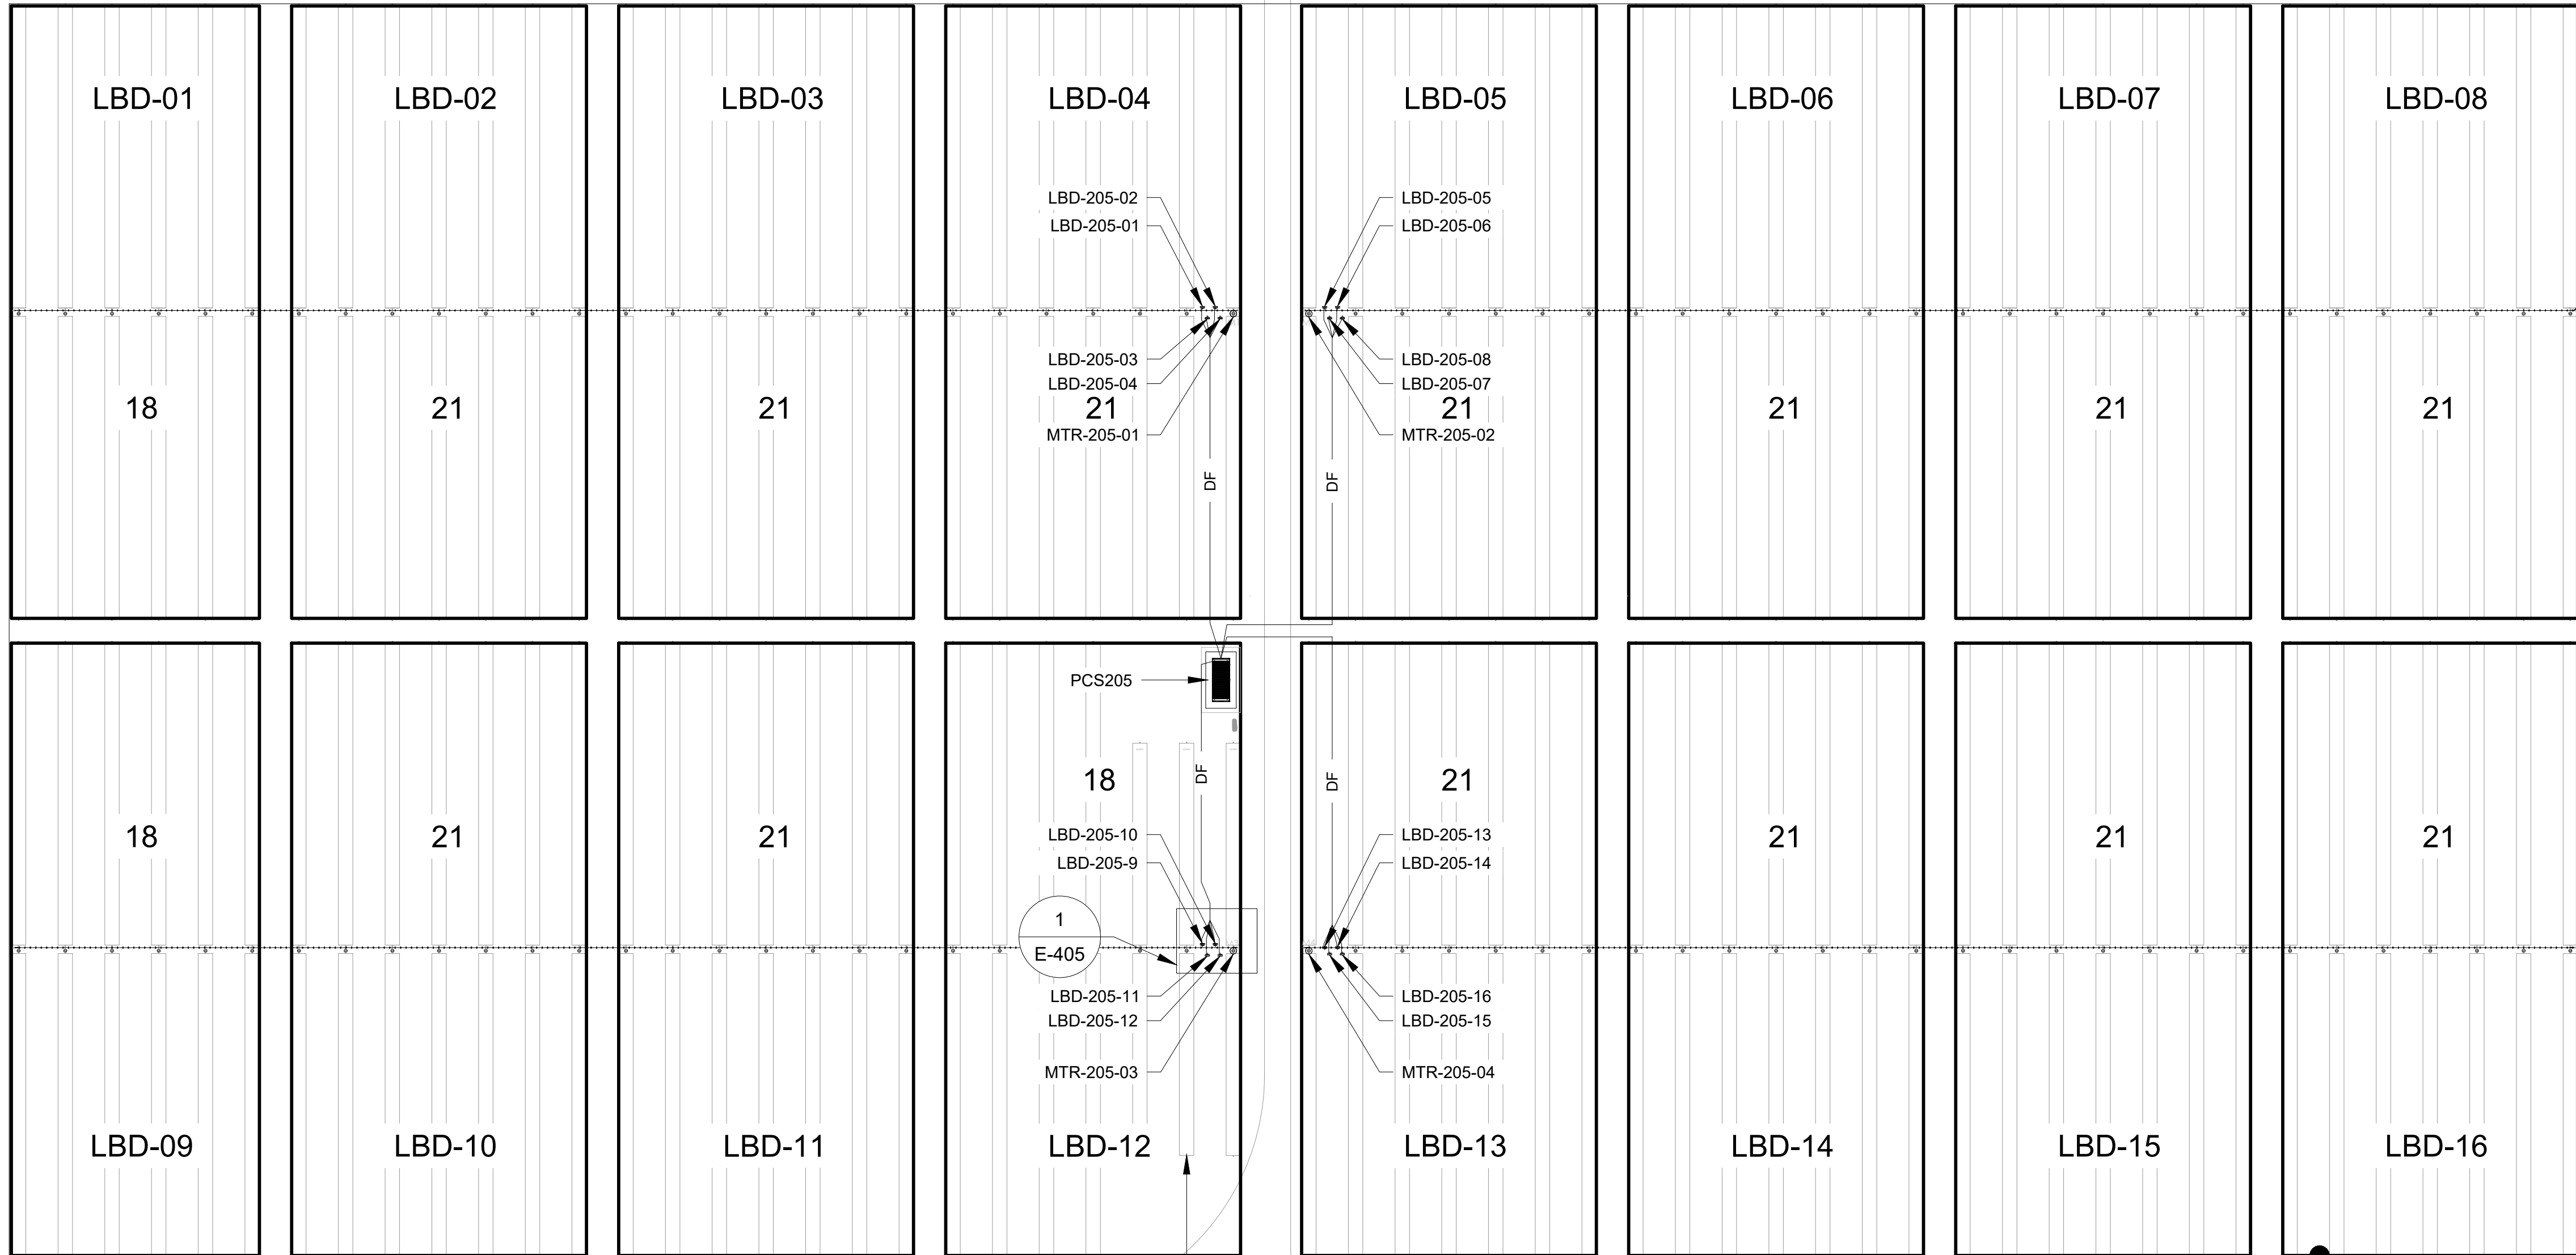

DC PLAN - ARRAY TYPE - E (TRINA)
SCALE: 1"=50'

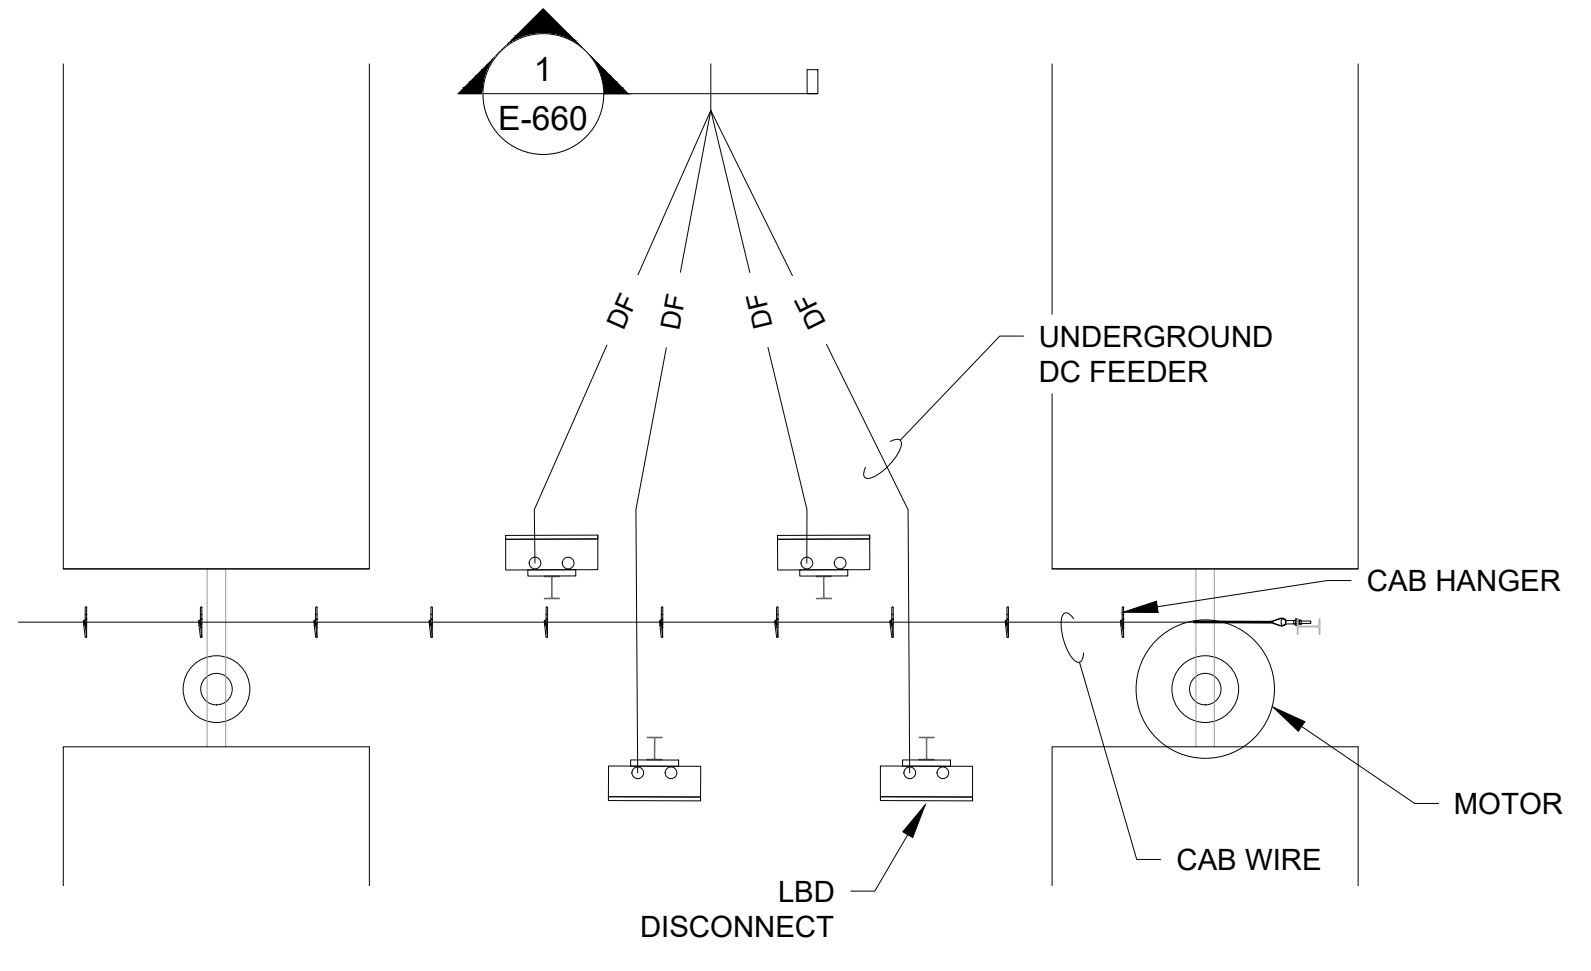

1 LBD LAYOUT DETAIL

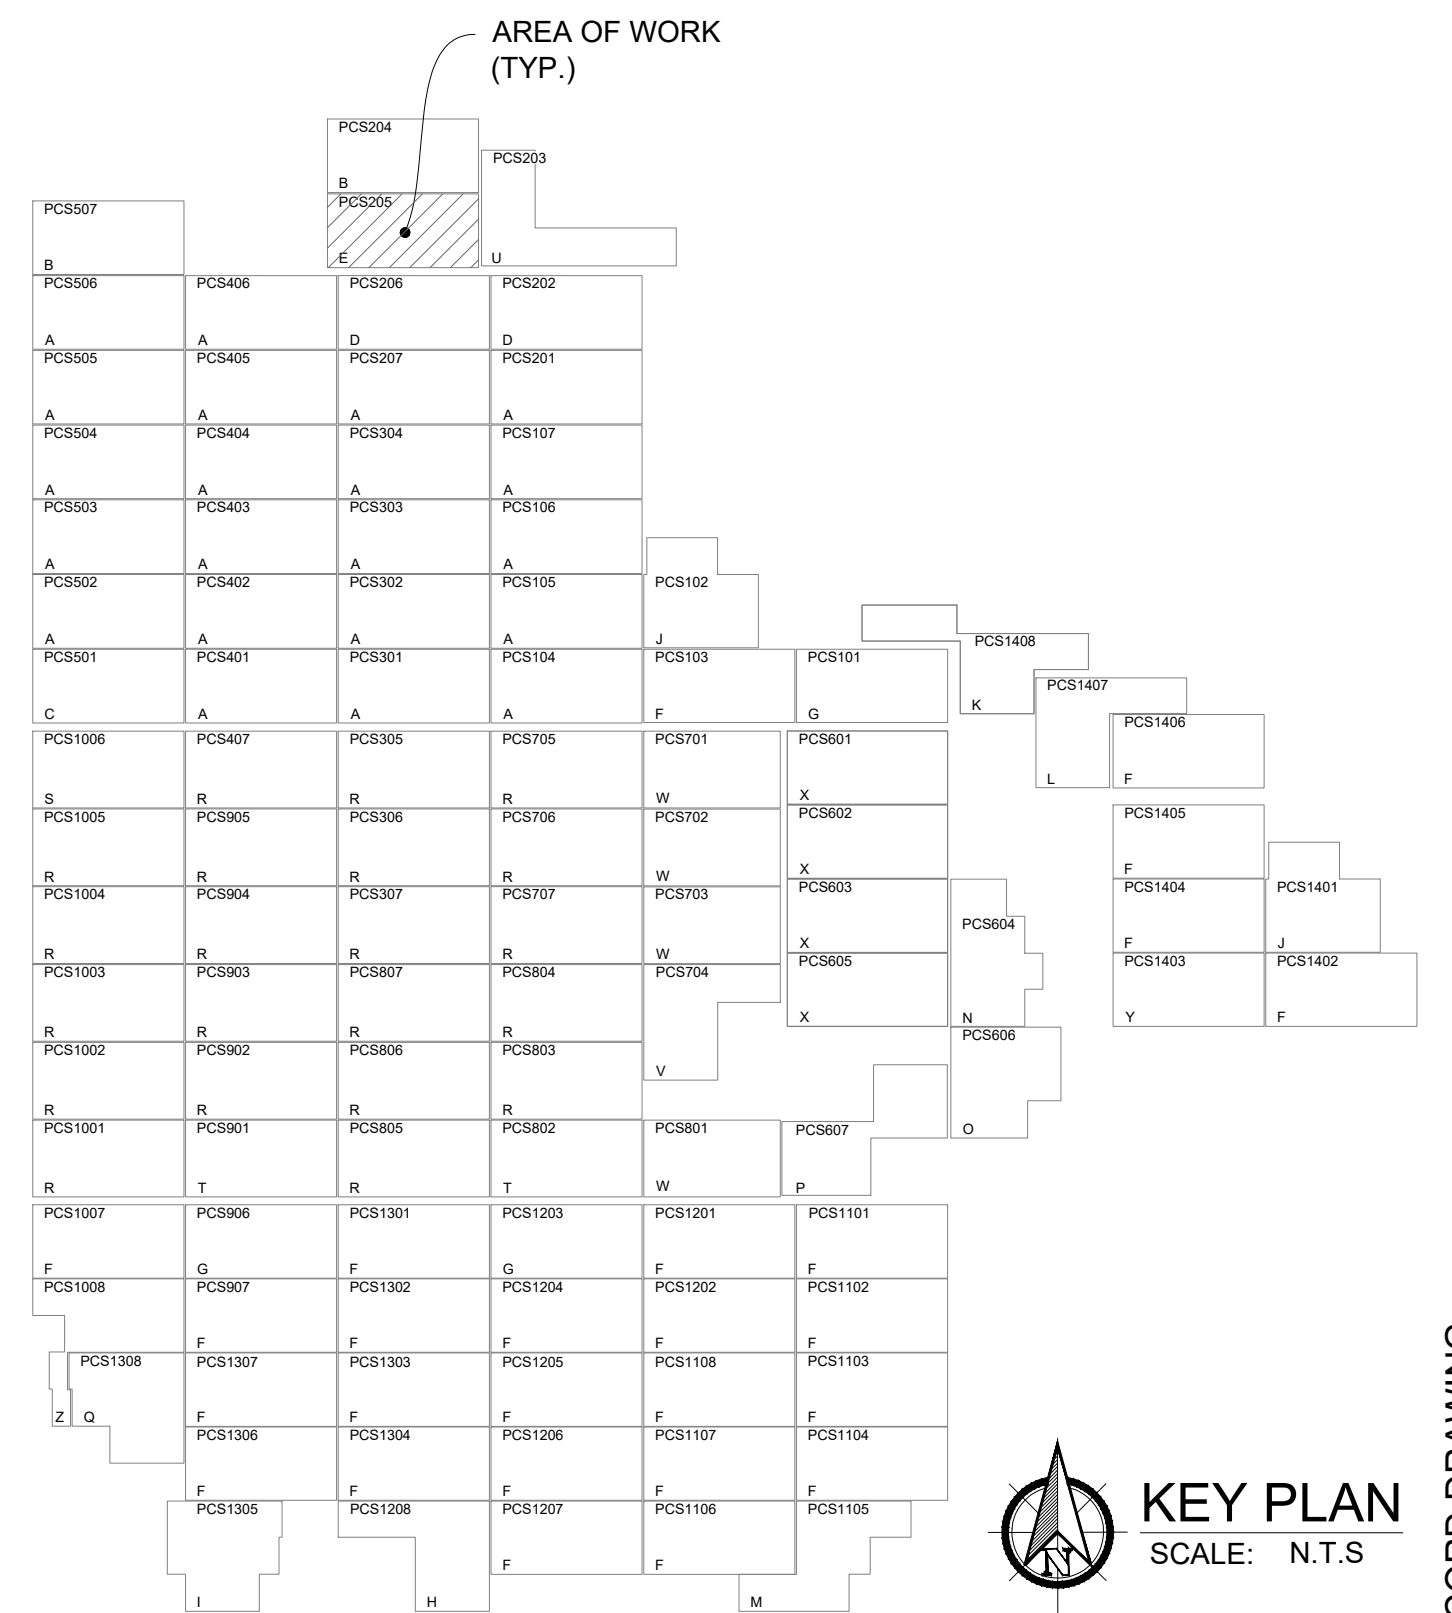

- NOTES:
- DC FEEDER TAGS ARE SAME AS LBD TAGS EXCEPT SUBSTITUTING 'DF' IN PLACE OF 'LBD'.
 - REFER TO SHEET E-011 - BLOCK SCHEDULE AND SHEET E-011 - MODULE ALLOCATION PLAN FOR SPECIFIC INFORMATION REGARDING MODULE QUANTITIES ASSOCIATED WITH PCS-SPECIFIC ARRAY TYPES.

- LEGEND:
- DF DC FEEDER
 - HANGER SYSTEM

ARRAY TYPE	ASSOCIATED PCS
A	PCS104 PCS105 PCS106 PCS107 PCS201 PCS207 PCS301 PCS302 PCS303 PCS304 PCS401 PCS402 PCS403 PCS404 PCS405 PCS406 PCS502 PCS503 PCS504 PCS505 PCS506
B	PCS204 PCS507
C	PCS501
D	PCS202 PCS206
E	PCS205
F	PCS103 PCS907 PCS1007 PCS1101 PCS1102 PCS1103 PCS1104 PCS1106 PCS1107 PCS1108 PCS1201 PCS1202 PCS1204 PCS1205 PCS1206 PCS1207 PCS1301 PCS1302 PCS1303 PCS1304 PCS1306 PCS1307 PCS1402 PCS1404 PCS1405 PCS1406
G	PCS101 PCS906 PCS1203
H	PCS1208
I	PCS1305
J	PCS102 PCS1401
K	PCS1408
L	PCS1407
M	PCS1105
N	PCS604
O	PCS606
P	PCS607
Q	PCS1308
R	PCS305 PCS306 PCS307 PCS407 PCS705 PCS706 PCS707 PCS803 PCS804 PCS805 PCS806 PCS807 PCS902 PCS903 PCS904 PCS905 PCS1001 PCS1002 PCS1003 PCS1004 PCS1005
S	PCS1006
T	PCS802 PCS901
U	PCS203
V	PCS704
W	PCS701 PCS702 PCS703 PCS801
X	PCS601 PCS602 PCS603 PCS605
Y	PCS1403
Z	PCS1008

FastGrid, LLC
225 E Germann Road
Suite 301
Gilbert, AZ 85297

REV	DESCRIPTION	DATE
4	RECORD DRAWINGS	06/08/2023


PROJECT NAME:
**EAGLE SHADOW MOUNTAIN
PV SOLAR POWER
GENERATION FACILITY**

PROJECT ADDRESS:
**I-15
CRYSTAL, NV
CLARK COUNTY**

SEAL:	DATE: 10/16/2020
	PROJECT #: 190067.03
	DRAWN BY: NK
	CHECKED BY: EL

SHEET NAME:
DC PLAN - ARRAY TYPE E (TRINA)

SHEET #:	REV #:
E-405	4

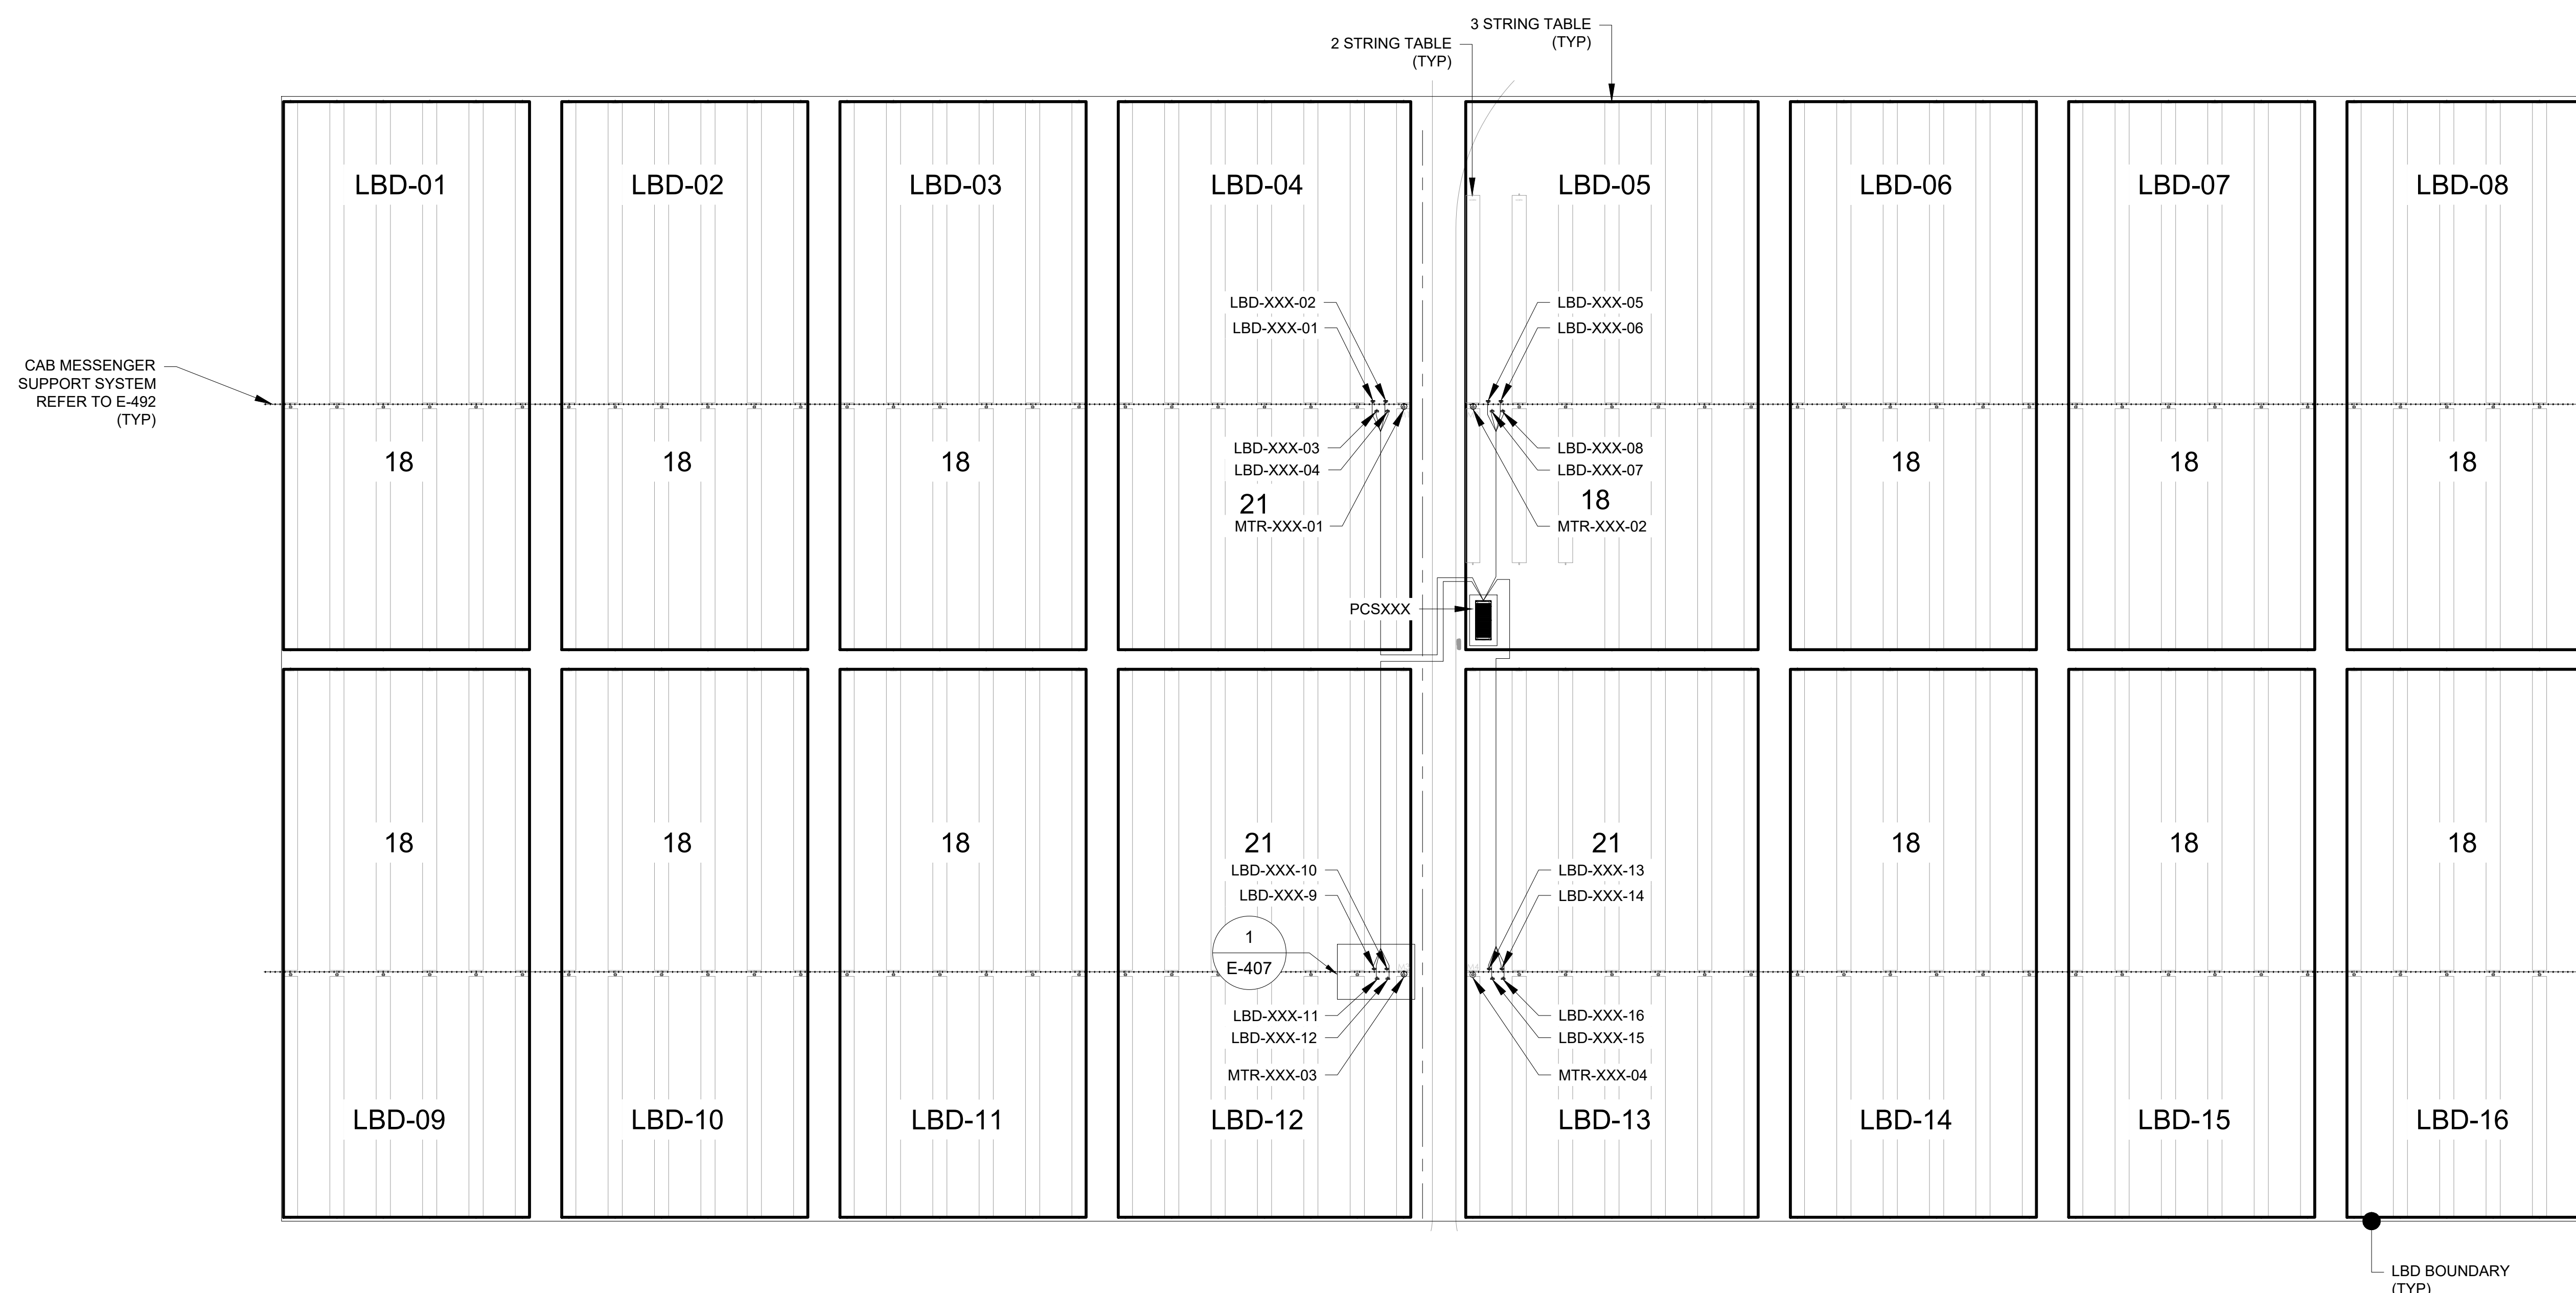

CAB MESSENGER
SUPPORT SYSTEM
REFER TO E-492
(TYP)

NOTES:

1. DC FEEDER TAGS ARE SAME AS LBD TAGS EXCEPT SUBSTITUTING 'DF' IN PLACE OF 'LBD'.
2. REFER TO SHEET E-005 - BLOCK SCHEDULE AND SHEET E-011 - MODULE ALLOCATION PLAN FOR SPECIFIC INFORMATION REGARDING MODULE QUANTITIES ASSOCIATED WITH PCS-SPECIFIC ARRAY TYPES.



LEGEND:

_____ DF _____ DC FEEDER




HANGER SYSTEM

ARRAY TYPE	ASSOCIATED PCS	
A	PCS104 PCS105 PCS106 PCS107 PCS201 PCS207 PCS301 PCS302 PCS303 PCS304 PCS401 PCS402 PCS403 PCS404 PCS405 PCS406 PCS502 PCS503 PCS504 PCS505 PCS506	
	B	PCS204 PCS507
	C	PCS501
	D	PCS202 PCS206
E	PCS205	
F	PCS103 PCS3907 PCS1007 PCS1101 PCS1102 PCS1103 PCS1104 PCS1106 PCS1107 PCS1108 PCS1201 PCS1202 PCS1204 PCS1205 PCS1206 PCS1207 PCS1301 PCS1302 PCS1303 PCS1304 PCS1306 PCS1307 PCS1402 PCS1404 PCS1405 PCS1406	
	G	PCS101 PCS906 PCS1203
	H	PCS1208
	I	PCS1305
J	PCS102 PCS1401	
K	PCS1408	
L	PCS1407	
M	PCS1105	
N	PCS604	
O	PCS606	
P	PCS607	
Q	PCS1308	
R	PCS805 PCS806 PCS807 PCS407 PCS705 PCS706 PCS707 PCS803 PCS804 PCS805 PCS806 PCS807 PCS902 PCS903 PCS904 PCS905 PCS1001 PCS1002 PCS1003 PCS1004 PCS1005	
	S	PCS1006
	T	PCS802 PCS901
	U	PCS203
V	PCS704	
W	PCS701 PCS702 PCS703 PCS801	
X	PCS601 PCS602 PCS603 PCS605	
Y	PCS1403	
Z	PCS1008	

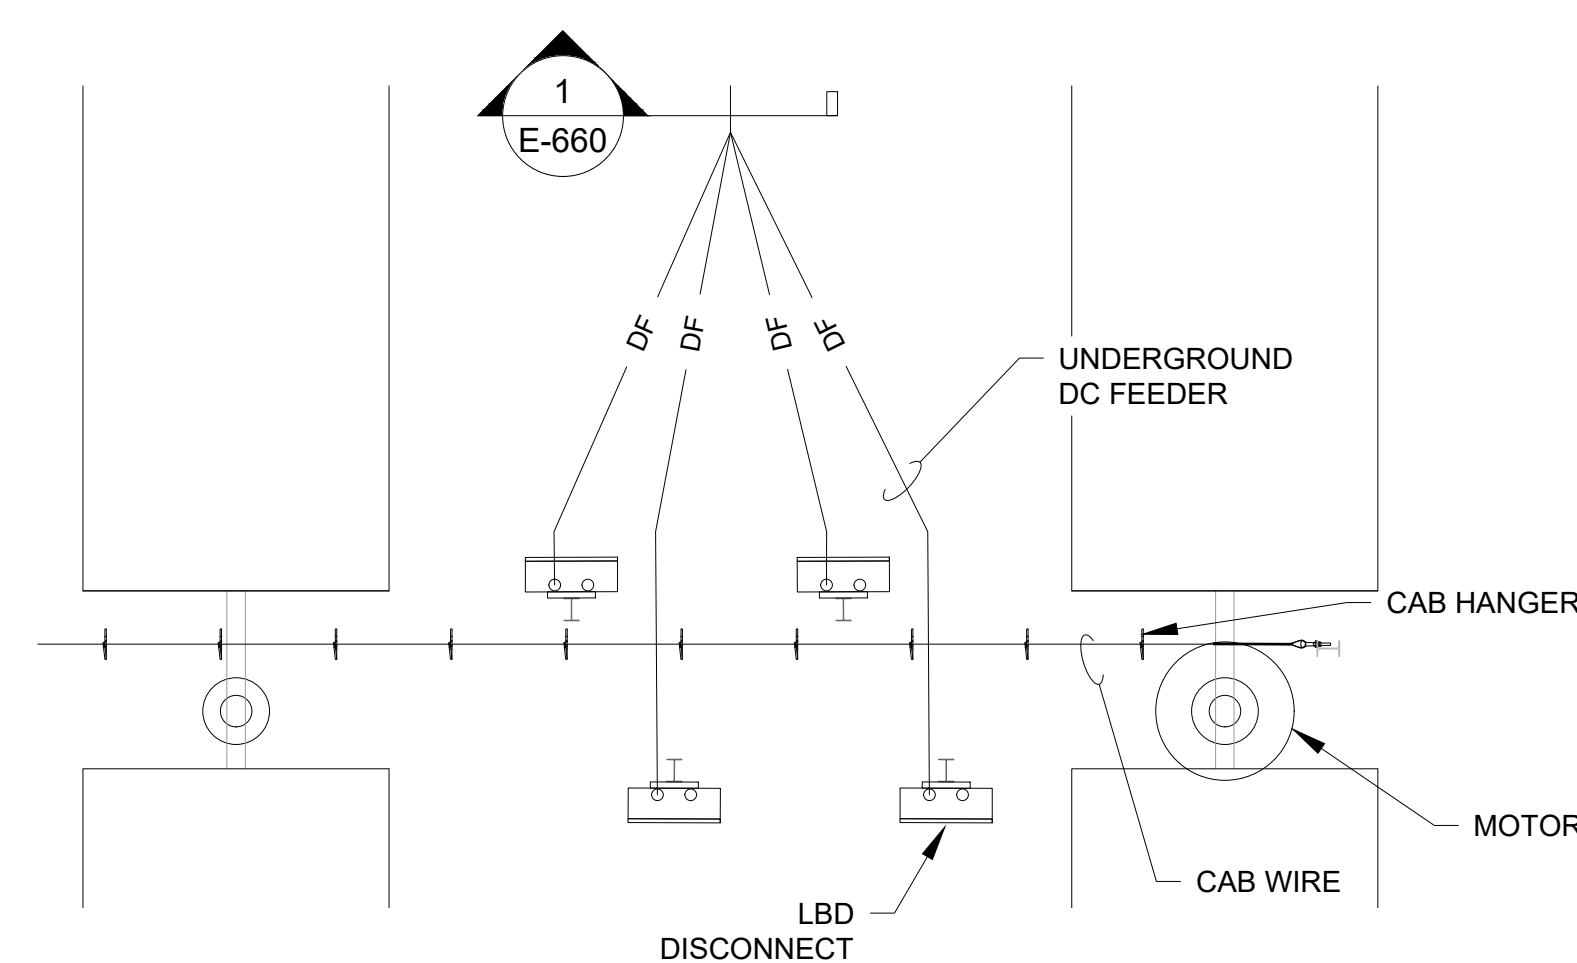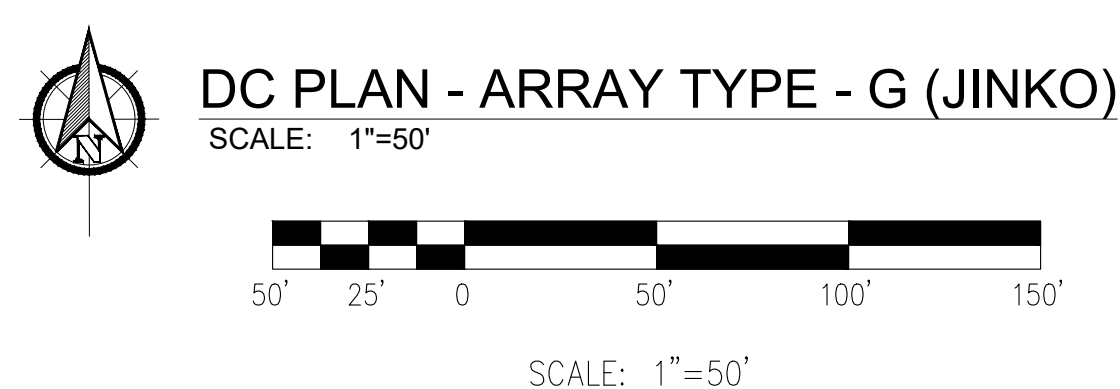

1 LBD LAYOUT DETAIL

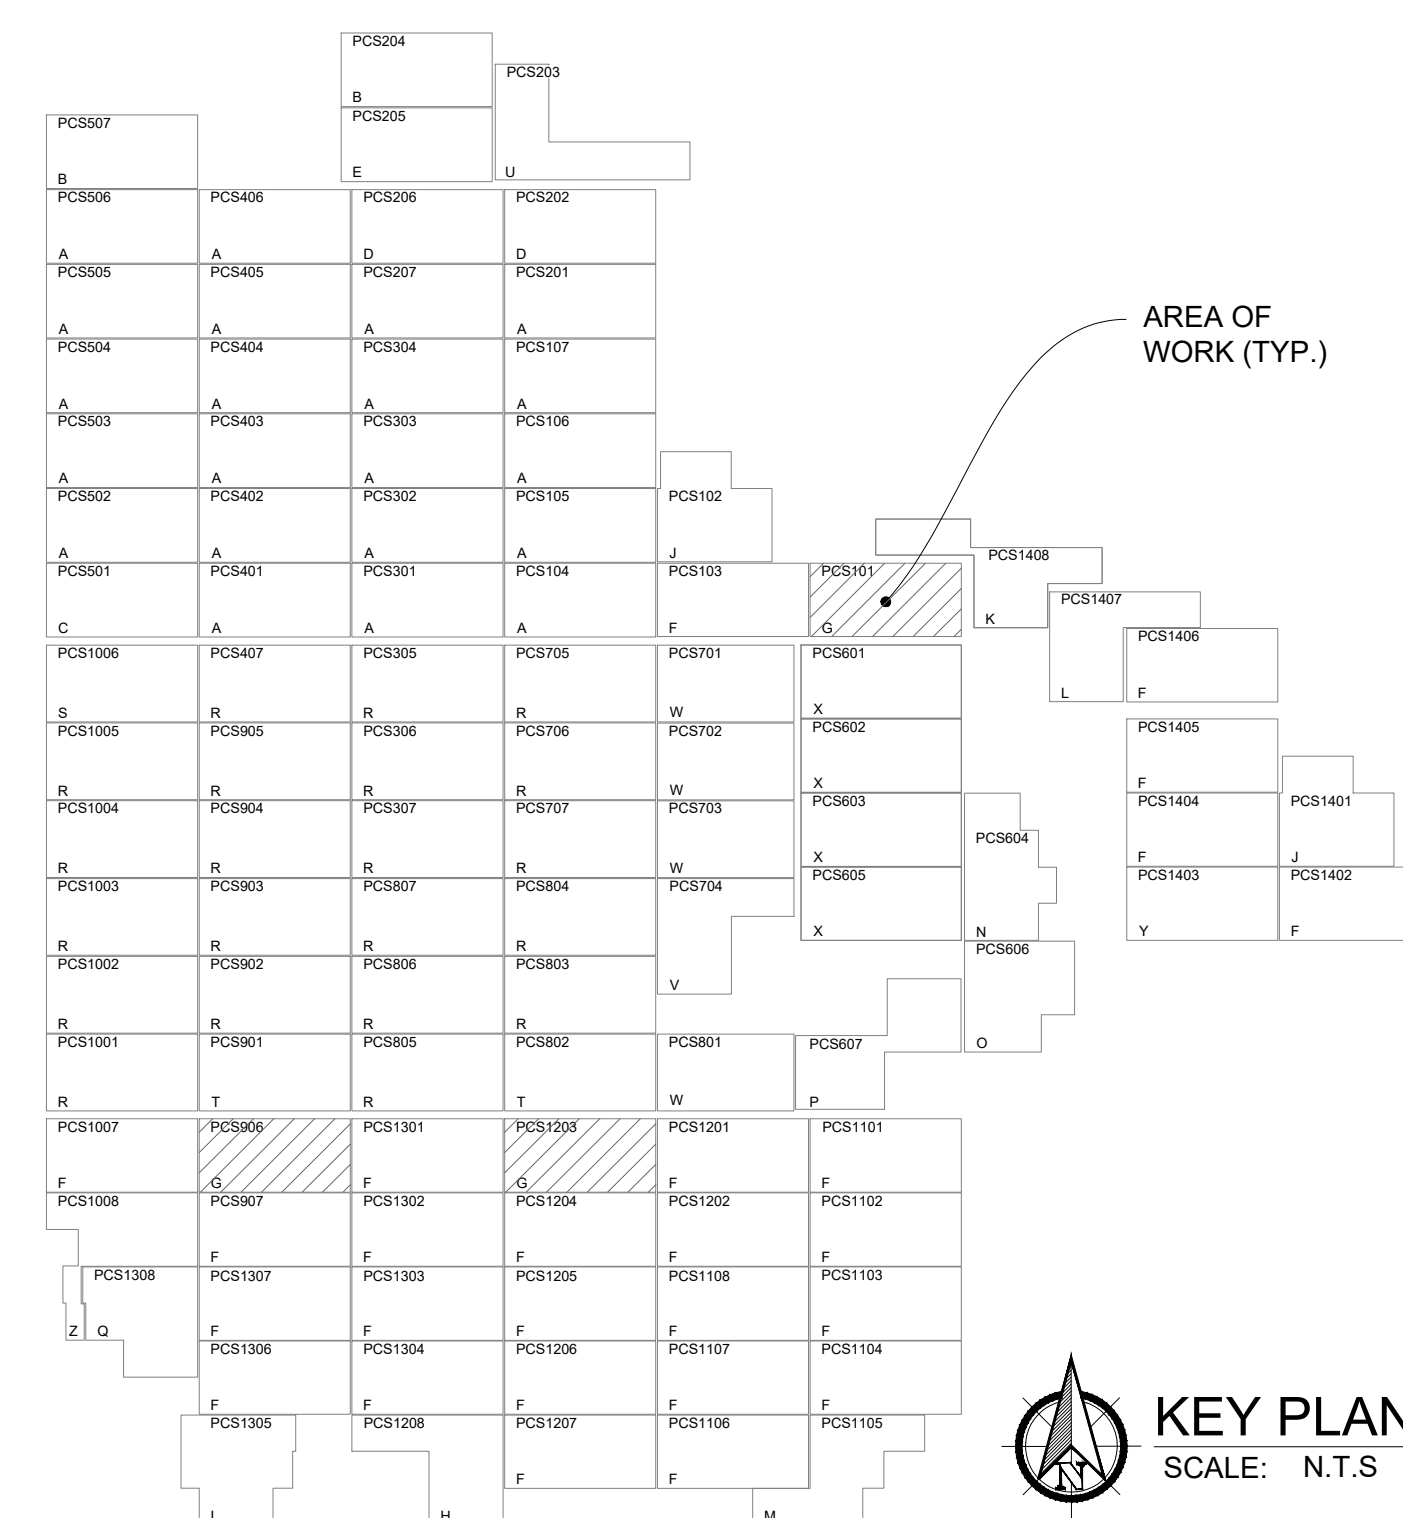

— AREA OF
WORK (TYP.)

[illegible]

PROJECT NAME:
EAGLE SHADOW MOUNTAIN
PV SOLAR POWER
GENERATION FACILITY

PROJECT ADDRESS:
I-15
CRYSTAL, NV
CLARK COUNTY

SEAL:	DATE:	10/16/2020
	PROJECT #:	190067.03
	DRAWN BY:	NK
	CHECKED BY:	EL


SHEET NAME:
DC PLAN - ARRAY TYPE G (JINKO)

RECORD	SHEET #:	REV
	E-407	#: 4

PLOT DATE: Thursday, June 08, 2023

SAVED BY: Nick Kasidjaris

LOCATION: K:\09 PROJECTS\190067.03 - PRIMORIS - EAGLE SHADOW MOUNTAIN\05 ENGINEERING\DWG\IE-407 DC PLAN - ARRAY TYPE G (JUNKO)

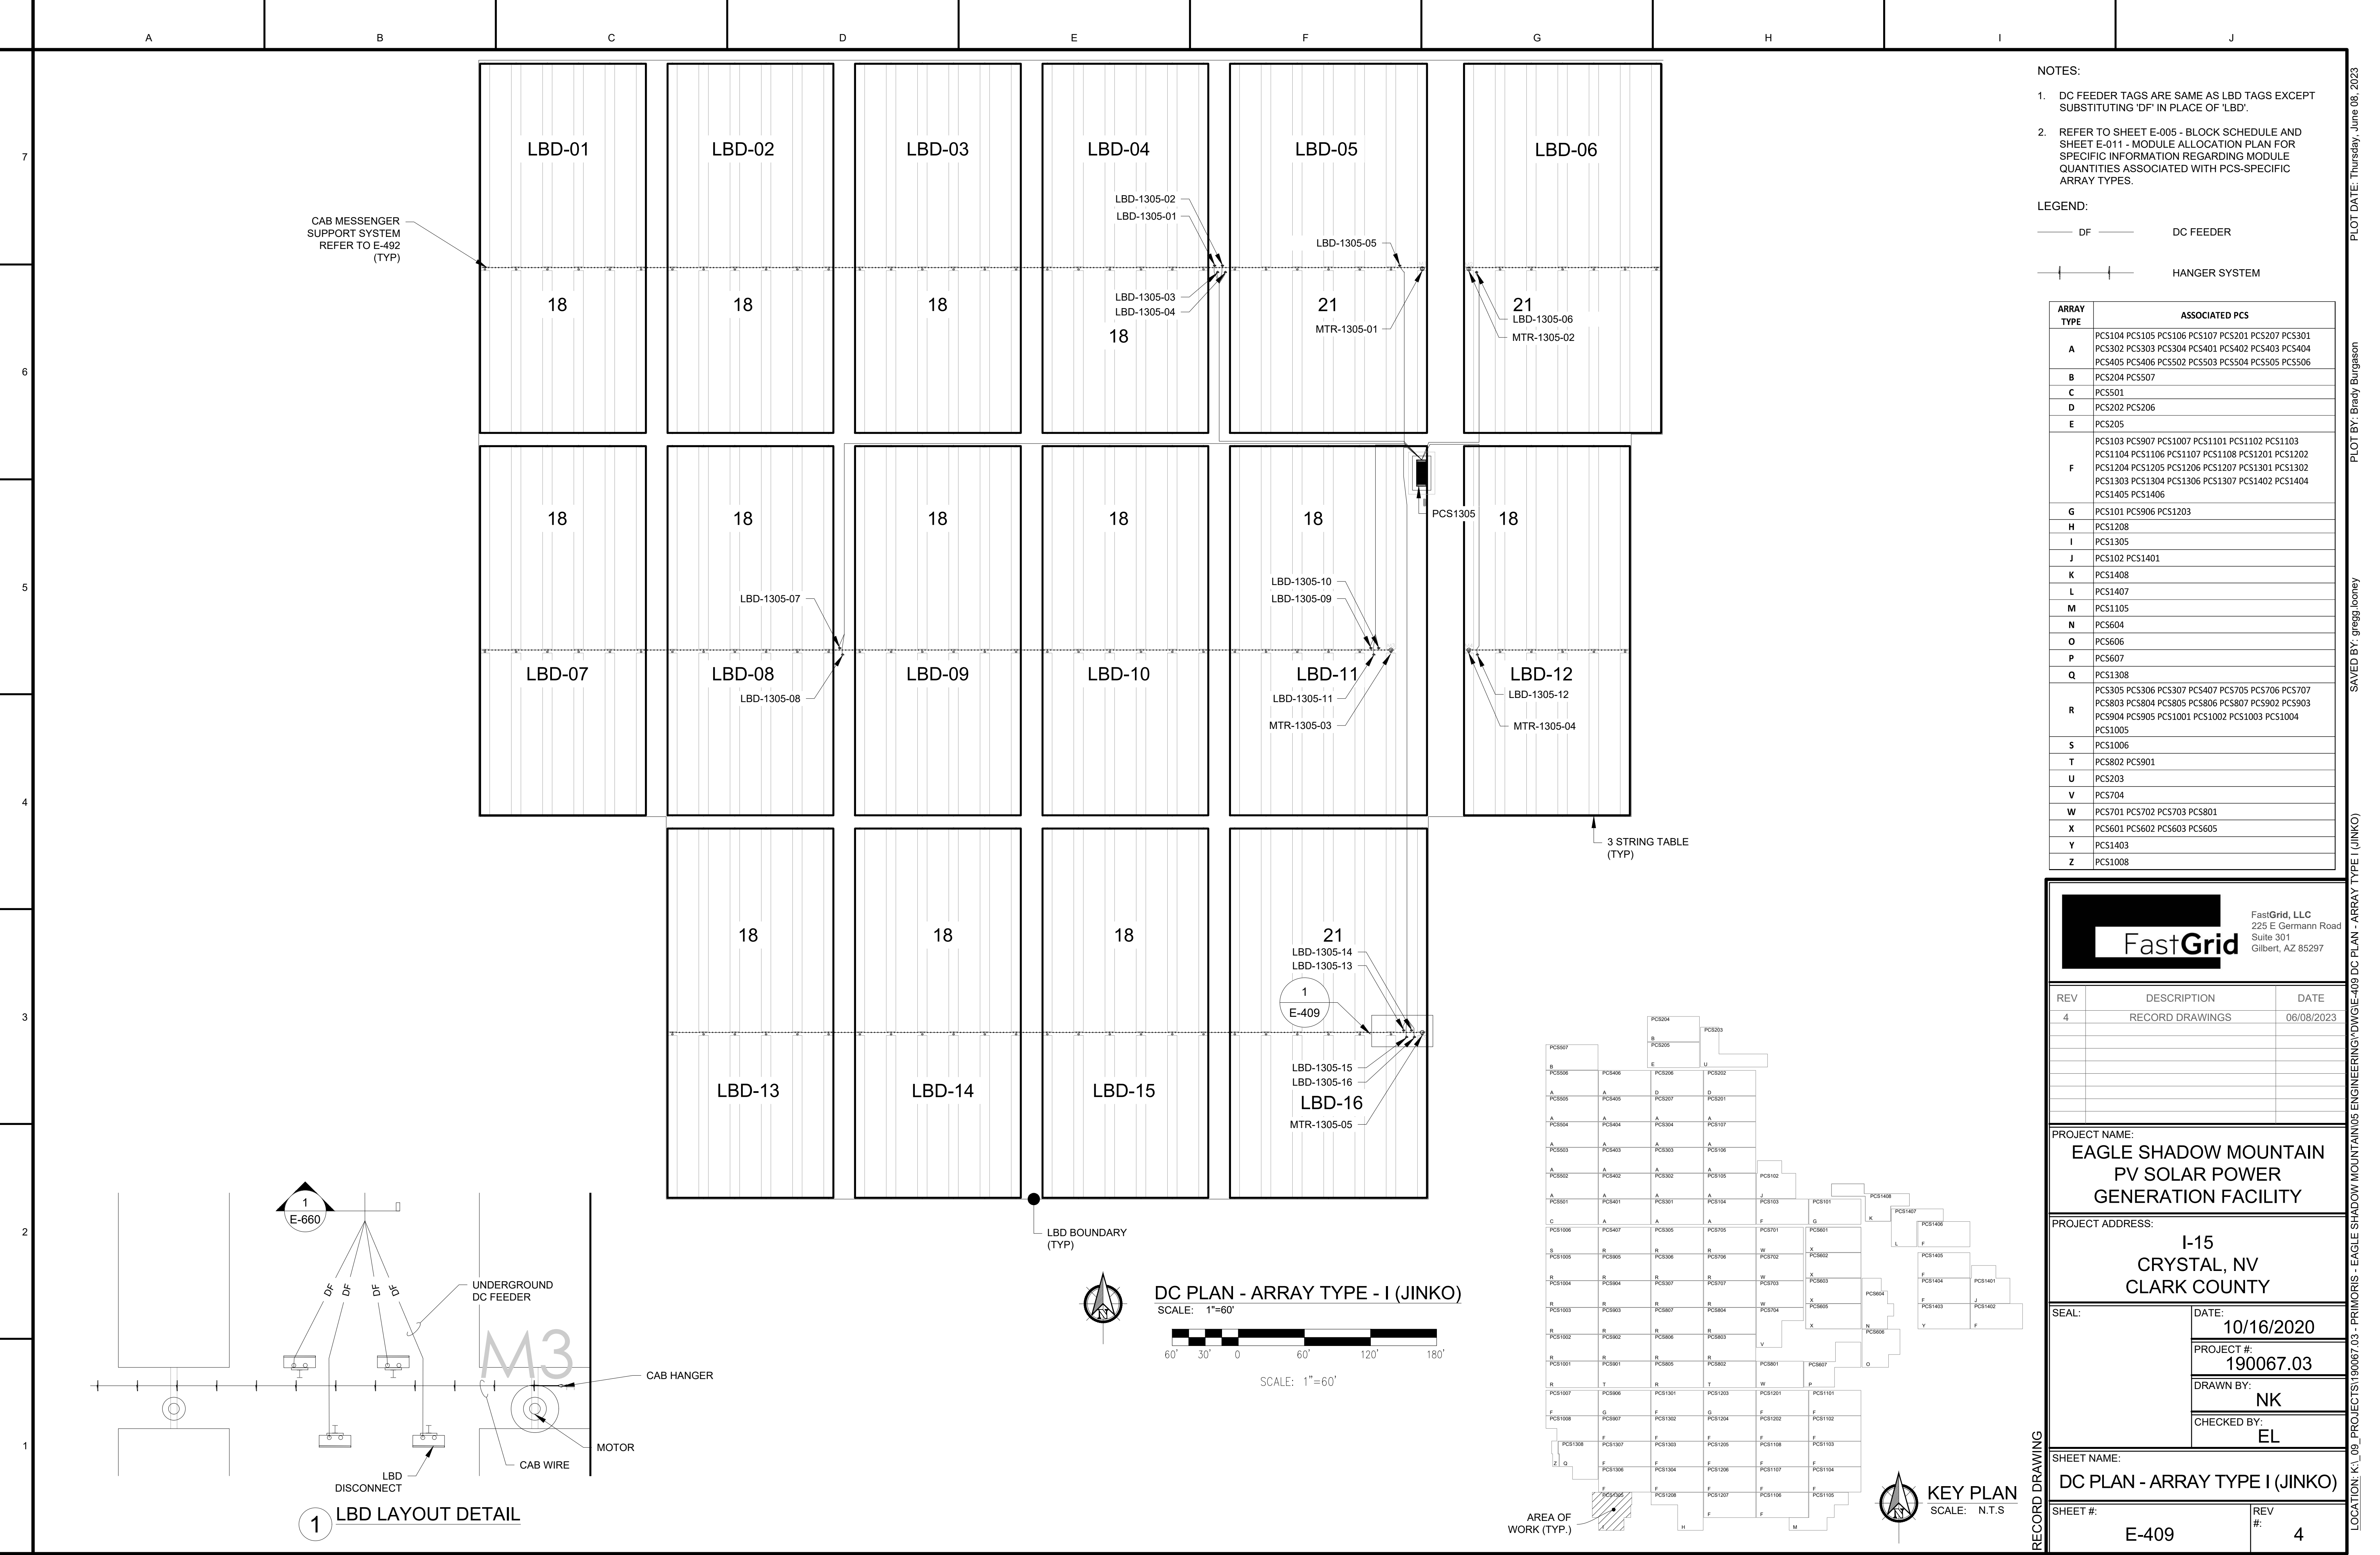

- NOTES:
- DC FEEDER TAGS ARE SAME AS LBD TAGS EXCEPT SUBSTITUTING 'DF' IN PLACE OF 'LBD'.
 - REFER TO SHEET E-005 - BLOCK SCHEDULE AND SHEET E-011 - MODULE ALLOCATION PLAN FOR SPECIFIC INFORMATION REGARDING MODULE QUANTITIES ASSOCIATED WITH PCS-SPECIFIC ARRAY TYPES.

LEGEND:

— DF — DC FEEDER

— | — HANGER SYSTEM

ARRAY TYPE	ASSOCIATED PCS
A	PCS104 PCS105 PCS106 PCS107 PCS201 PCS207 PCS301 PCS302 PCS303 PCS304 PCS401 PCS402 PCS403 PCS404 PCS405 PCS406 PCS502 PCS503 PCS504 PCS505 PCS506
B	PCS204 PCS507
C	PCS501
D	PCS202 PCS206
E	PCS205
F	PCS103 PCS907 PCS1007 PCS1101 PCS1102 PCS1103 PCS1104 PCS1106 PCS1107 PCS1108 PCS1201 PCS1202 PCS1204 PCS1205 PCS1206 PCS1207 PCS1301 PCS1302 PCS1303 PCS1304 PCS1306 PCS1307 PCS1402 PCS1404 PCS1405 PCS1406
G	PCS101 PCS906 PCS1203
H	PCS1208
I	PCS1305
J	PCS102 PCS1401
K	PCS1408
L	PCS1407
M	PCS1105
N	PCS604
O	PCS606
P	PCS607
Q	PCS1308
R	PCS305 PCS306 PCS307 PCS407 PCS705 PCS706 PCS707 PCS803 PCS804 PCS805 PCS806 PCS807 PCS902 PCS903 PCS904 PCS905 PCS1001 PCS1002 PCS1003 PCS1004 PCS1005
S	PCS1006
T	PCS802 PCS901
U	PCS203
V	PCS704
W	PCS701 PCS702 PCS703 PCS801
X	PCS601 PCS602 PCS603 PCS605
Y	PCS1403
Z	PCS1008

FastGrid, LLC
225 E Germann Road
Suite 301
Gilbert, AZ 85297

REV	DESCRIPTION	DATE
4	RECORD DRAWINGS	06/08/2023

PROJECT NAME:
**EAGLE SHADOW MOUNTAIN
PV SOLAR POWER
GENERATION FACILITY**

PROJECT ADDRESS:
**I-15
CRYSTAL, NV
CLARK COUNTY**




SEAL:

DATE:
10/16/2020
PROJECT #:
190067.03
DRAWN BY:
NK
CHECKED BY:
EL





SHEET NAME:
DC PLAN - ARRAY TYPE I (JINKO)

SHEET #:
E-409

REV #:
4

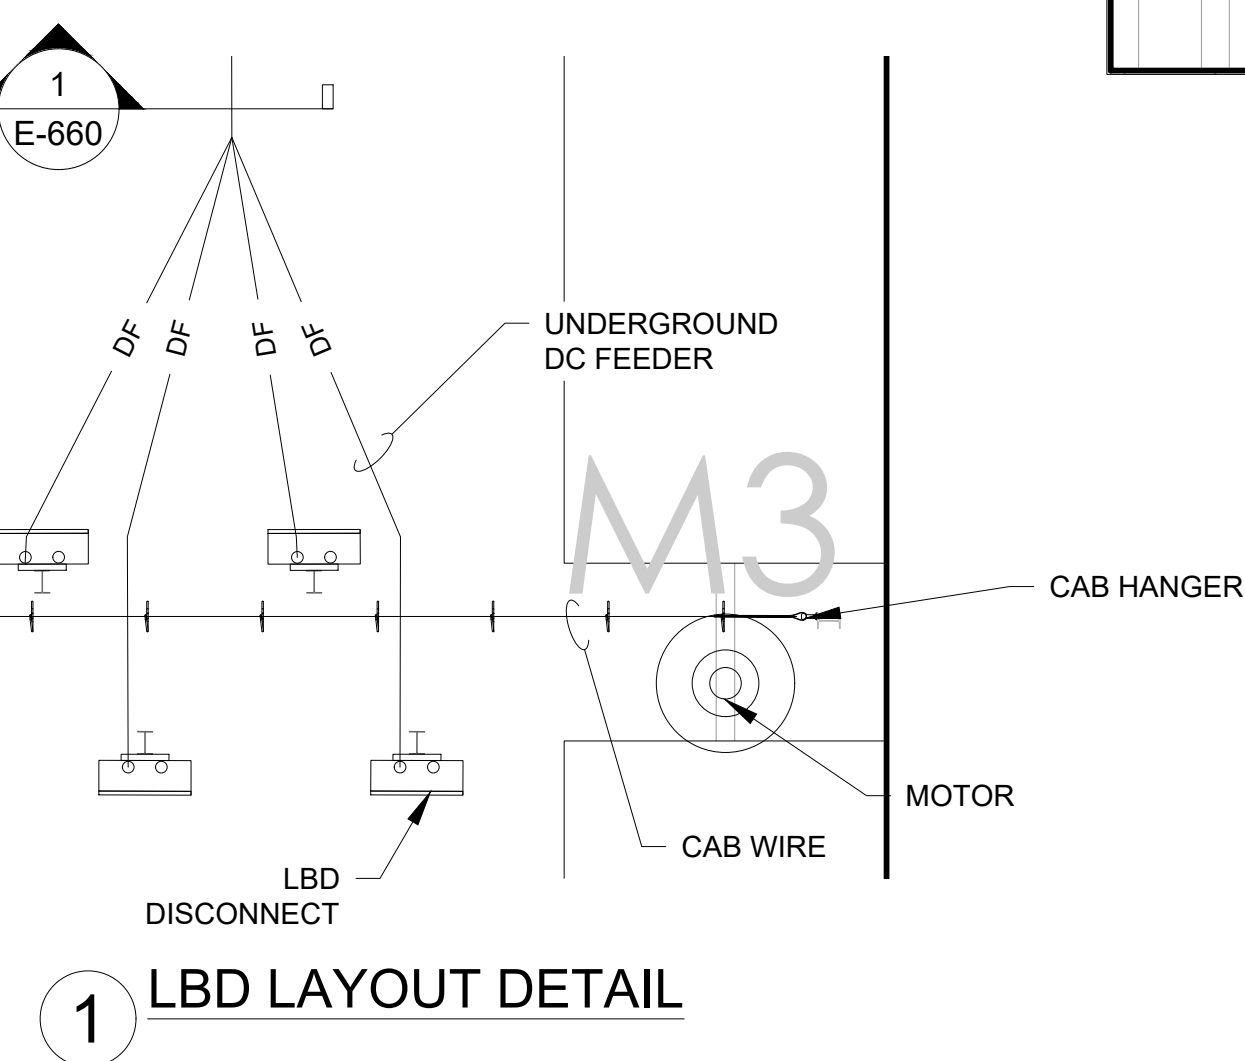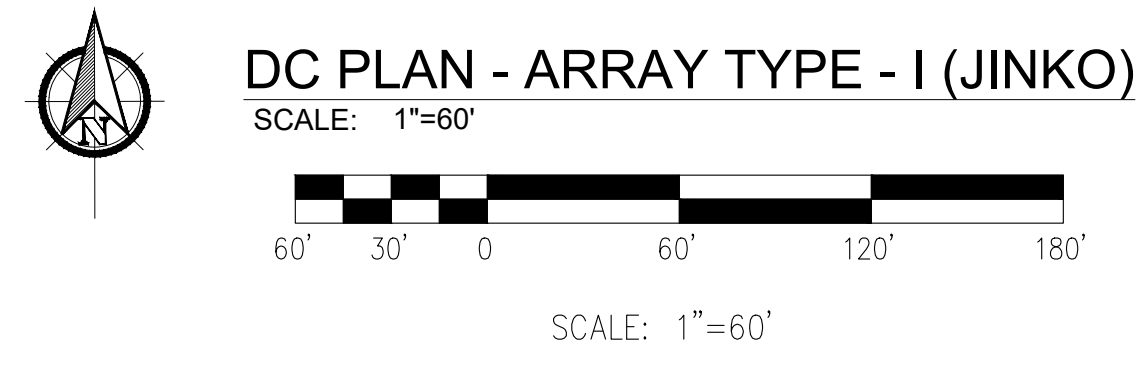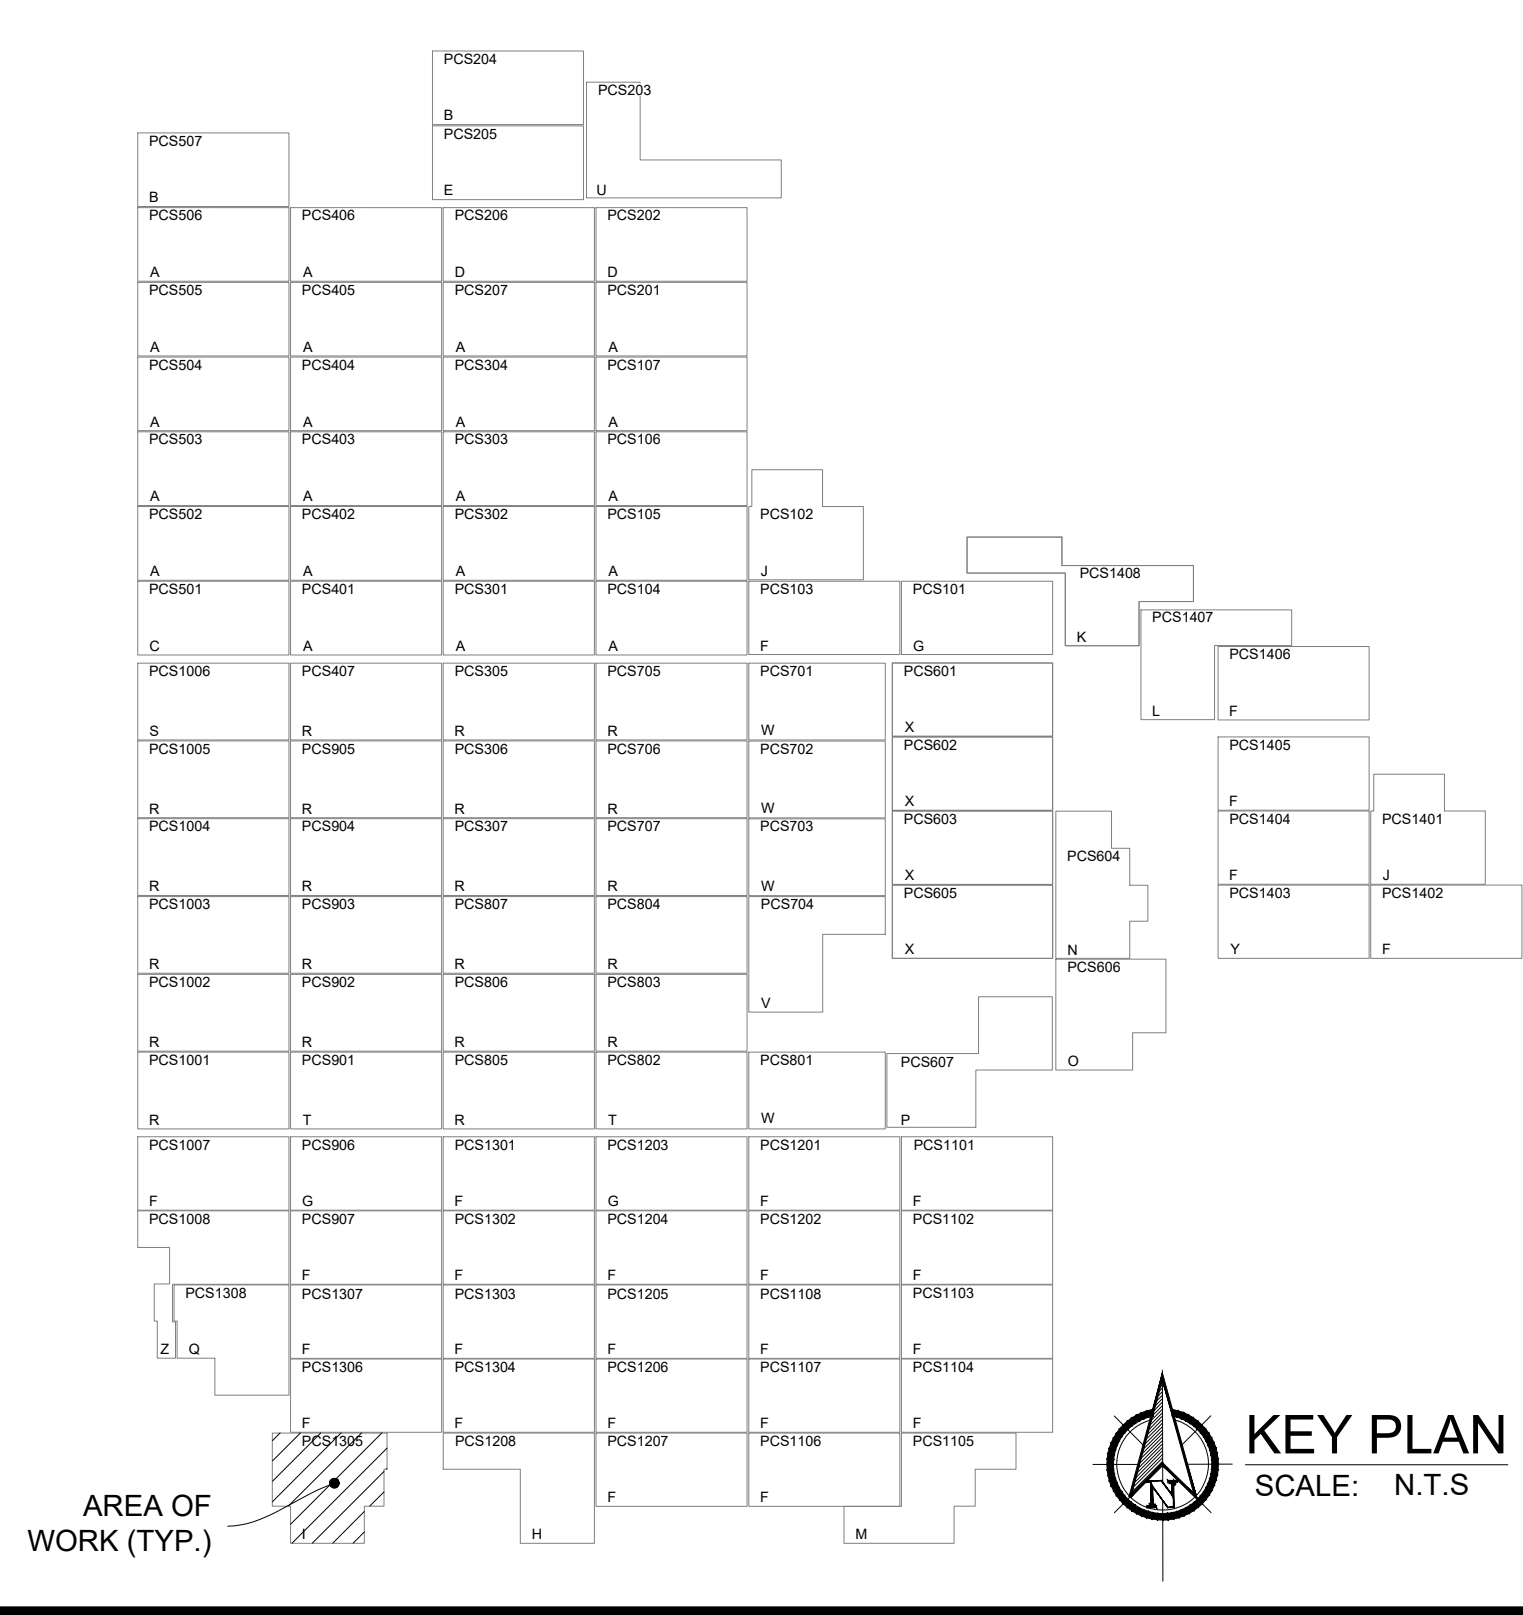

LOCATION: K:_09 PROJECTS\190067.03 - PRIMONIS - EAGLE SHADOW MOUNTAIN\05 ENGINEERING\DWG\E-409 DC PLAN - ARRAY TYPE I (JINKO) PLOT DATE: Thursday, June 08, 2023 PLOT BY: Brady Burgesson SAVED BY: gregg looney

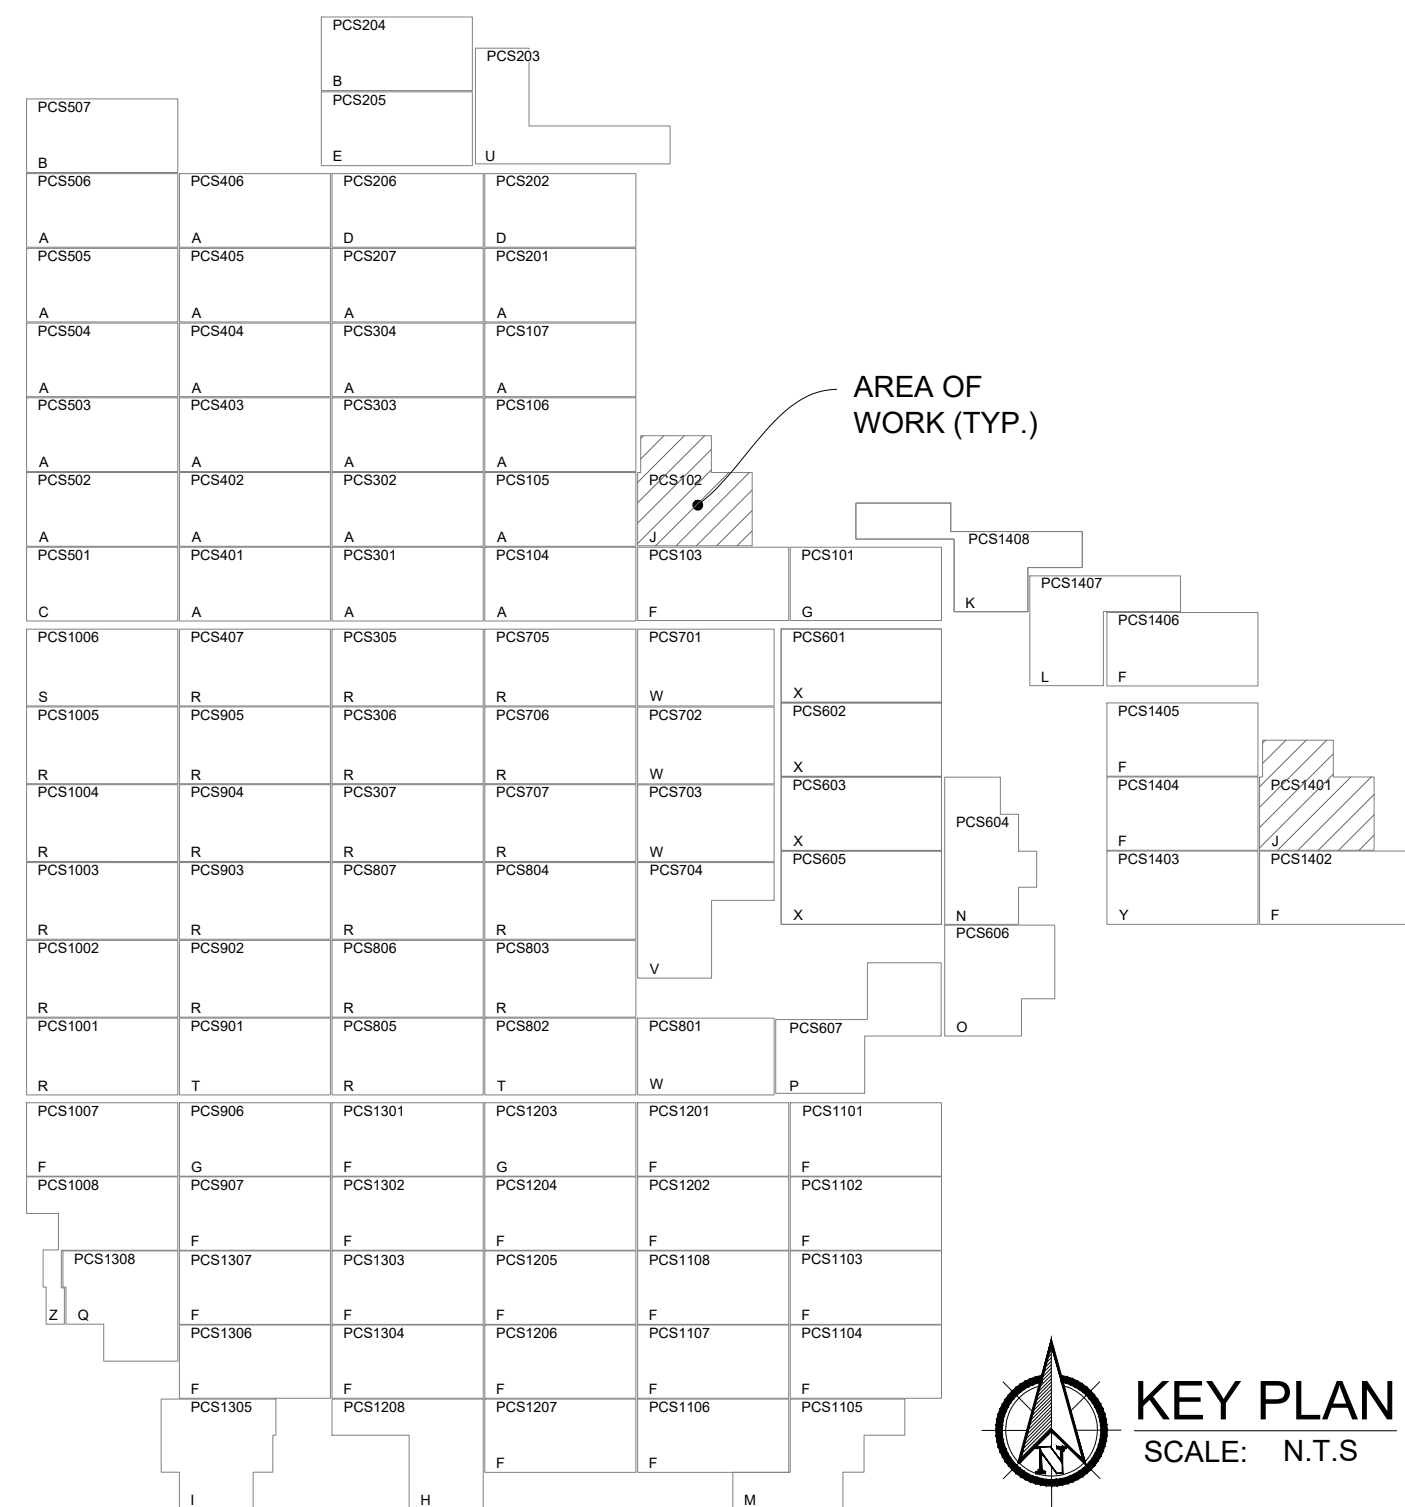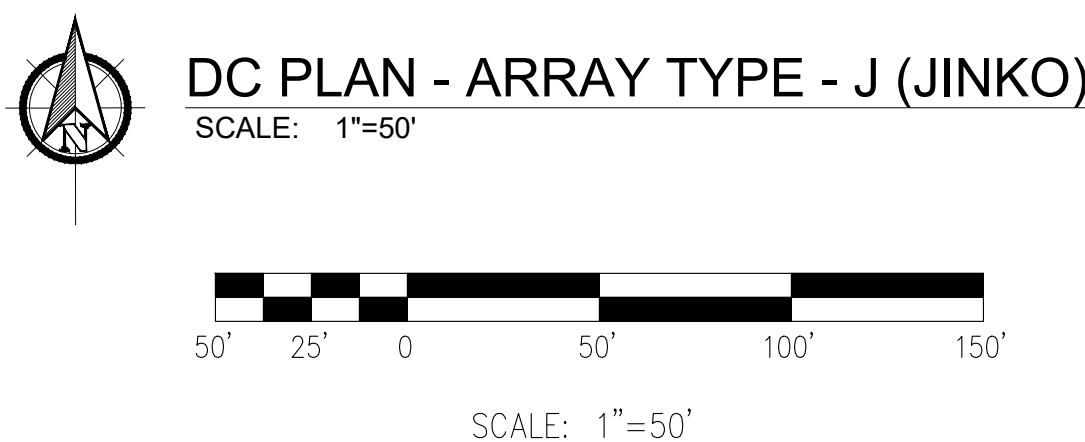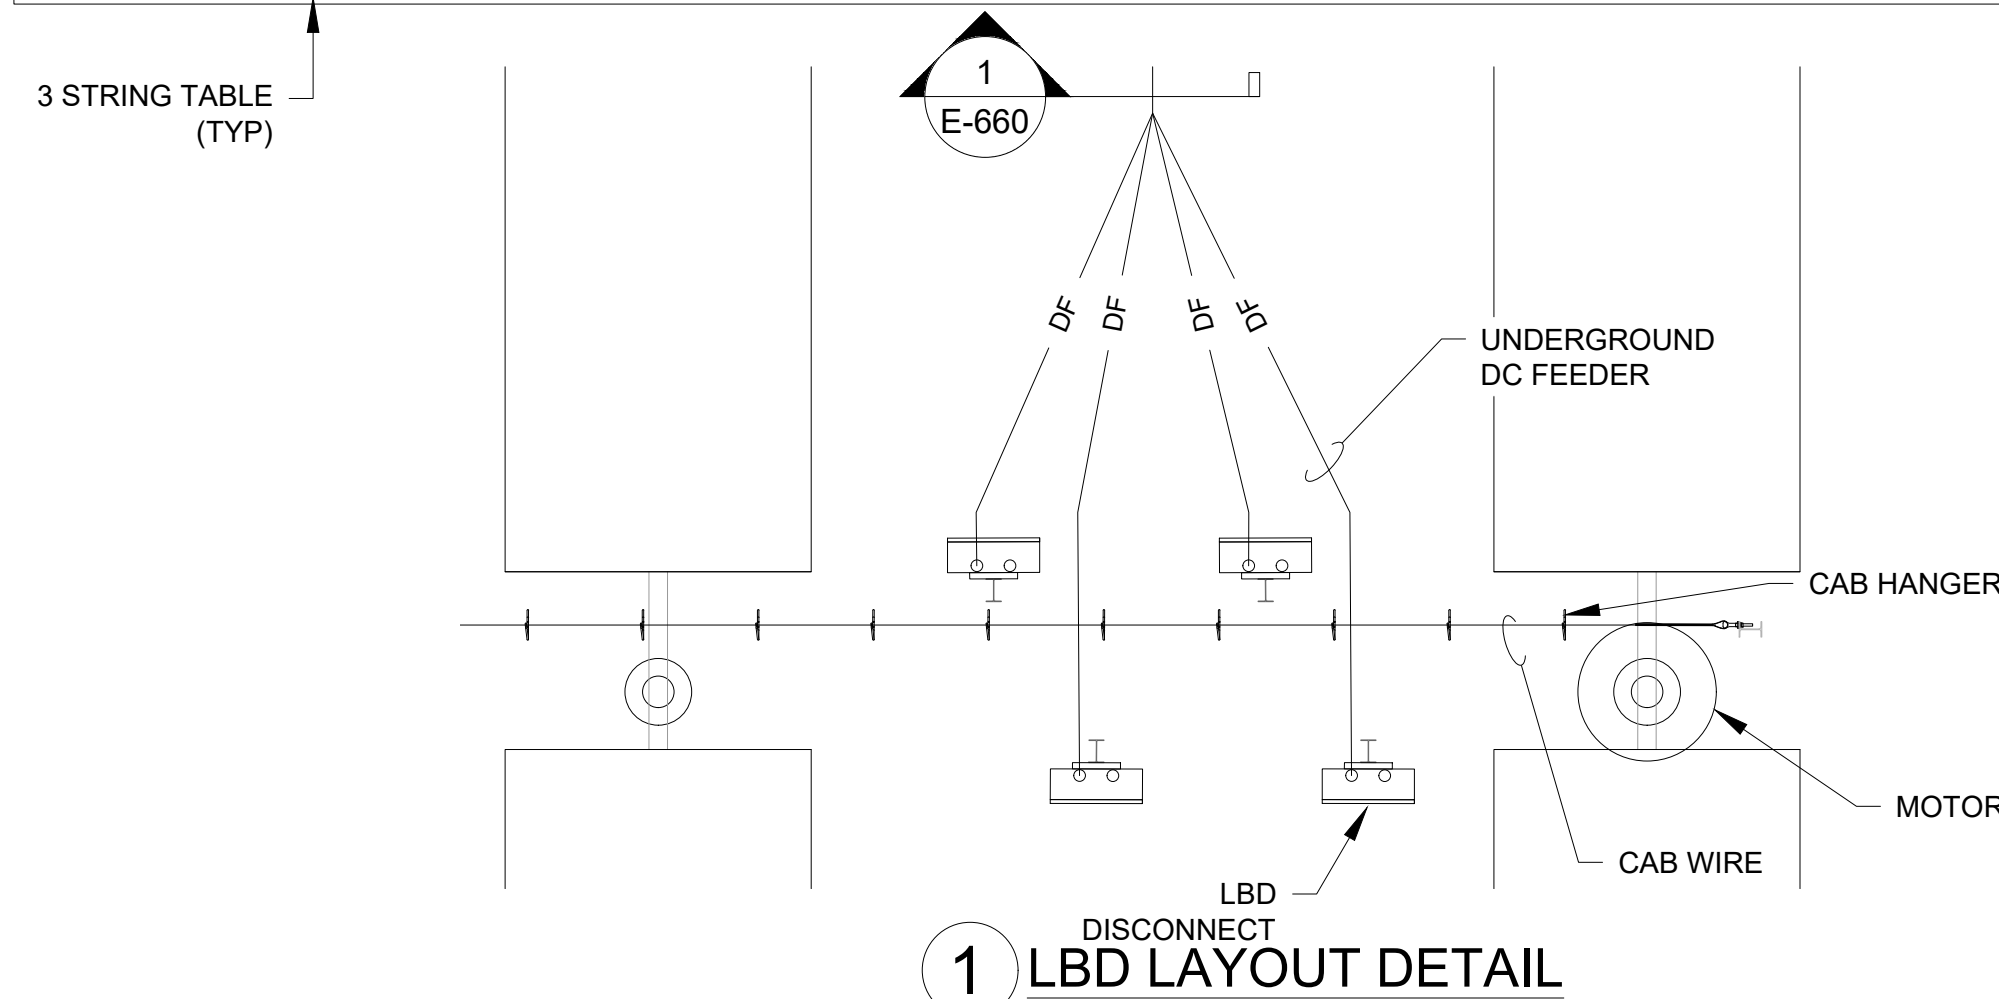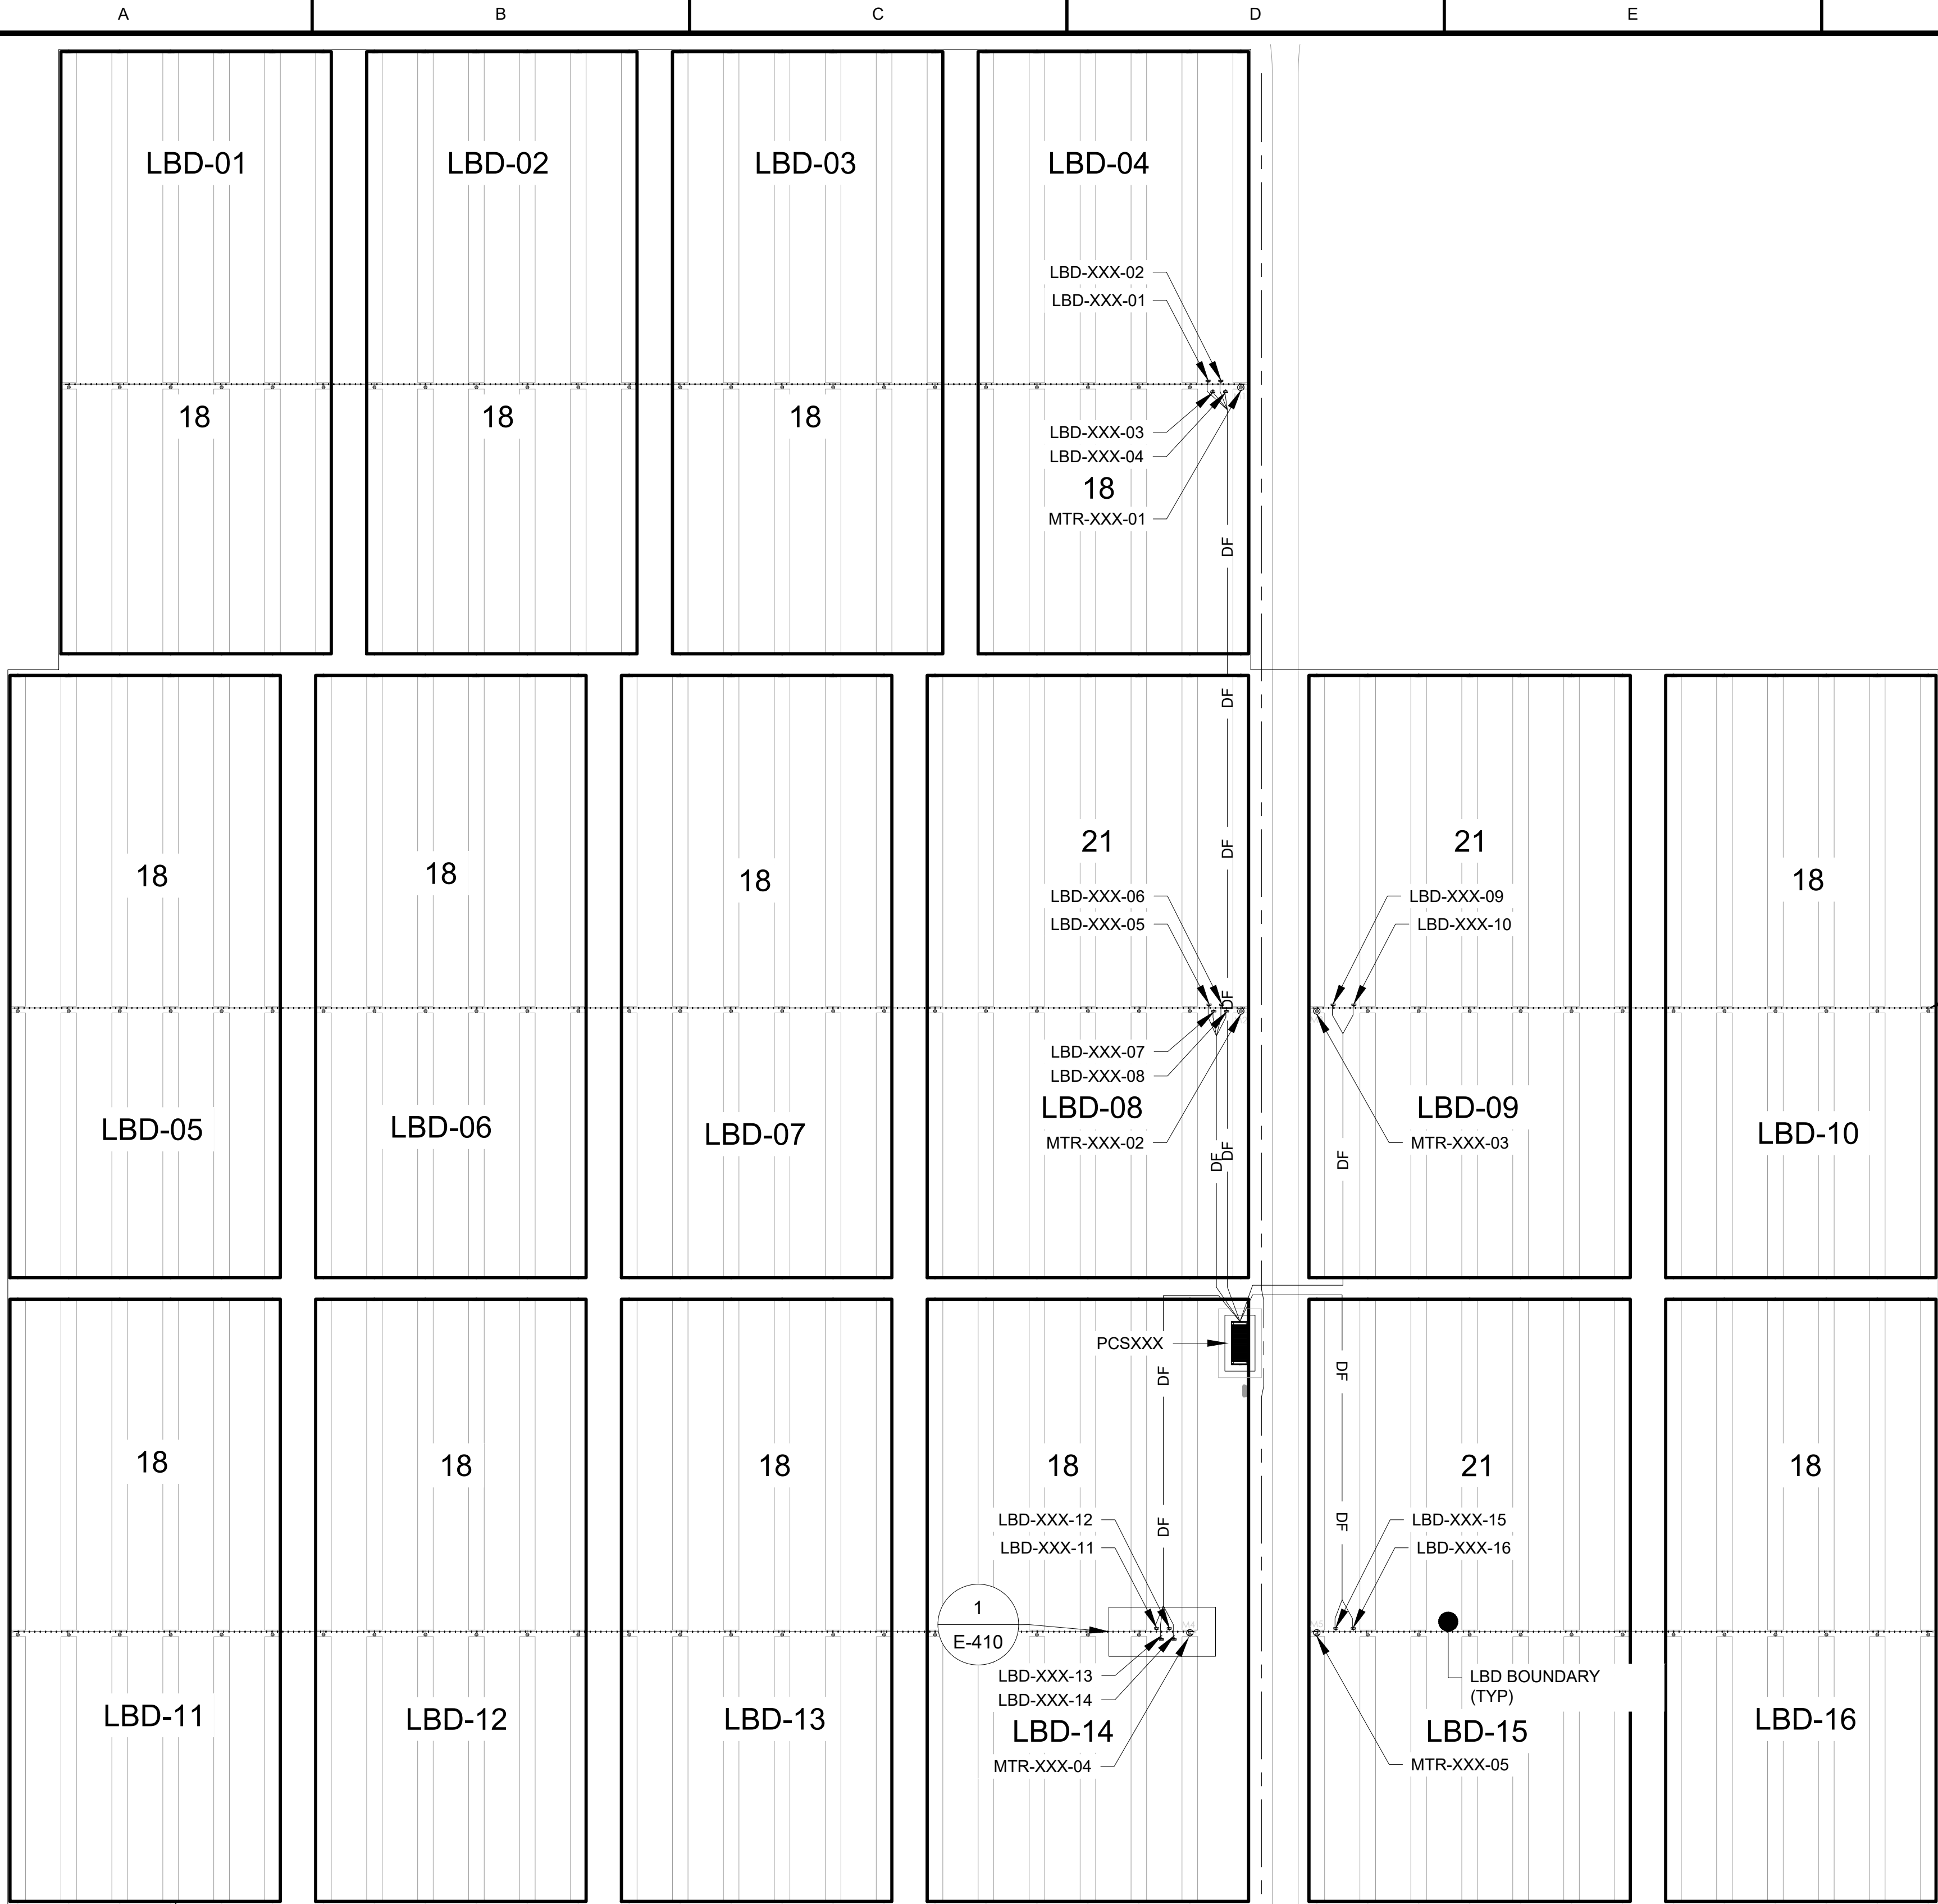

- NOTES:
- DC FEEDER TAGS ARE SAME AS LBD TAGS EXCEPT SUBSTITUTING 'DF' IN PLACE OF 'LBD'.
 - REFER TO SHEET E-005 - BLOCK SCHEDULE AND SHEET E-011 - MODULE ALLOCATION PLAN FOR SPECIFIC INFORMATION REGARDING MODULE QUANTITIES ASSOCIATED WITH PCS-SPECIFIC ARRAY TYPES.

LEGEND:

— DF — DC FEEDER

— — — — — BAB MESSENGER SYSTEM

ARRAY TYPE	ASSOCIATED PCS
A	PCS104 PCS105 PCS106 PCS107 PCS201 PCS207 PCS301 PCS302 PCS303 PCS304 PCS401 PCS402 PCS403 PCS404 PCS405 PCS406 PCS502 PCS503 PCS504 PCS505 PCS506
B	PCS204 PCS507
C	PCS501
D	PCS202 PCS206
E	PCS205
F	PCS103 PCS907 PCS1007 PCS1101 PCS1102 PCS1103 PCS1104 PCS1106 PCS1107 PCS1108 PCS1201 PCS1202 PCS1204 PCS1205 PCS1206 PCS1207 PCS1301 PCS1302 PCS1303 PCS1304 PCS1306 PCS1307 PCS1402 PCS1404 PCS1405 PCS1406
G	PCS101 PCS906 PCS1203
H	PCS1208
I	PCS1305
J	PCS102 PCS1401
K	PCS1408
L	PCS1407
M	PCS1105
N	PCS604
O	PCS606
P	PCS607
Q	PCS1308
R	PCS305 PCS306 PCS307 PCS407 PCS705 PCS706 PCS707 PCS803 PCS804 PCS805 PCS806 PCS807 PCS902 PCS903 PCS904 PCS905 PCS1001 PCS1002 PCS1003 PCS1004 PCS1005
S	PCS1006
T	PCS802 PCS901
U	PCS203
V	PCS704
W	PCS701 PCS702 PCS703 PCS801
X	PCS601 PCS602 PCS603 PCS605
Y	PCS1403
Z	PCS1008



REV	DESCRIPTION	DATE
4	RECORD DRAWINGS	06/08/2023

PROJECT NAME:
**EAGLE SHADOW MOUNTAIN
PV SOLAR POWER
GENERATION FACILITY**

PROJECT ADDRESS:
**I-15
CRYSTAL, NV
CLARK COUNTY**

SEAL: PROJECT #
190067.03
DRAWN BY:
TLR
CHECKED BY:
EL


SHEET NAME:
DC PLAN - ARRAY TYPE J (JINKO)

SHEET #:
E-410
REV #:
4


RECORD DRAWING

MATCHLINE - SEE ABOVE FOR CONTINUATION


1
E-411

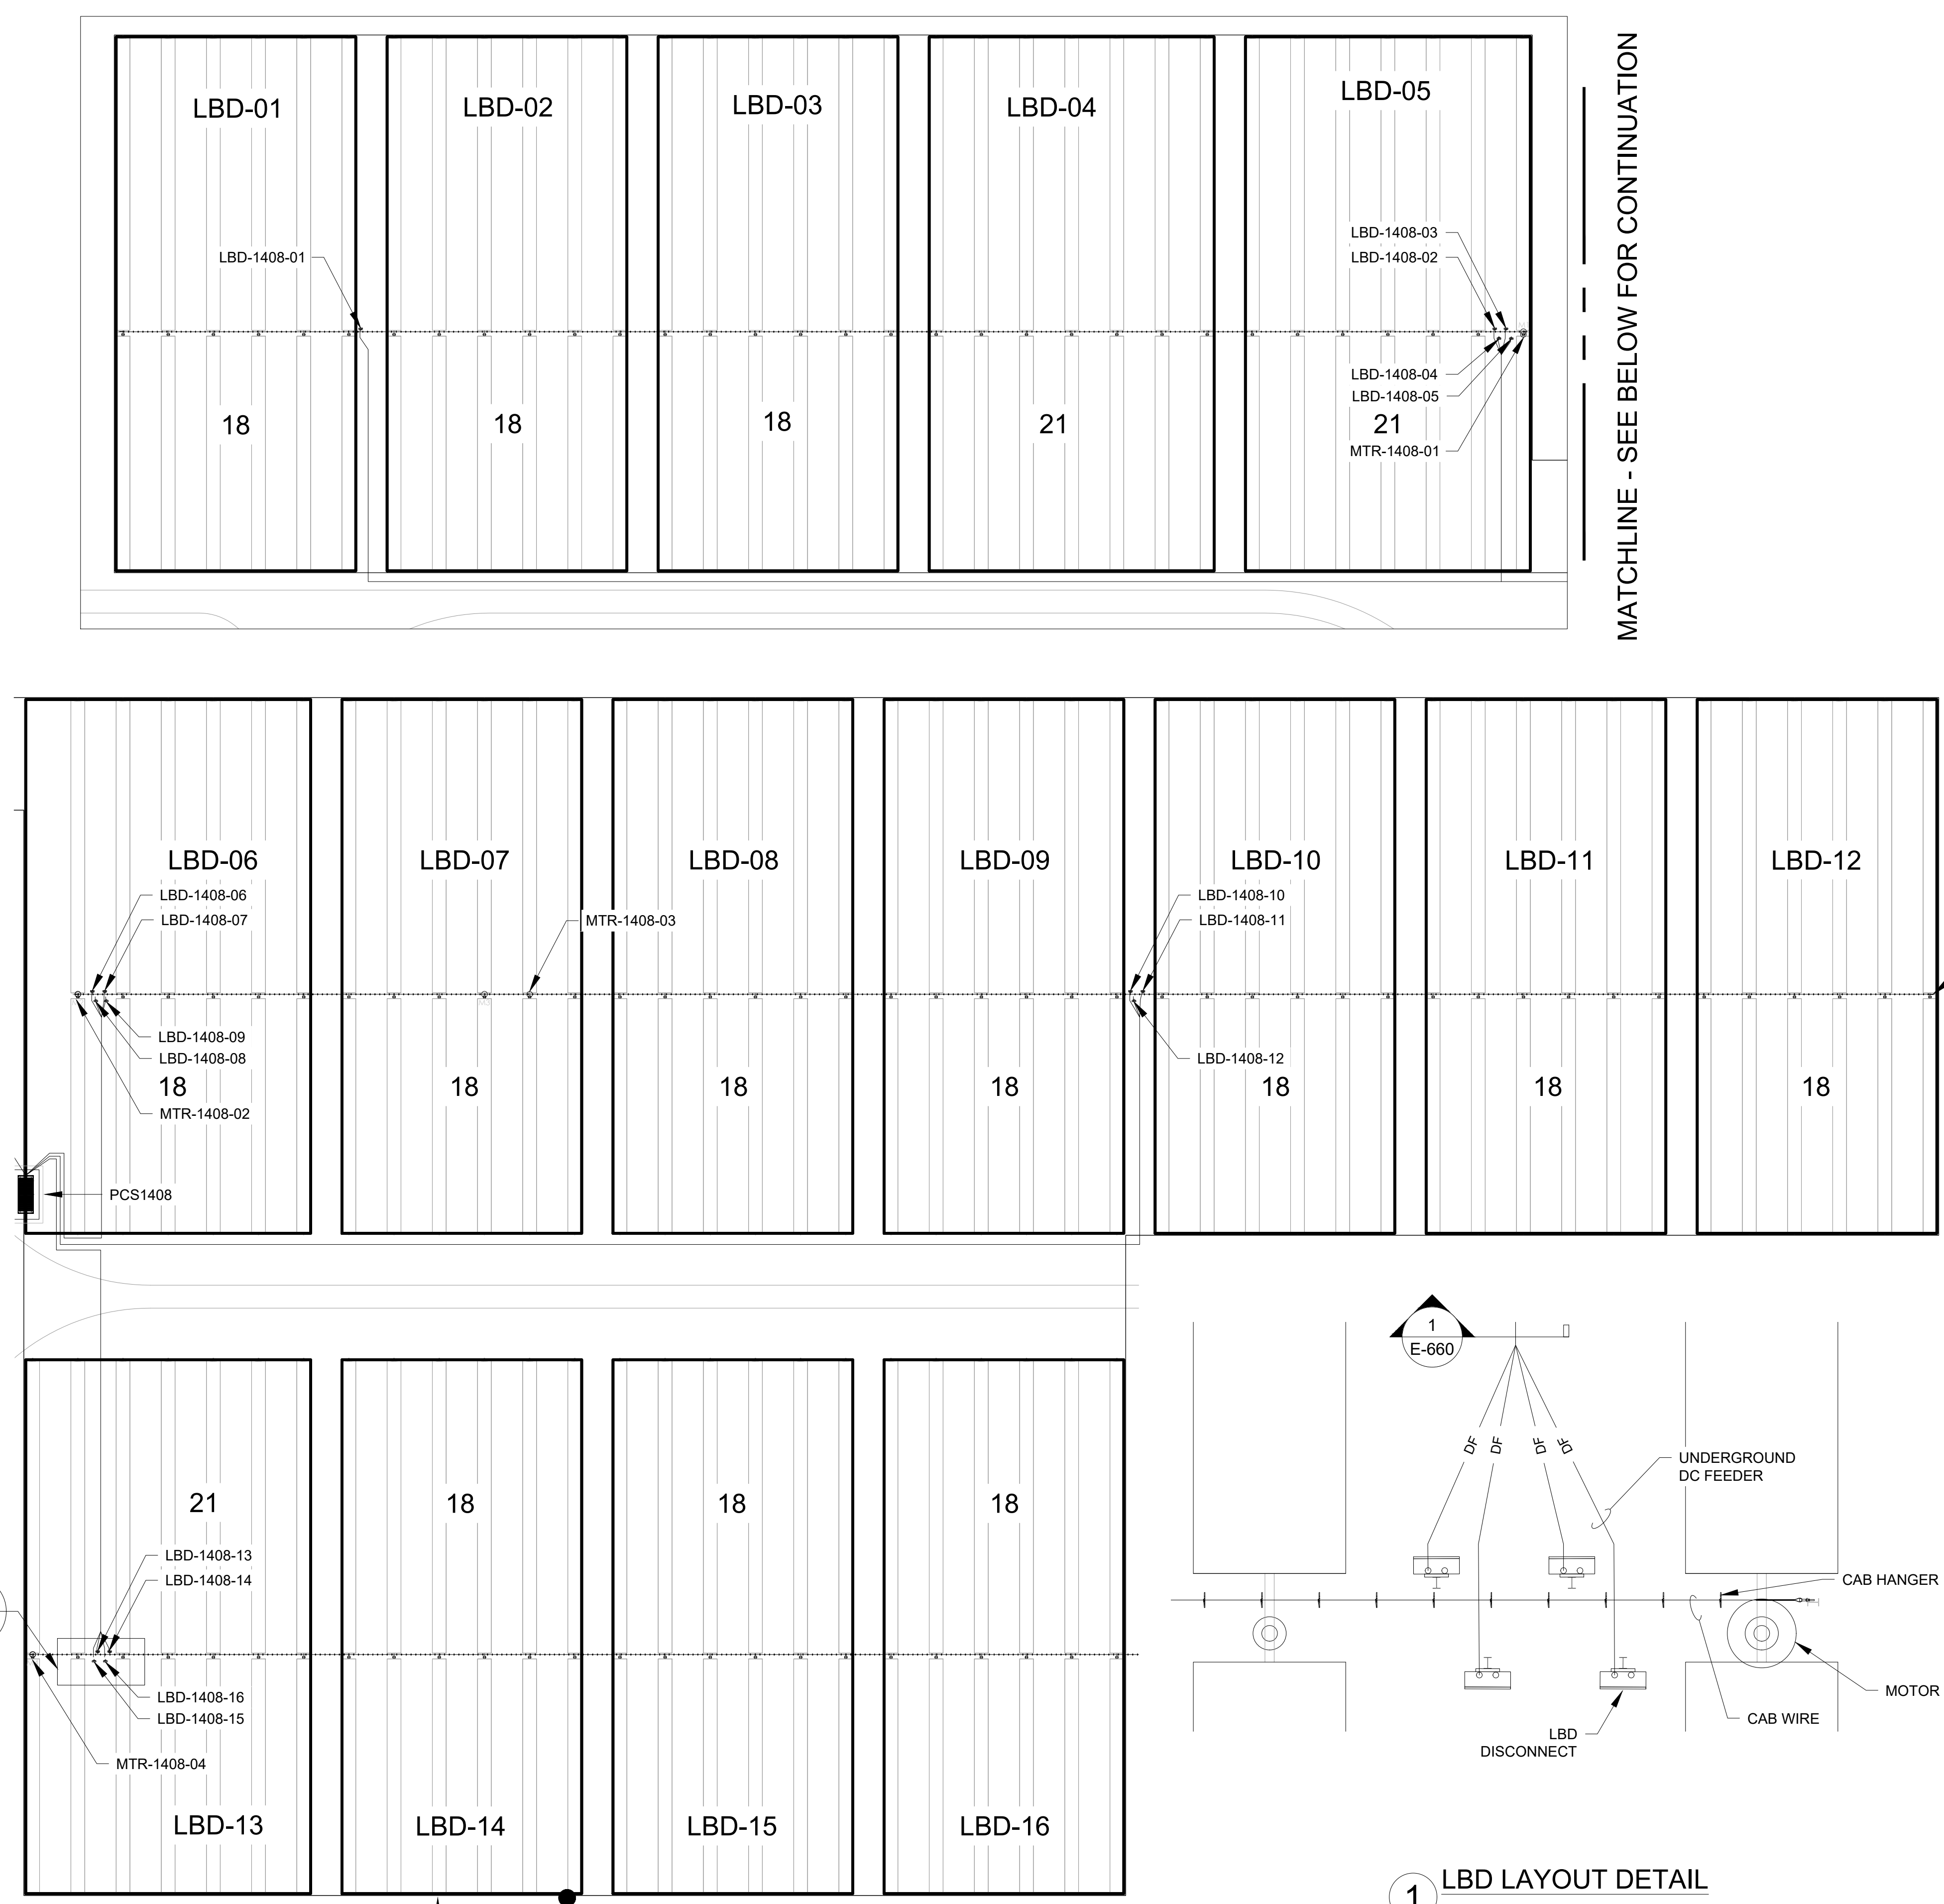

3 STRING TABLE (TYP)
LBD BOUNDARY (TYP)
DC PLAN - ARRAY TYPE - K (JINKO)
SCALE: 1"=60'

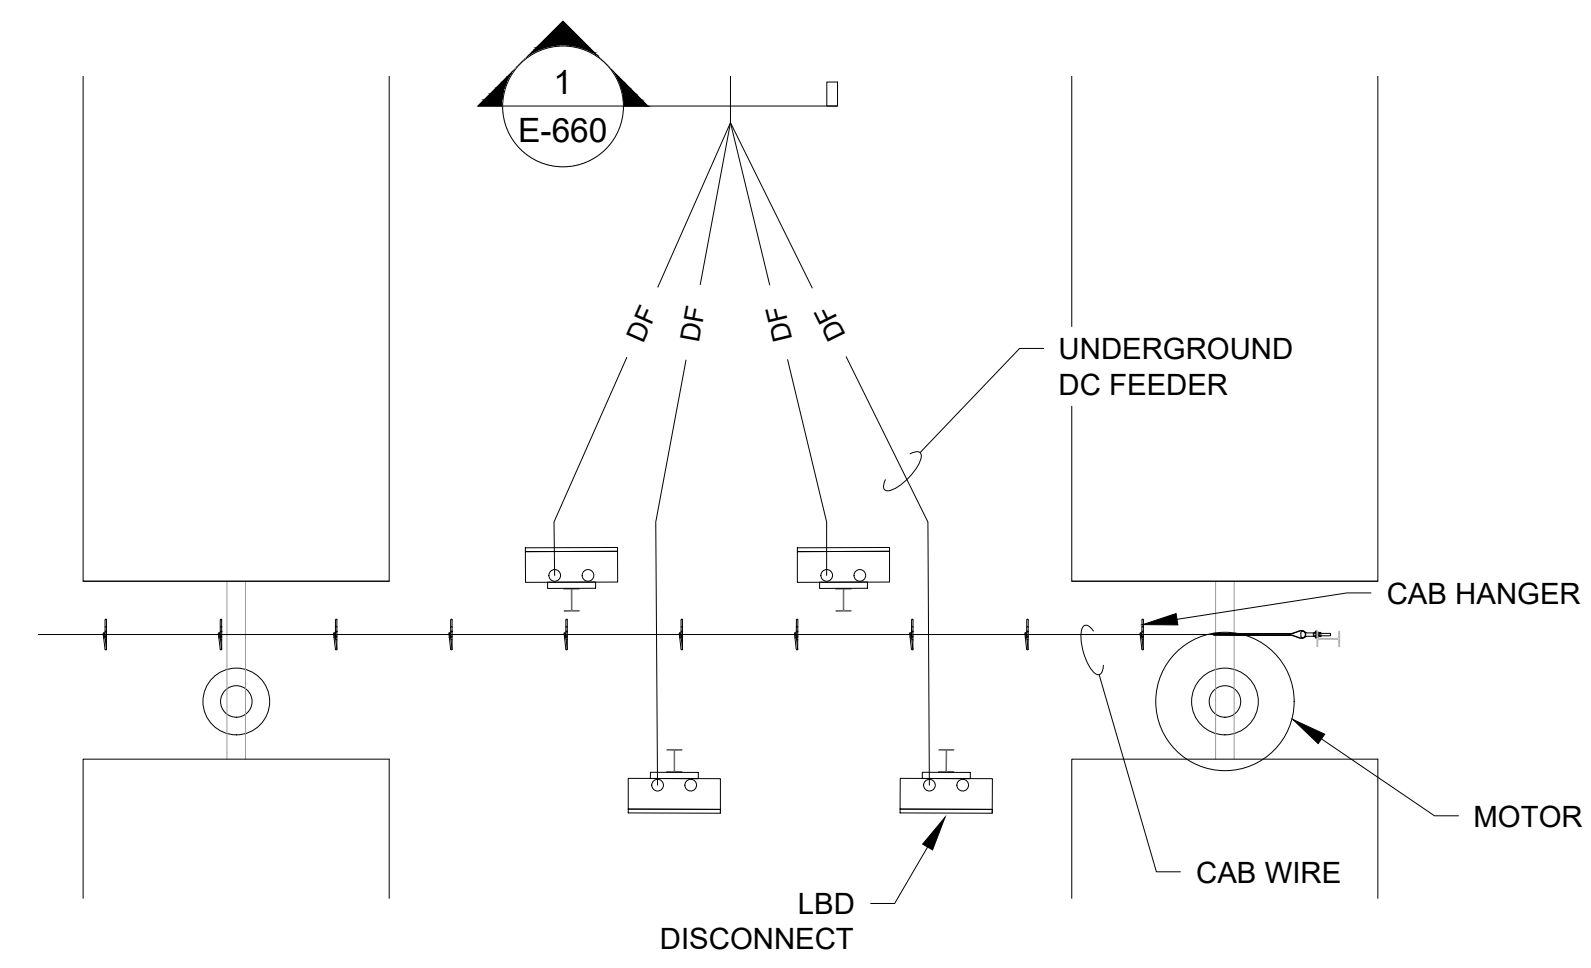

1
LBD LAYOUT DETAIL
SCALE: 1"=60'

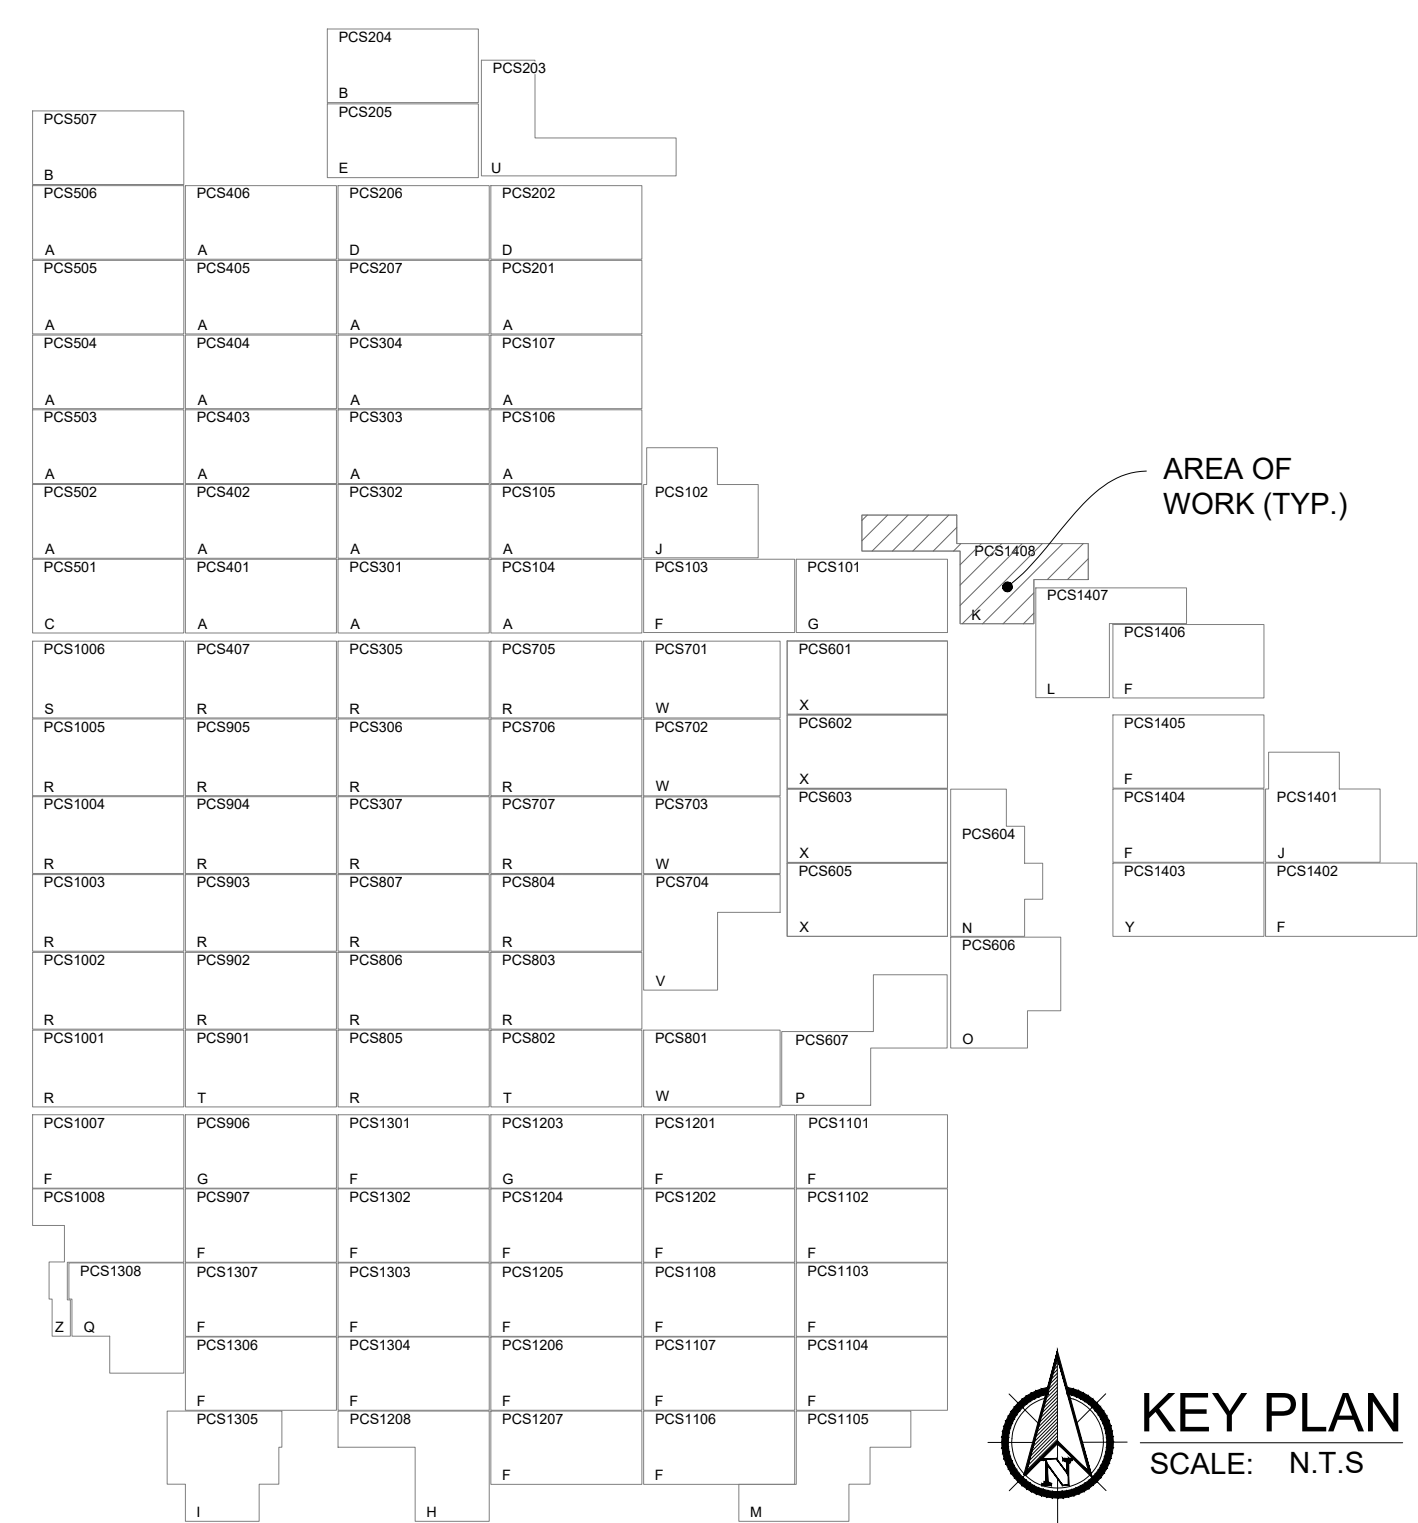

KEY PLAN
SCALE: N.T.S.

- NOTES:
- DC FEEDER TAGS ARE SAME AS LBD TAGS EXCEPT SUBSTITUTING 'DF' IN PLACE OF 'LBD'.
 - REFER TO SHEET E-005 - BLOCK SCHEDULE AND SHEET E-011 - MODULE ALLOCATION PLAN FOR SPECIFIC INFORMATION REGARDING MODULE QUANTITIES ASSOCIATED WITH PCS-SPECIFIC ARRAY TYPES.

LEGEND:

— DF — DC FEEDER

— HANGER SYSTEM

ARRAY TYPE	ASSOCIATED PCS
A	PCS104 PCS105 PCS106 PCS107 PCS201 PCS207 PCS301 PCS302 PCS303 PCS304 PCS401 PCS402 PCS403 PCS404 PCS405 PCS406 PCS502 PCS503 PCS504 PCS505 PCS506
B	PCS204 PCS507
C	PCS501
D	PCS202 PCS206
E	PCS205
F	PCS103 PCS907 PCS1007 PCS1101 PCS1102 PCS1103 PCS1104 PCS1106 PCS1107 PCS1108 PCS1201 PCS1202 PCS1204 PCS1205 PCS1206 PCS1207 PCS1301 PCS1302 PCS1303 PCS1304 PCS1306 PCS1307 PCS1402 PCS1404 PCS1405 PCS1406
G	PCS101 PCS906 PCS1203
H	PCS1208
I	PCS1305
J	PCS102 PCS1401
K	PCS1408
L	PCS1407
M	PCS1105
N	PCS604
O	PCS606
P	PCS607
Q	PCS1308
R	PCS305 PCS306 PCS307 PCS407 PCS705 PCS706 PCS707 PCS803 PCS804 PCS805 PCS806 PCS807 PCS902 PCS903 PCS904 PCS905 PCS1001 PCS1002 PCS1003 PCS1004 PCS1005
S	PCS1006
T	PCS802 PCS901
U	PCS203
V	PCS704
W	PCS701 PCS702 PCS703 PCS801
X	PCS601 PCS602 PCS603 PCS605
Y	PCS1403
Z	PCS1008

FastGrid

FastGrid, LLC
225 E Germann Road
Suite 301
Gilbert, AZ 85297

REV	DESCRIPTION	DATE
4	RECORD DRAWINGS	06/08/2023


PROJECT NAME:
EAGLE SHADOW MOUNTAIN
PV SOLAR POWER
GENERATION FACILITY

PROJECT ADDRESS:
I-15
CRYSTAL, NV
CLARK COUNTY

SEAL:	DATE: 10/16/2020
	PROJECT #: 190067.03
	DRAWN BY: NK
	CHECKED BY: EL

SHEET NAME:
DC PLAN - ARRAY TYPE K (JINKO)

SHEET #: E-411	REV #: 4
-------------------	-------------

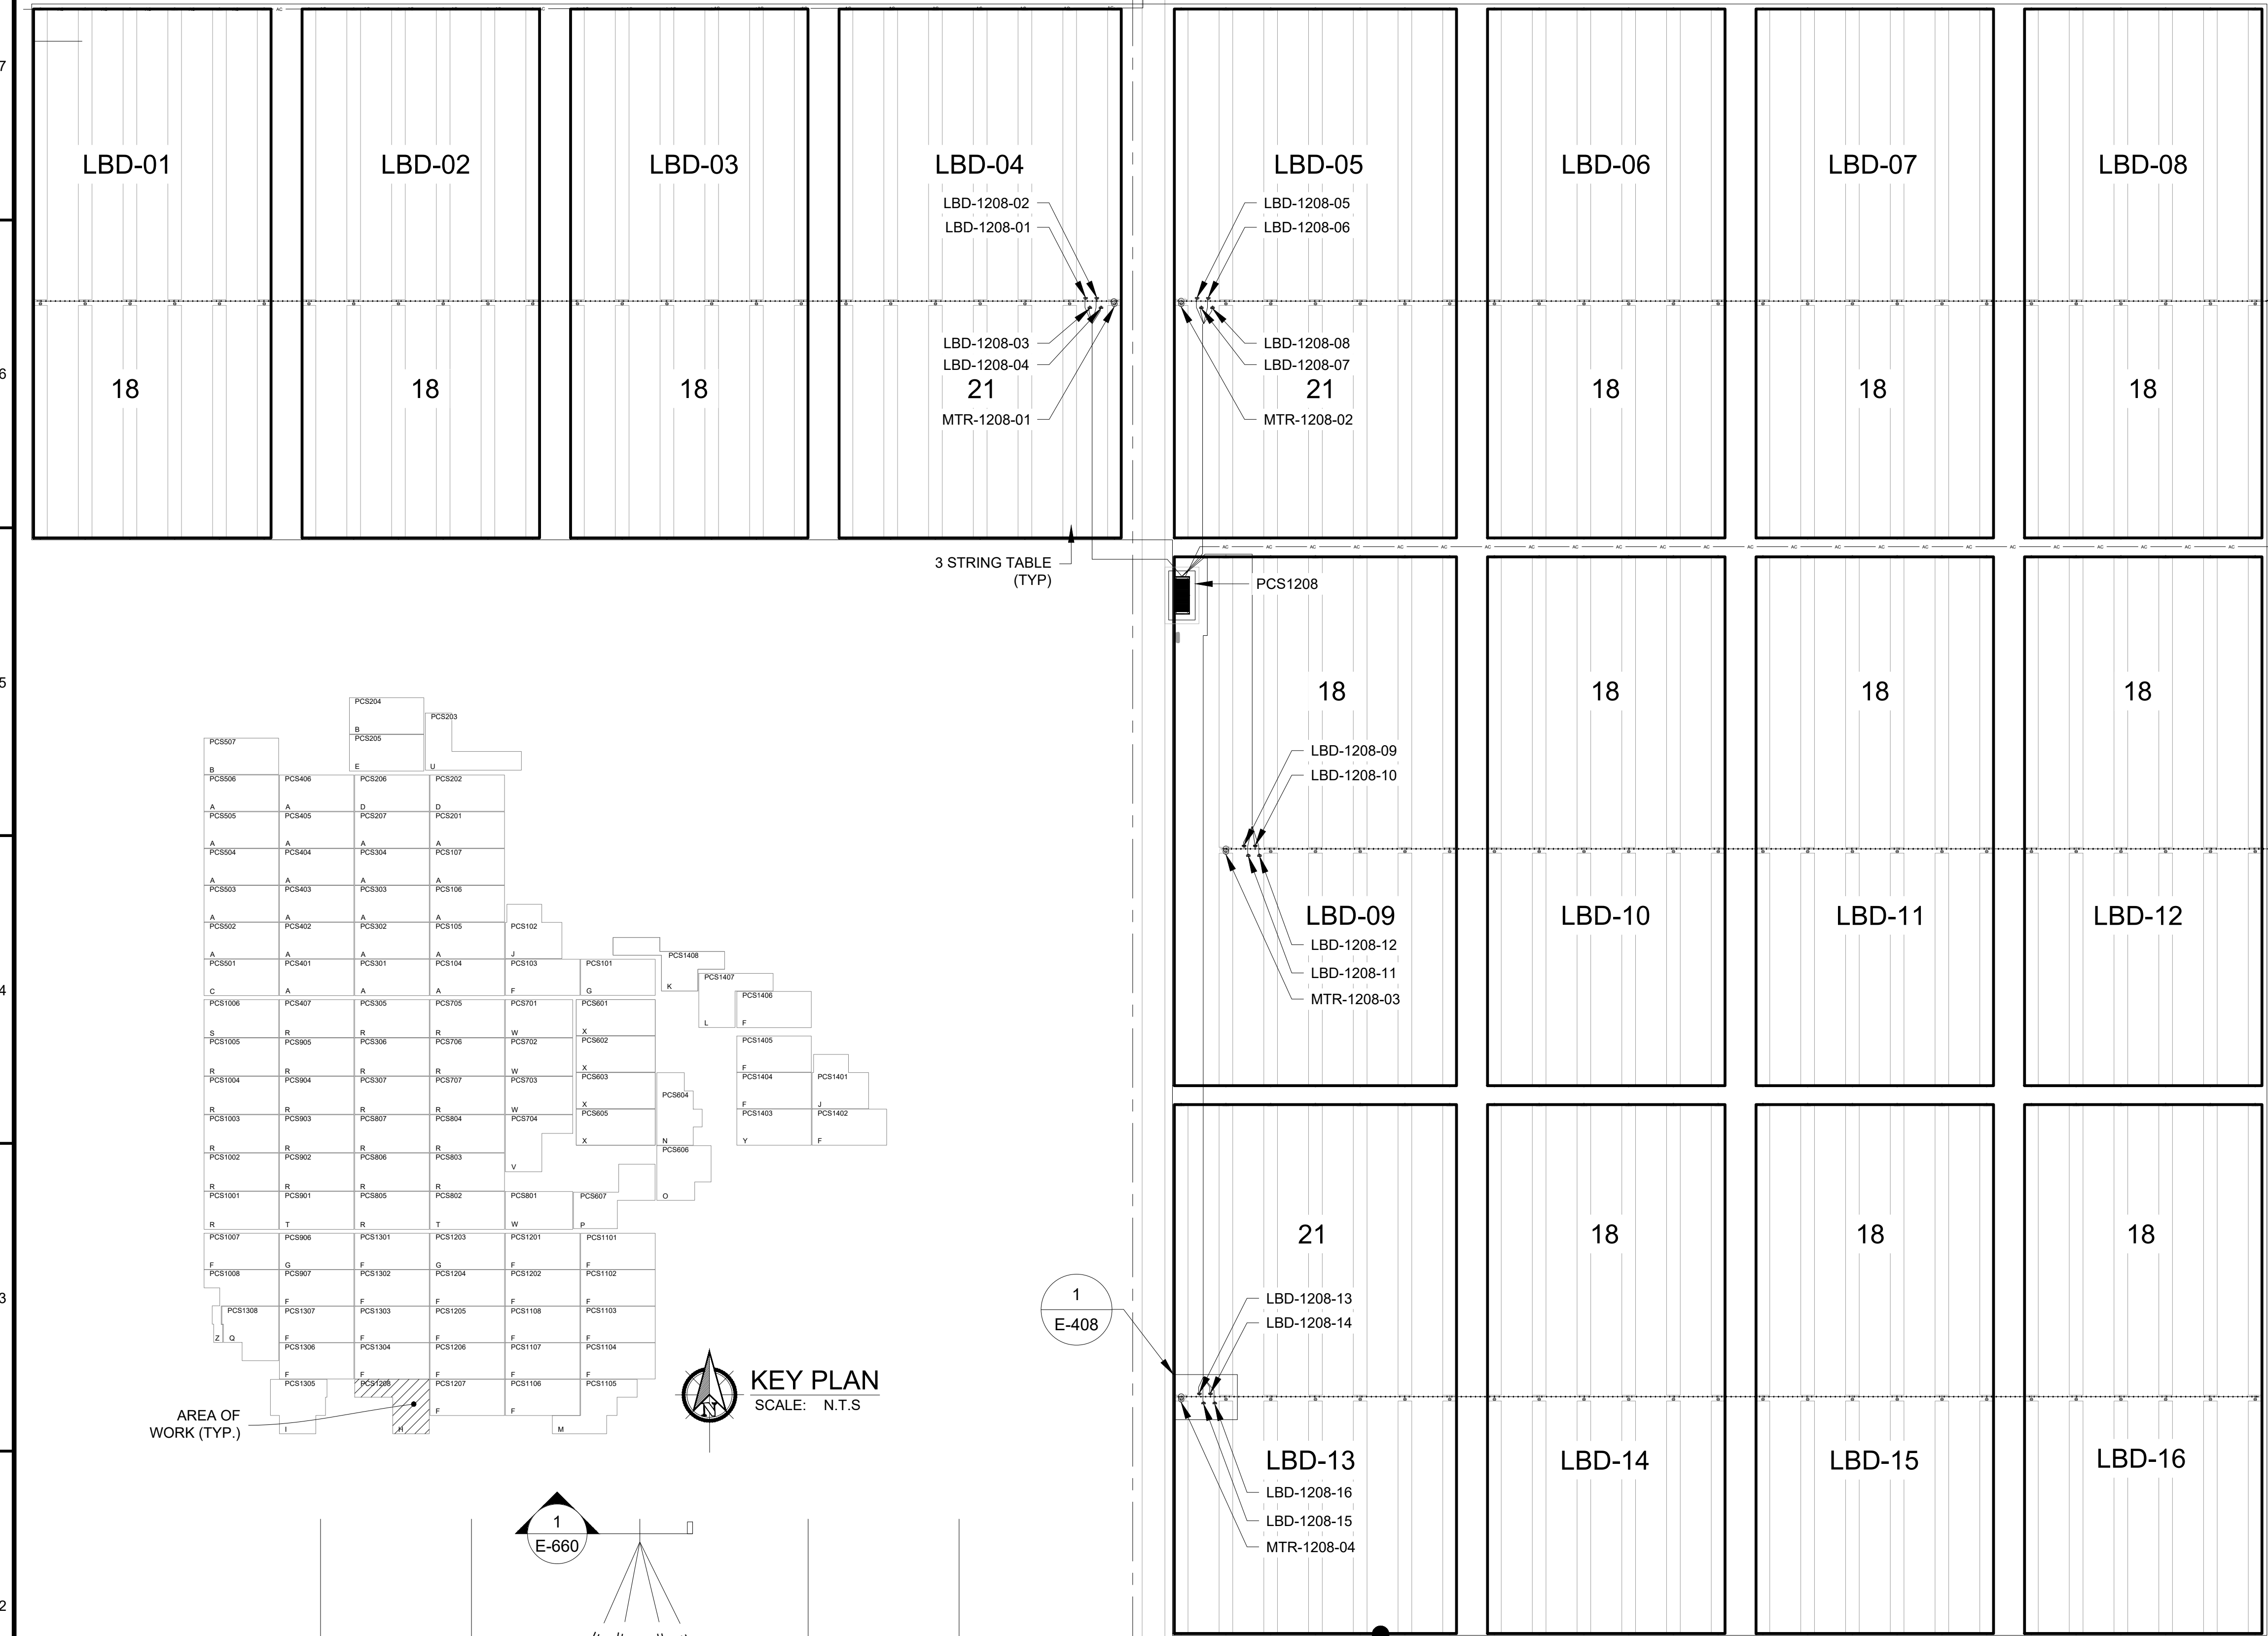

NOTES:

- DC FEEDER TAGS ARE SAME AS LBD TAGS EXCEPT SUBSTITUTING 'DF' IN PLACE OF 'LBD'.
- REFER TO SHEET E-005 - BLOCK SCHEDULE AND SHEET E-011 - MODULE ALLOCATION PLAN FOR SPECIFIC INFORMATION REGARDING MODULE QUANTITIES ASSOCIATED WITH PCS-SPECIFIC ARRAY TYPES.

LEGEND:

— DF — DC FEEDER

— HANGER SYSTEM

ARRAY TYPE	ASSOCIATED PCS
A	PCS104 PCS105 PCS106 PCS107 PCS201 PCS207 PCS301 PCS302 PCS303 PCS304 PCS401 PCS402 PCS403 PCS404 PCS405 PCS406 PCS502 PCS503 PCS504 PCS505 PCS506
B	PCS204 PCS507
C	PCS501
D	PCS202 PCS206
E	PCS205
F	PCS103 PCS907 PCS1007 PCS1101 PCS1102 PCS1103 PCS1104 PCS1106 PCS1107 PCS1108 PCS1201 PCS1202 PCS1204 PCS1205 PCS1206 PCS1207 PCS1301 PCS1302 PCS1303 PCS1304 PCS1306 PCS1307 PCS1402 PCS1404 PCS1405 PCS1406
G	PCS101 PCS906 PCS1203
H	PCS1208
I	PCS1305
J	PCS102 PCS1401
K	PCS1408
L	PCS1407
M	PCS1105
N	PCS604
O	PCS606
P	PCS607
Q	PCS1308
R	PCS305 PCS306 PCS307 PCS407 PCS705 PCS706 PCS707 PCS803 PCS804 PCS805 PCS806 PCS807 PCS902 PCS903 PCS904 PCS905 PCS1001 PCS1002 PCS1003 PCS1004 PCS1005
S	PCS1006
T	PCS802 PCS901
U	PCS203
V	PCS704
W	PCS701 PCS702 PCS703 PCS801
X	PCS601 PCS602 PCS603 PCS605
Y	PCS1403
Z	PCS1008

FastGrid

FastGrid, LLC

225 E Germann Road

Suite 301

Gilbert, AZ 85297

REV	DESCRIPTION	DATE
4	RECORD DRAWINGS	06/08/2023

PROJECT NAME:

EAGLE SHADOW MOUNTAIN
PV SOLAR POWER
GENERATION FACILITY

PROJECT ADDRESS:

I-15
CRYSTAL, NV
CLARK COUNTY

SEAL:

DATE:
10/16/2020

PROJECT #:
190067.03

DRAWN BY:
NK

CHECKED BY:
EL

SHEET NAME:

DC PLAN - ARRAY TYPE H (JINKO)

SHEET #:

REV #:

E-408

4

RECORD DRAWING

7

6

5




4

3


2

1


A B C D E F G H I J

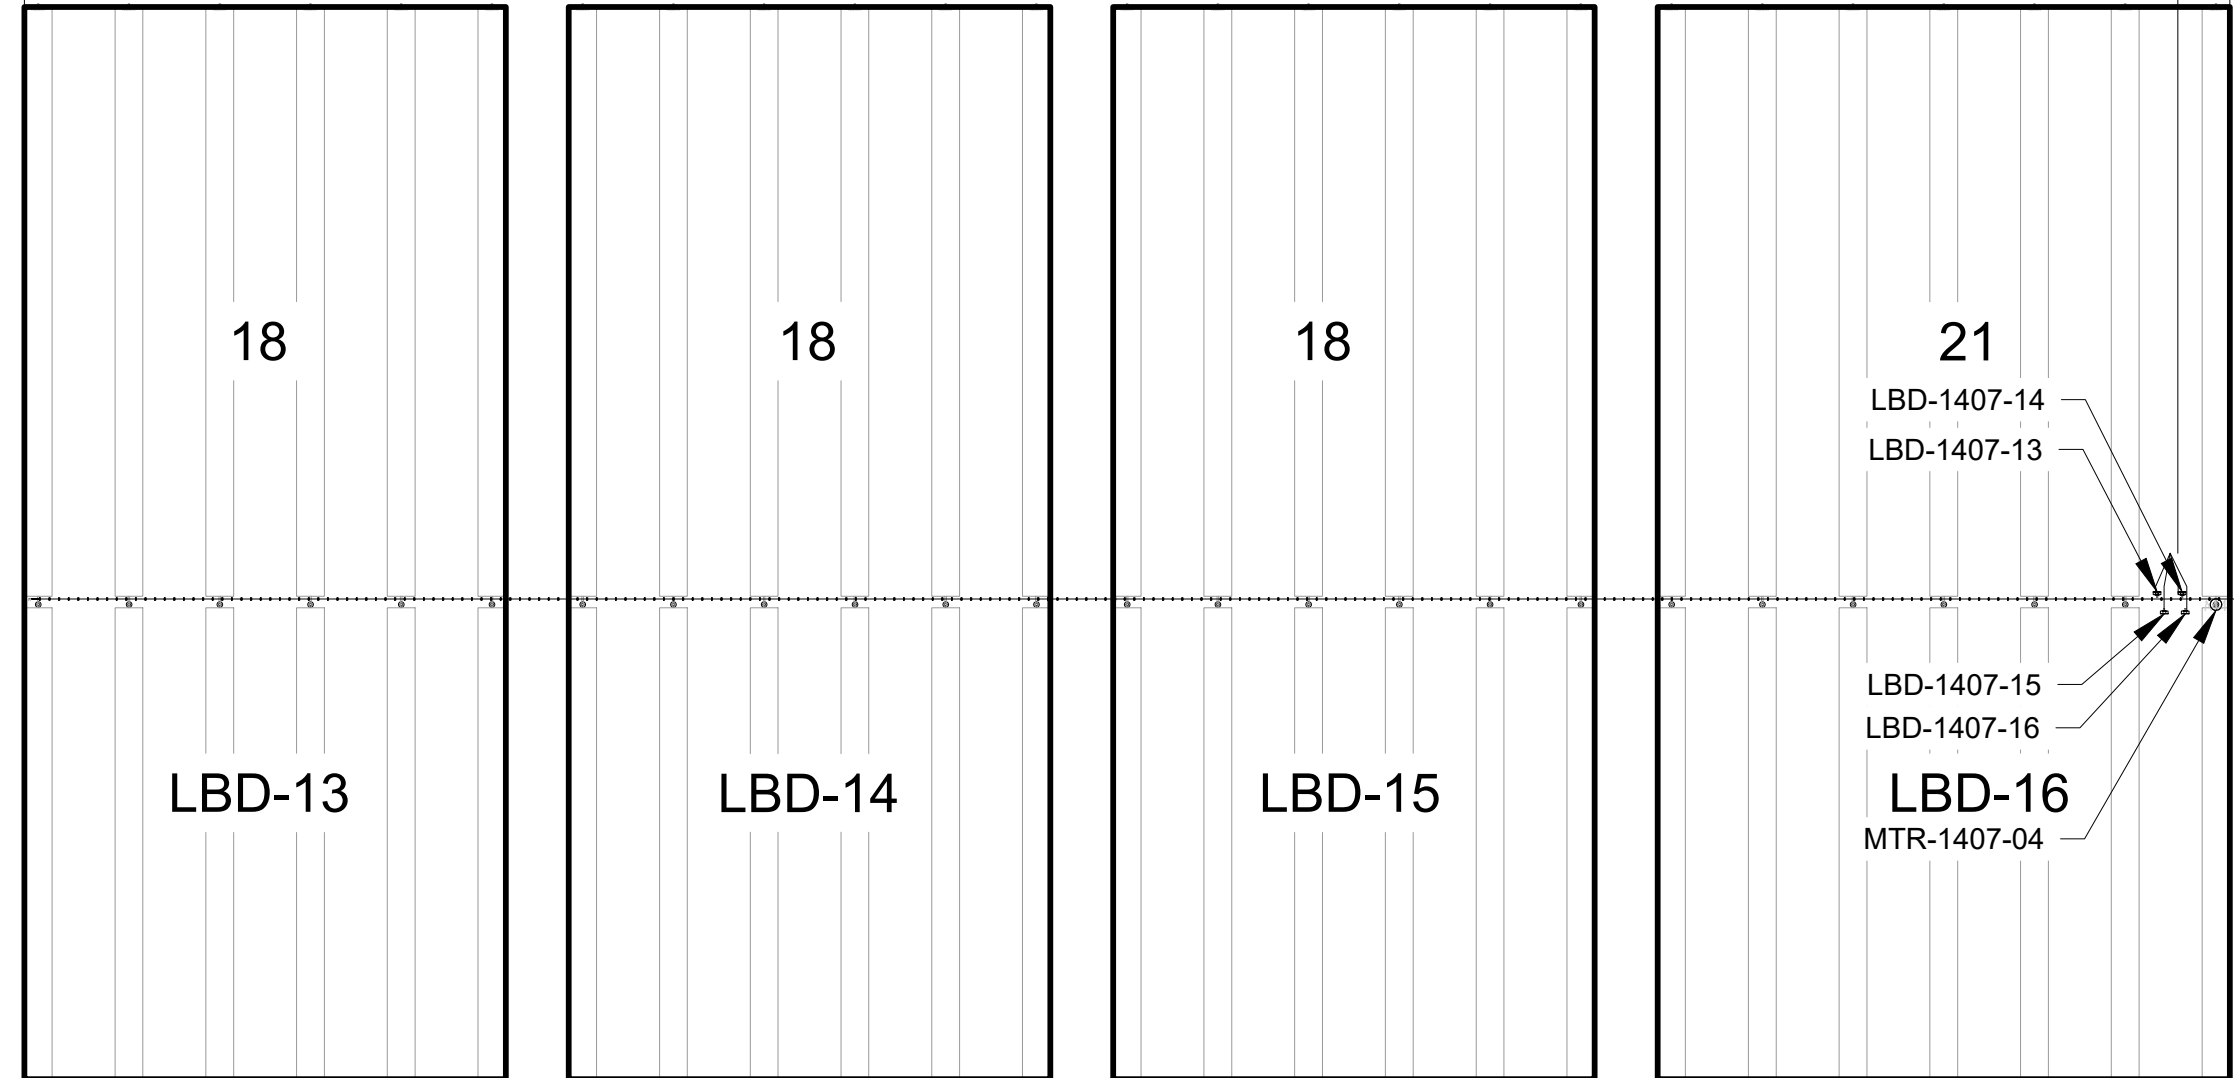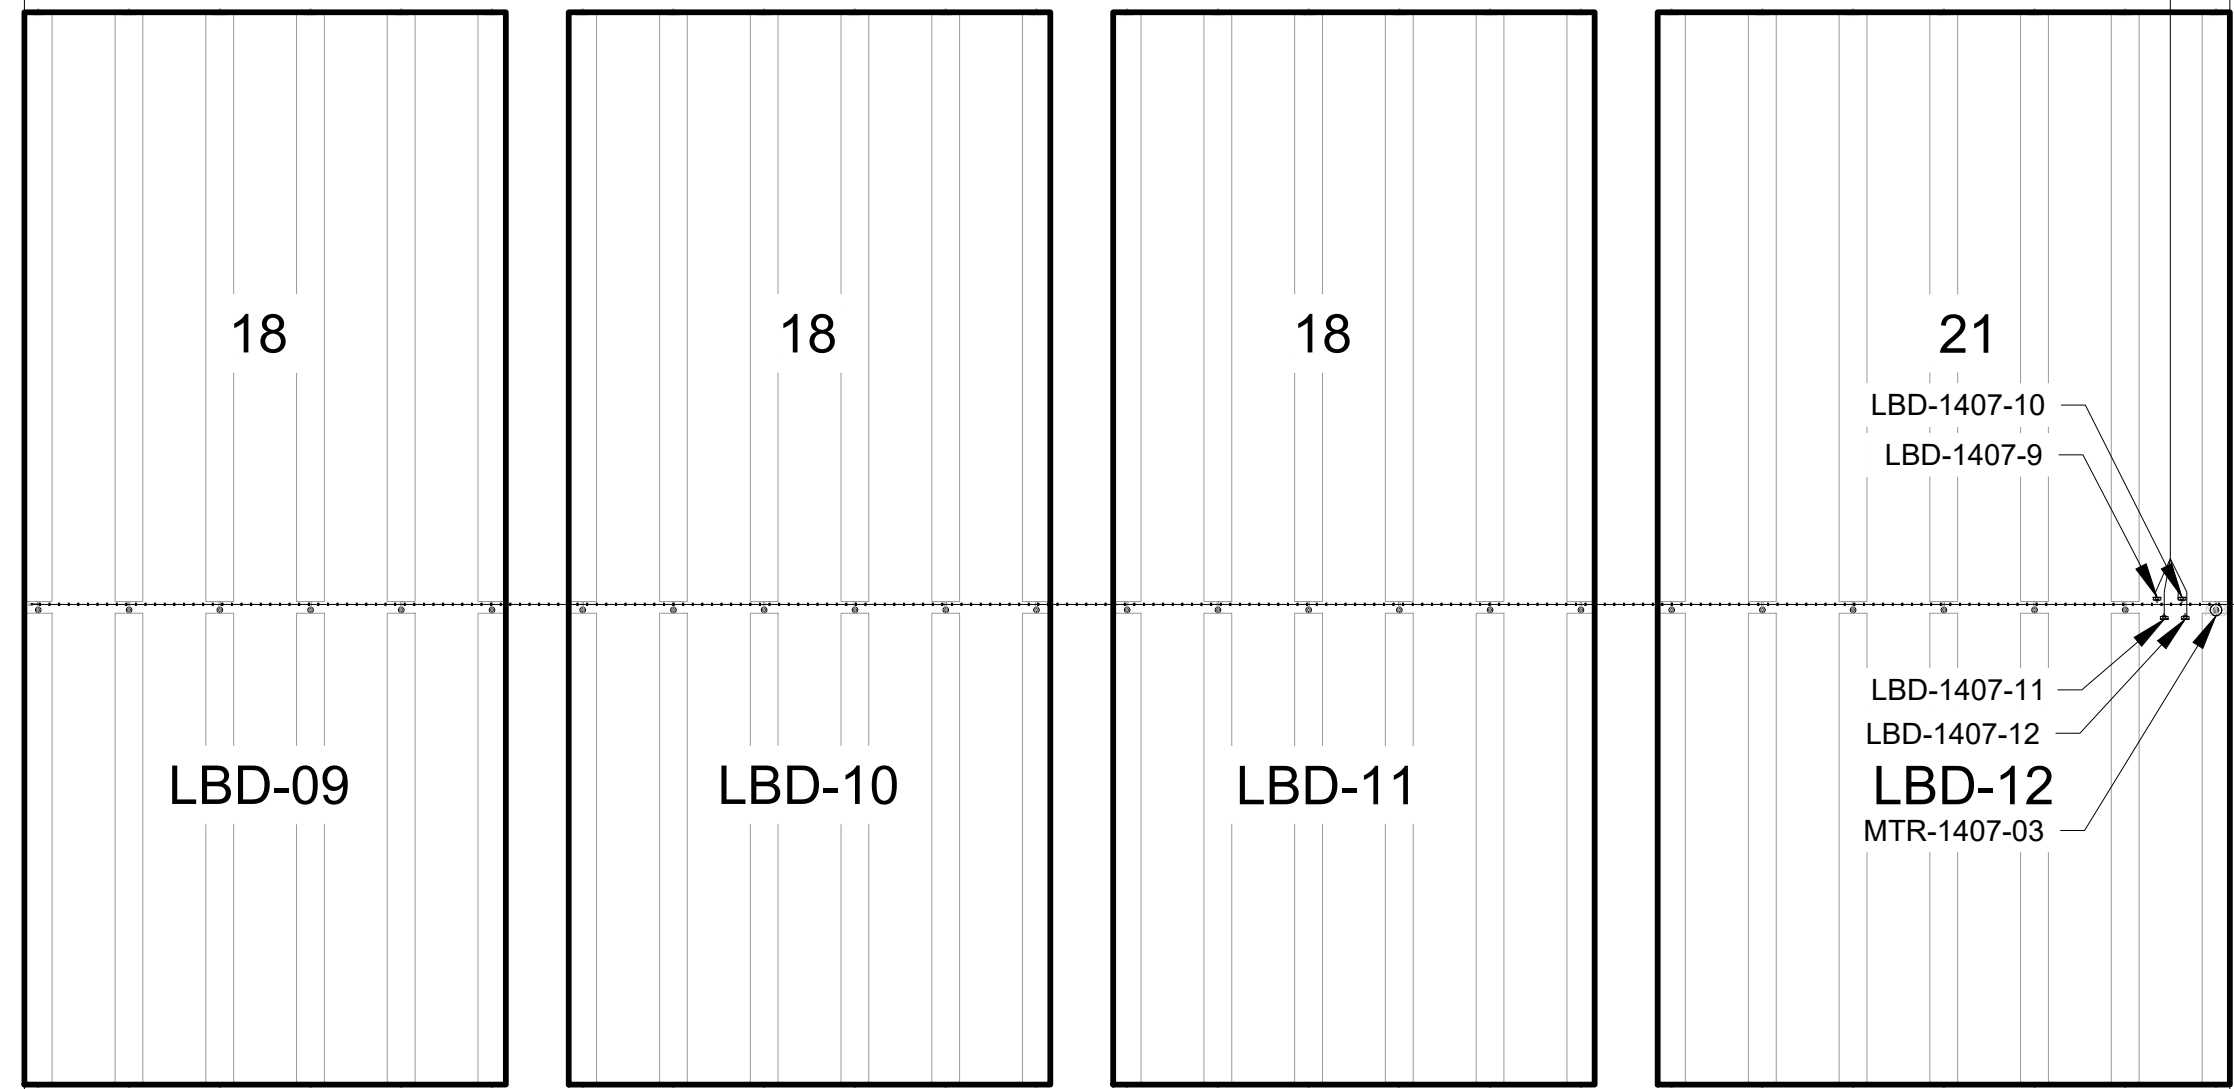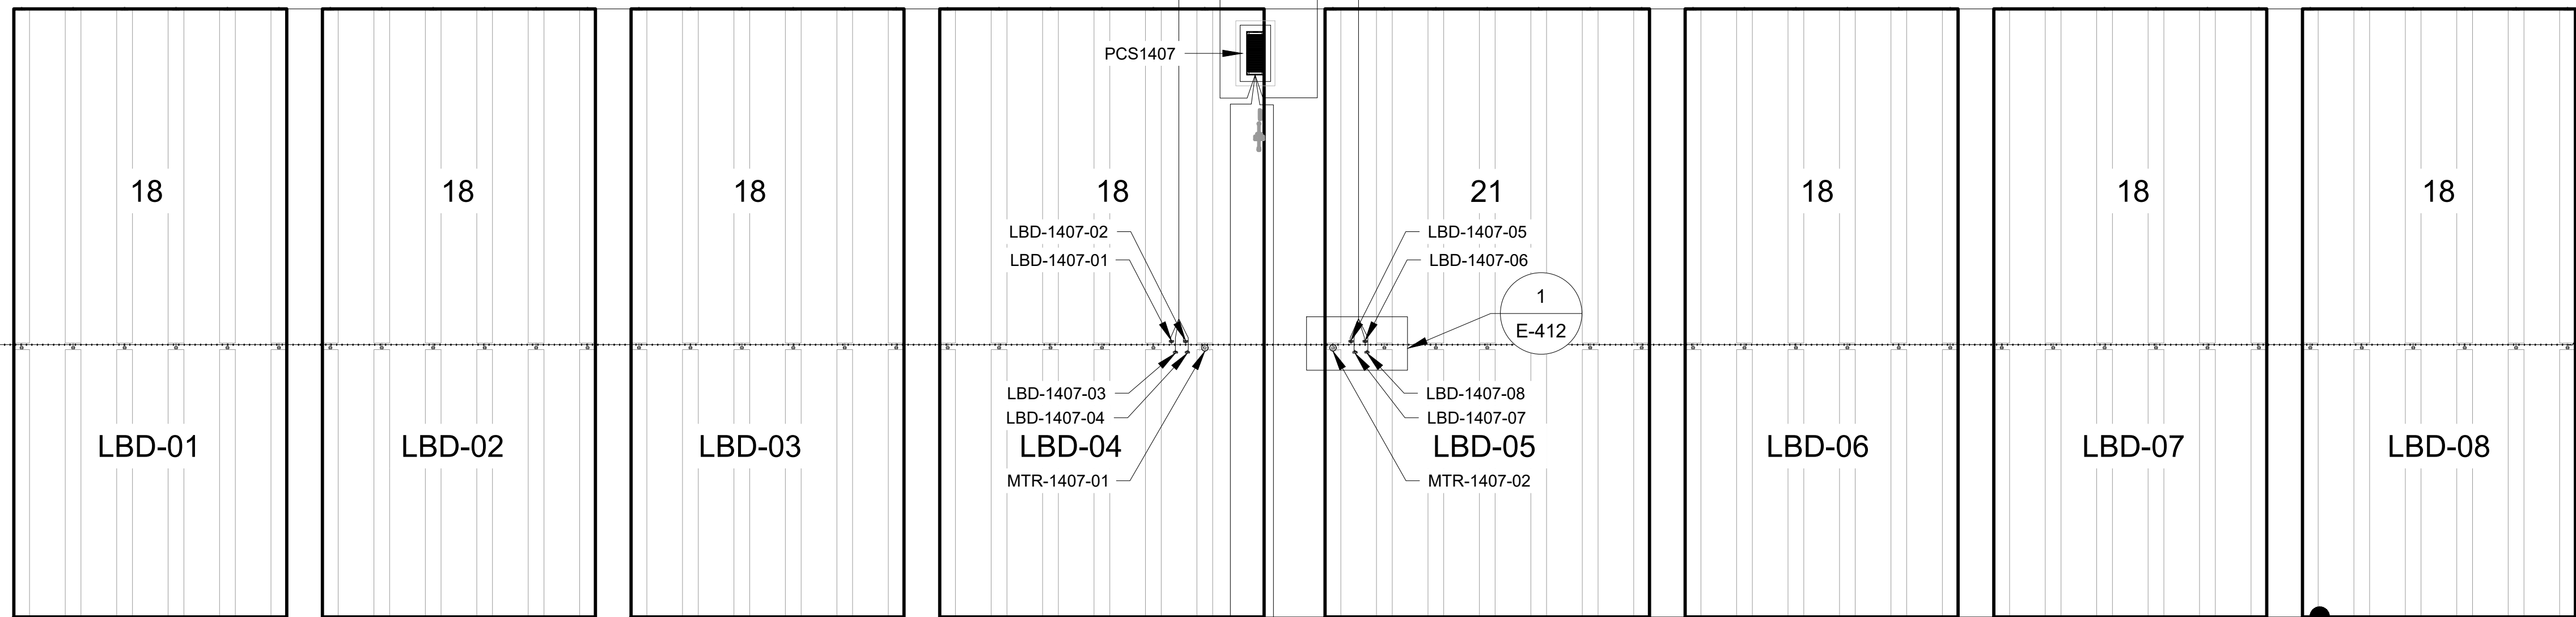

DC PLAN - ARRAY TYPE - L (JINKO)
SCALE: 1"=1600'

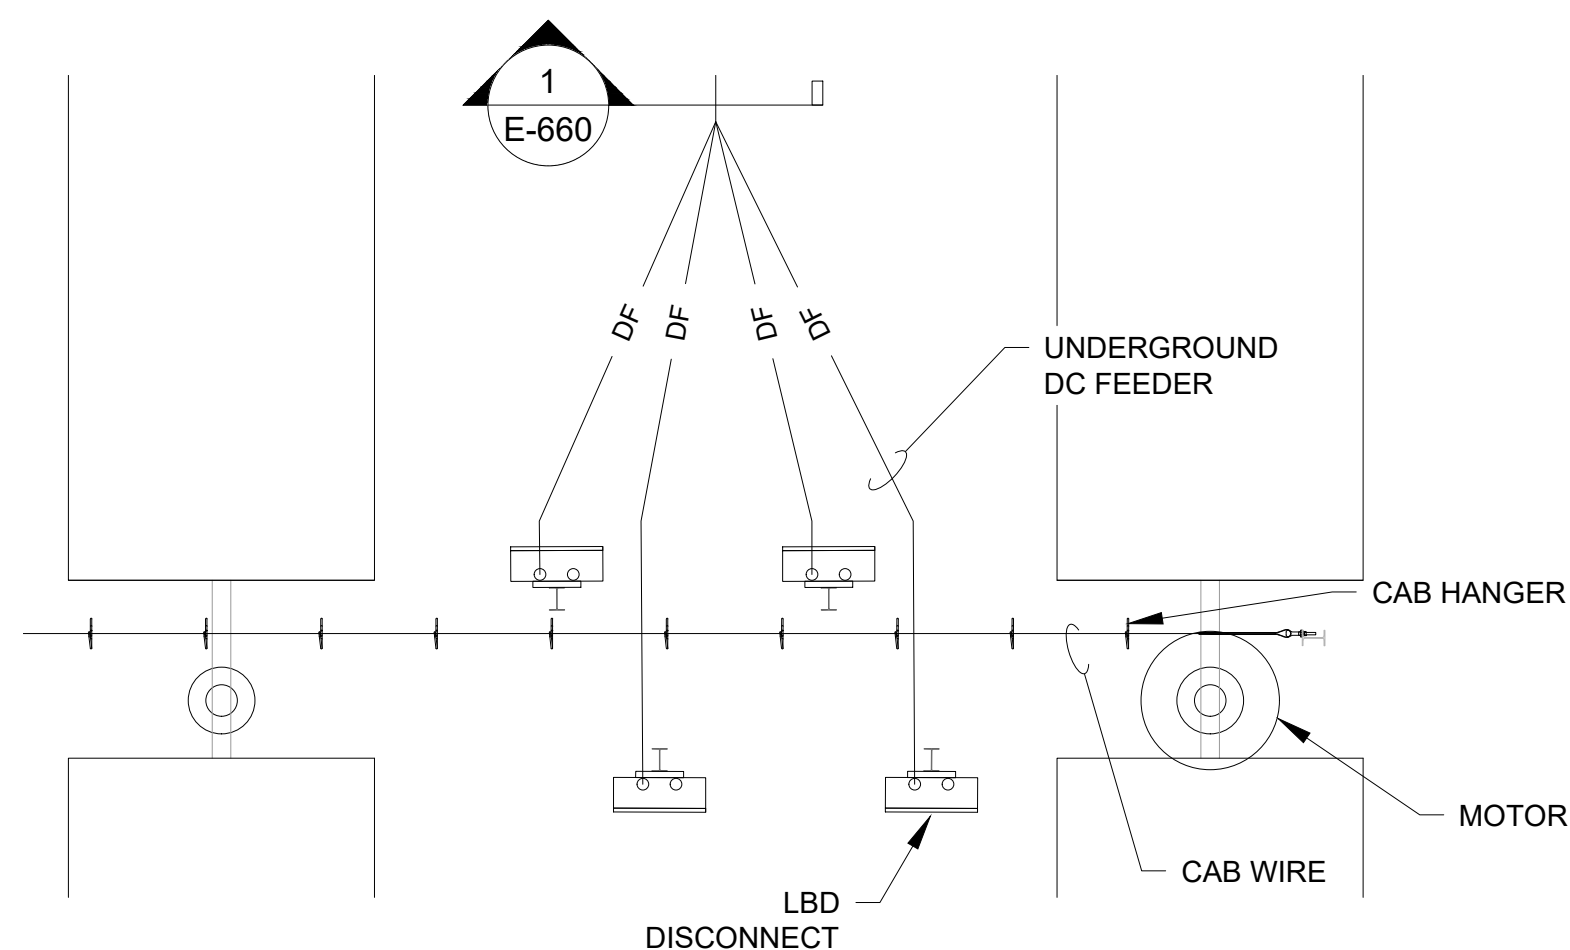

1 LBD LAYOUT DETAIL

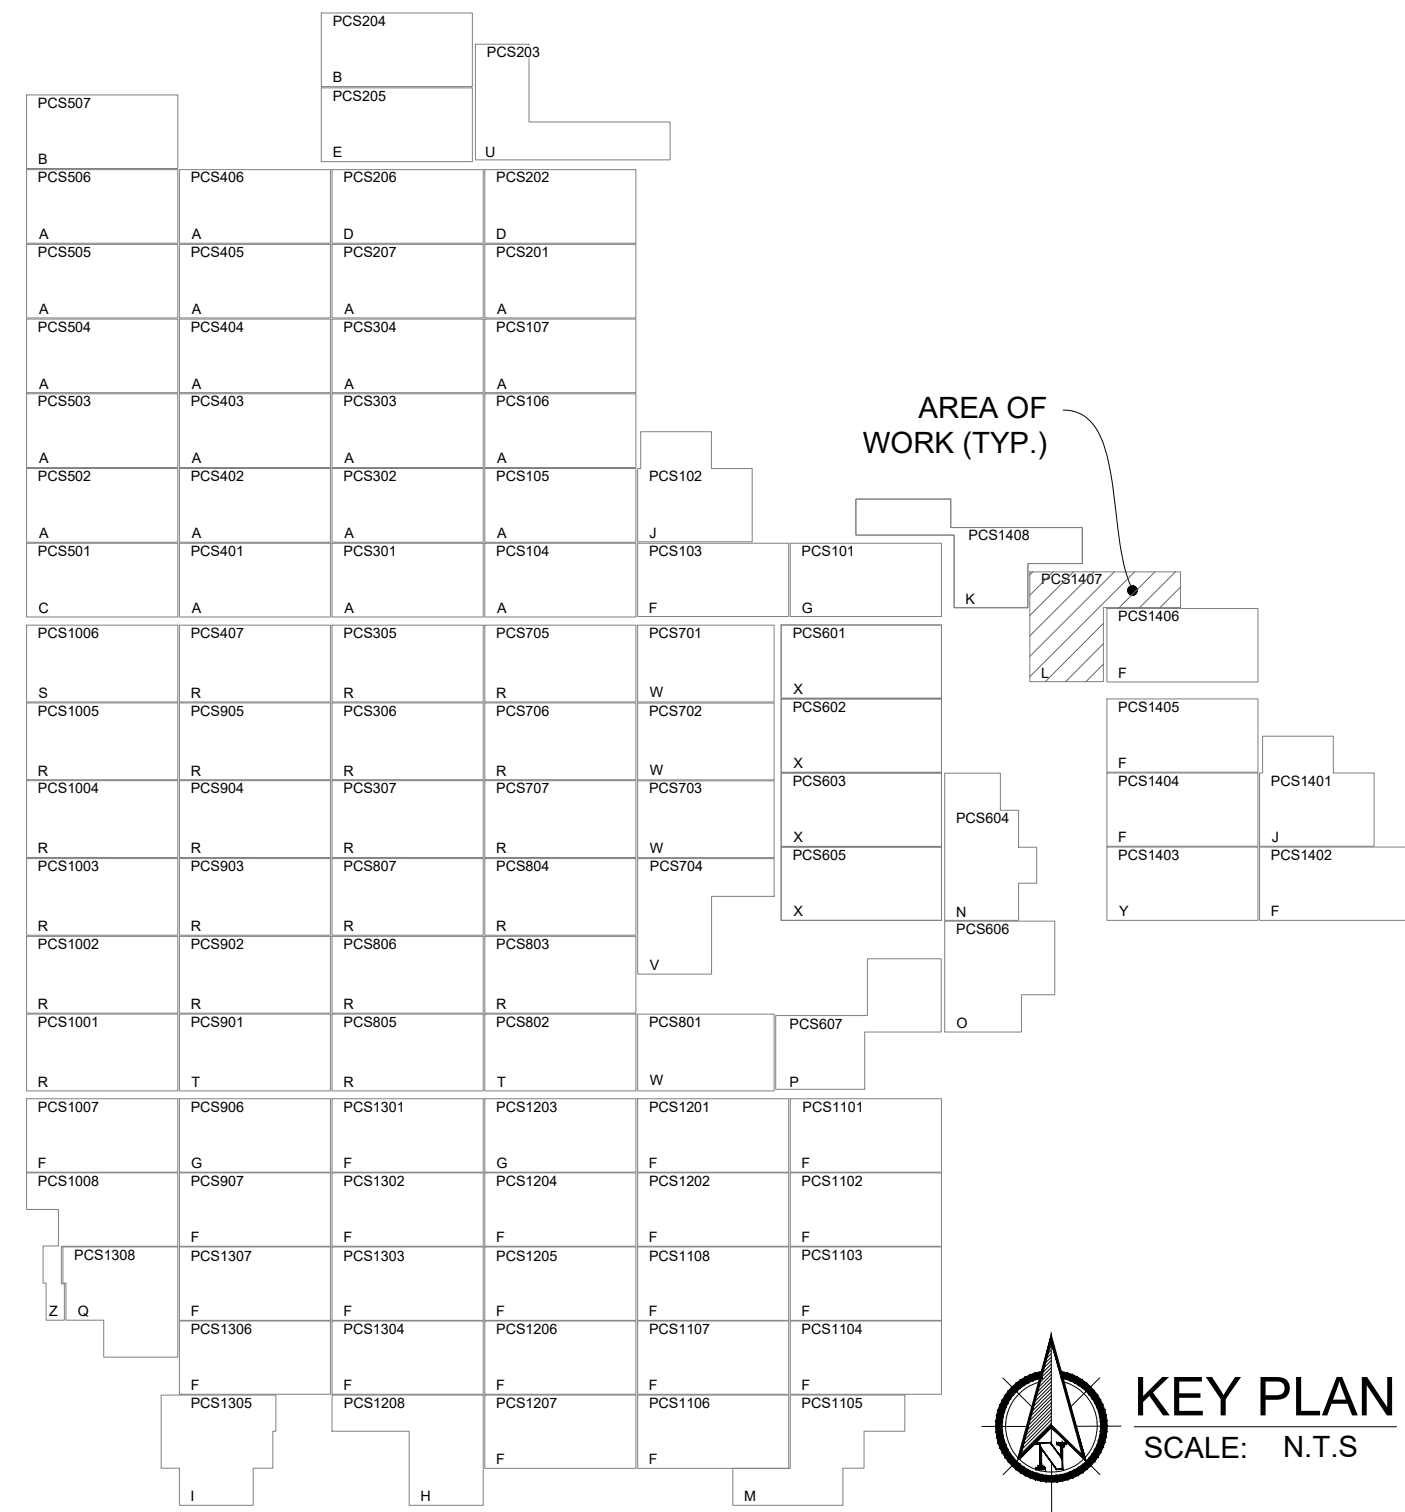

KEY PLAN
SCALE: N.T.S.

- NOTES:
- DC FEEDER TAGS ARE SAME AS LBD TAGS EXCEPT SUBSTITUTING 'DF' IN PLACE OF 'LBD'.
 - REFER TO SHEET E-005 - BLOCK SCHEDULE AND SHEET E-011 - MODULE ALLOCATION PLAN FOR SPECIFIC INFORMATION REGARDING MODULE QUANTITIES ASSOCIATED WITH PCS-SPECIFIC ARRAY TYPES.

- LEGEND:
- DF DC FEEDER
 - HANGER SYSTEM

ARRAY TYPE	ASSOCIATED PCS
A	PCS104 PCS105 PCS106 PCS107 PCS201 PCS207 PCS301 PCS302 PCS303 PCS304 PCS401 PCS402 PCS403 PCS404 PCS405 PCS406 PCS502 PCS503 PCS504 PCS505 PCS506
B	PCS204 PCS507
C	PCS501
D	PCS202 PCS206
E	PCS205
F	PCS103 PCS907 PCS1007 PCS1101 PCS1102 PCS1103 PCS1104 PCS1106 PCS1107 PCS1108 PCS1201 PCS1202 PCS1204 PCS1205 PCS1206 PCS1207 PCS1301 PCS1302 PCS1303 PCS1304 PCS1306 PCS1307 PCS1402 PCS1404 PCS1405 PCS1406
G	PCS101 PCS906 PCS1203
H	PCS1208
I	PCS1305
J	PCS102 PCS1401
K	PCS1408
L	PCS1407
M	PCS1105
N	PCS604
O	PCS606
P	PCS607
Q	PCS1308
R	PCS305 PCS306 PCS307 PCS407 PCS705 PCS706 PCS707 PCS803 PCS804 PCS805 PCS806 PCS807 PCS902 PCS903 PCS904 PCS905 PCS1001 PCS1002 PCS1003 PCS1004 PCS1005
S	PCS1006
T	PCS802 PCS901
U	PCS203
V	PCS704
W	PCS701 PCS702 PCS703 PCS801
X	PCS601 PCS602 PCS603 PCS605
Y	PCS1403
Z	PCS1008



REV	DESCRIPTION	DATE
4	RECORD DRAWINGS	06/08/2023

PROJECT NAME:
**EAGLE SHADOW MOUNTAIN
PV SOLAR POWER
GENERATION FACILITY**

PROJECT ADDRESS:
**I-15
CRYSTAL, NV
CLARK COUNTY**



SEAL: DATE: **10/16/2020**
PROJECT #: **190067.03**
DRAWN BY: **NK**
CHECKED BY: **EL**

SHEET NAME:
DC PLAN - ARRAY TYPE L (JINKO)

SHEET #: **E-412** REV #: **4**

RECORD DRAWING

LOCATION: K:_09_PROJECTS\190067.03 - PRIMORIS - EAGLE SHADOW MOUNTAIN\05 ENGINEERING\DWG\E-412 DC PLAN - ARRAY TYPE L (JINKO) PLOT DATE: Thursday, June 08, 2023 PLOT BY: Brady Burgesson SAVED BY: gregg jooney

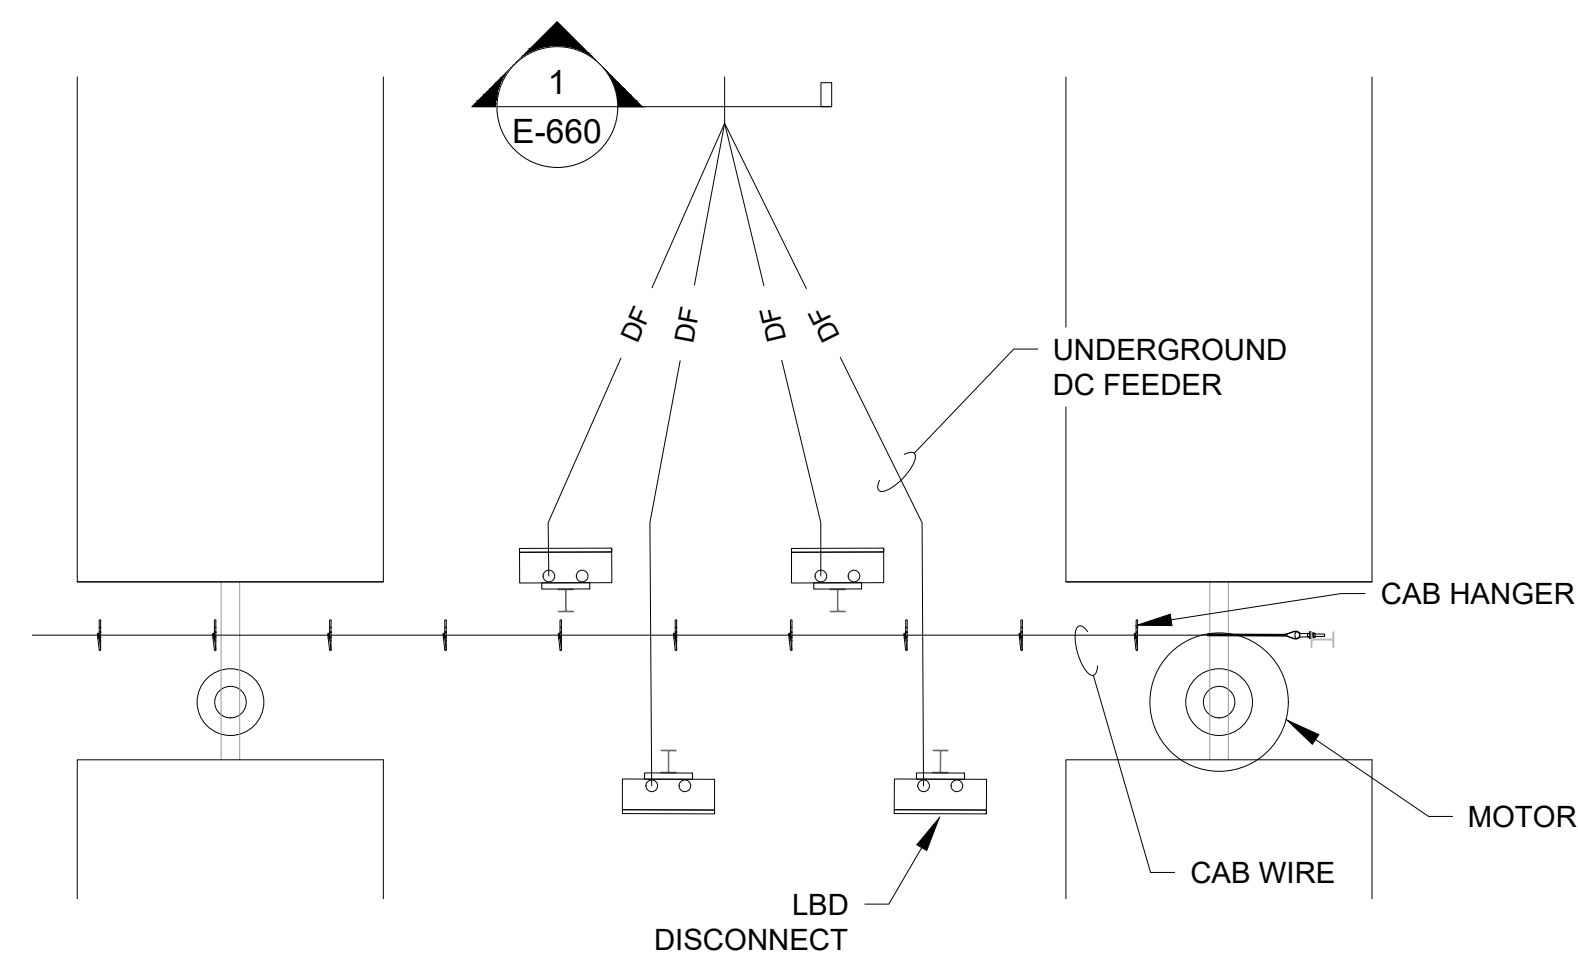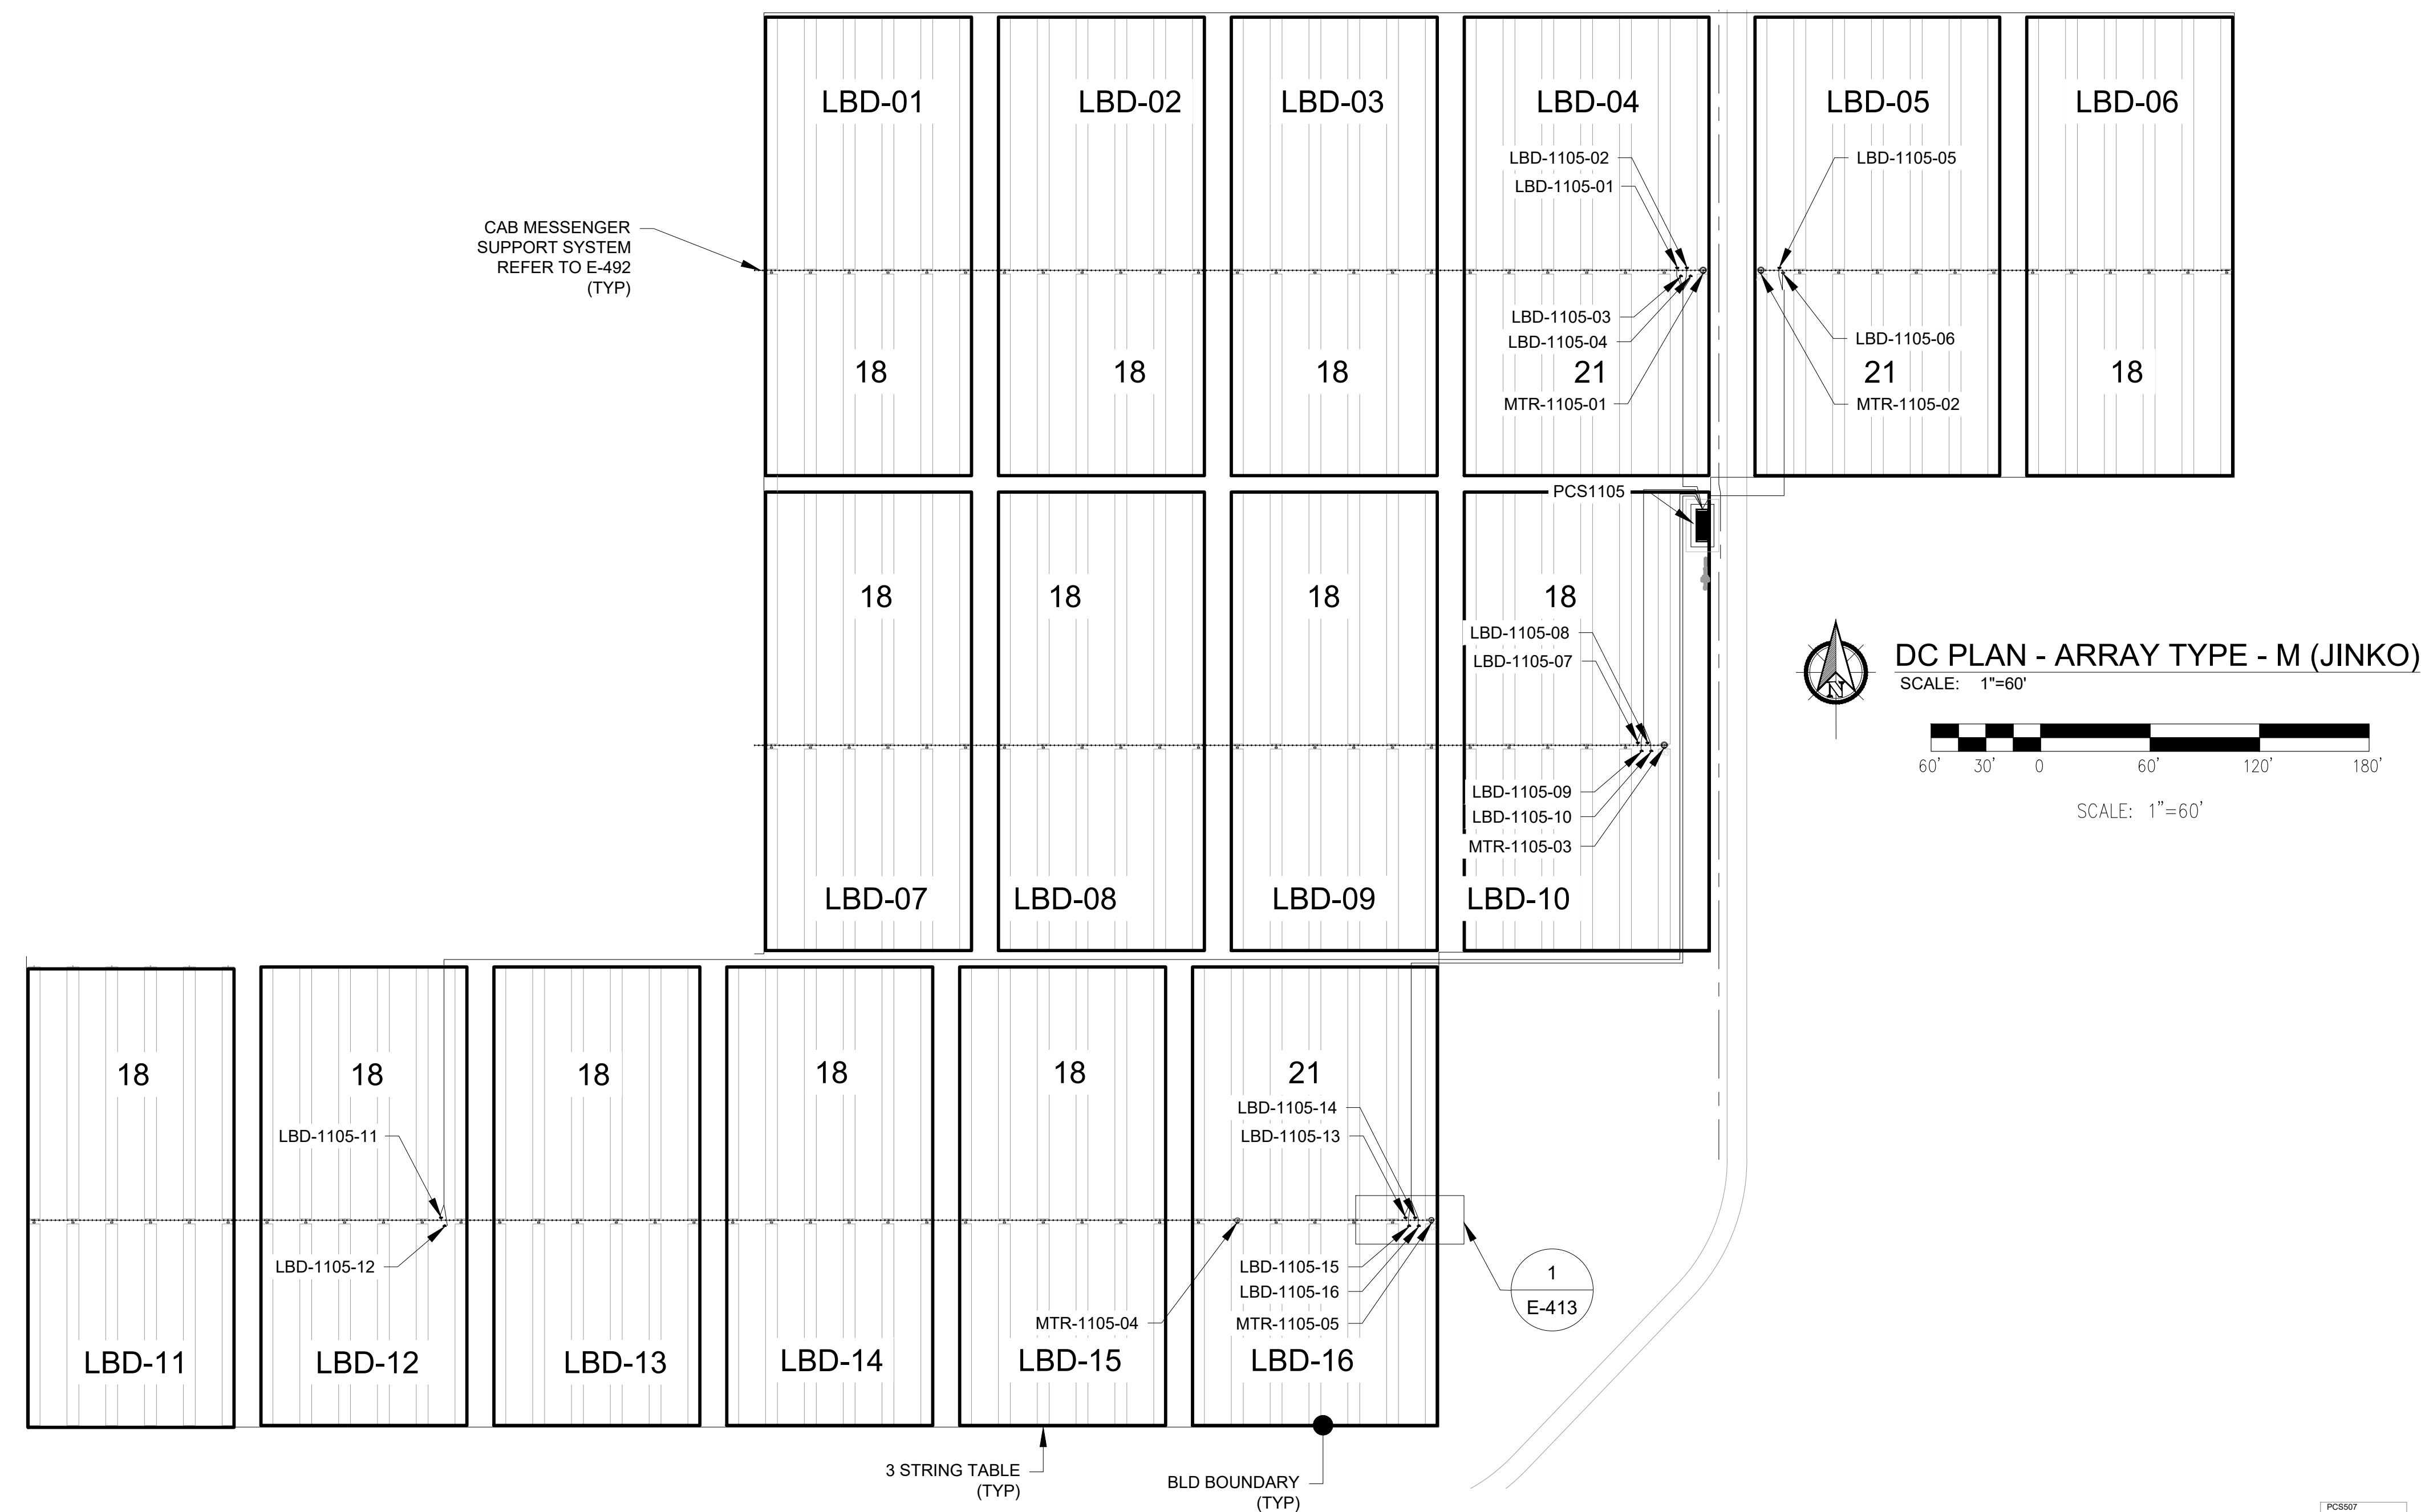

1 LBD LAYOUT DETAIL

NOTES:


1. DC FEEDER TAGS ARE SAME AS LBD TAGS EXCEPT SUBSTITUTING 'DF' IN PLACE OF 'LBD'.
2. REFER TO SHEET E-005 - BLOCK SCHEDULE AND SHEET E-011 - MODULE ALLOCATION PLAN FOR SPECIFIC INFORMATION REGARDING MODULE QUANTITIES ASSOCIATED WITH PCS-SPECIFIC ARRAY TYPES.


LEGEND:

_____ DF _____	DC FEEDER
----------------	-----------

HANGER SYSTEM

ARRAY TYPE	ASSOCIATED PCS
A	PCS104 PCS105 PCS106 PCS107 PCS201 PCS207 PCS301 PCS302 PCS303 PCS304 PCS401 PCS402 PCS403 PCS404 PCS405 PCS406 PCS502 PCS503 PCS504 PCS505 PCS506
	PCS204 PCS507
	PCS1201
B	PCS202 PCS206
C	PCS205
F	PCS103 PCS907 PCS1007 PCS1101 PCS1102 PCS1103 PCS1104 PCS1106 PCS1107 PCS1108 PCS1201 PCS1202 PCS1204 PCS1205 PCS1206 PCS1207 PCS1301 PCS1302 PCS1303 PCS1304 PCS1306 PCS1307 PCS1402 PCS1404 PCS1405 PCS1406
	PCS101 PCS906 PCS1203
	PCS1208
	PCS1305
	PCS102 PCS1401
K	PCS1408
L	PCS1407
M	PCS1105
N	PCS604
O	PCS606
P	PCS607
Q	PCS1308
R	PCS305 PCS306 PCS307 PCS407 PCS705 PCS706 PCS707 PCS803 PCS804 PCS805 PCS806 PCS807 PCS902 PCS903 PCS904 PCS905 PCS1001 PCS1002 PCS1003 PCS1004 PCS1005
	PCS1006
	PCS802 PCS901
U	PCS203
V	PCS704
W	PCS701 PCS702 PCS703 PCS801
X	PCS601 PCS602 PCS603 PCS605
Y	PCS1403
Z	PCS1008

 FastGrid		FastGrid, LLC 225 E Germann Road Suite 301 Gilbert, AZ 85297	
REV	DESCRIPTION	DATE	
4	RECORD DRAWINGS	06/08/2023	
PROJECT NAME:			
EAGLE SHADOW MOUNTAIN PV SOLAR POWER GENERATION FACILITY			
PROJECT ADDRESS:			
I-15 CRYSTAL, NV CLARK COUNTY			
SEAL:		DATE:	10/16/2020
		PROJECT #:	190067.03
		DRAWN BY:	NK
		CHECKED BY:	EL
SHEET NAME:			
DC PLAN - ARRAY TYPE M (JINKO)			
SHEET #:		REV #:	4
E-413			



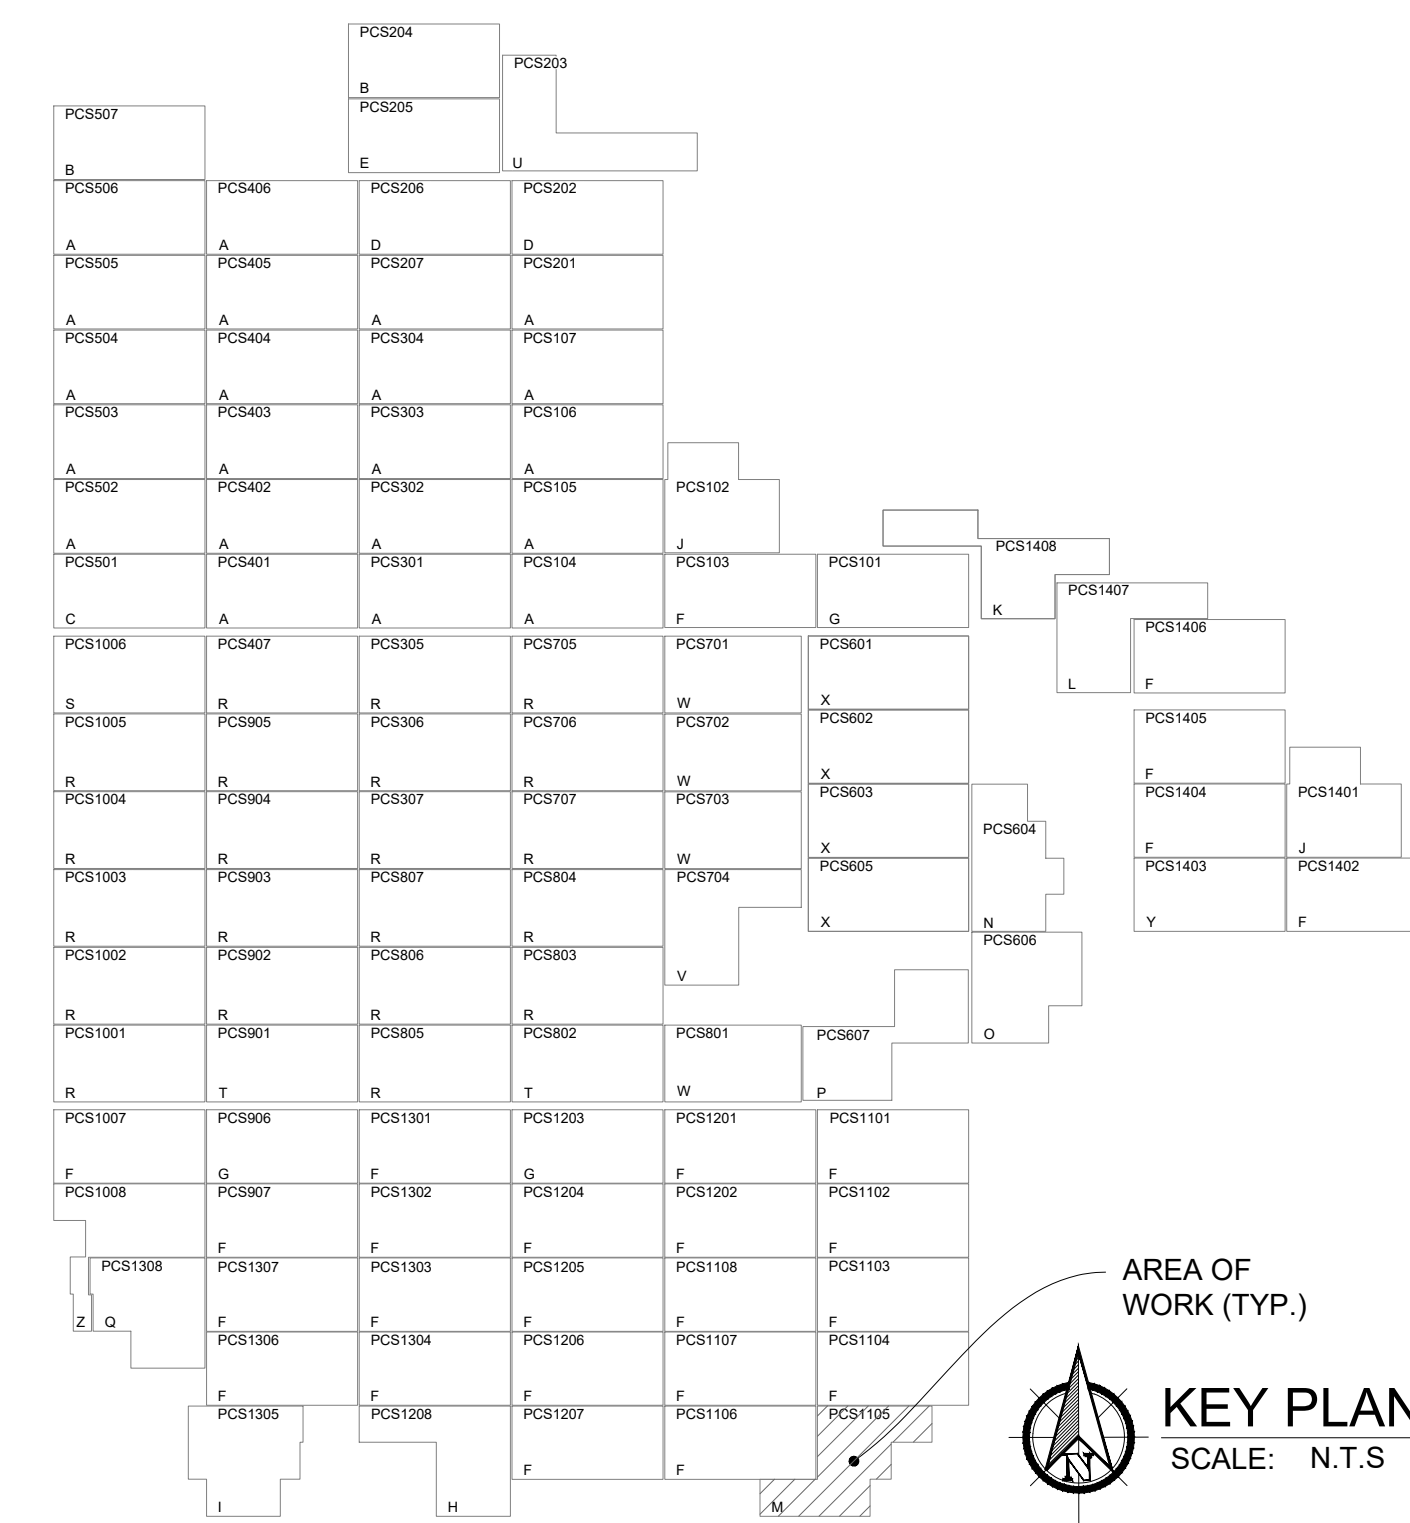


AREA OF
WORK (TYP.)

KEY PLAN

SCALE: N.T.S.

RECORD DRAWING

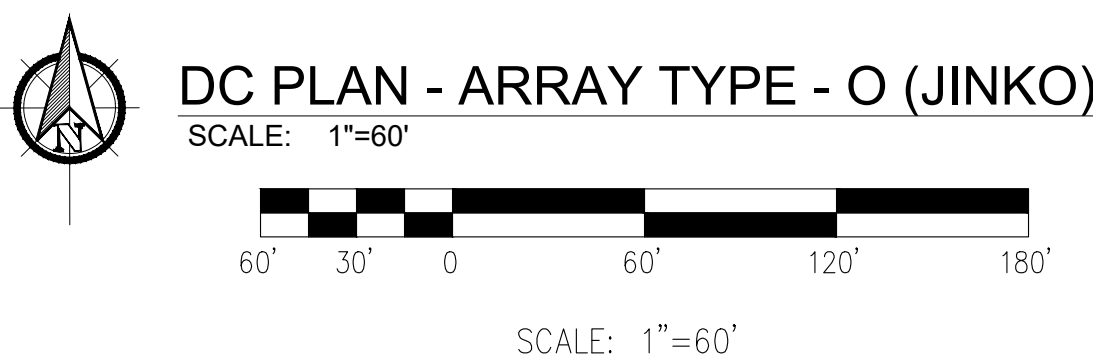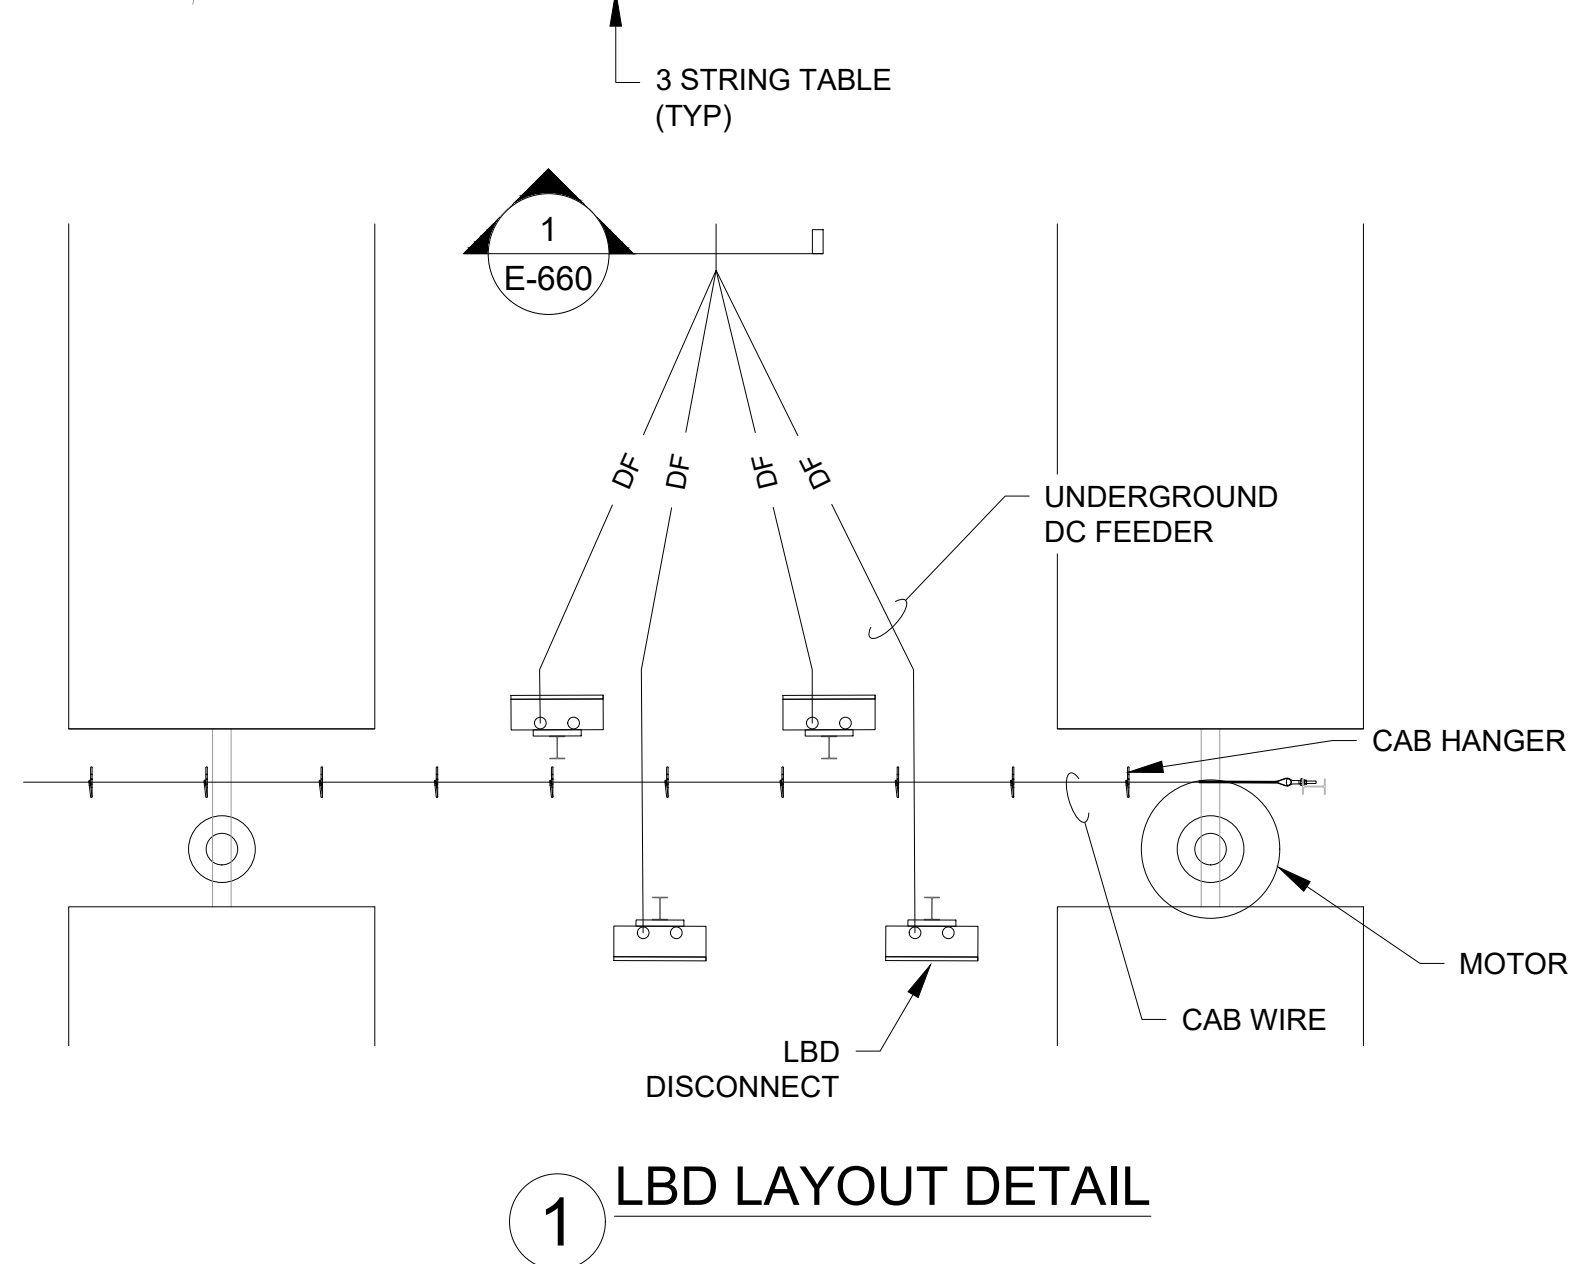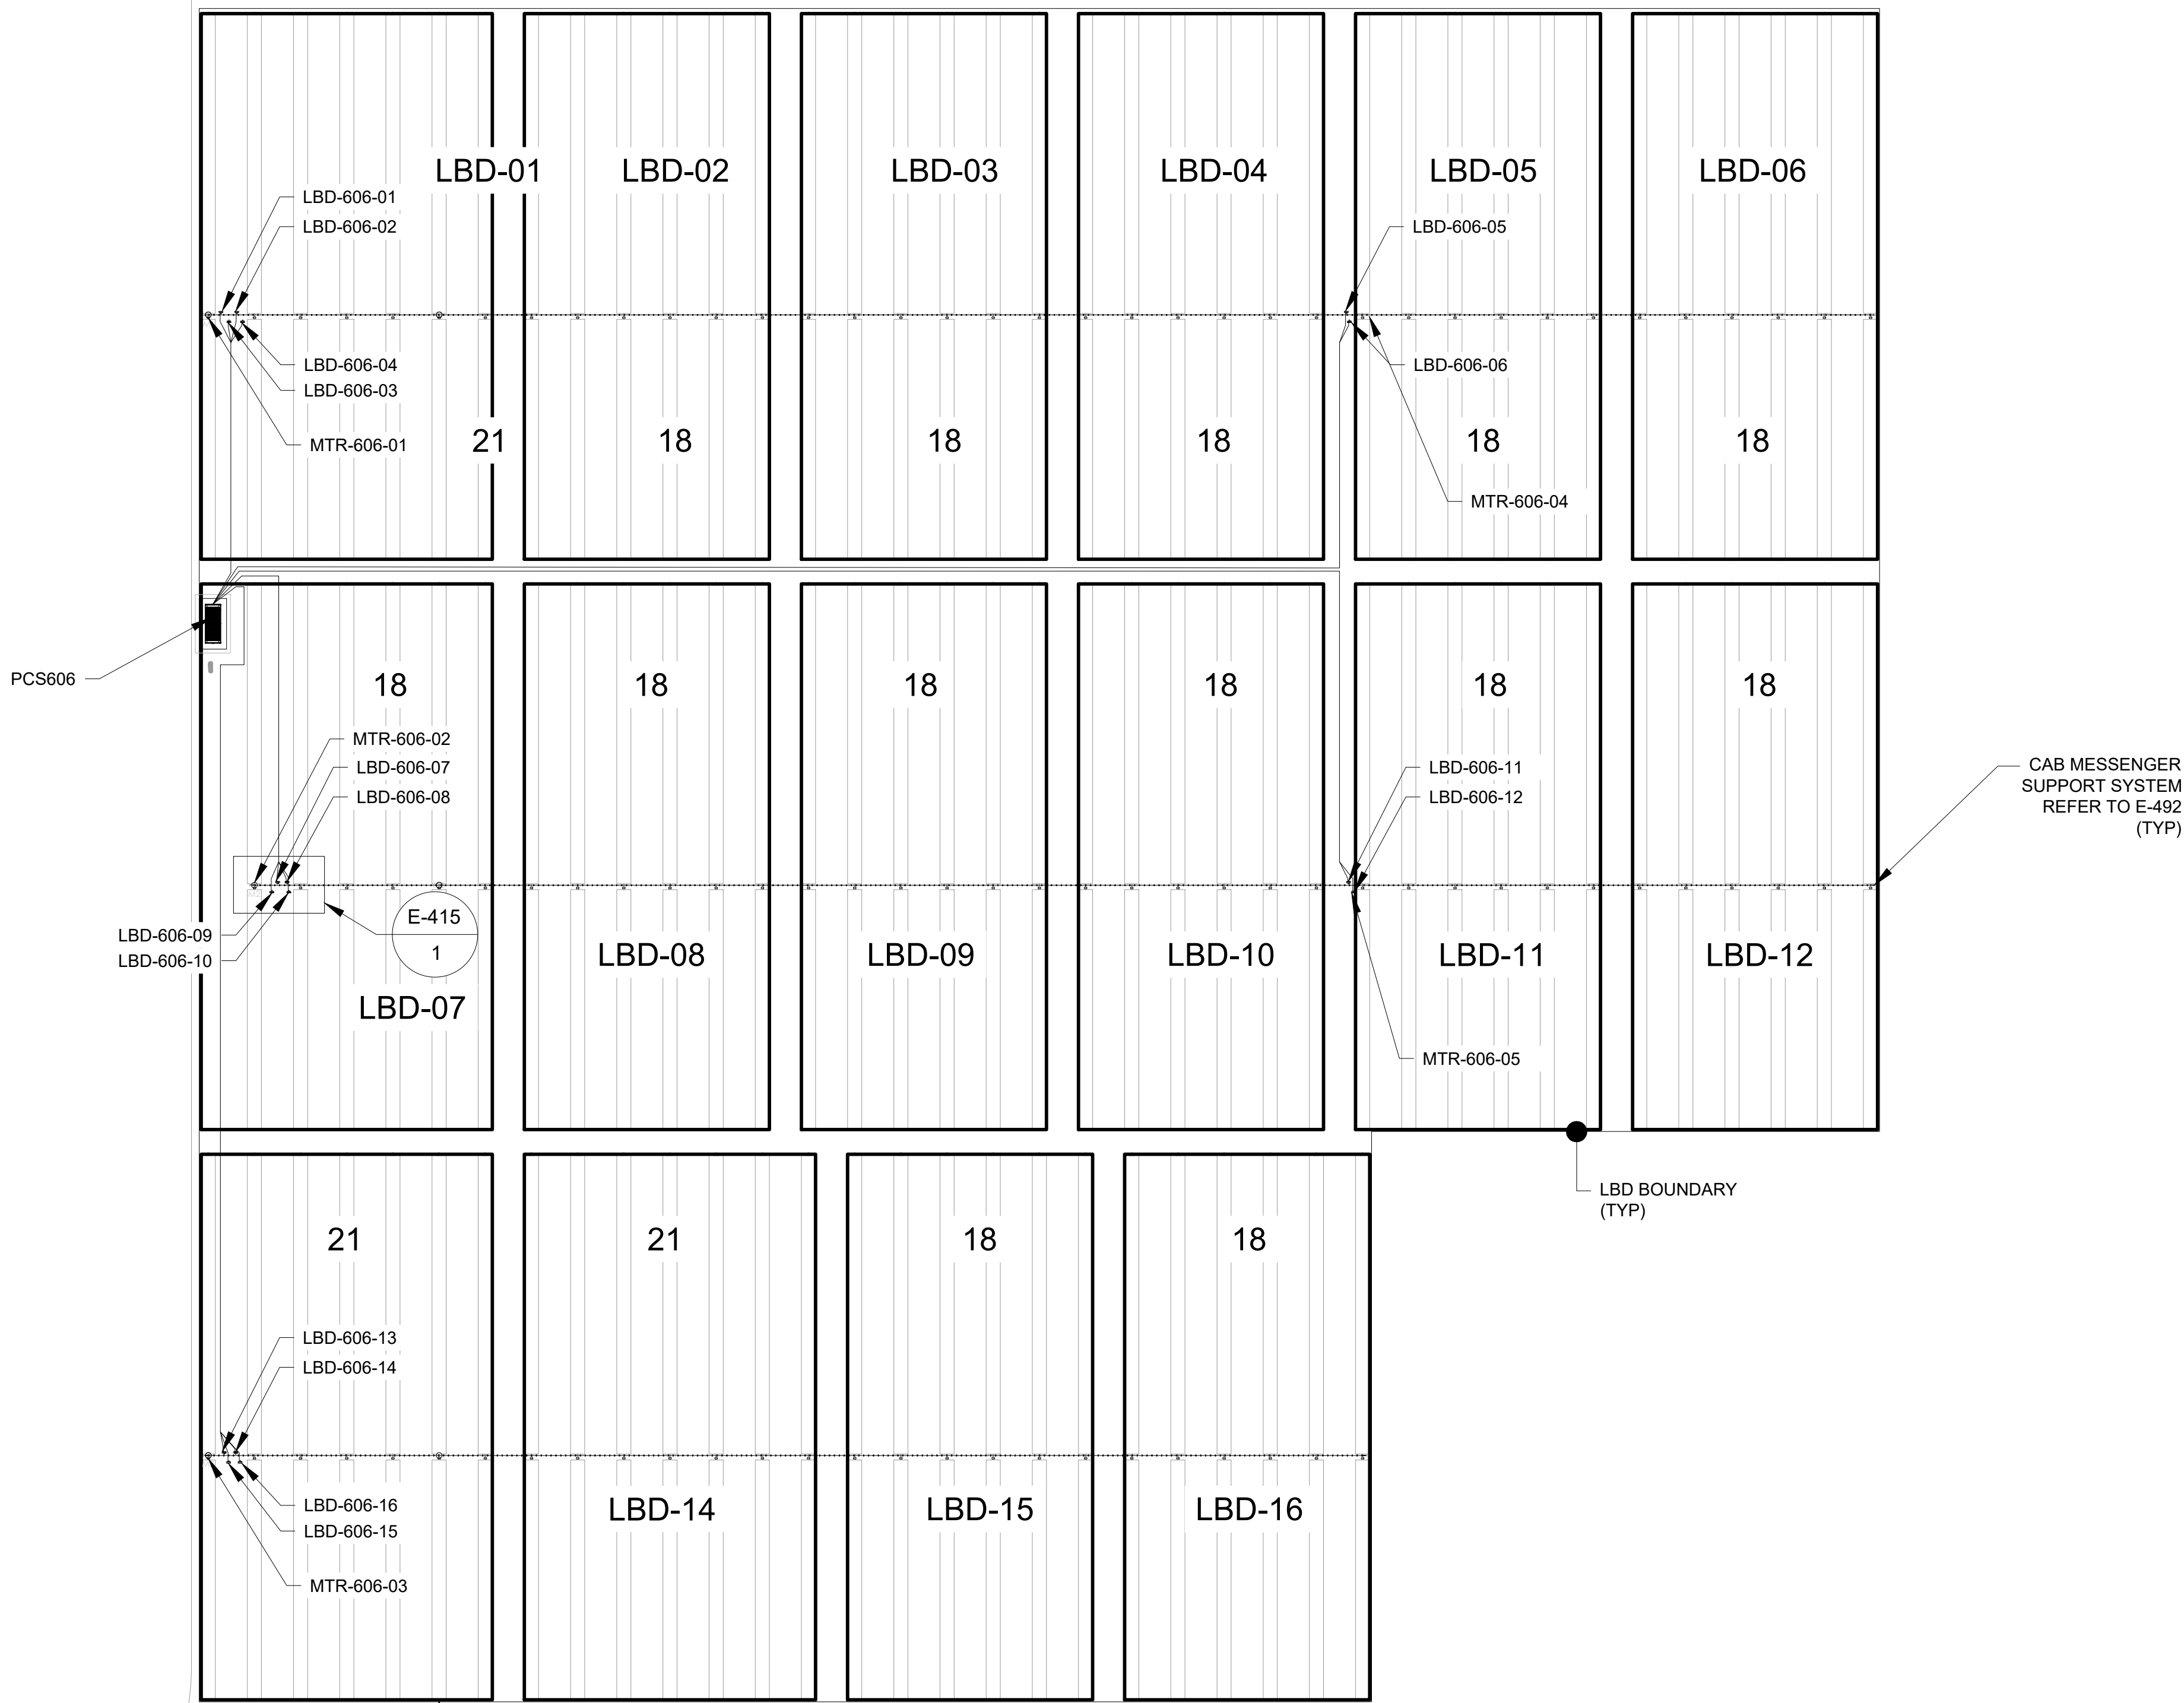

- NOTES:
- DC FEEDER TAGS ARE SAME AS LBD TAGS EXCEPT SUBSTITUTING 'DF' IN PLACE OF 'LBD'.
 - REFER TO SHEET E-005 - BLOCK SCHEDULE AND SHEET E-011 - MODULE ALLOCATION PLAN FOR SPECIFIC INFORMATION REGARDING MODULE QUANTITIES ASSOCIATED WITH PCS SPECIFIC ARRAY TYPES.

LEGEND:

— DF —	DC FEEDER
— H —	HANGER SYSTEM

ARRAY TYPE	ASSOCIATED PCS
A	PCS104 PCS105 PCS106 PCS107 PCS201 PCS207 PCS302 PCS303 PCS304 PCS401 PCS402 PCS403 PCS404 PCS405 PCS406 PCS502 PCS503 PCS504 PCS505 PCS506
B	PCS204 PCS507
C	PCS501
D	PCS202 PCS206
E	PCS205
F	PCS103 PCS907 PCS1007 PCS1101 PCS1102 PCS1103 PCS1104 PCS1106 PCS1107 PCS1108 PCS1201 PCS1202 PCS1204 PCS1205 PCS1206 PCS1207 PCS1301 PCS1302 PCS1303 PCS1304 PCS1306 PCS1307 PCS1402 PCS1403 PCS1405 PCS1406
G	PCS101 PCS906 PCS1203
H	PCS1208
I	PCS1305
J	PCS102 PCS1401
K	PCS1408
L	PCS1407
M	PCS1105
N	PCS604
O	PCS606
P	PCS607
Q	PCS1308
R	PCS305 PCS306 PCS307 PCS407 PCS705 PCS706 PCS707 PCS803 PCS804 PCS805 PCS806 PCS807 PCS902 PCS903 PCS904 PCS905 PCS1001 PCS1002 PCS1003 PCS1004 PCS1005
S	PCS1006
T	PCS802 PCS901
U	PCS203
V	PCS704
W	PCS701 PCS702 PCS703 PCS801
X	PCS601 PCS602 PCS603 PCS605
Y	PCS1403
Z	PCS1008

FastGrid

FastGrid, LLC

225 E Germann Road

Suite 301

Gilbert, AZ 85297

REV	DESCRIPTION	DATE
4	RECORD DRAWINGS	

PROJECT NAME:

EAGLE SHADOW MOUNTAIN PV SOLAR POWER GENERATION FACILITY

PROJECT ADDRESS:

I-15
CRYSTAL, NV
CLARK COUNTY

DATE:

10/16/2023

PROJECT #:

190607.03

DRAWN BY:

TLR

CHECKED BY:

EL


SHEET NAME:

DC PLAN - ARRAY TYPE - O (JINKO)


SHEET #:

415


PLOT DATE: 10/16/2023
MINUS ENGINEERING\DWG\E-415 DC PLAN - ARRAY TYPE - O (JINKO).TIF
EAGLE SHADOW MOUNTAIN PV SOLAR POWER GENERATION FACILITY
PROJECTS\190607.03\190607.03\DC PLAN - ARRAY TYPE - O (JINKO).TIF

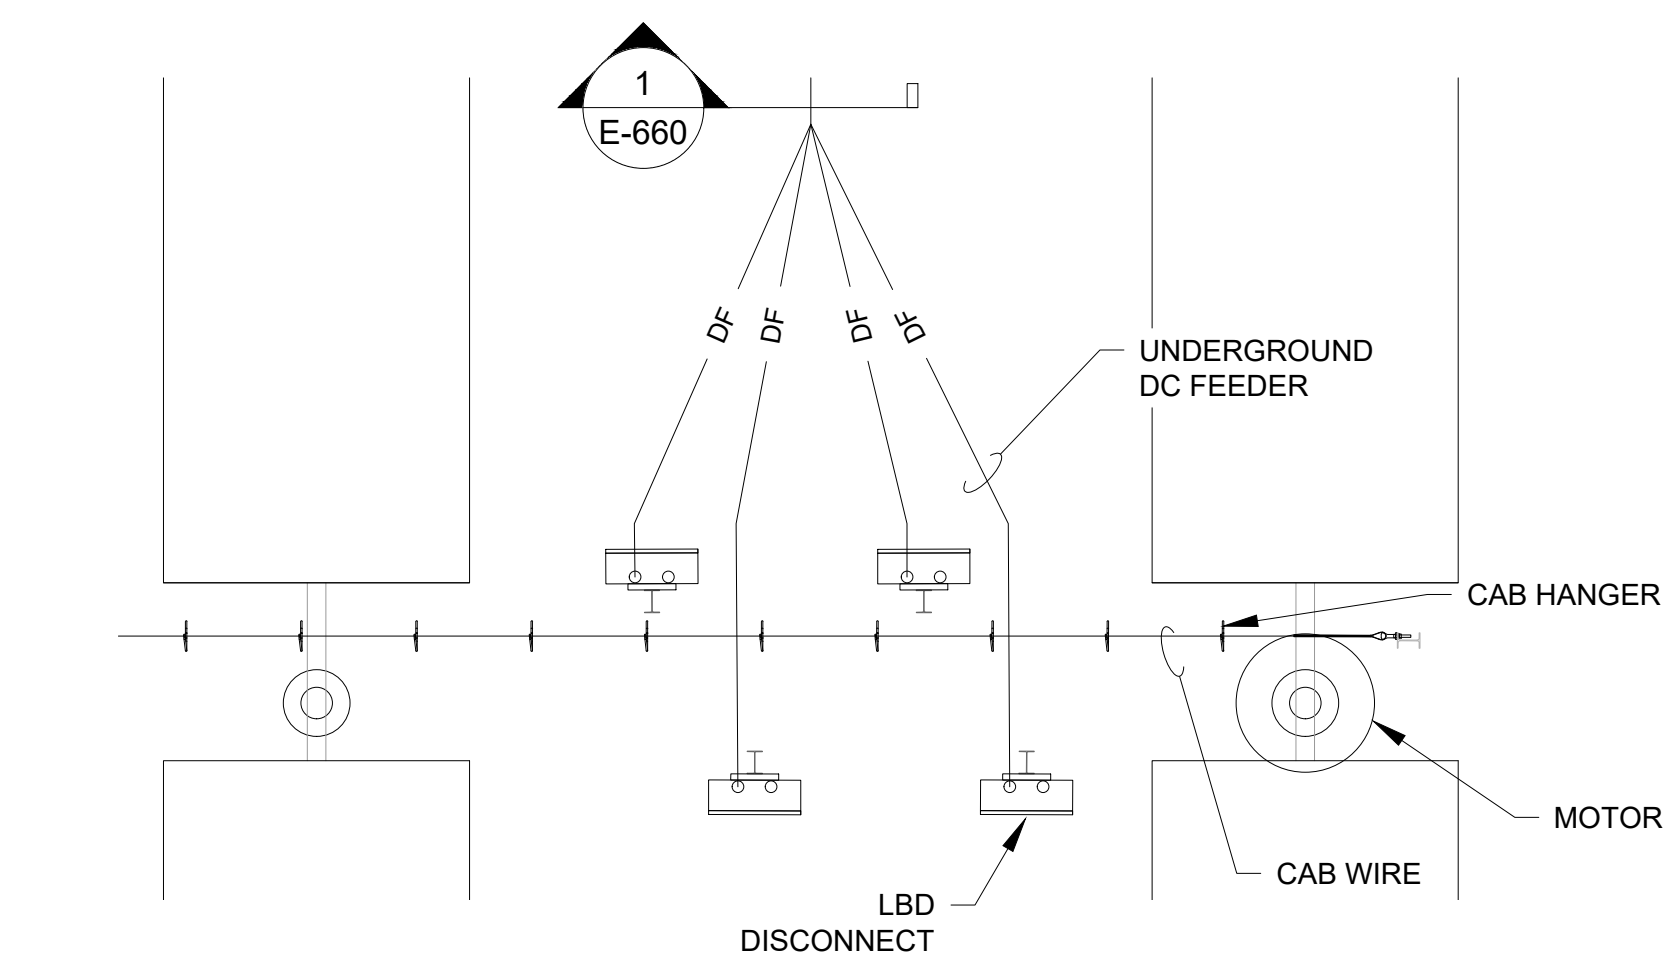


1 LBD LAYOUT DETAIL

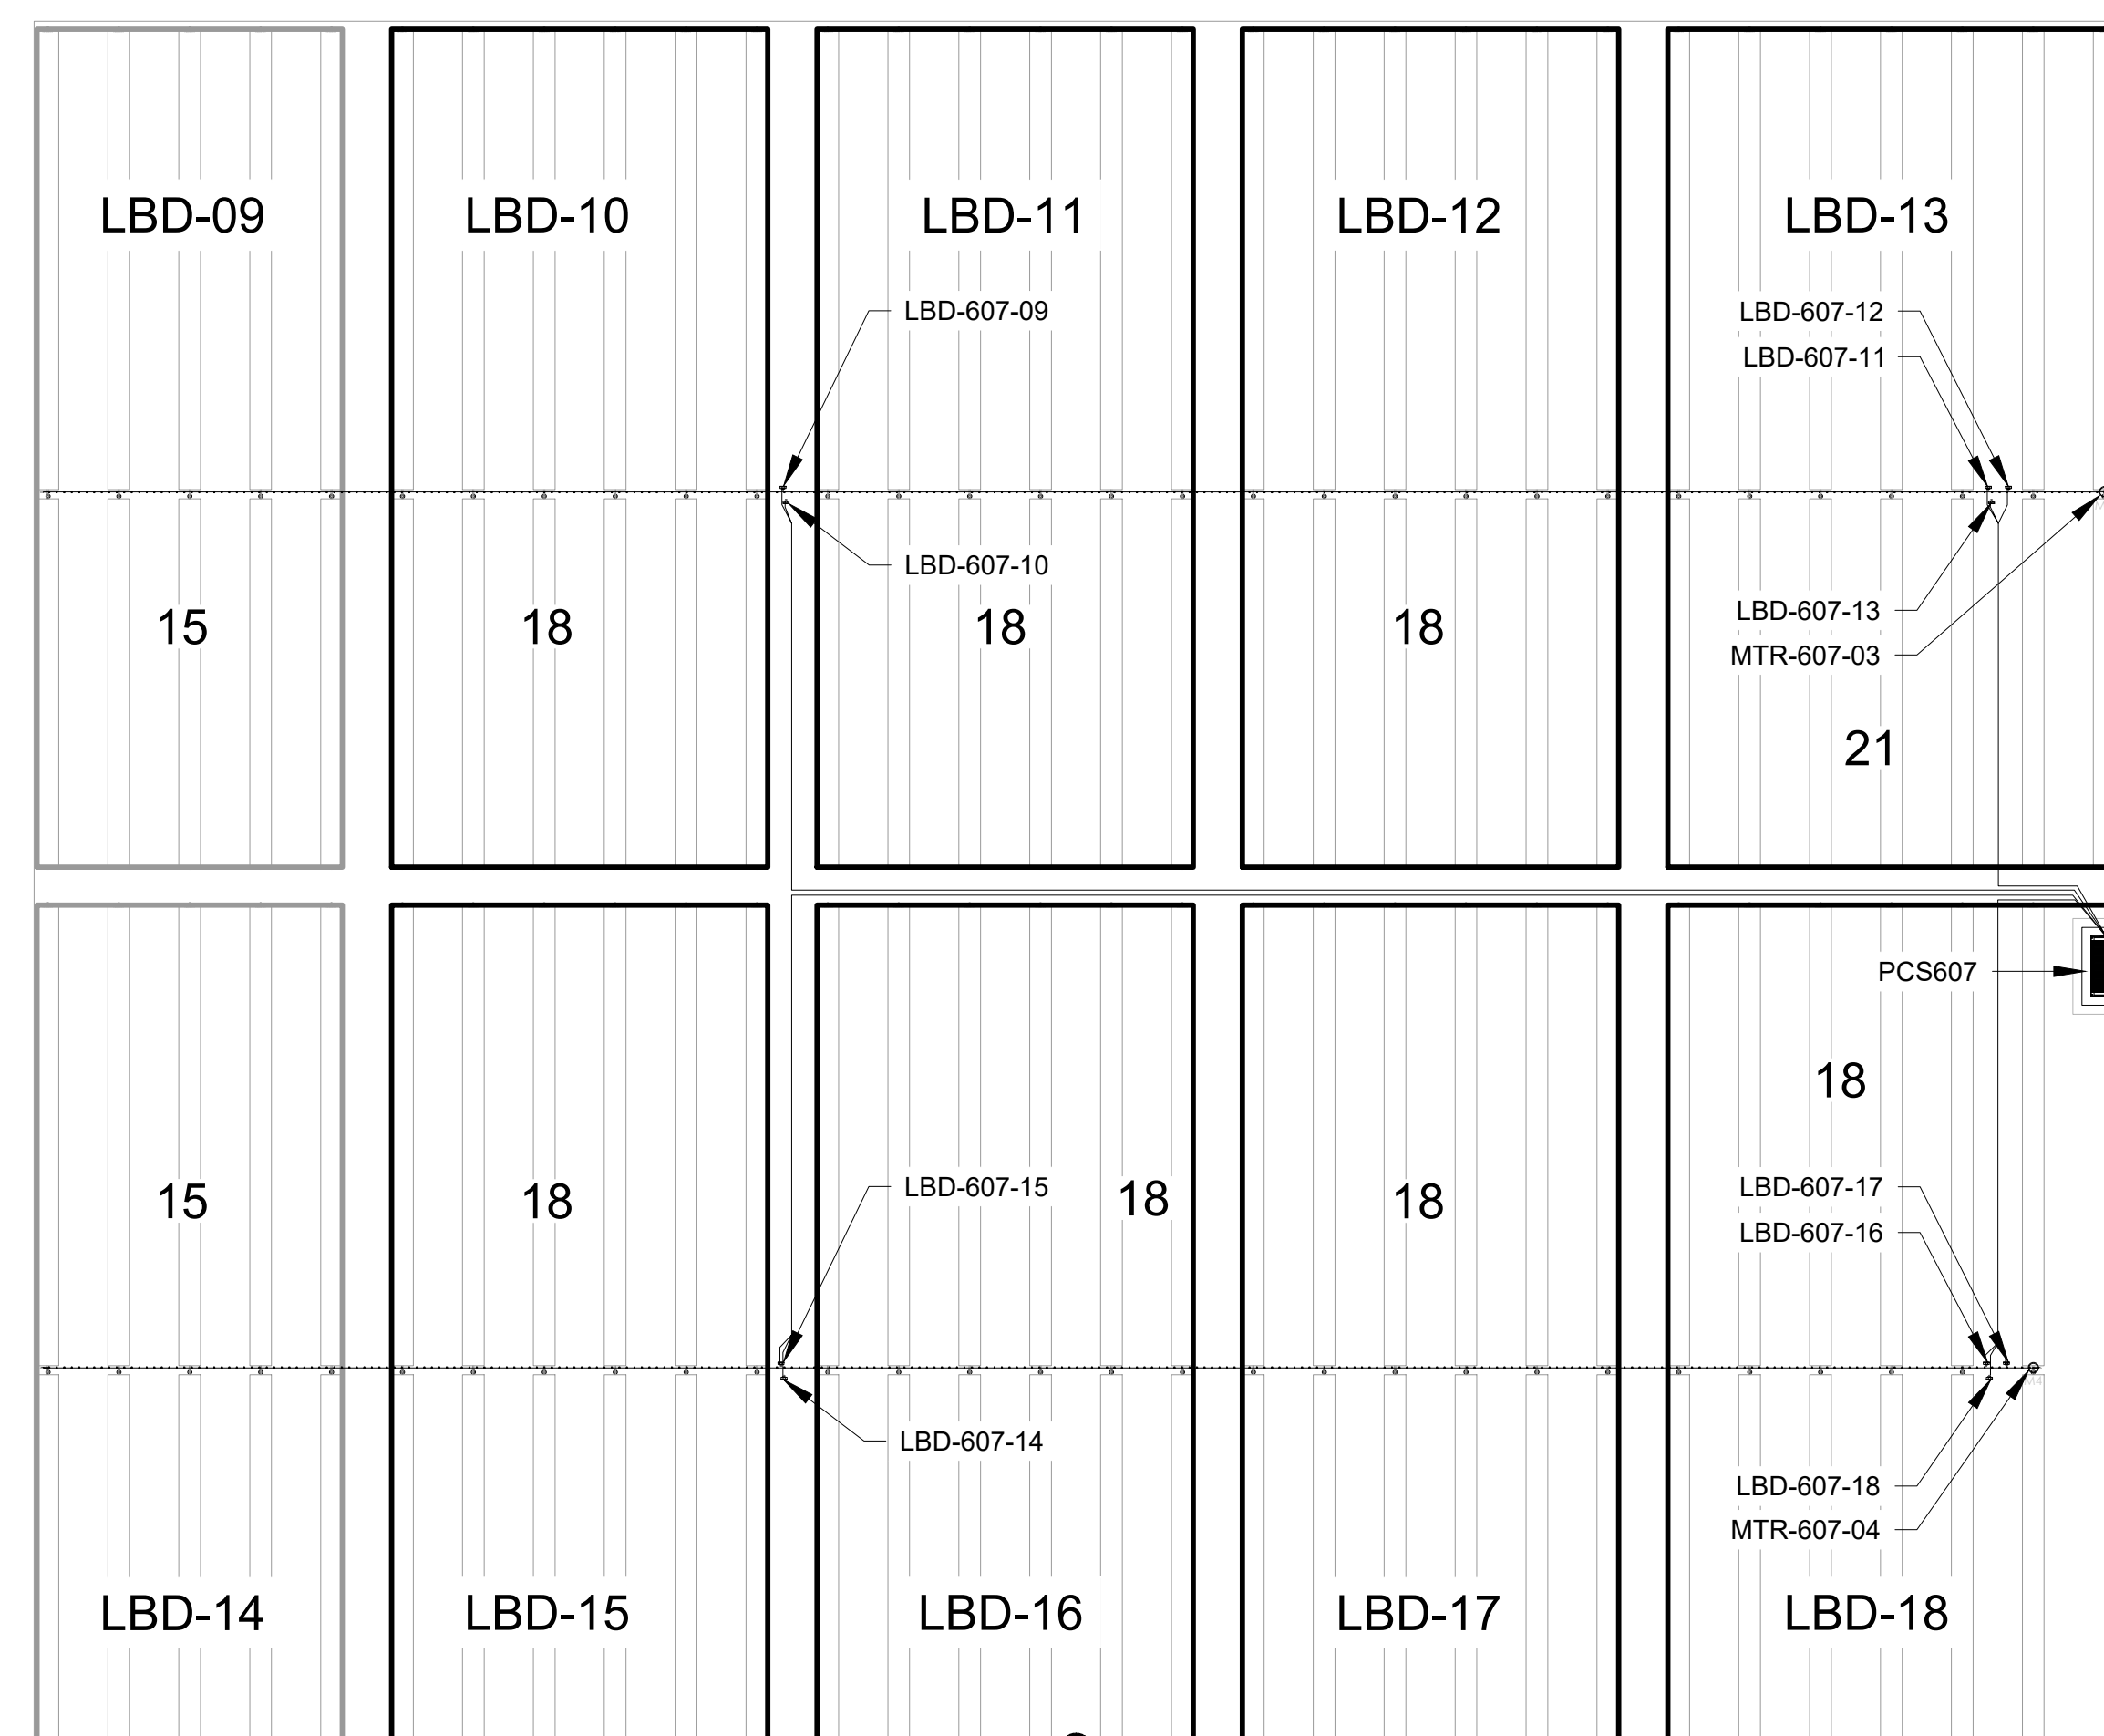3 STRING TABLE
(TYP)


LBD BOUNDARY
(TYP)

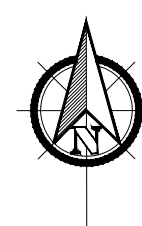


DC PLAN - ARRAY TYPE - P (JINKO)
SCALE: 1"=60'

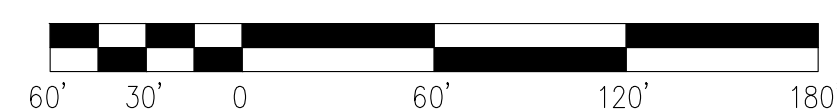

SCALE: 1"=60'

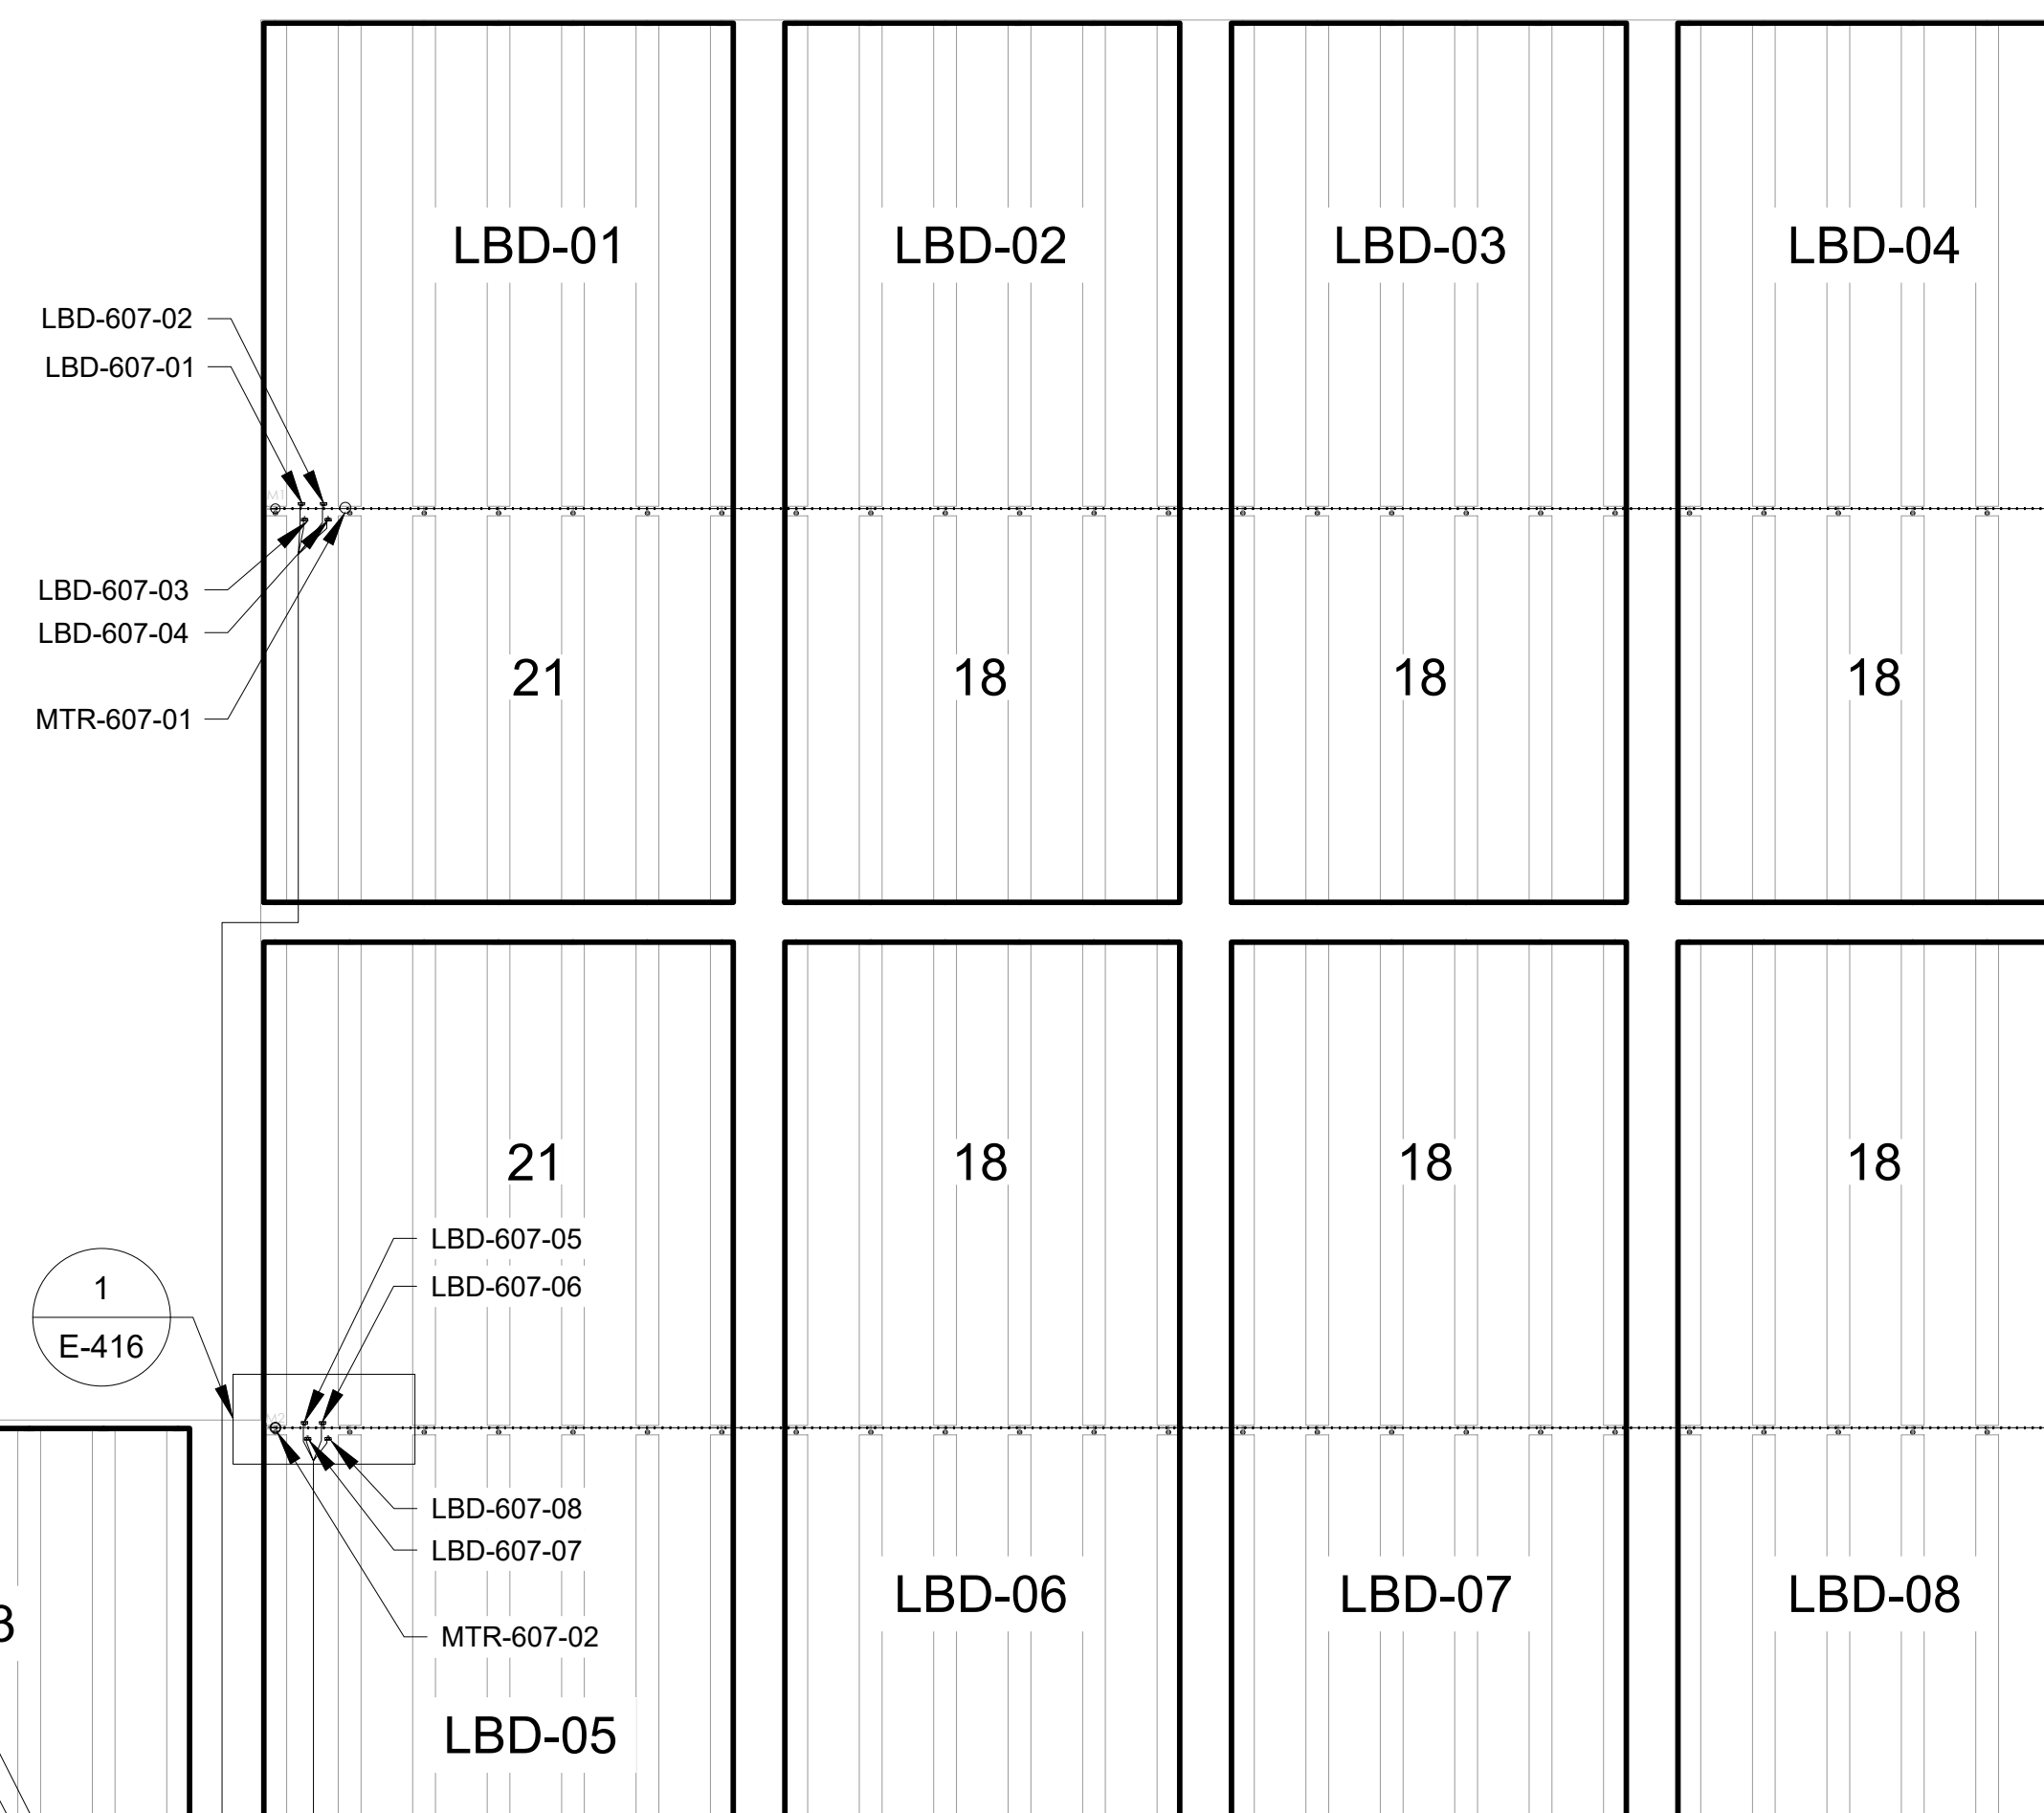

CAB MESSENGER
SUPPORT SYSTEM
REFER TO E-492
(TYP)

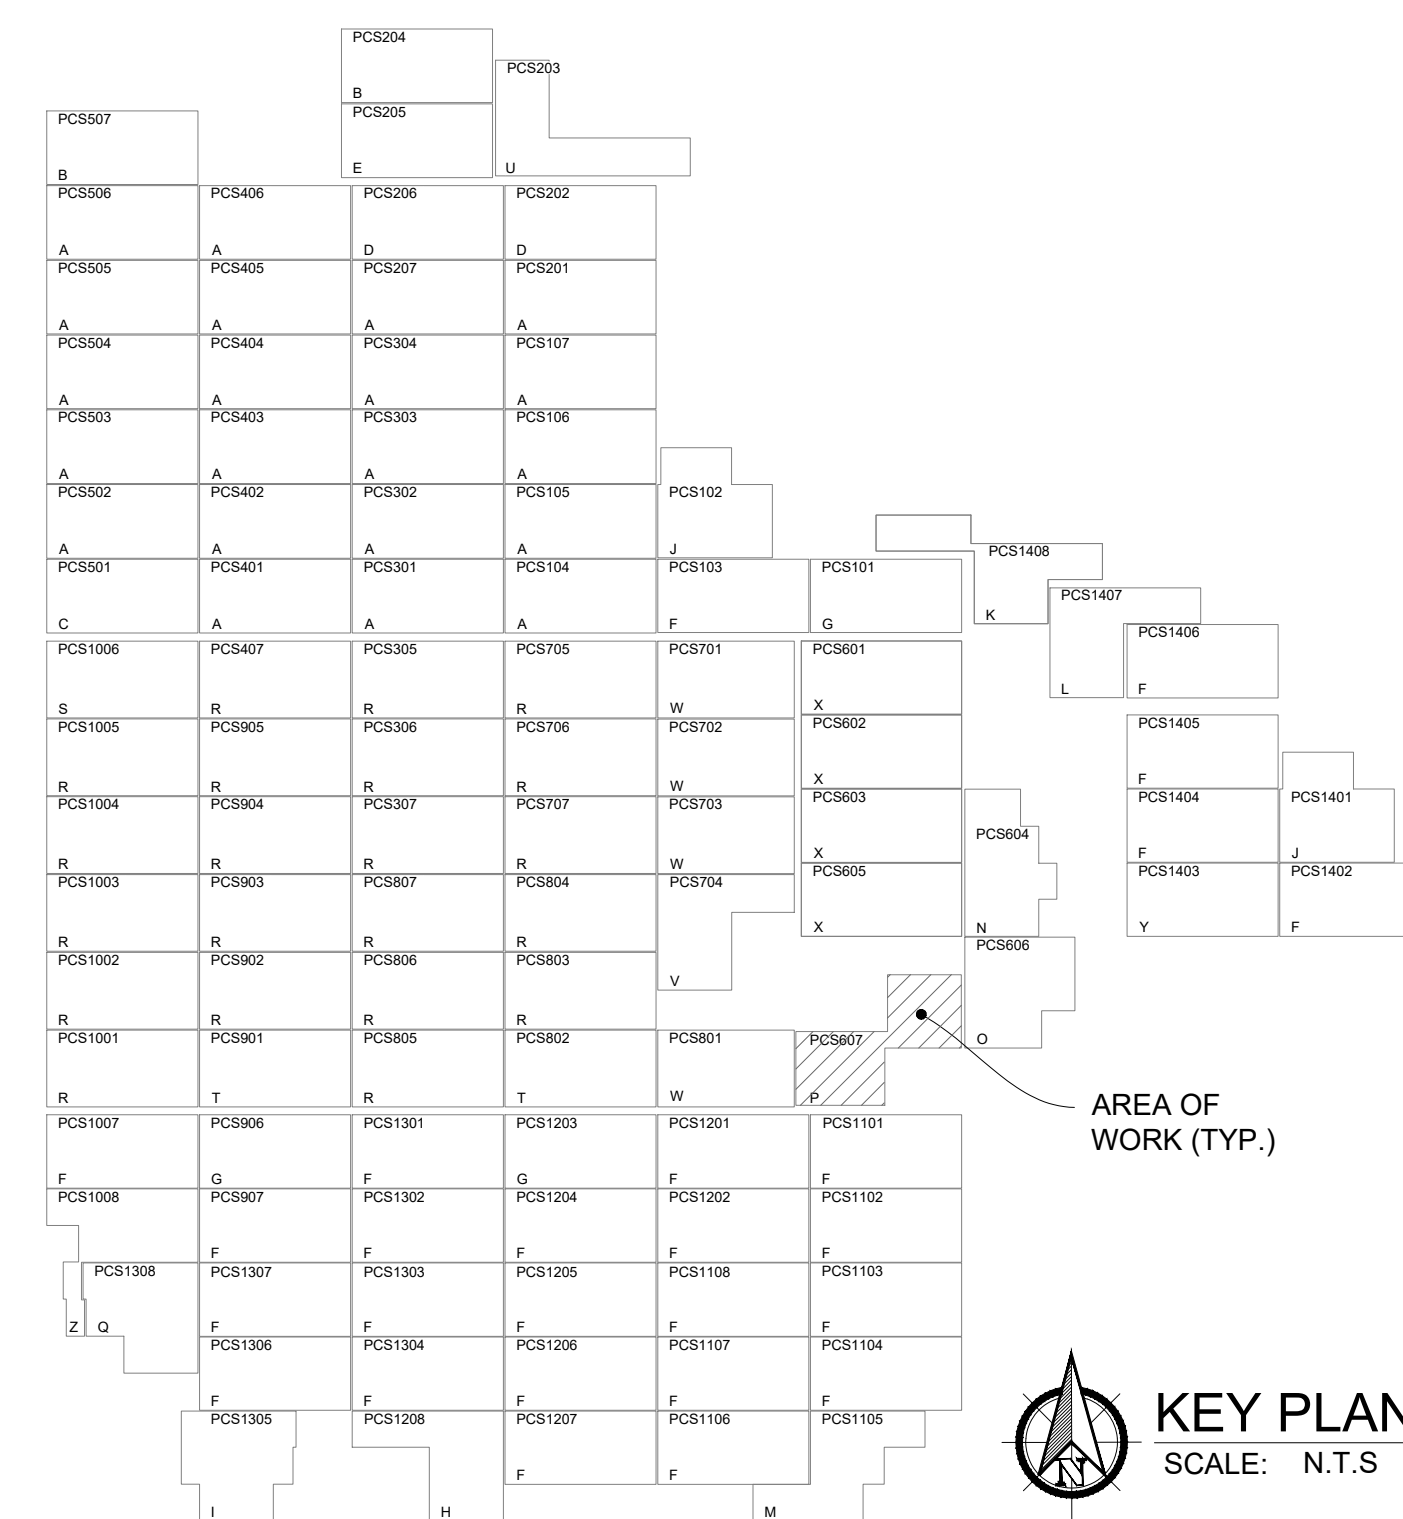

KEY PLAN
SCALE: N.T.S

NOTES:

1. DC FEEDER TAGS ARE SAME AS LBD TAGS EXCEPT SUBSTITUTING 'D' IN PLACE OF 'LBD'.
2. REFER TO SHEET E-005 - BLOCK SCHEDULE AND SHEET E-011 - MODULE ALLOCATION PLAN FOR SPECIFIC INFORMATION REGARDING MODULE QUANTITIES ASSOCIATED WITH PCS-SPECIFIC ARRAY TYPES.

LEGEND:

_____ DF _____ DC FEEDER

HANGER SYSTEM

ARRAY TYPE	ASSOCIATED PCS
A	PCS1104 PCS105 PCS106 PCS107 PCS201 PCS207 PCS301 PCS302 PCS303 PCS304 PCS401 PCS402 PCS403 PCS404 PCS405 PCS406 PCS502 PCS503 PCS504 PCS505 PCS506
B	PCS204 PCS507
C	PCS501
D	PCS202 PCS206
E	PCS205
F	PCS1103 PCS307 PCS1007 PCS1101 PCS1102 PCS1103 PCS1104 PCS1106 PCS1107 PCS1108 PCS1201 PCS1202 PCS1204 PCS1205 PCS1206 PCS1207 PCS1301 PCS1302 PCS1303 PCS1304 PCS1306 PCS1307 PCS1307 PCS1402 PCS1404 PCS1405 PCS1406
G	PCS101 PCS906 PCS1203
H	PCS1208
I	PCS1305
J	PCS102 PCS1401
K	PCS1408
L	PCS1407
M	PCS1105
N	PCS604
O	PCS606
P	PCS607
Q	PCS1308
R	PCS305 PCS306 PCS307 PCS407 PCS705 PCS706 PCS707 PCS803 PCS804 PCS805 PCS806 PCS807 PCS902 PCS903 PCS904 PCS905 PCS1001 PCS1002 PCS1003 PCS1004 PCS1005
S	PCS1006
T	PCS802 PCS901
U	PCS203
V	PCS704
W	PCS701 PCS702 PCS703 PCS801
X	PCS601 PCS602 PCS603 PCS605
Y	PCS1403
Z	PCS1008



FastGrid, LLC
225 E Germann Road
Suite 301
Gilbert, AZ 85297

REV	DESCRIPTION	DATE
4	RECORD DRAWINGS	06/08/2023

PROJECT NAME:

EAGLE SHADOW MOUNTAIN
PV SOLAR POWER
GENERATION FACILITY

PROJECT ADDRESS:

I-15
CRYSTAL, NV
CLARK COUNTY

SEAL:

DATE:	10/16/2020
-------	------------

PROJECT #:
190067.03

DRAWN BY:
TLR

CHECKED BY

SHEET NAME:

DC PLAN - ARRAY TYPE P (JINKO)

SHEET #:

E-416





REV

4

PLOT DATE: Thursday, June 08, 2023

SAVED BY: grega.looney

LOCATION: K1-09 PROJECT/S/190067-03 - PRIMORIS - EAGLE SHADOW MOUNTAIN 05 ENGINEERING\DWG-E-416 DC PLAN - ARRAY TYPE P (JINKO)	3	Lead
--	---	------

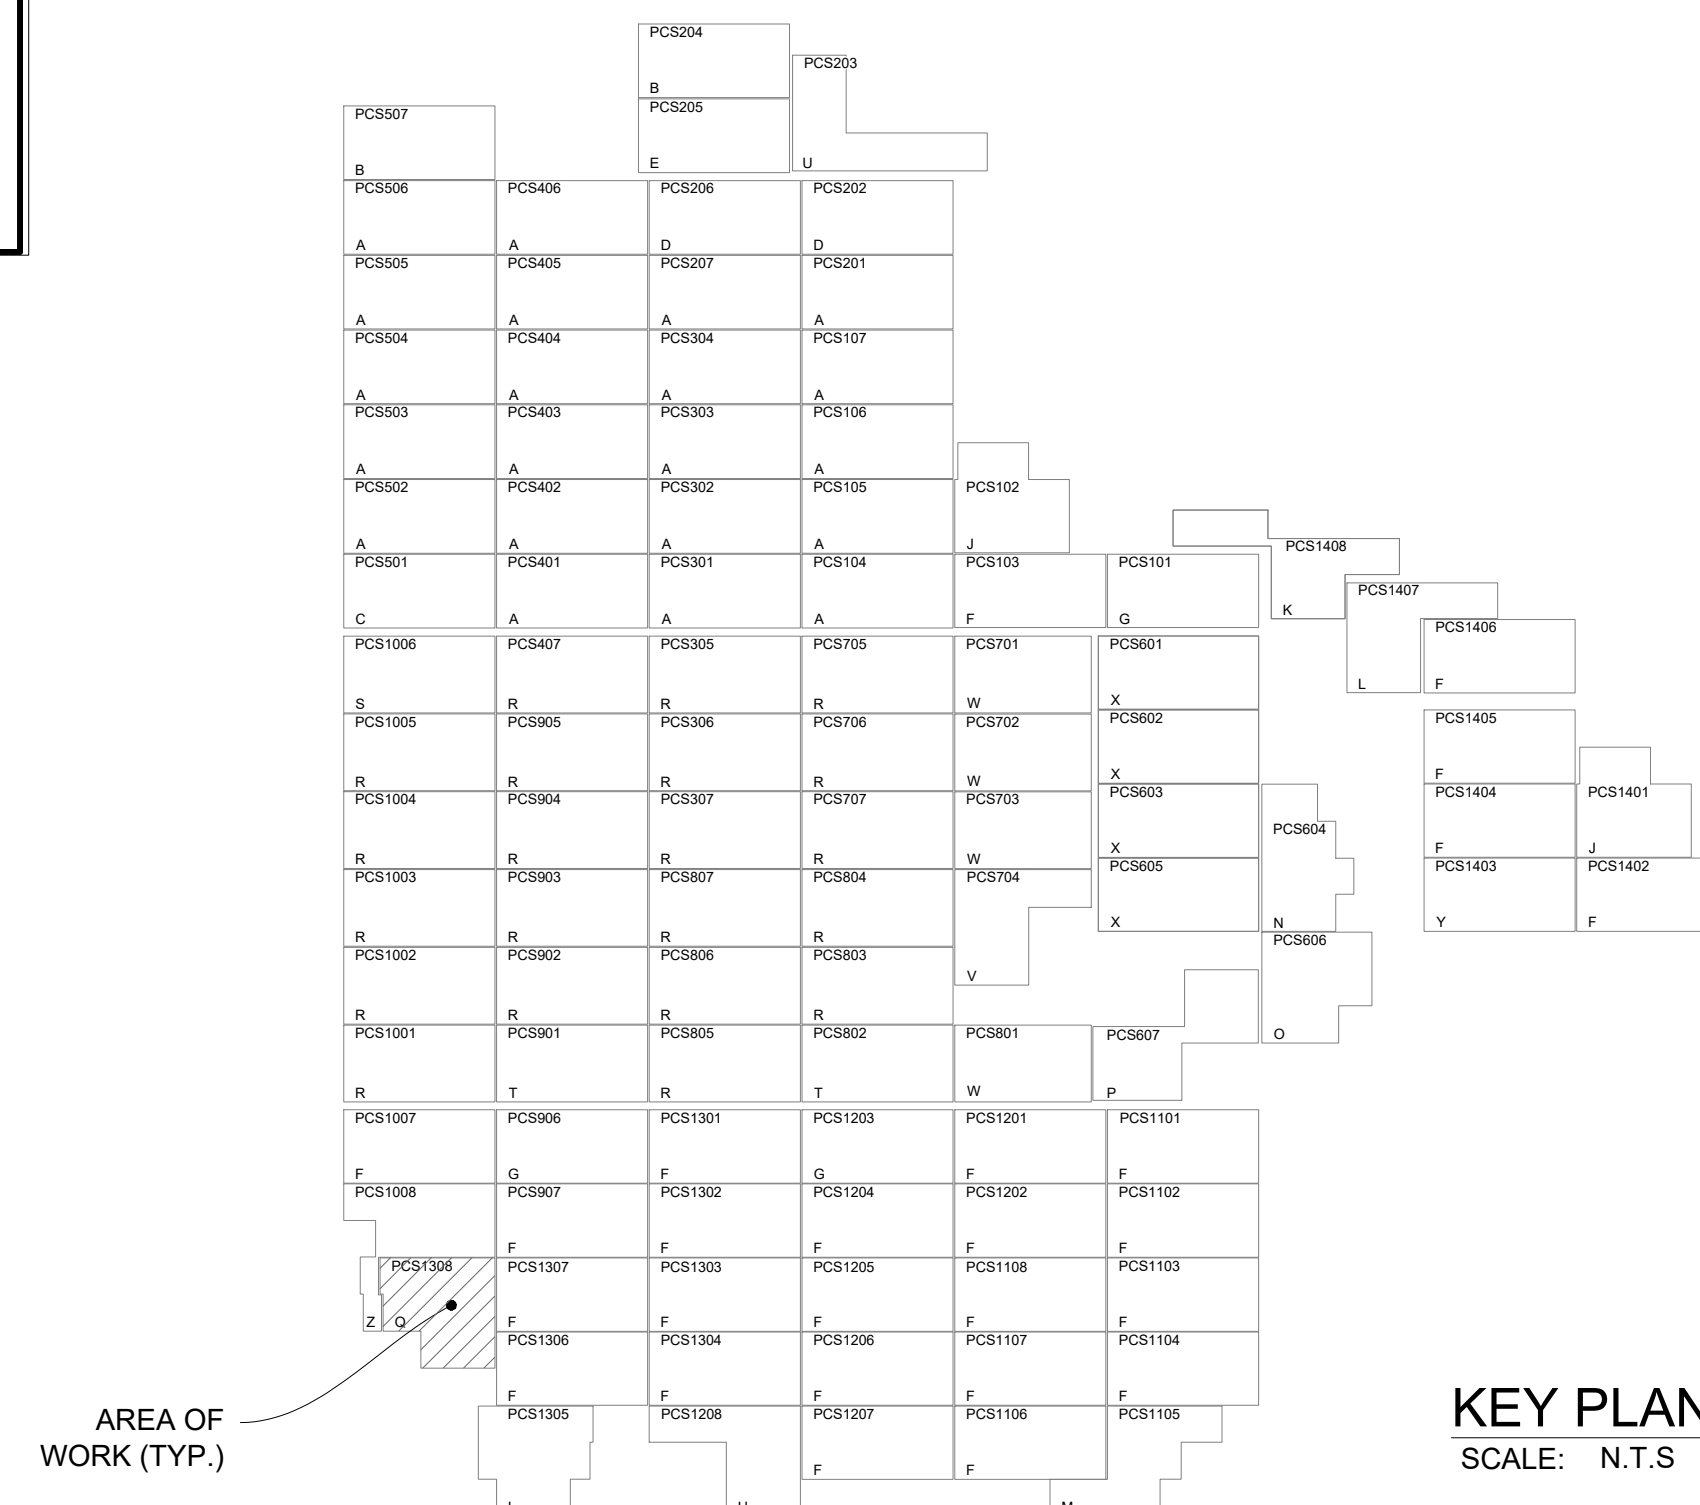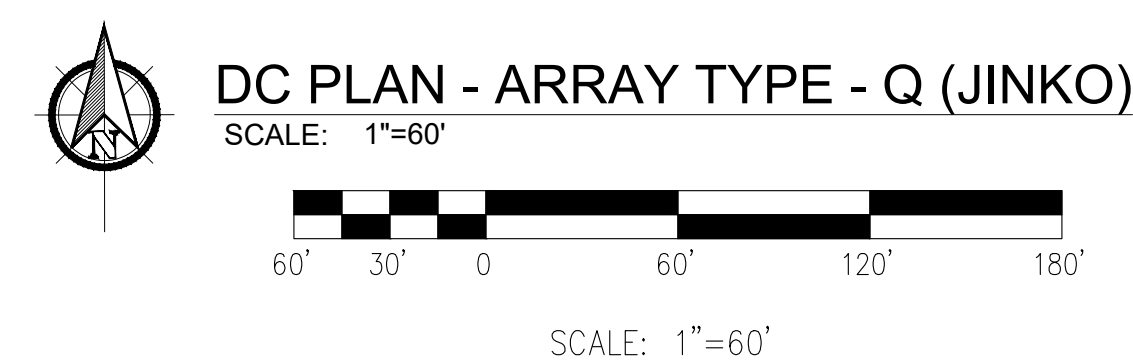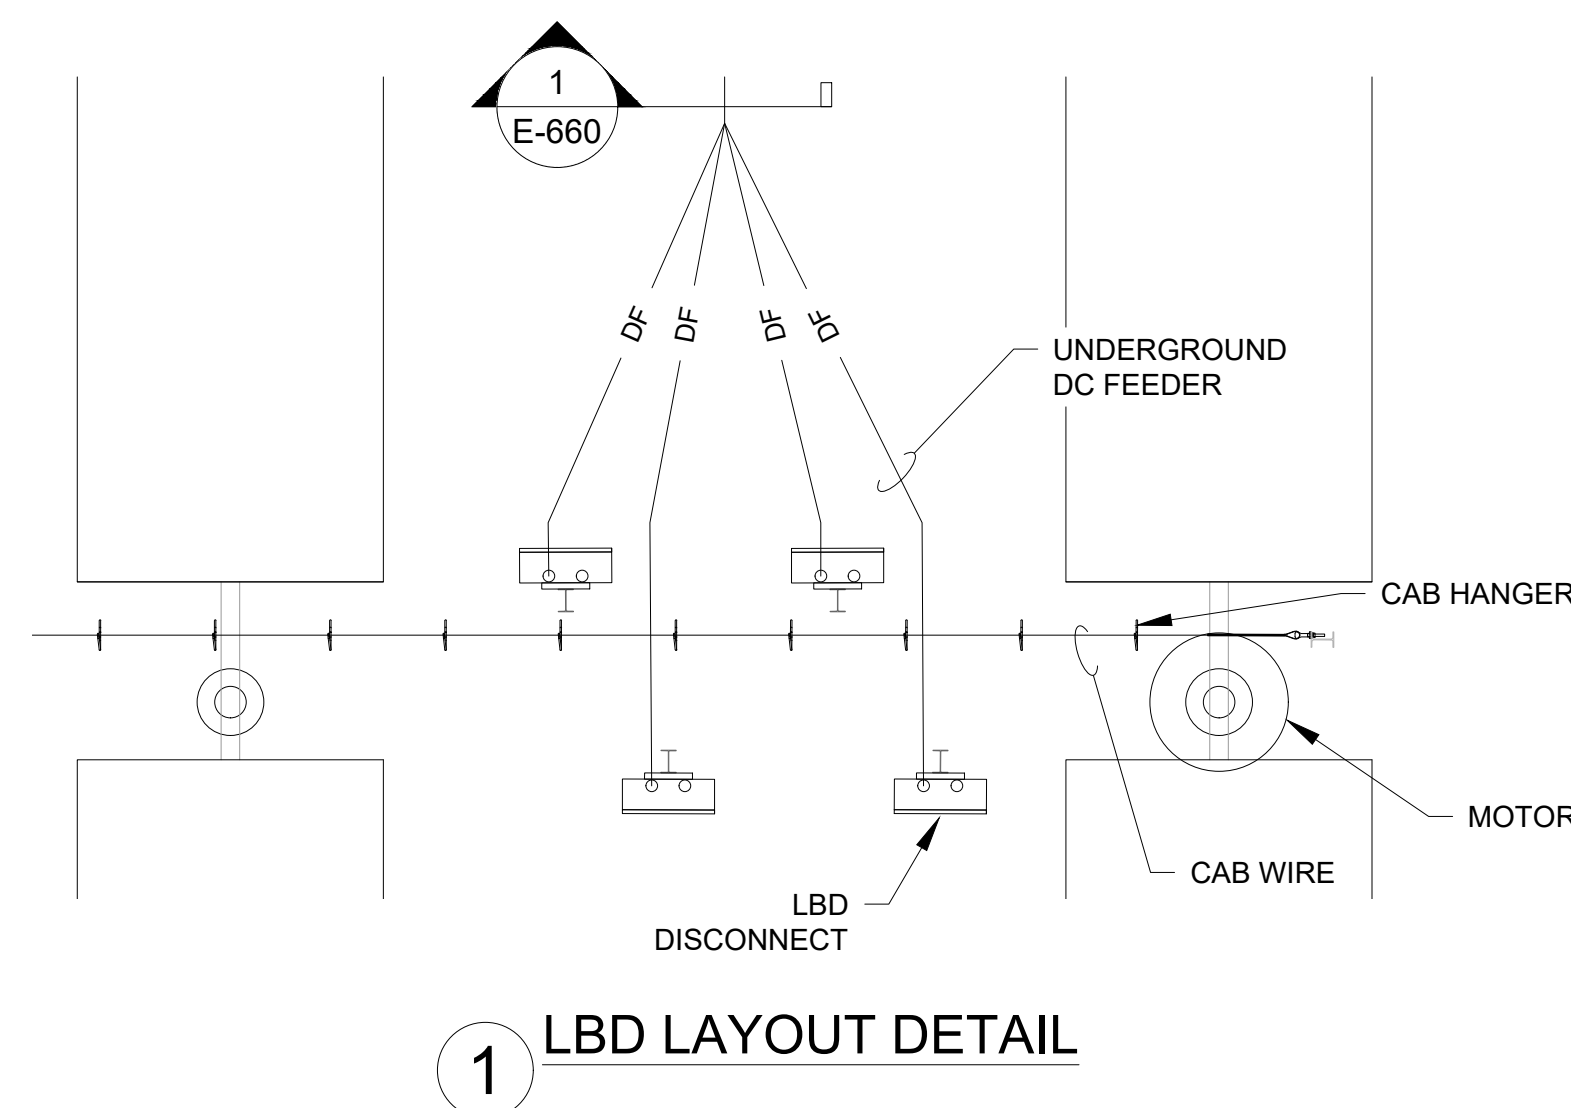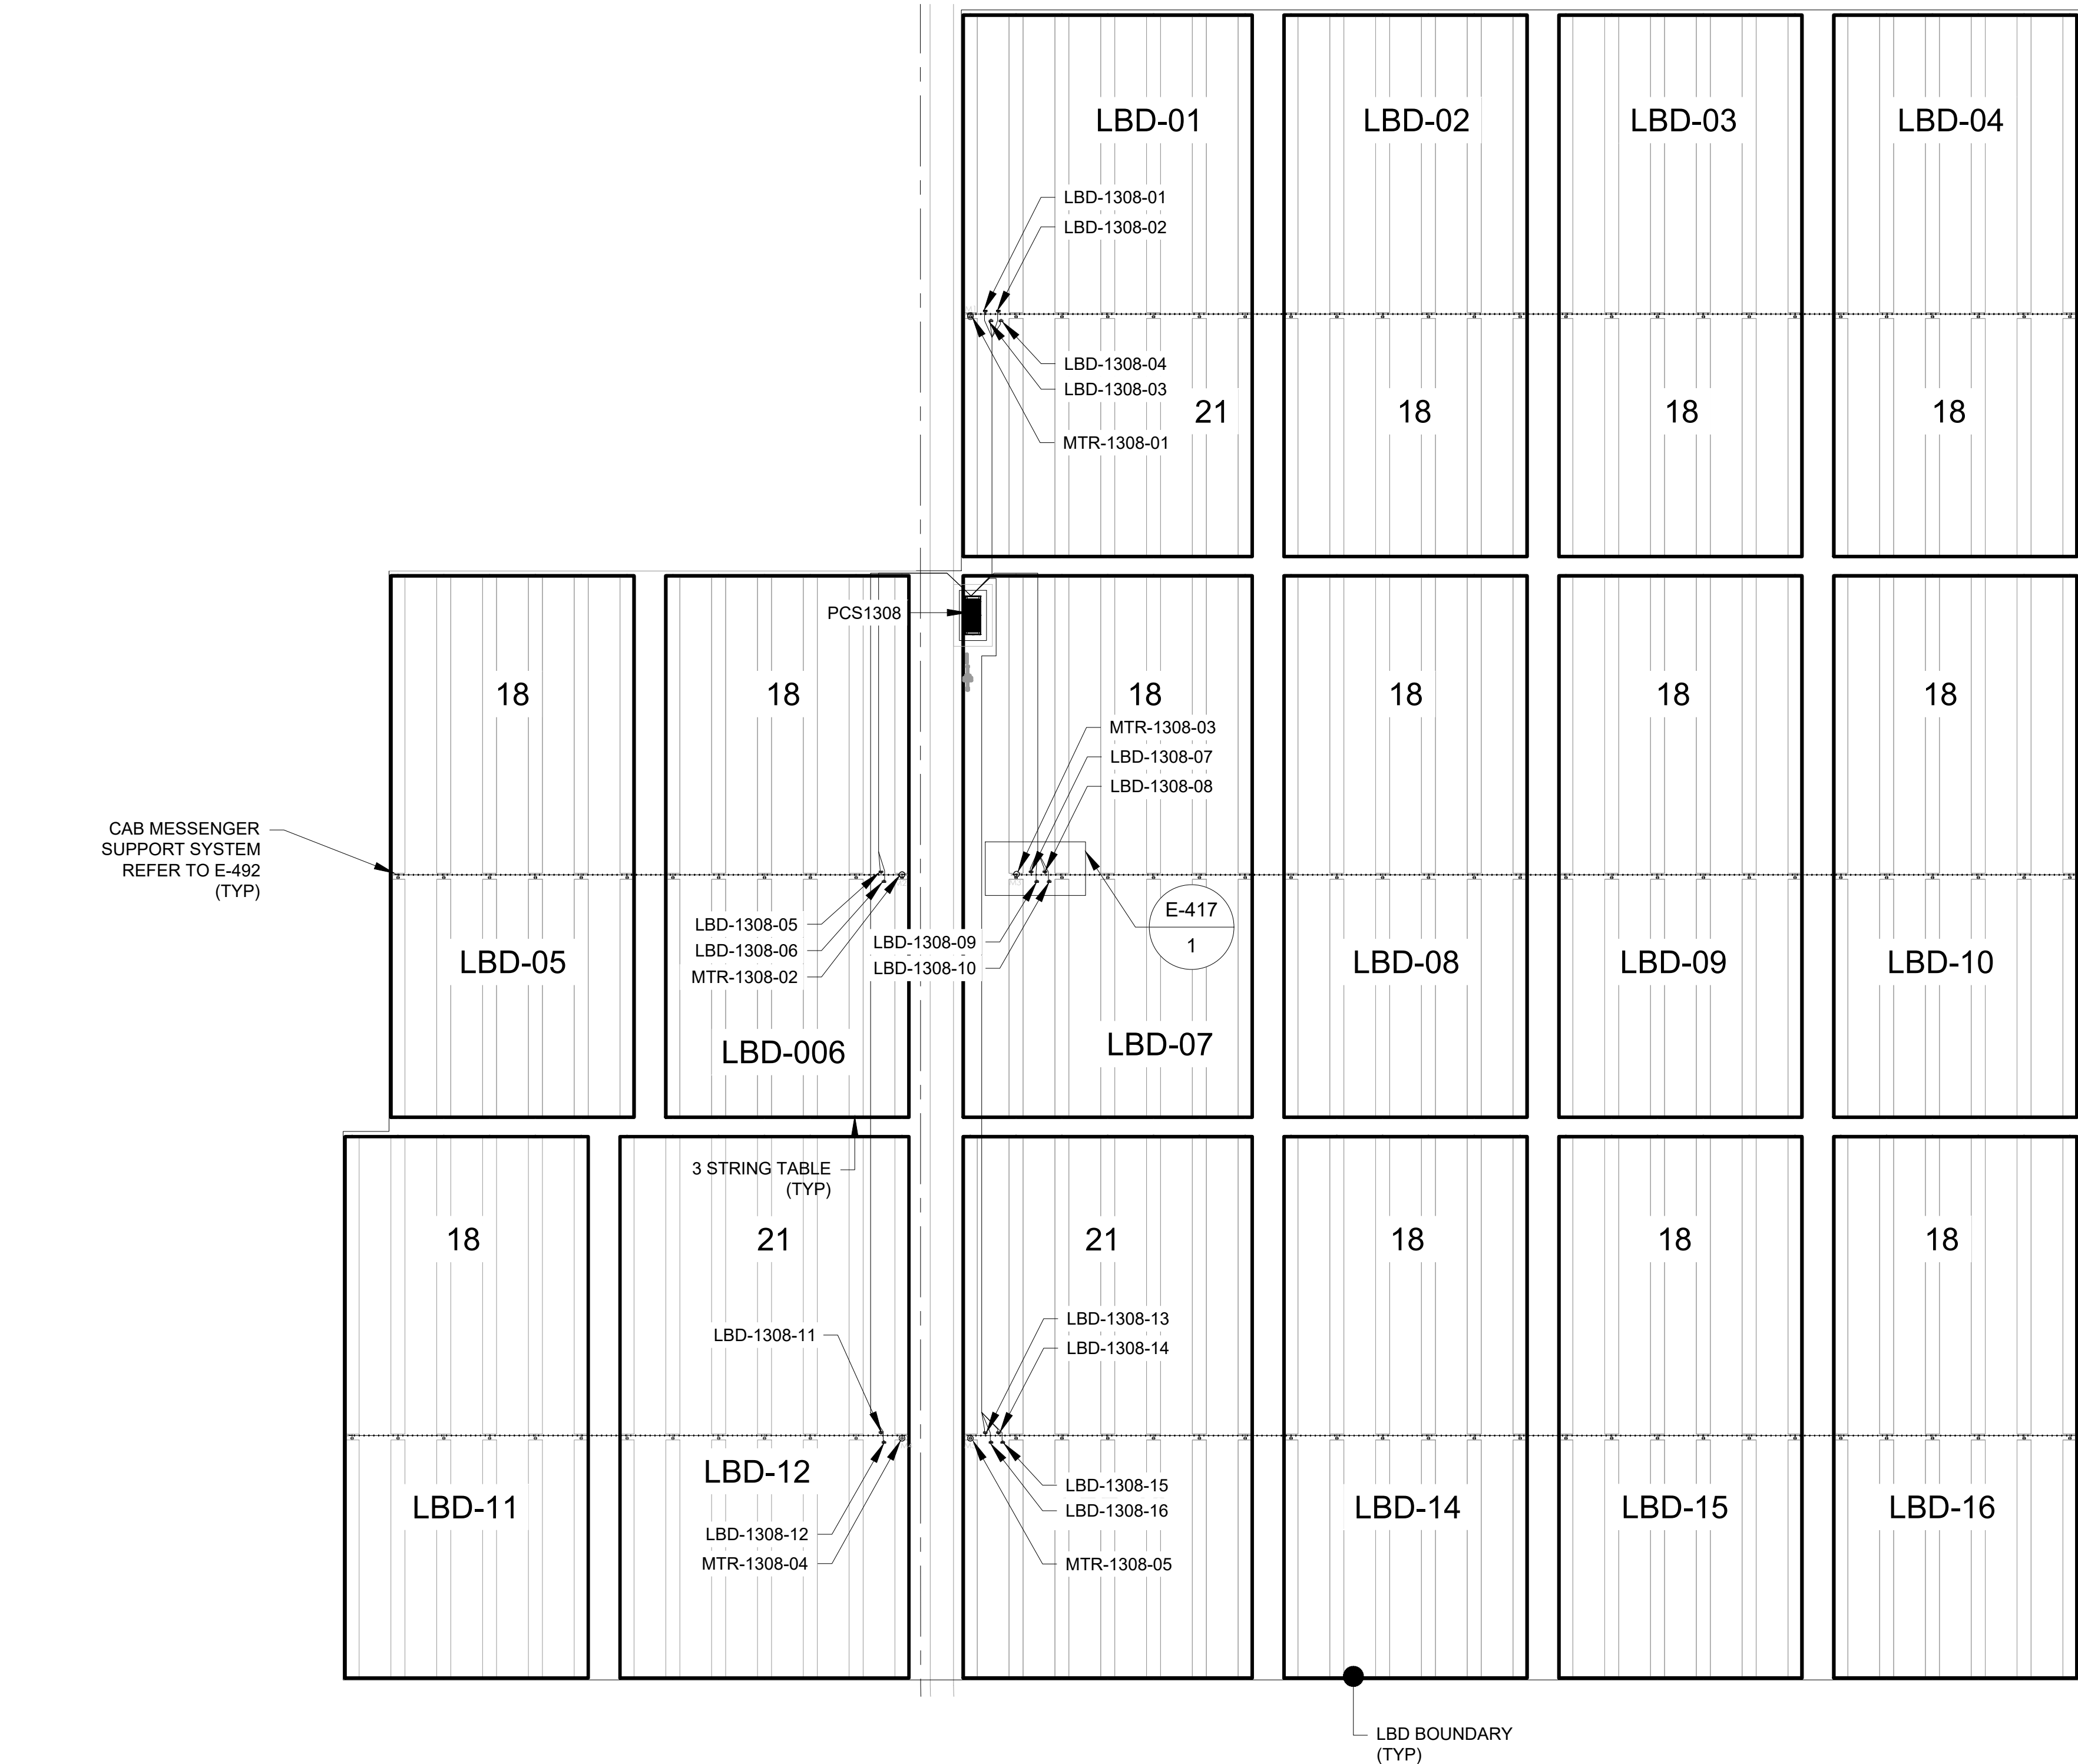

NOTES:

1. DC FEEDER TAGS ARE SAME AS LBD TAGS EXCEPT SUBSTITUTING 'DF' IN PLACE OF 'LBD'.
2. REFER TO SHEET E-005 - BLOCK SCHEDULE AND SHEET E-011 - MODULE ALLOCATION PLAN FOR SPECIFIC INFORMATION REGARDING MODULE QUANTITIES ASSOCIATED WITH PCS-SPECIFIC ARRAY TYPES.


LEGEND:

_____ DF _____ DC FEEDER



HANGER SYSTEM


ARRAY TYPE	ASSOCIATED PCS
A	PCS104 PCS105 PCS106 PCS107 PCS201 PCS207 PCS301 PCS302 PCS303 PCS304 PCS401 PCS402 PCS403 PCS404 PCS405 PCS406 PCS502 PCS503 PCS504 PCS505 PCS506
	PCS204 PCS507
	PCS501
D	PCS202 PCS206
E	PCS205
F	PCS103 PCS907 PCS1007 PCS1101 PCS1102 PCS1103 PCS1104 PCS1106 PCS1107 PCS1108 PCS1201 PCS1202 PCS1204 PCS1205 PCS1206 PCS1207 PCS1301 PCS1302 PCS1303 PCS1304 PCS1306 PCS1307 PCS1402 PCS1404 PCS1405 PCS1406
	PCS101 PCS906 PCS1203
	PCS1208
	PCS1305
	PCS102 PCS1401
K	PCS1408
L	PCS1407
M	PCS1105
N	PCS604
O	PCS606
P	PCS607
Q	PCS1308
R	PCS305 PCS306 PCS307 PCS407 PCS705 PCS706 PCS707 PCS803 PCS804 PCS805 PCS806 PCS807 PCS902 PCS903 PCS904 PCS905 PCS1001 PCS1002 PCS1003 PCS1004 PCS1005
	PCS1006
	PCS802 PCS901
U	PCS203
V	PCS704
W	PCS701 PCS702 PCS703 PCS801
X	PCS601 PCS602 PCS603 PCS605
Y	PCS1403
Z	PCS1008

		FastGrid, LLC 225 E Germann Road Suite 301 Gilbert, AZ 85297
REV	DESCRIPTION	DATE
4	RECORD DRAWINGS	06/08/2023
PROJECT NAME: EAGLE SHADOW MOUNTAIN PV SOLAR POWER GENERATION FACILITY		
PROJECT ADDRESS: I-15 CRYSTAL, NV CLARK COUNTY		
SEAL:		DATE: 10/16/2020
		PROJECT #: 190067.03
		DRAWN BY: TLR
		CHECKED BY: EL
SHEET NAME: DC PLAN - ARRAY TYPE Q (JINKO)		
SHEET #: E-417		REV #: 4

PLOT DATE: Thursday, June 08, 2023

SAVED BY: gregg.looney

LOCATION: K:_09_PROJECTS\190067.03 - PRIMORIS - EAGLE SHADOW MOUNTAIN\05 ENGINEERING\DWG\IE-417 DC PLAN - ARRAY TYPE Q (JINKO)

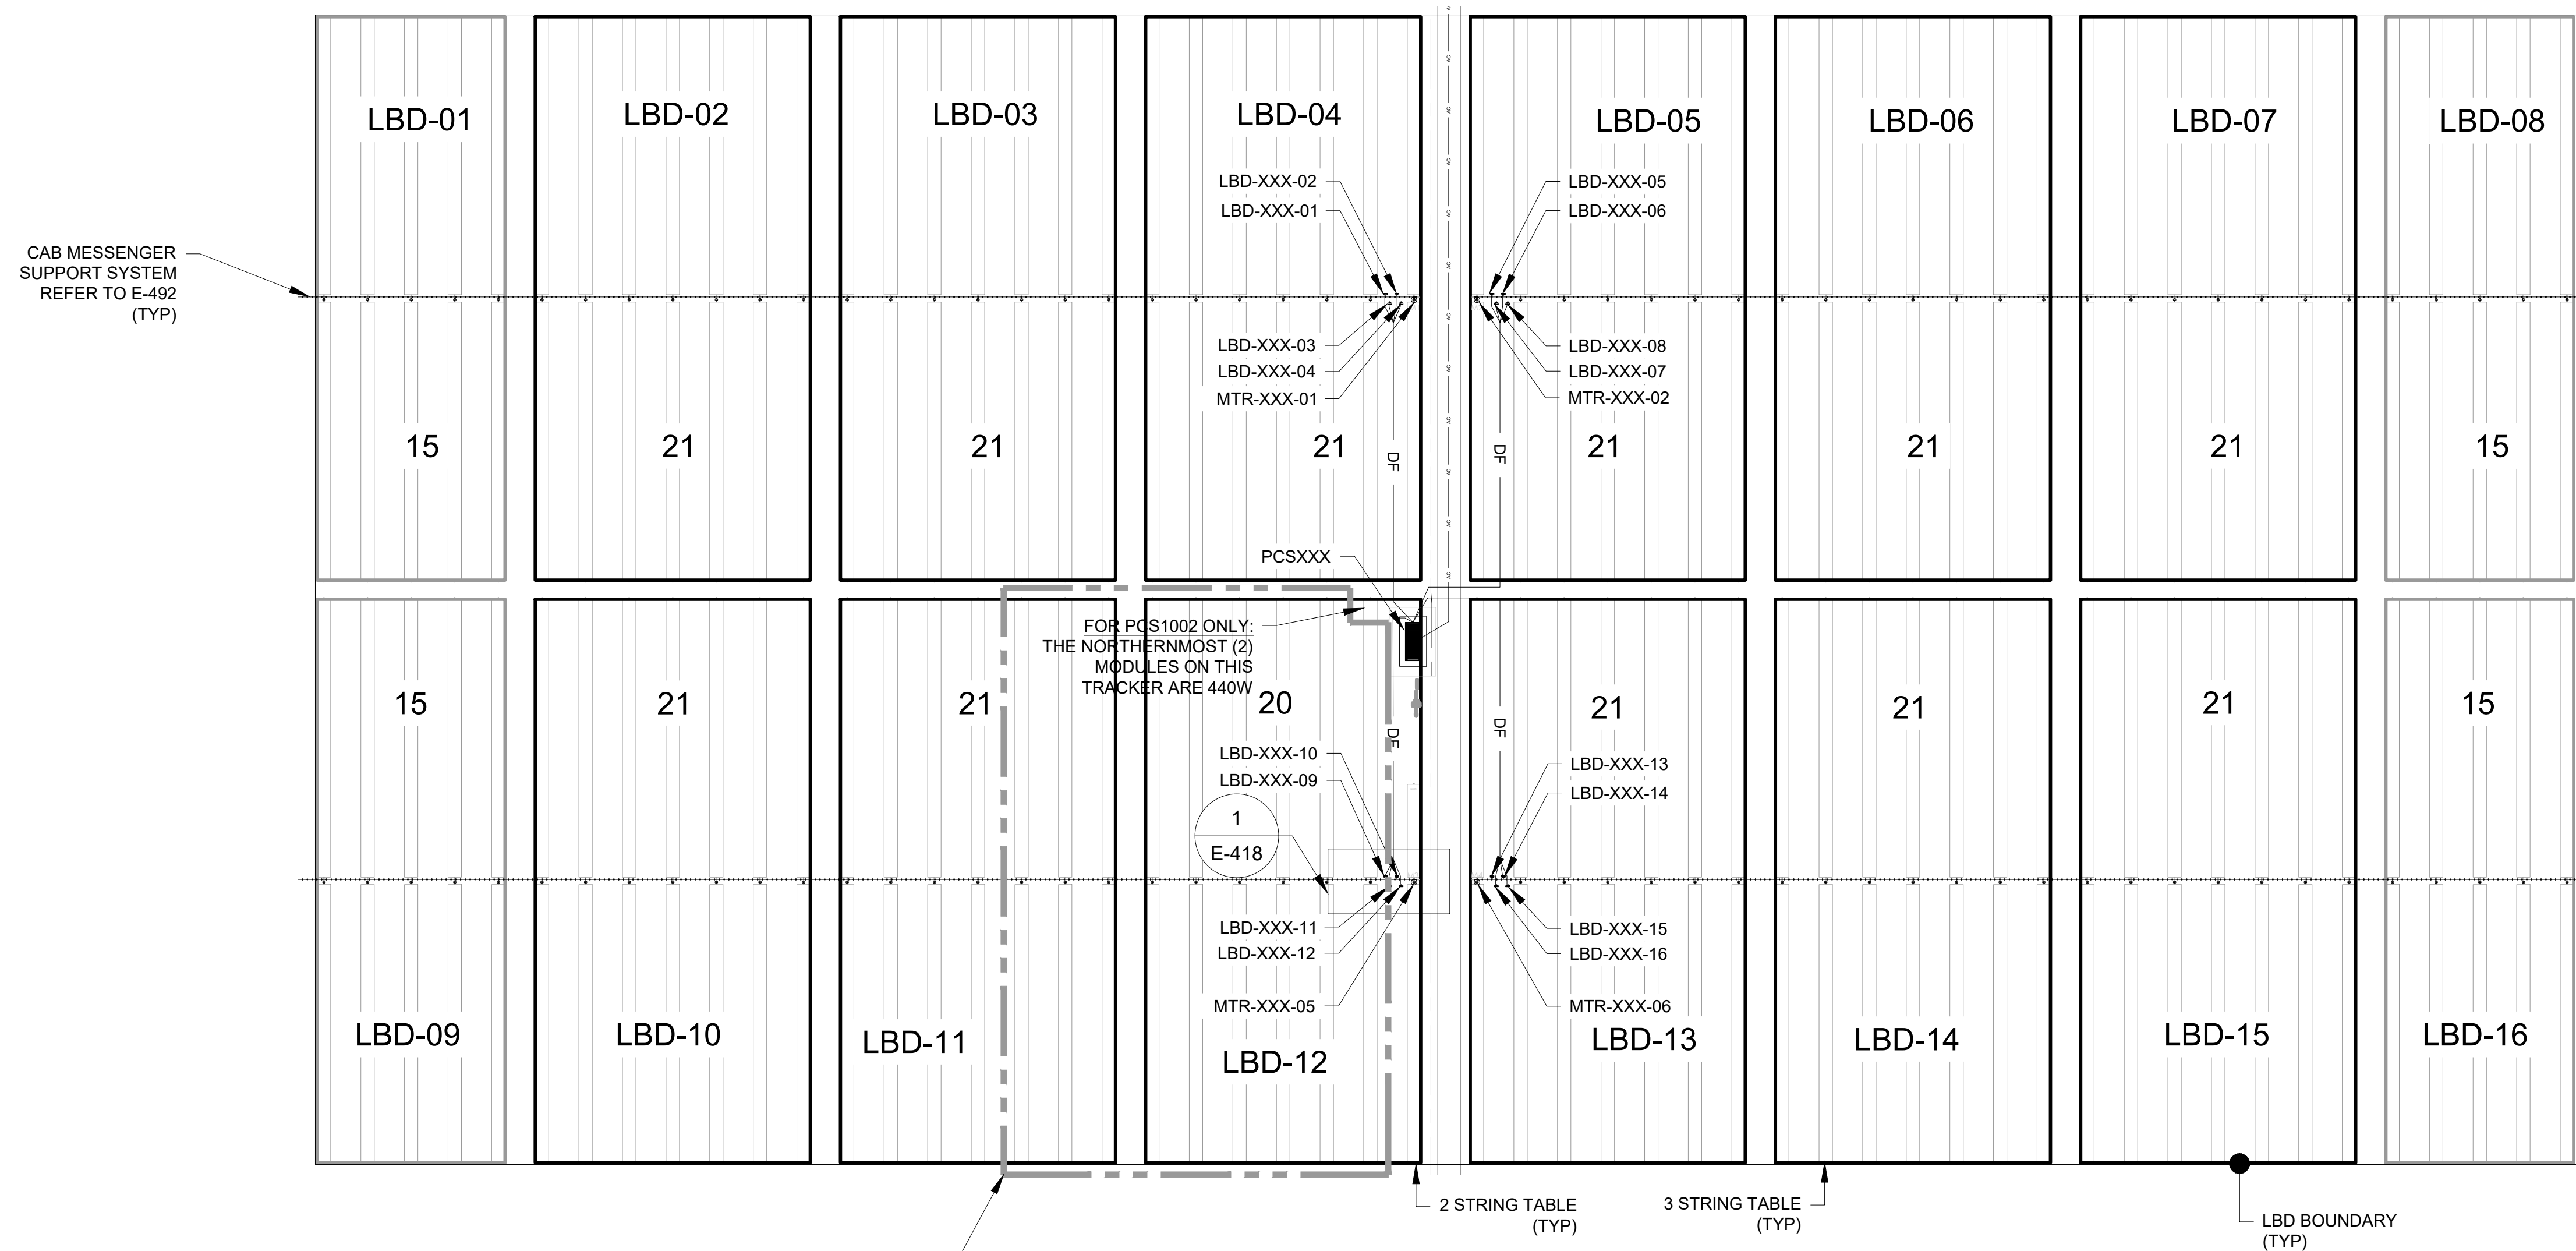

NOTES:



1. DC FEEDER TAGS ARE SAME AS LBD TAGS EXCEPT SUBSTITUTING 'DF' IN PLACE OF 'LBD'.
2. REFER TO SHEET E-005 - BLOCK SCHEDULE AND SHEET E-011 - MODULE ALLOCATION PLAN FOR SPECIFIC INFORMATION REGARDING MODULE QUANTITIES ASSOCIATED WITH PCS-SPECIFIC ARRAY TYPES.

LEGEND:

— DF — DC FEEDER

— HANGER SYSTEM

ARRAY TYPE	ASSOCIATED PCS
A	PCS104 PCS105 PCS106 PCS107 PCS201 PCS207 PCS301 PCS302 PCS303 PCS304 PCS401 PCS402 PCS403 PCS404 PCS405 PCS406 PCS502 PCS503 PCS504 PCS505 PCS506
B	PCS204 PCS507
C	PCS501
D	PCS202 PCS206
E	PCS205
F	PCS103 PCS5907 PCS1007 PCS1101 PCS1102 PCS1103 PCS1104 PCS1106 PCS1107 PCS1108 PCS1201 PCS1202 PCS1204 PCS1205 PCS1206 PCS1207 PCS1301 PCS1302 PCS1303 PCS1304 PCS1306 PCS1307 PCS1402 PCS1404 PCS1405 PCS1406
G	PCS101 PCS906 PCS1203
H	PCS1208
I	PCS1305
J	PCS102 PCS1401
K	PCS1408
L	PCS1407
M	PCS1105
N	PCS604
O	PCS606
P	PCS607
Q	PCS1308
R	PCS305 PCS306 PCS307 PCS407 PCS705 PCS706 PCS707 PCS803 PCS804 PCS805 PCS806 PCS807 PCS902 PCS903 PCS904 PCS905 PCS1001 PCS1002 PCS1003 PCS1004 PCS1005
S	PCS1006
T	PCS802 PCS901
U	PCS203
V	PCS704
W	PCS701 PCS702 PCS703 PCS801
X	PCS601 PCS602 PCS603 PCS605
Y	PCS1403
Z	PCS1008

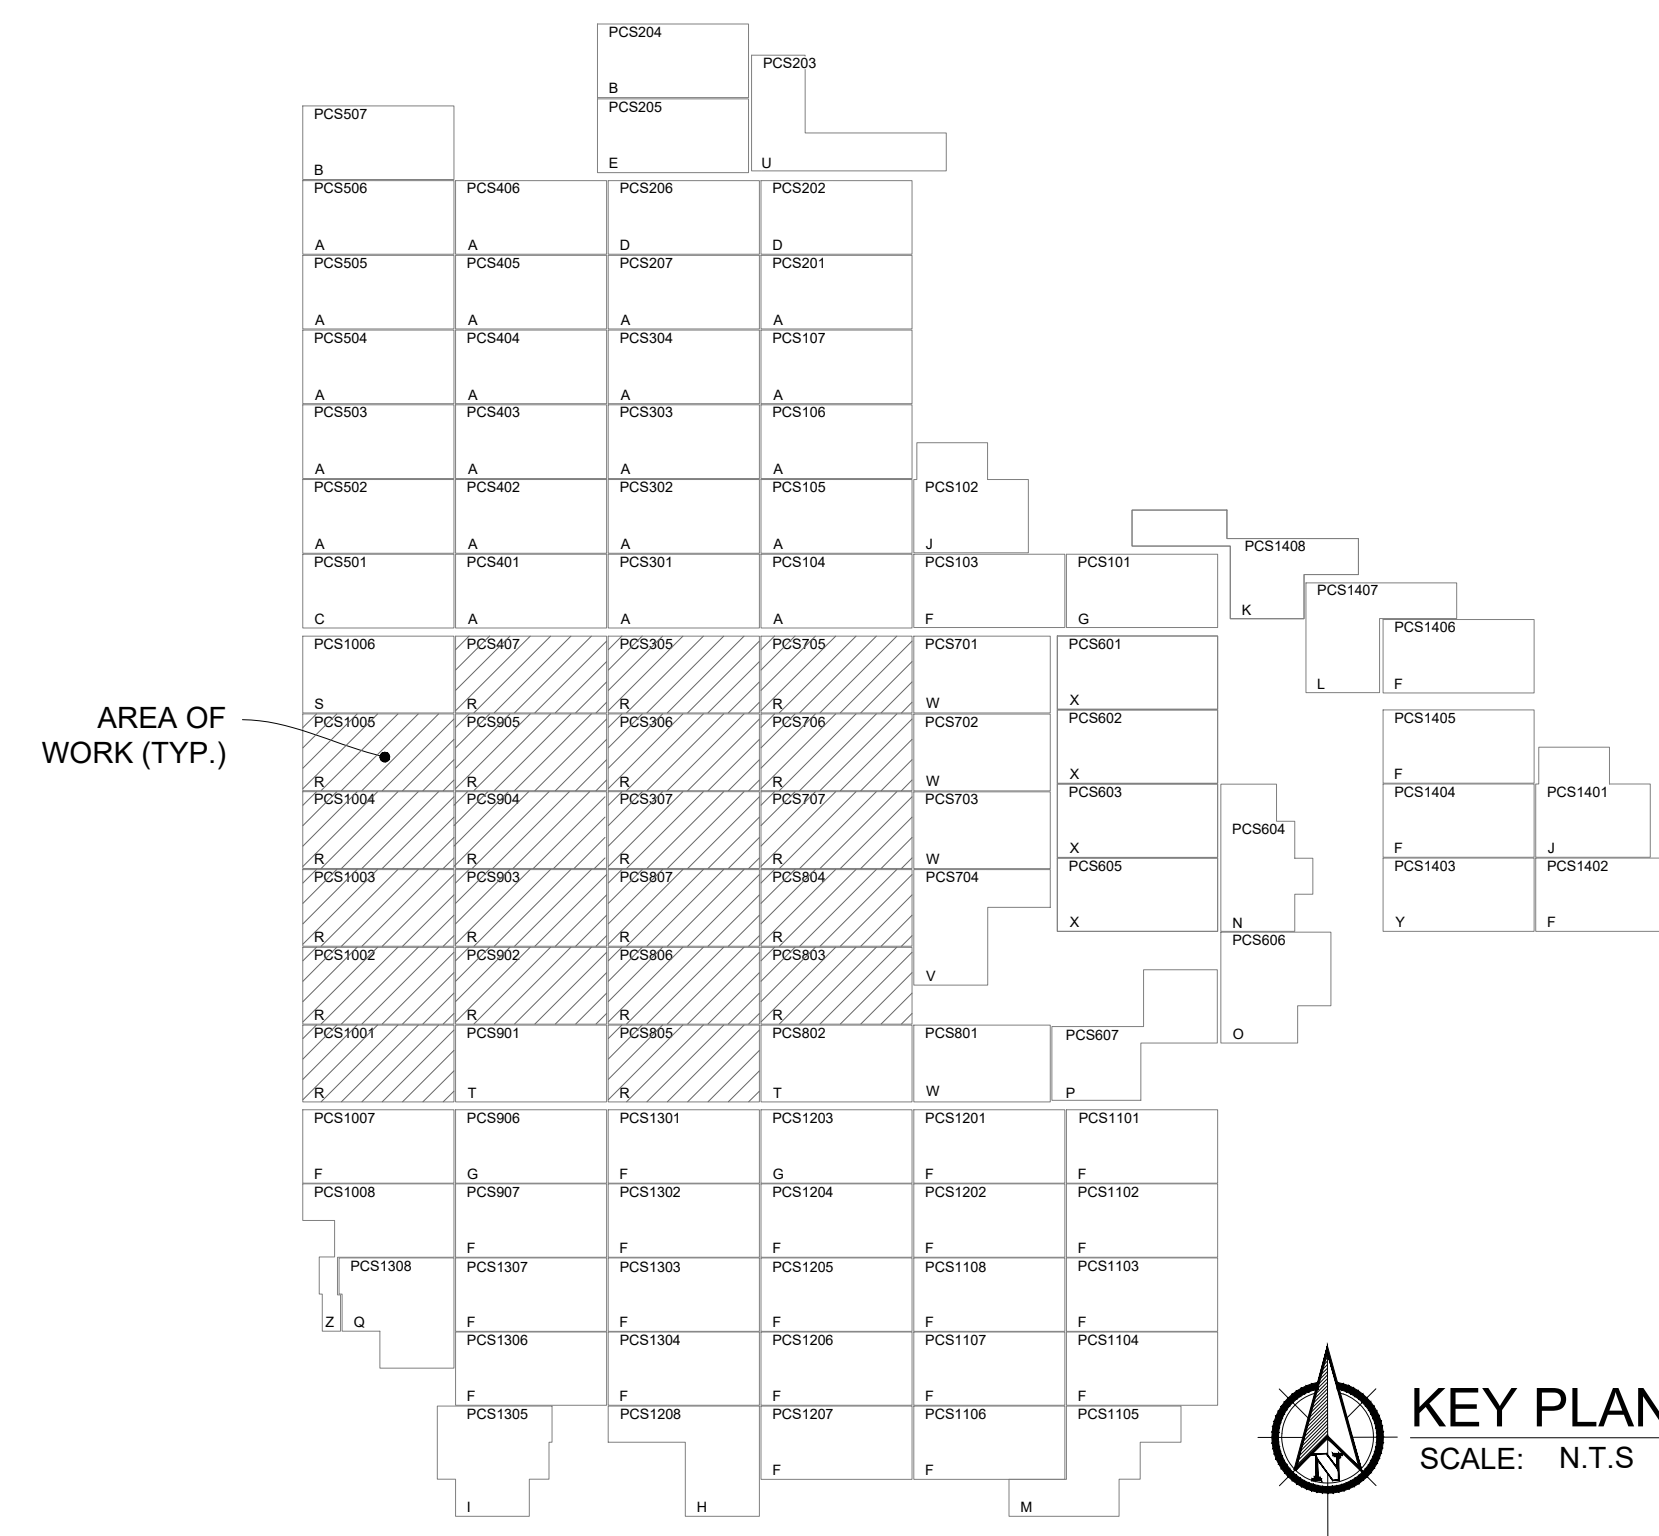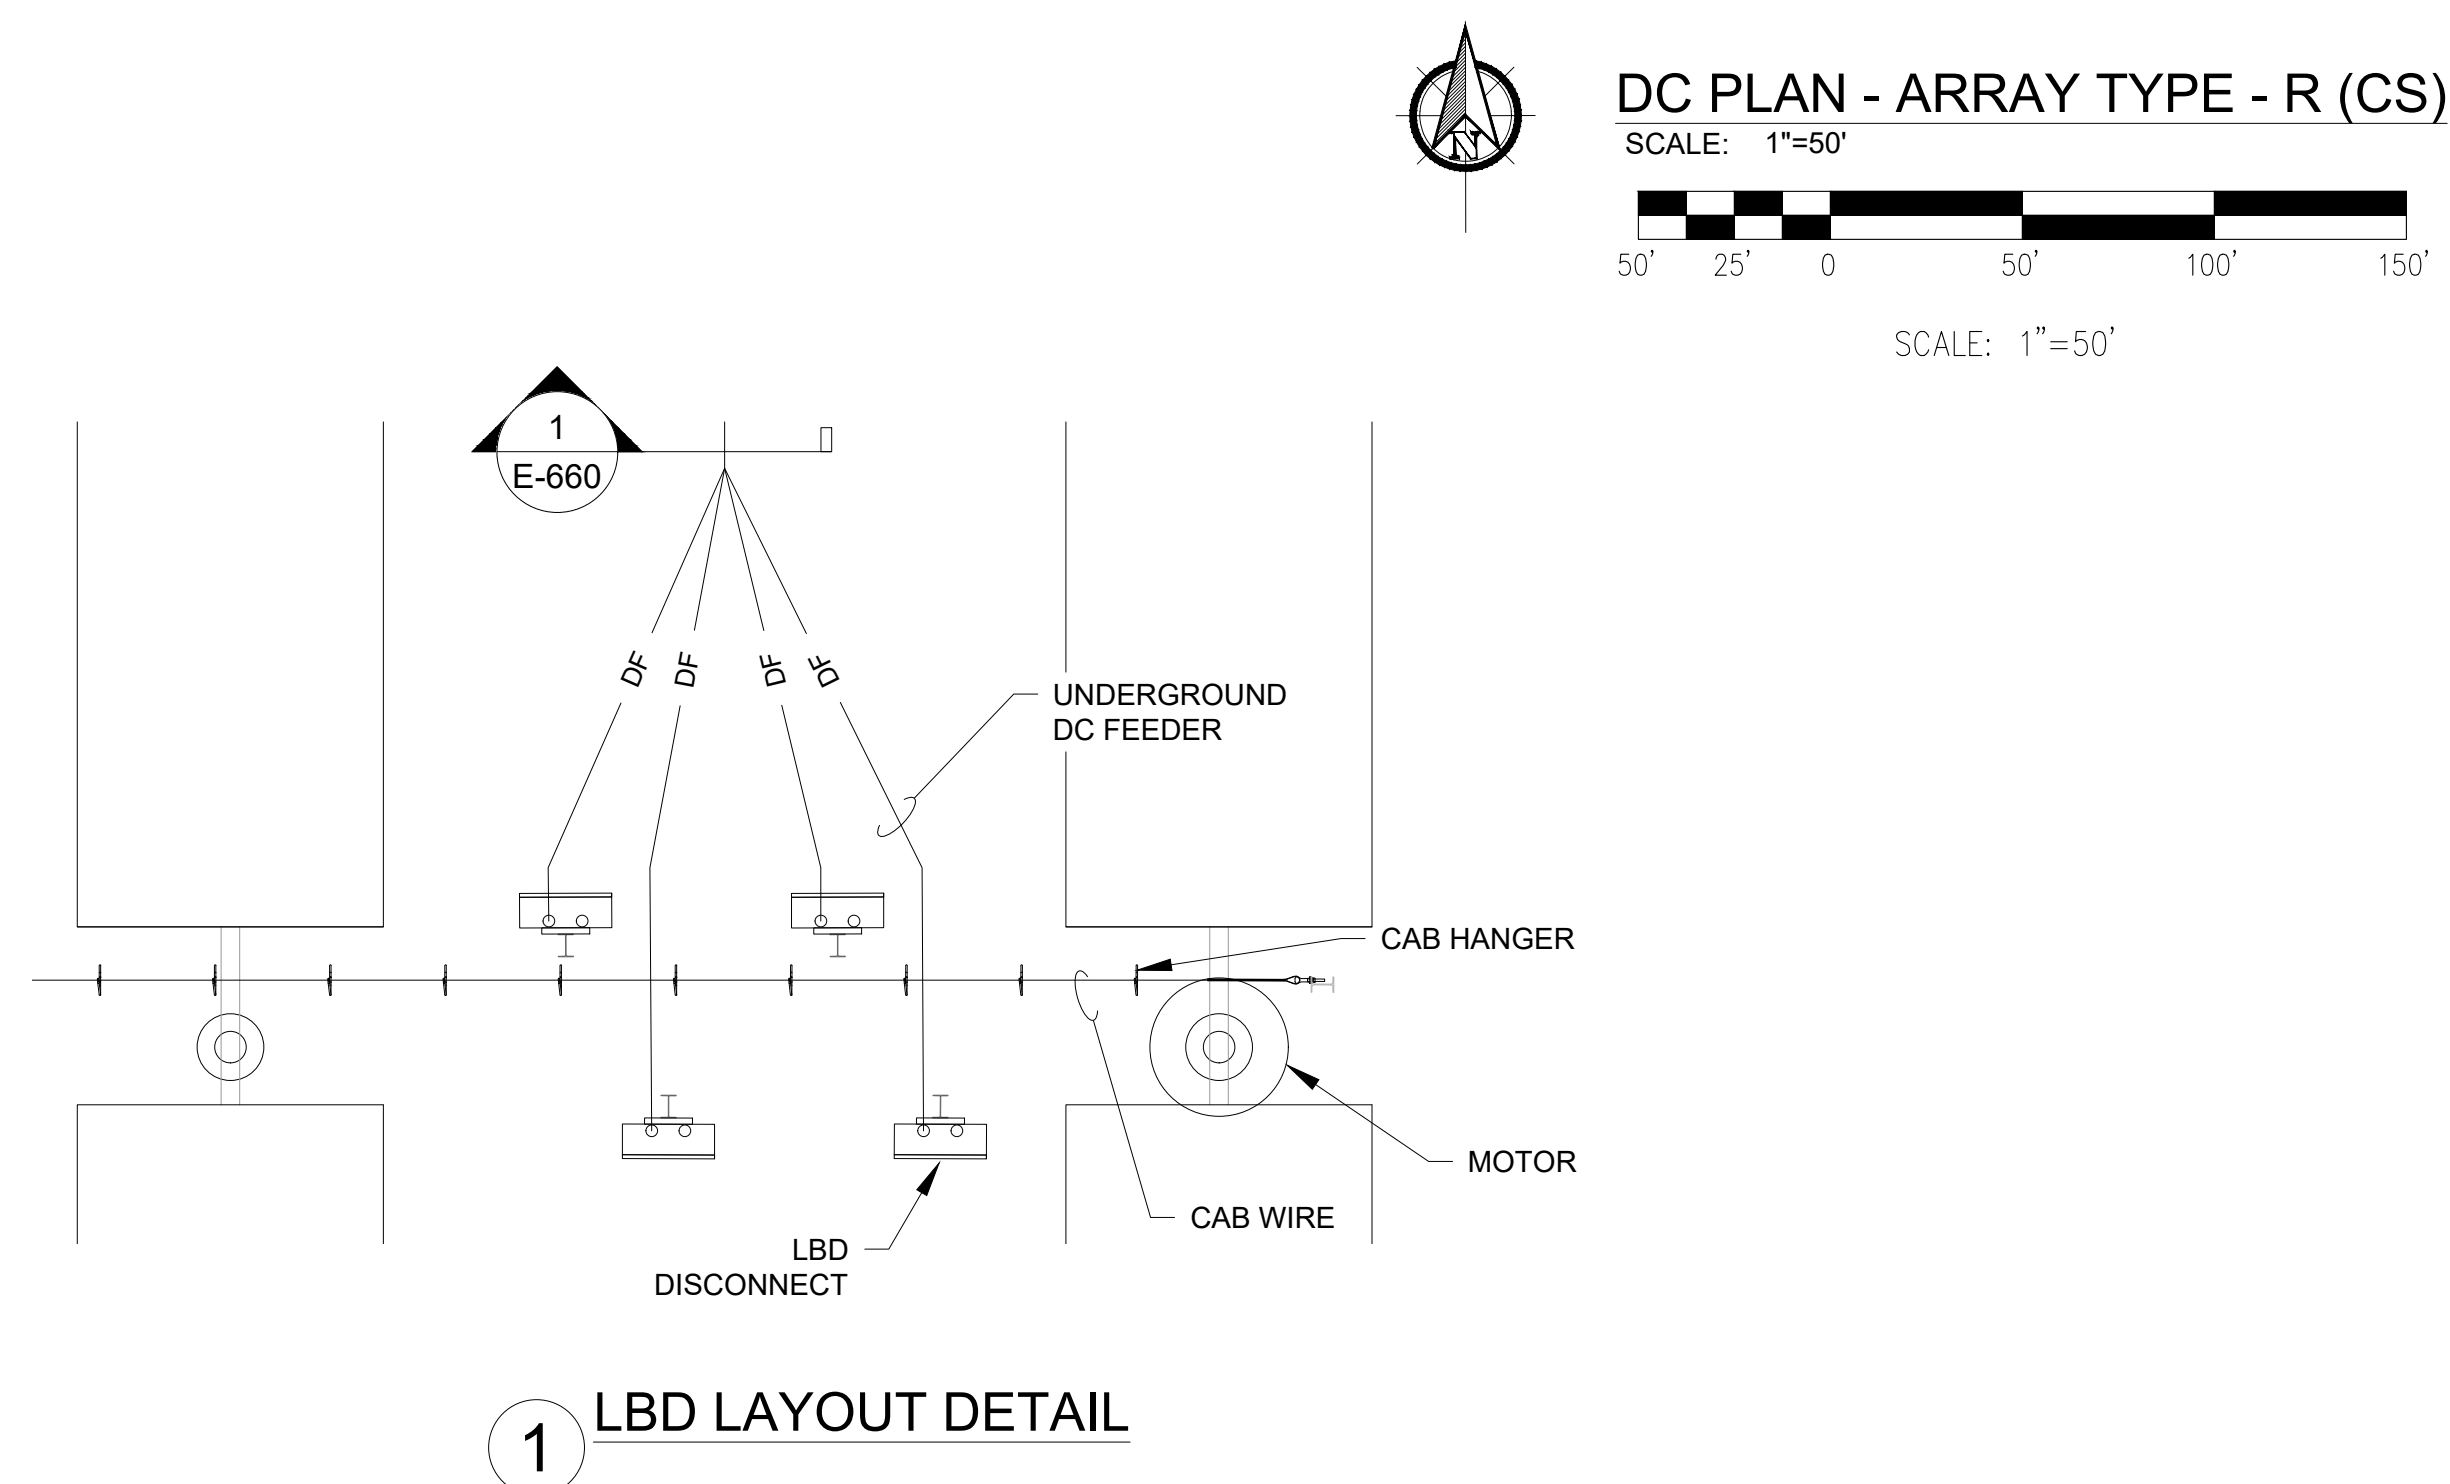[illegible]

LOCATION: K:\09 PROJECTS\190067 03 - PRIMORIS - EAGLE SHADOW MOUNTAIN\05 ENGINEERING\DWG-418 DC PLAN - ARRAY TYPE R (CS)	SAVED BY: brady.burgason	PLOT BY: Brady Burgason	PLOT DATE: Thursday, June 08, 2023
--	--------------------------	-------------------------	------------------------------------

- NOTES:
- DC FEEDER TAGS ARE SAME AS LBD TAGS EXCEPT SUBSTITUTING 'DF' IN PLACE OF 'LBD'.
 - REFER TO SHEET E-005 - BLOCK SCHEDULE AND SHEET E-011 - MODULE ALLOCATION PLAN FOR SPECIFIC INFORMATION REGARDING MODULE QUANTITIES ASSOCIATED WITH PCS-SPECIFIC ARRAY TYPES.

LEGEND:

— DF — DC FEEDER

— HANGER SYSTEM

ARRAY TYPE	ASSOCIATED PCS
A	PCS104 PCS105 PCS106 PCS107 PCS201 PCS207 PCS301 PCS302 PCS303 PCS304 PCS401 PCS402 PCS403 PCS404 PCS405 PCS406 PCS502 PCS503 PCS504 PCS505 PCS506
B	PCS204 PCS507
C	PCS501
D	PCS202 PCS206
E	PCS205
F	PCS103 PCS907 PCS1007 PCS1101 PCS1102 PCS1103 PCS1104 PCS1106 PCS1107 PCS1108 PCS1201 PCS1202 PCS1204 PCS1205 PCS1206 PCS1207 PCS1301 PCS1302 PCS1303 PCS1304 PCS1306 PCS1307 PCS1402 PCS1404 PCS1405 PCS1406
G	PCS101 PCS906 PCS1203
H	PCS1208
I	PCS1305
J	PCS102 PCS1401
K	PCS1408
L	PCS1407
M	PCS1105
N	PCS604
O	PCS606
P	PCS607
Q	PCS1308
R	PCS305 PCS306 PCS307 PCS407 PCS705 PCS706 PCS707 PCS803 PCS804 PCS805 PCS806 PCS807 PCS902 PCS903 PCS904 PCS905 PCS1001 PCS1002 PCS1003 PCS1004 PCS1005
S	PCS1006
T	PCS802 PCS901
U	PCS203
V	PCS704
W	PCS701 PCS702 PCS703 PCS801
X	PCS601 PCS602 PCS603 PCS605
Y	PCS1403
Z	PCS1008



REV	DESCRIPTION	DATE
4	RECORD DRAWINGS	06/08/2023

PROJECT NAME:
**EAGLE SHADOW MOUNTAIN
PV SOLAR POWER
GENERATION FACILITY**

PROJECT ADDRESS:
**I-15
CRYSTAL, NV
CLARK COUNTY**

SEAL:

DATE:
10/16/2020

PROJECT #:
190067.03

DRAWN BY:
NK

CHECKED BY:
EL



SHEET NAME:
DC PLAN - ARRAY TYPE S (CS)

SHEET #:
E-419


REV #:
4

RECORD DRAWING

KEY PLAN
SCALE: N.T.S.

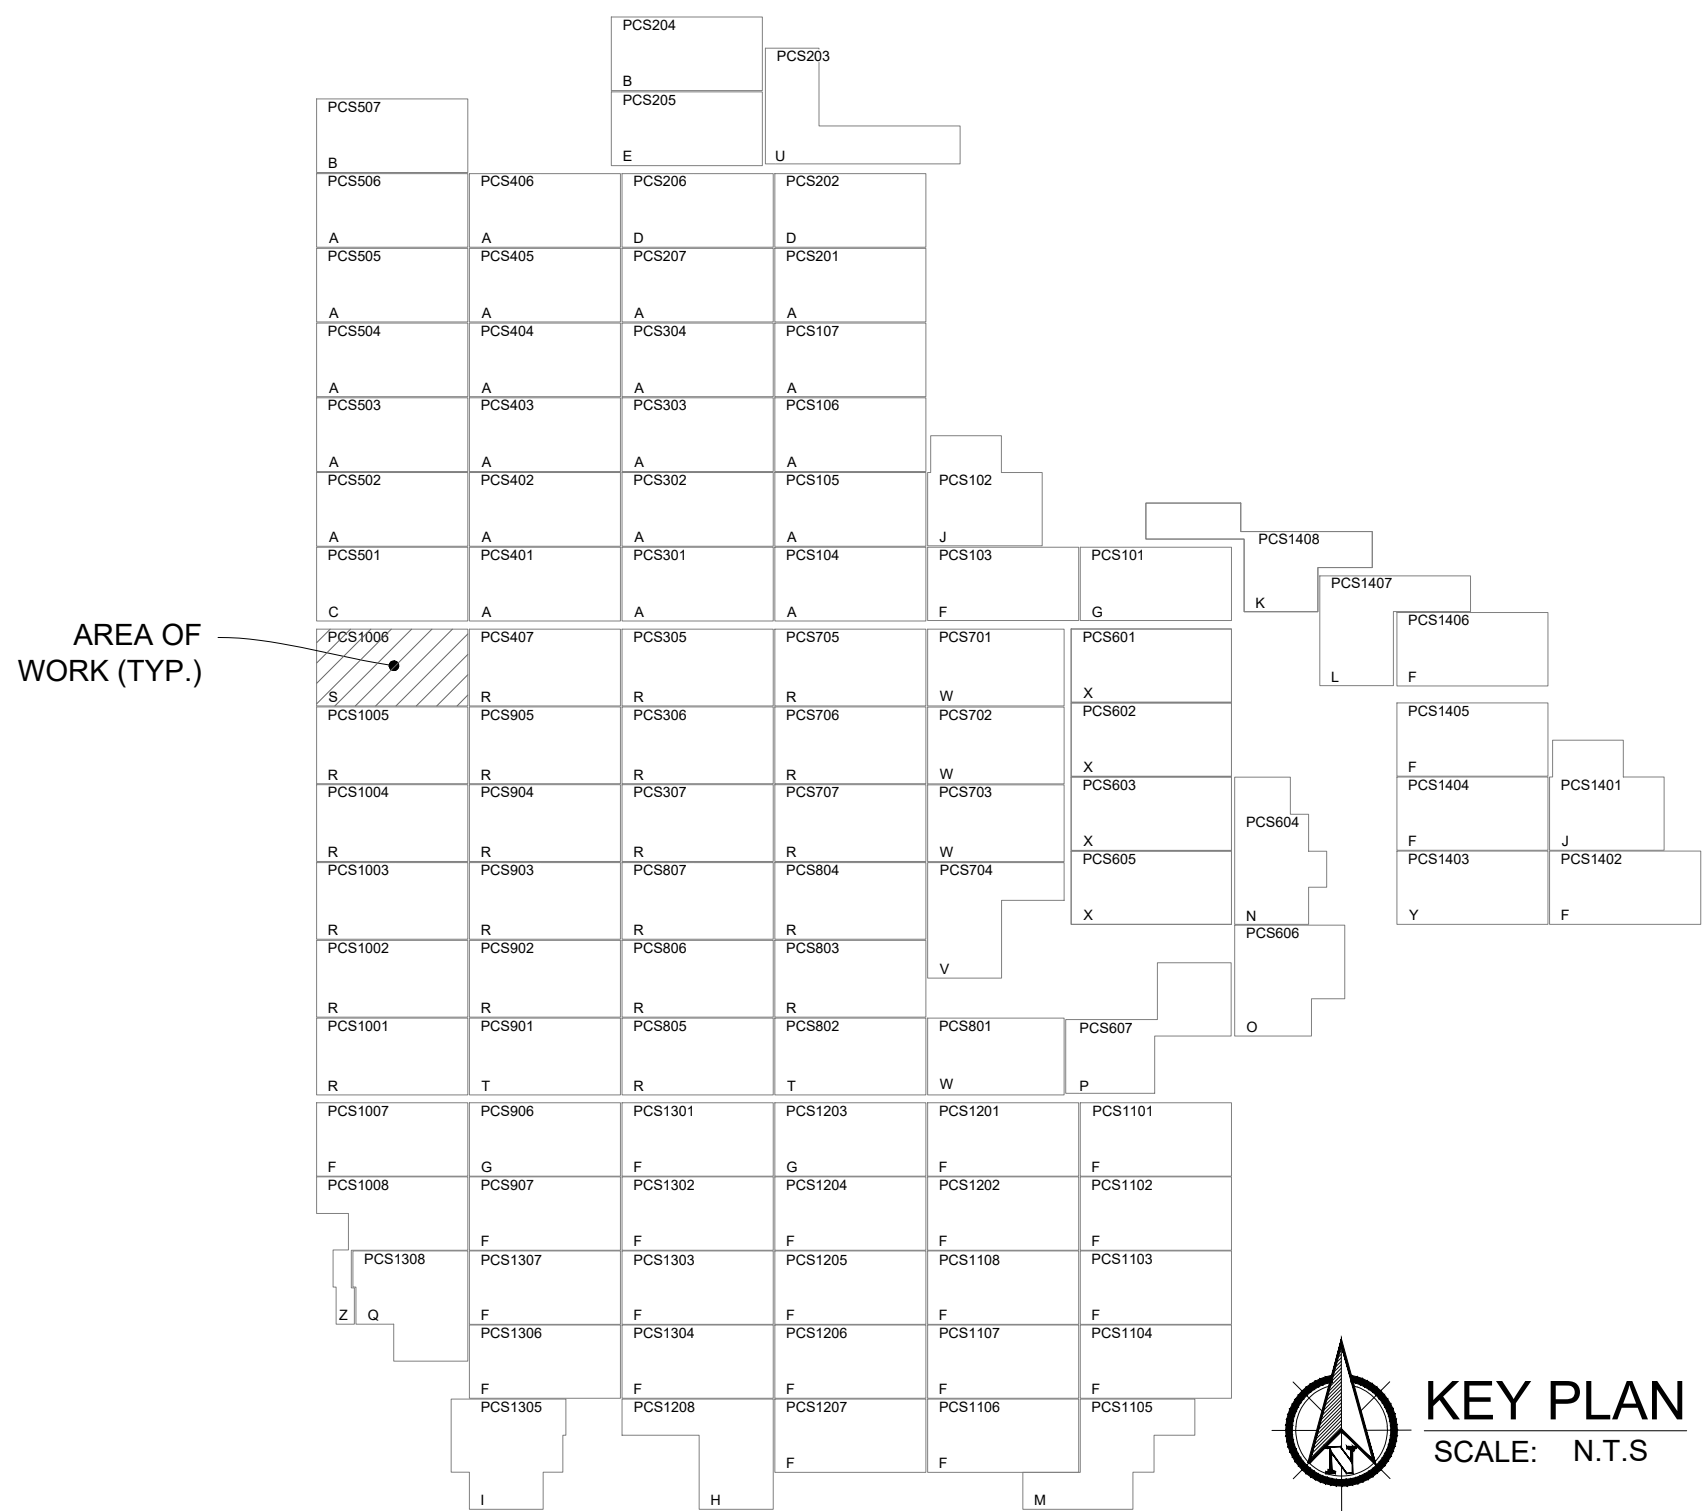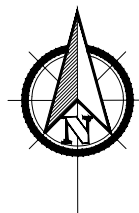


AREA OF
WORK (TYP.)

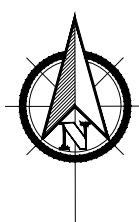


DC PLAN - ARRAY TYPE - S (CS)

SCALE: 1"=50'

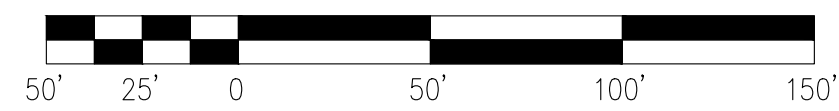


SCALE: 1"=50'

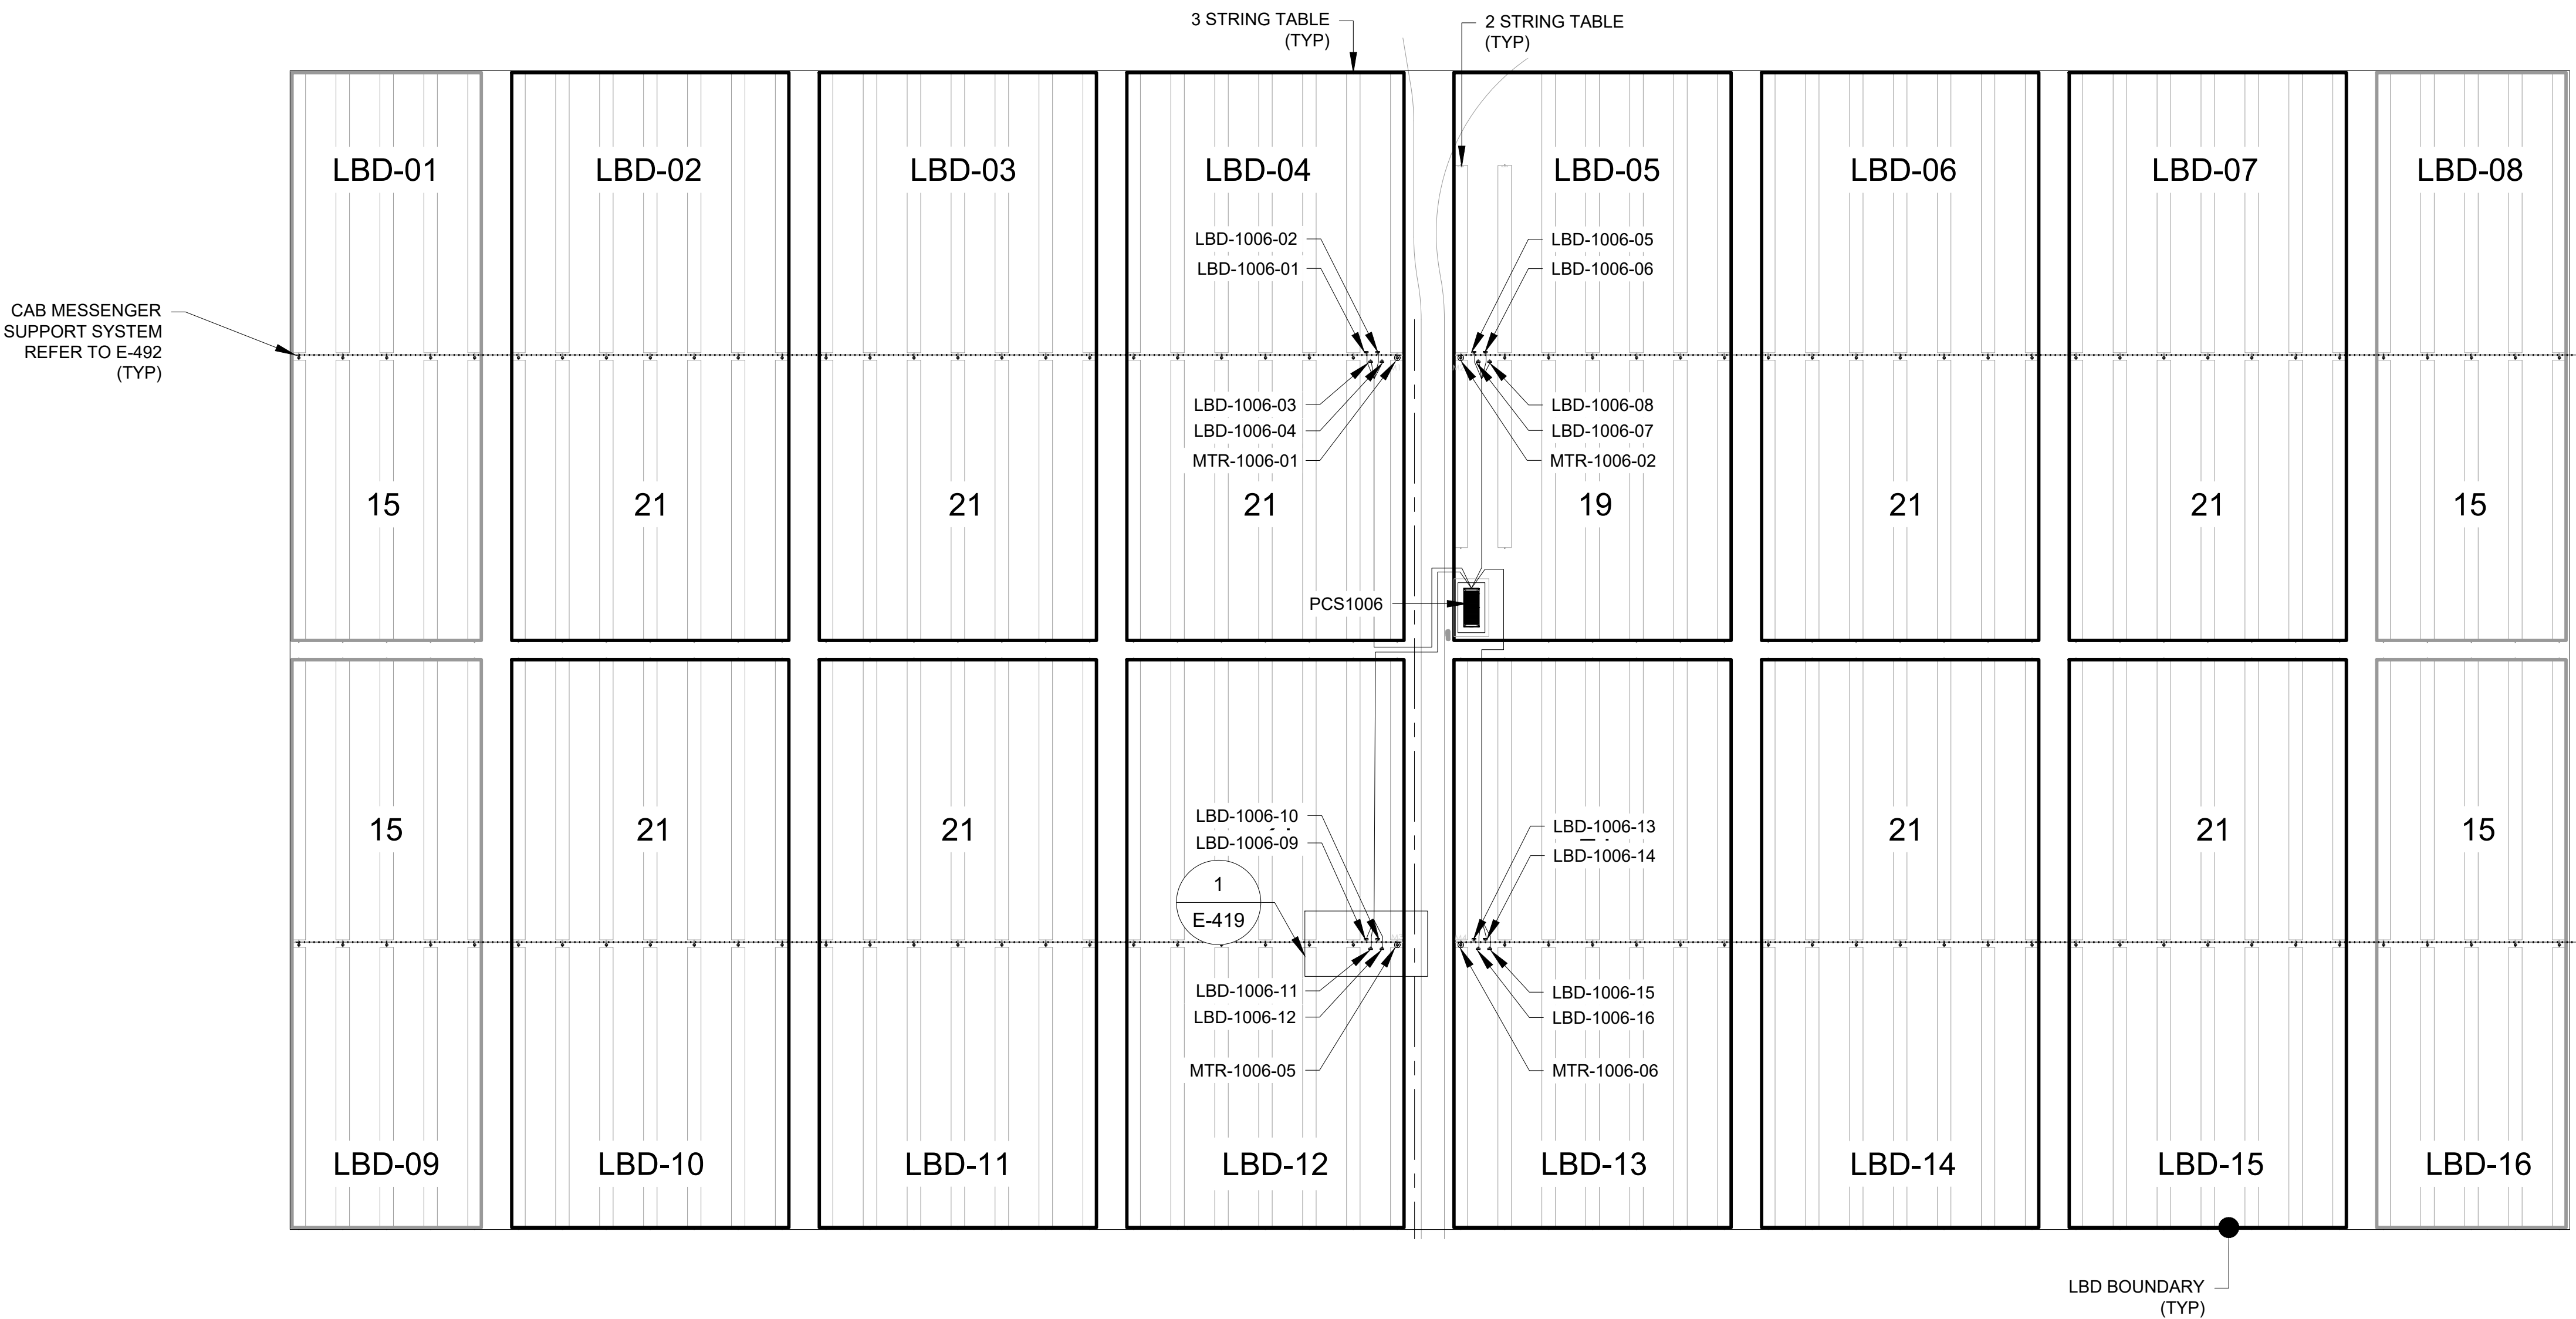

CAB MESSENGER
SUPPORT SYSTEM
REFER TO E-492
(TYP)

LBD BOUNDARY
(TYP)

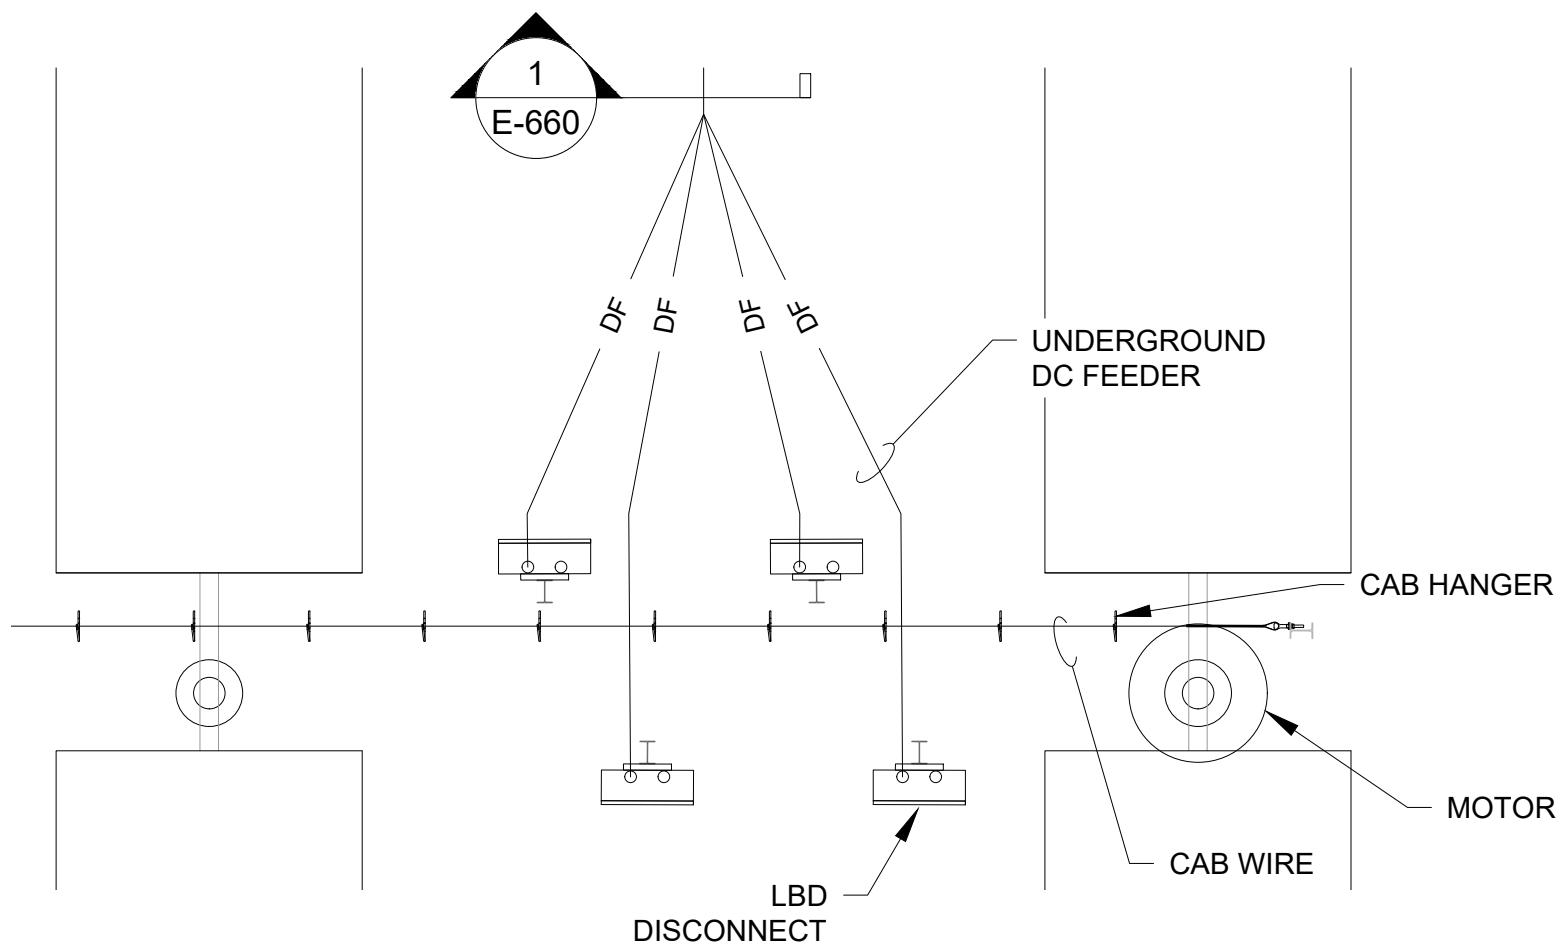

1 LBD LAYOUT DETAIL

PLOT DATE: Thursday, June 08, 2023

SAVED BY: EridLoos

LOCATION: K:_09_PROJECTS\190067.03 - PRIMORS - EAGLE SHADOW MOUNTAIN\05 ENGINEERING\DWG\E-419 DC PLAN - ARRAY TYPE S (CS)

7

6

5


4

3

2

1


CAB MESSENGER
SUPPORT SYSTEM
REFER TO E-492
(TYP)

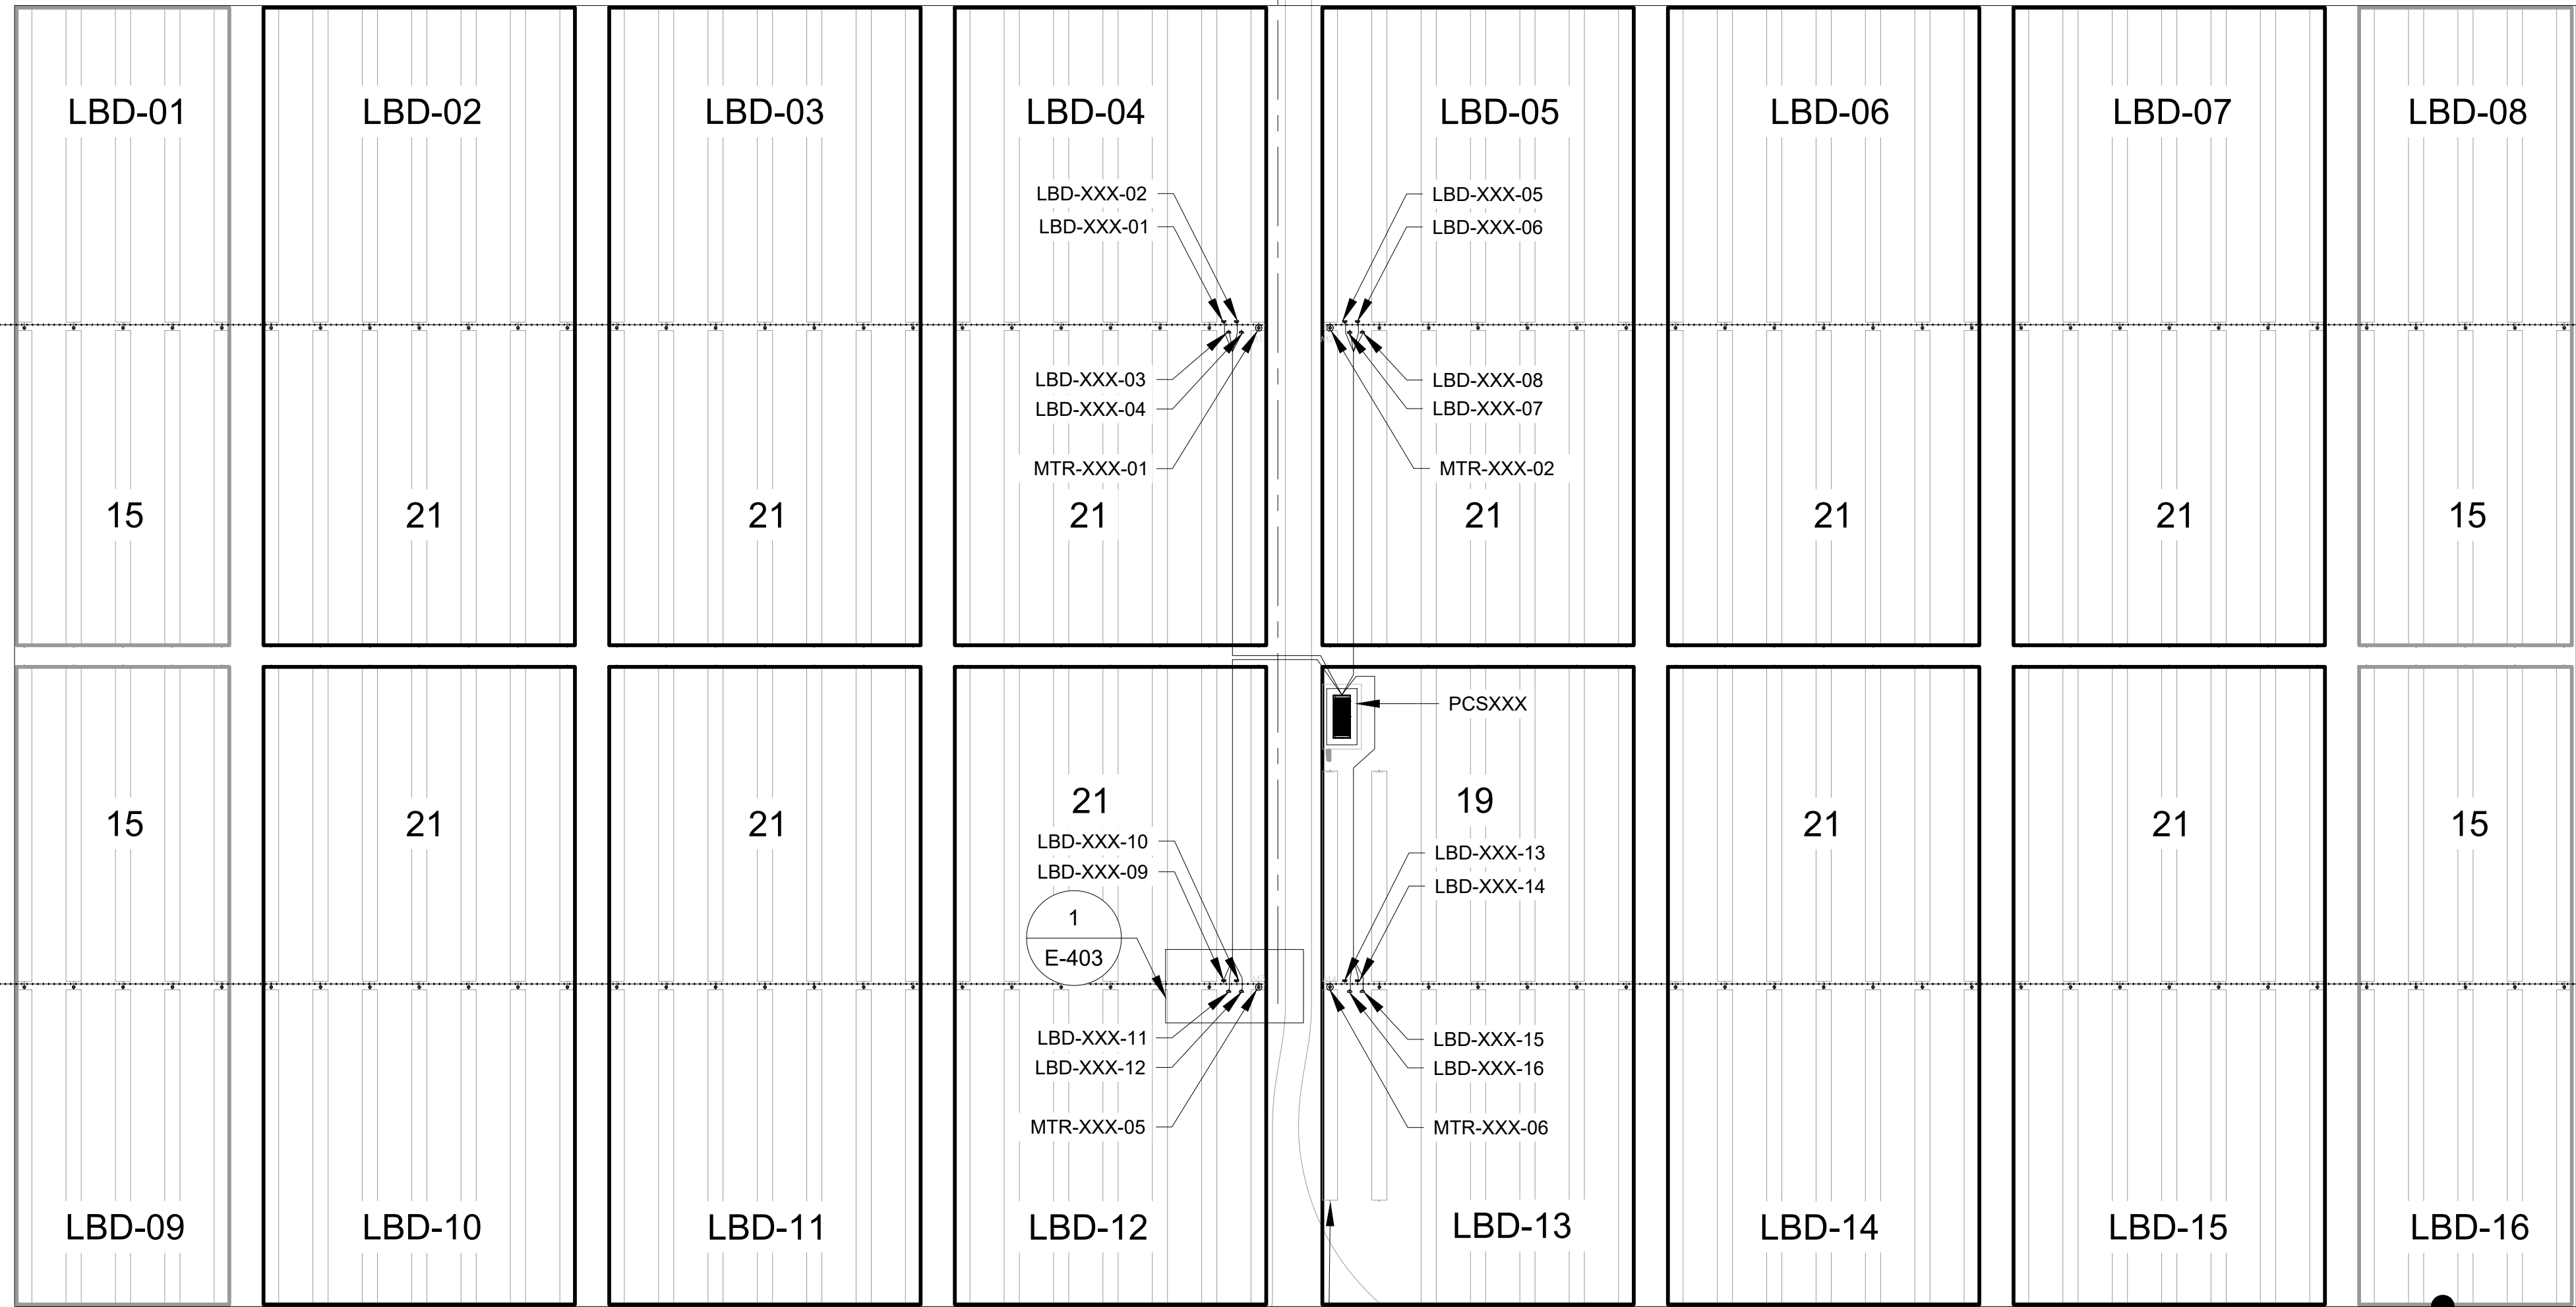

2 STRING TABLE
(TYP)


3 STRING TABLE
(TYP)

LBD BOUNDARY
(TYP)

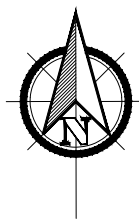


DC PLAN - ARRAY TYPE - T (CS)


SCALE: 1"=50'

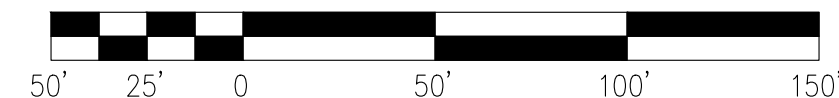

SCALE: 1"=50'

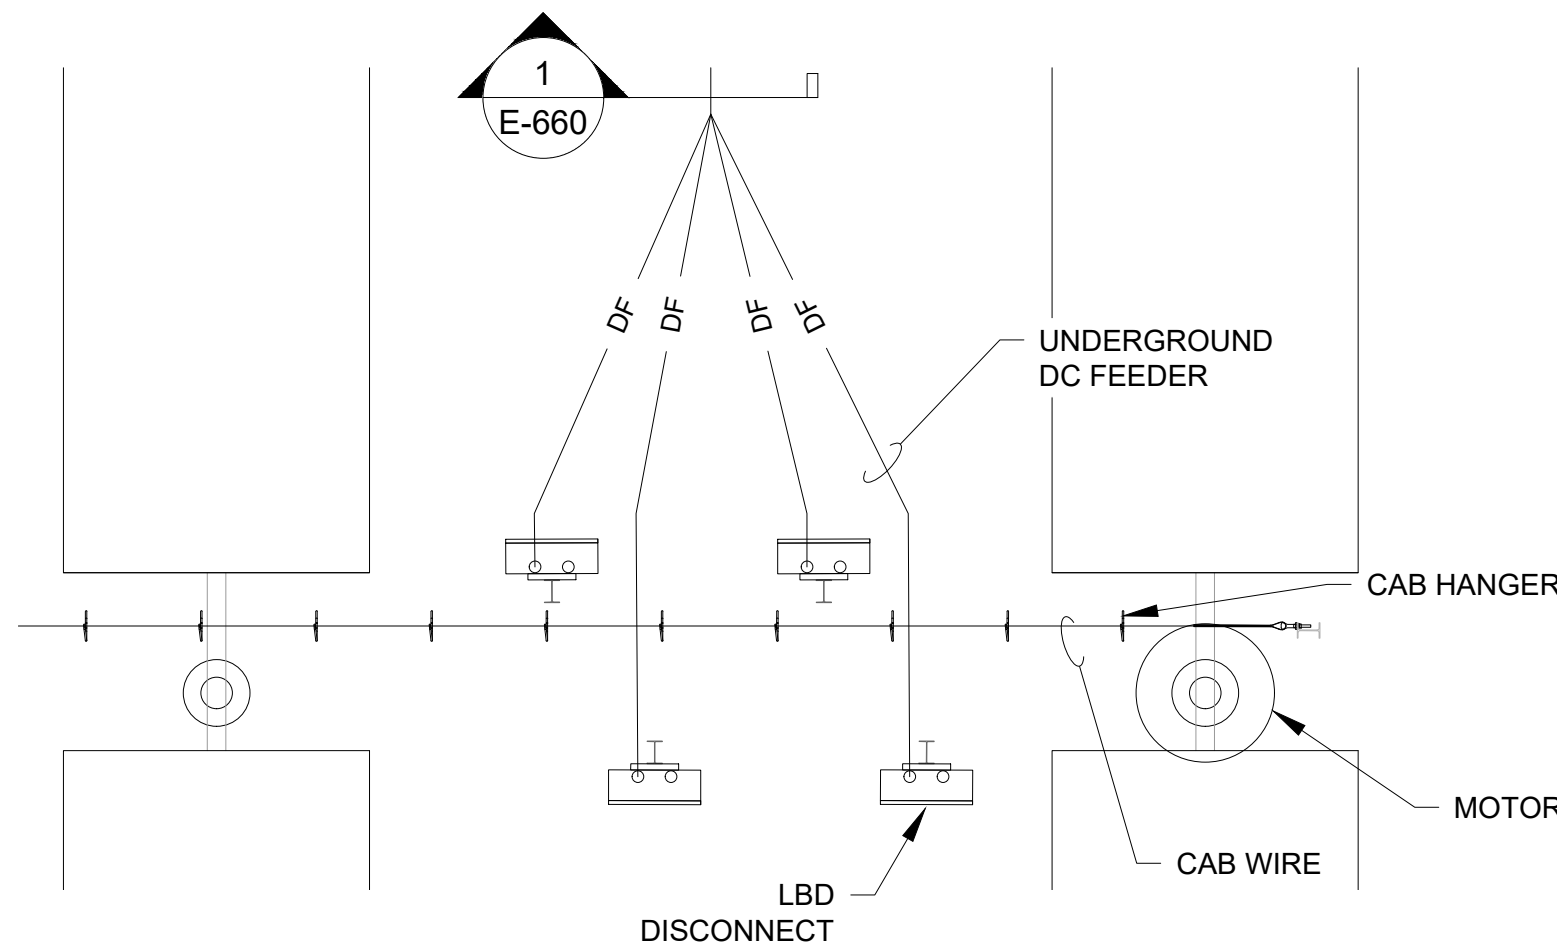

1 LBD LAYOUT DETAIL

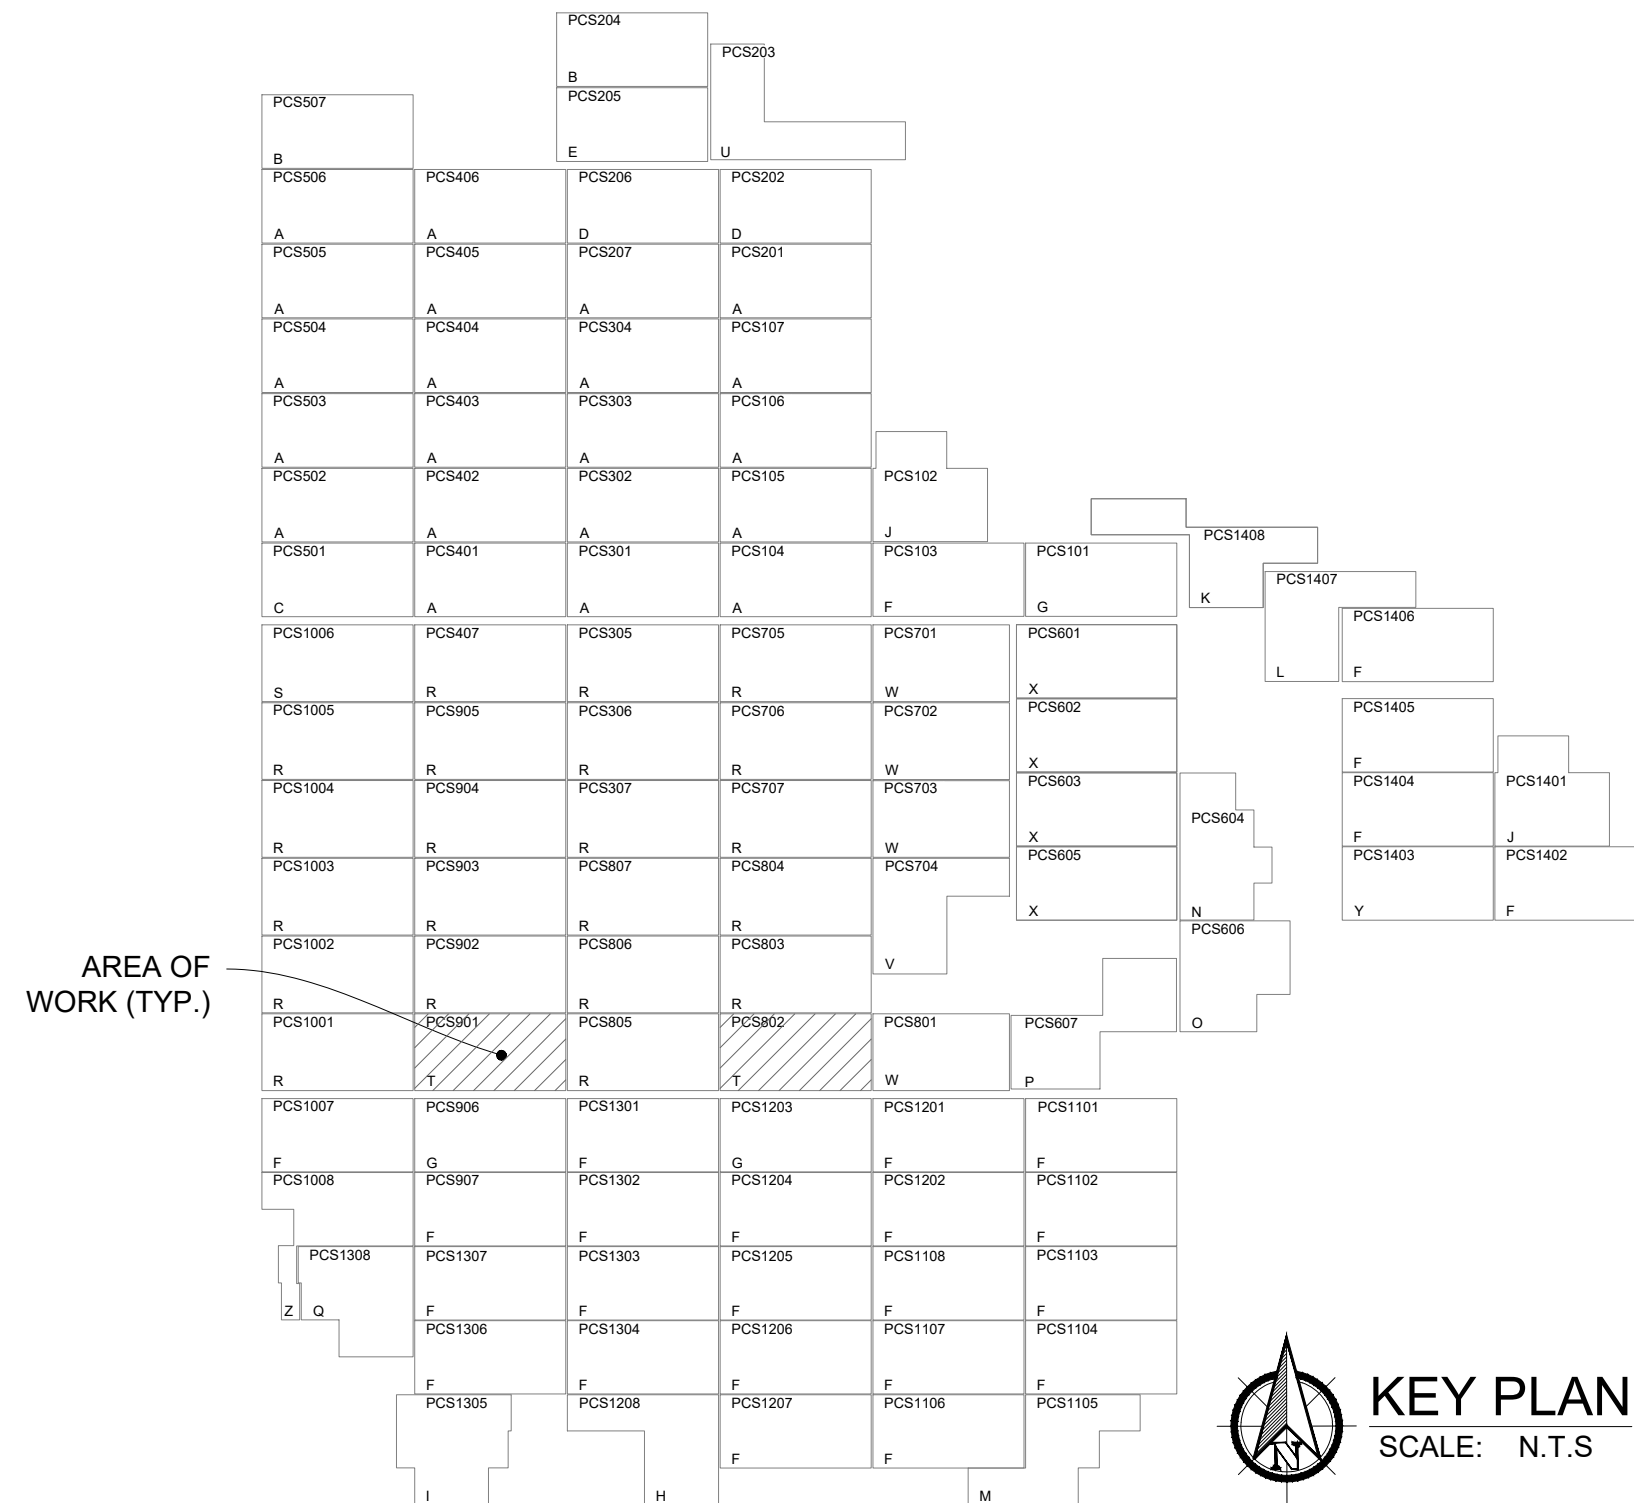

NOTES:

- DC FEEDER TAGS ARE SAME AS LBD TAGS EXCEPT SUBSTITUTING 'DF' IN PLACE OF 'LBD'.
- REFER TO SHEET E-005 - BLOCK SCHEDULE AND SHEET E-011 - MODULE ALLOCATION PLAN FOR SPECIFIC INFORMATION REGARDING MODULE QUANTITIES ASSOCIATED WITH PCS-SPECIFIC ARRAY TYPES.

LEGEND:

DF DC FEEDER

HANGER SYSTEM

ARRAY TYPE	ASSOCIATED PCS
A	PCS104 PCS105 PCS106 PCS107 PCS201 PCS207 PCS301 PCS302 PCS303 PCS304 PCS401 PCS402 PCS403 PCS404 PCS405 PCS406 PCS502 PCS503 PCS504 PCS505 PCS506
B	PCS204 PCS507
C	PCS501
D	PCS202 PCS206
E	PCS205
F	PCS103 PCS907 PCS1007 PCS1101 PCS1102 PCS1103 PCS1104 PCS1106 PCS1107 PCS1108 PCS1201 PCS1202 PCS1204 PCS1205 PCS1206 PCS1207 PCS1301 PCS1302 PCS1303 PCS1304 PCS1306 PCS1307 PCS1402 PCS1404 PCS1405 PCS1406
G	PCS101 PCS906 PCS1203
H	PCS1208
I	PCS1305
J	PCS102 PCS1401
K	PCS1408
L	PCS1407
M	PCS1105
N	PCS604
O	PCS606
P	PCS607
Q	PCS1308
R	PCS305 PCS306 PCS307 PCS407 PCS705 PCS706 PCS707 PCS803 PCS804 PCS805 PCS806 PCS807 PCS902 PCS903 PCS904 PCS905 PCS1001 PCS1002 PCS1003 PCS1004 PCS1005
S	PCS1006
T	PCS802 PCS901
U	PCS203
V	PCS704
W	PCS701 PCS702 PCS703 PCS801
X	PCS601 PCS602 PCS603 PCS605
Y	PCS1403
Z	PCS1008



REV	DESCRIPTION	DATE
4	RECORD DRAWINGS	06/08/2023

PROJECT NAME:
**EAGLE SHADOW MOUNTAIN
PV SOLAR POWER
GENERATION FACILITY**

PROJECT ADDRESS:
**I-15
CRYSTAL, NV
CLARK COUNTY**

SEAL: DATE: **10/16/2020**
PROJECT #:
190067.03
DRAWN BY:
NK
CHECKED BY:
EL

SHEET NAME:
DC PLAN - ARRAY TYPE T (CS)

SHEET #: **E-420** REV #: **4**

RECORD DRAWING




KEY PLAN
SCALE: N.T.S.

PLOT DATE: Thursday, June 08, 2023

SAVED BY: EridLoos

LOCATION: K:_09 PROJECTS\190067.03 - PRIMORS - EAGLE SHADOW MOUNTAIN\05 ENGINEERING\DWG\E-420 DC PLAN - ARRAY TYPE T (CS)

1 LBD LAYOUT DETAIL

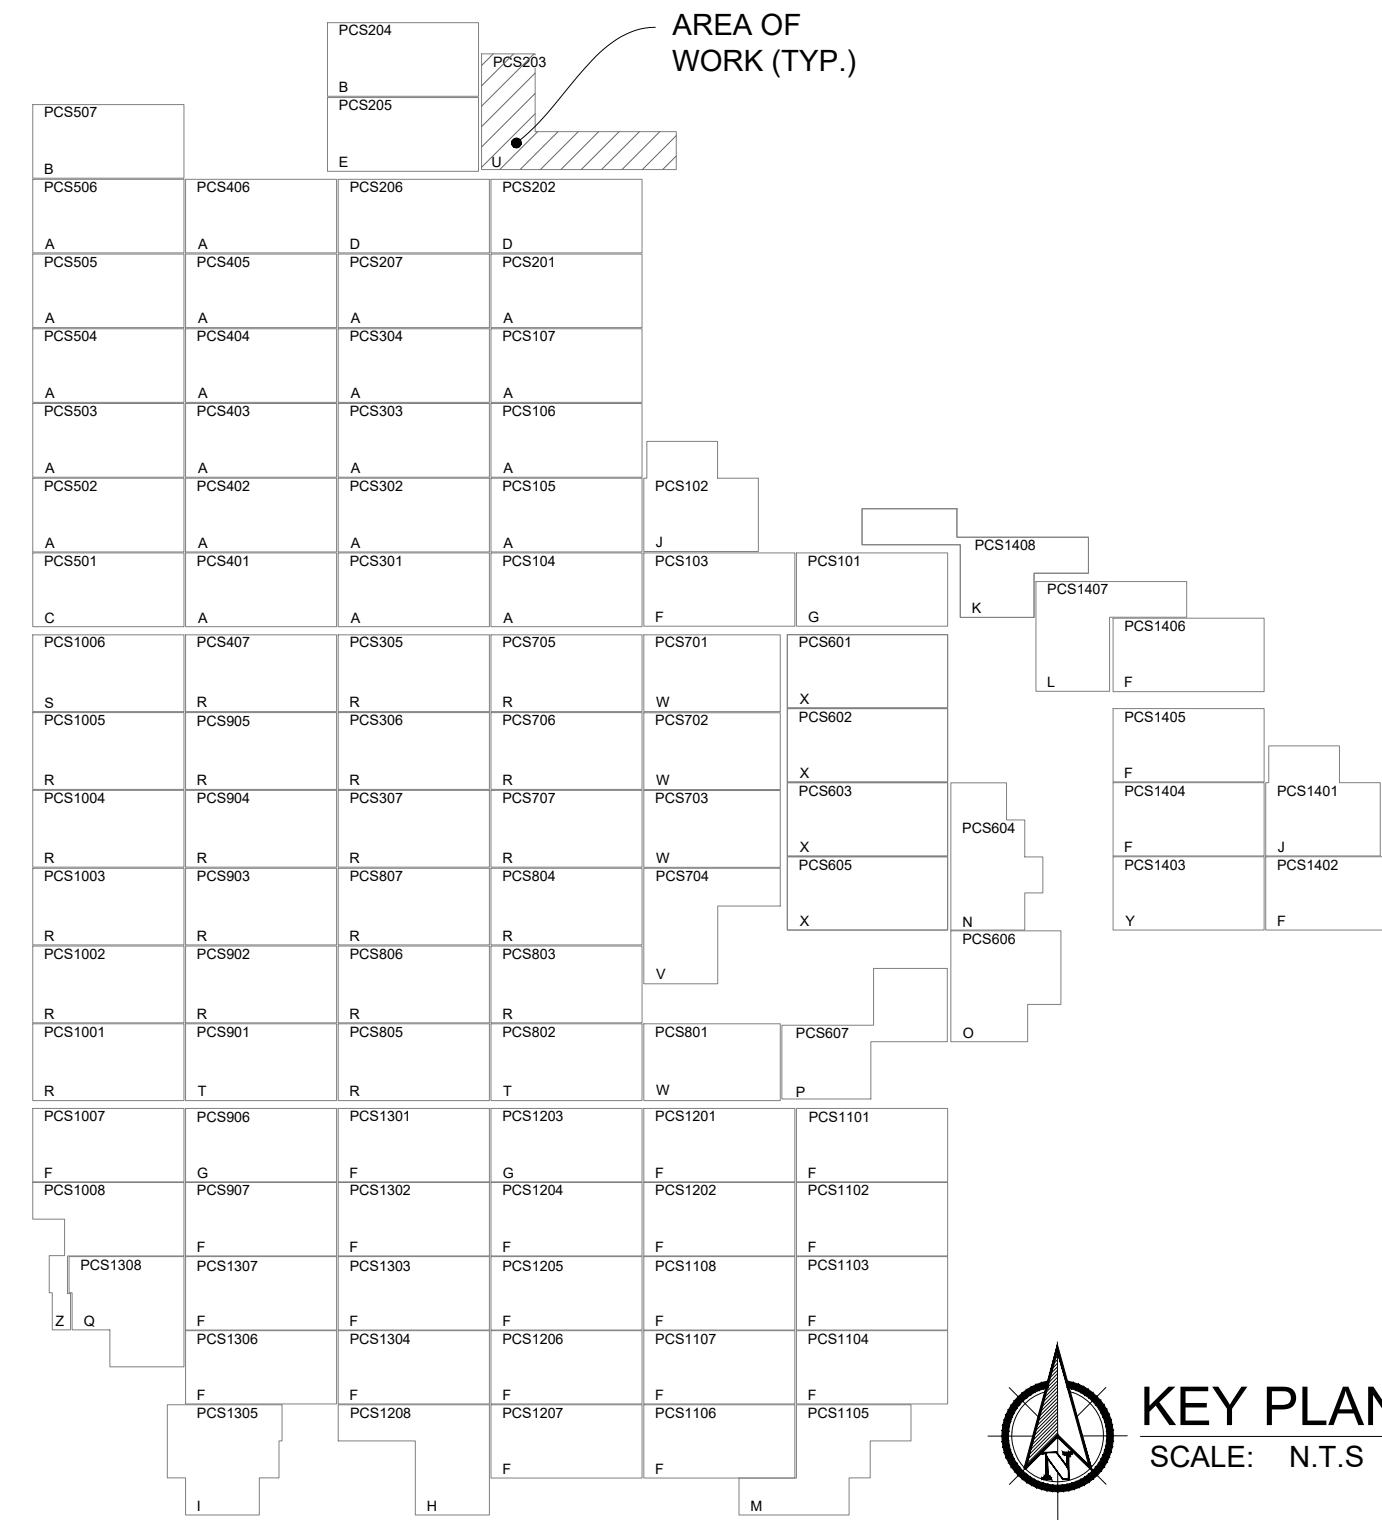

NOTES:

1. DC FEEDER TAGS ARE SAME AS LBD TAGS EXCEPT SUBSTITUTING 'DF' IN PLACE OF 'LBD'.
2. REFER TO SHEET E-005 - BLOCK SCHEDULE AND SHEET E-011 - MODULE ALLOCATION PLAN FOR SPECIFIC INFORMATION REGARDING MODULE QUANTITIES ASSOCIATED WITH PCS-SPECIFIC ARRAY TYPES.

LEGEND:

_____ DF _____ DC FEEDER



HANGER SYSTEM

ARRAY TYPE	ASSOCIATED PCS
A	PCS104 PCS105 PCS106 PCS107 PCS201 PCS207 PCS301 PCS302 PCS303 PCS304 PCS401 PCS402 PCS403 PCS404 PCS405 PCS406 PCS502 PCS503 PCS504 PCS505 PCS506
	PCS204 PCS507
	PCS501
	PCS202 PCS3206
E	PCS205
F	PCS1103 PCS907 PCS11007 PCS1101 PCS1102 PCS1103 PCS1104 PCS1106 PCS1107 PCS1108 PCS1201 PCS1202 PCS1204 PCS1205 PCS1206 PCS1207 PCS1301 PCS1302 PCS1303 PCS1304 PCS1306 PCS1307 PCS1402 PCS1404 PCS1405 PCS1406
	PCS101 PCS906 PCS1203
	PCS1208
	PCS1305
J	PCS102 PCS1401
K	PCS1408
L	PCS1407
M	PCS1105
N	PCS604
O	PCS606
P	PCS607
Q	PCS1308
R	PCS305 PCS306 PCS307 PCS407 PCS705 PCS706 PCS707 PCS803 PCS804 PCS805 PCS806 PCS807 PCS902 PCS903 PCS904 PCS905 PCS1001 PCS1002 PCS1003 PCS1004 PCS1005
	PCS1006
	PCS802 PCS901
	PCS203
V	PCS704
W	PCS701 PCS702 PCS703 PCS801
X	PCS601 PCS602 PCS603 PCS605
Y	PCS1403
Z	PCS1008




KEY PLAN
SCALE: N.T.S



DC PLAN - ARRAY TYPE - U (CS)




SCALE: 1"=70'

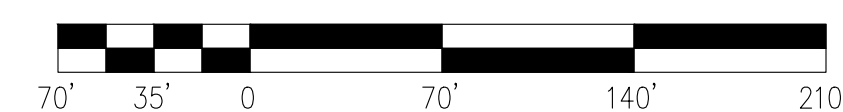

SCALE: 1"=70'



CAB MESSENGER
SUPPORT SYSTEM
REFER TO E-492
(TYP)

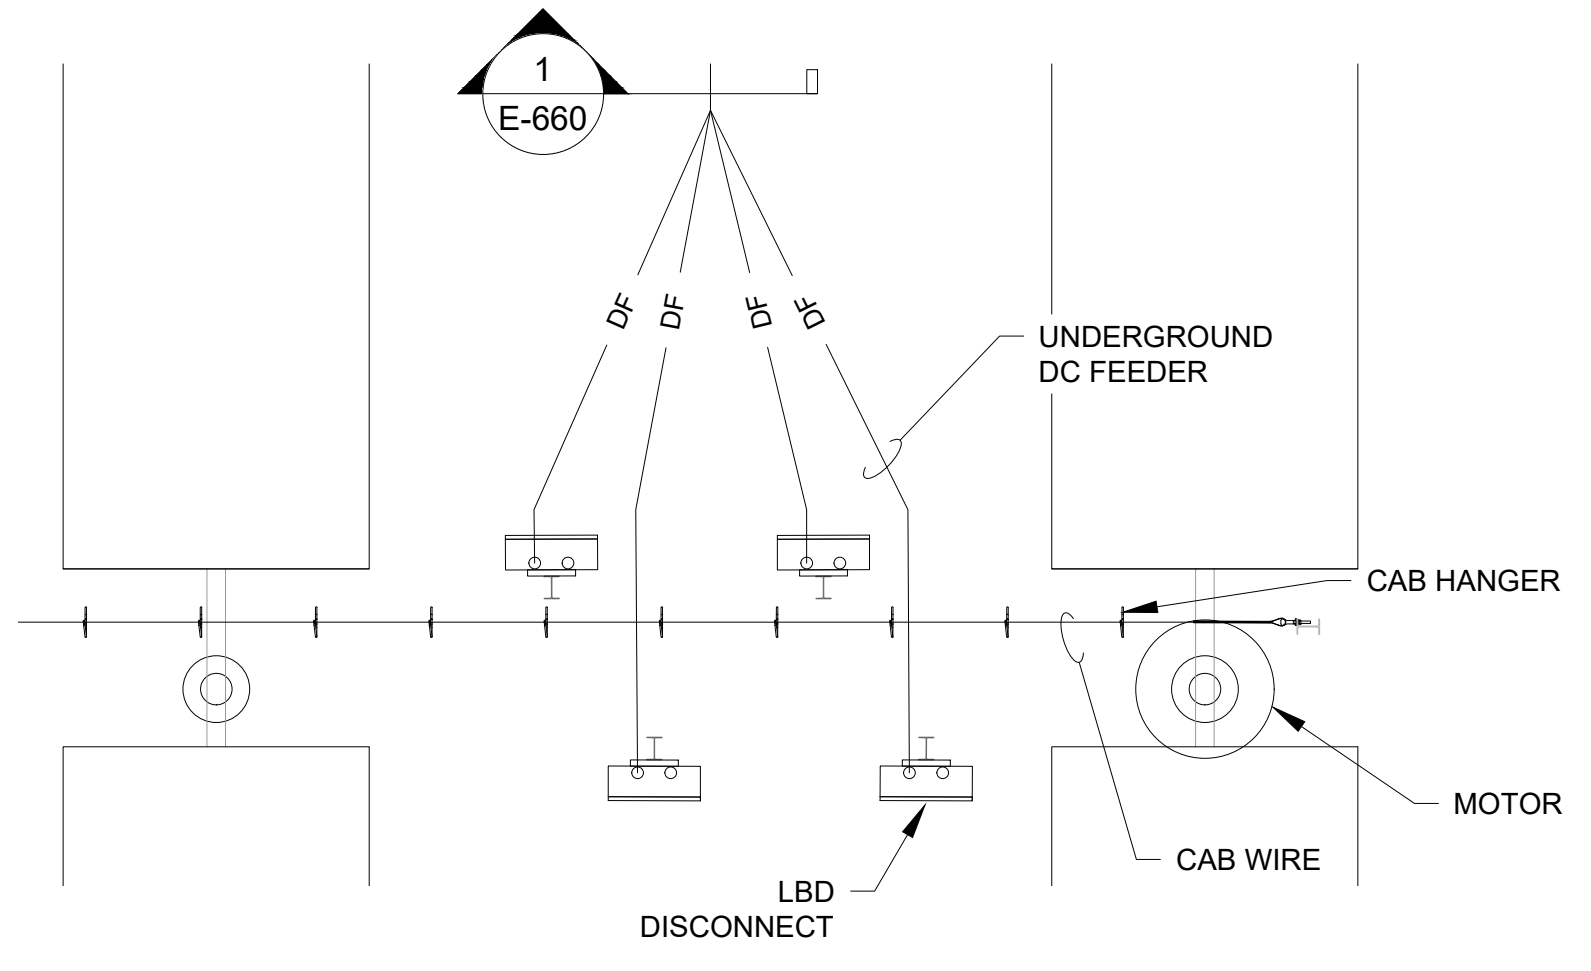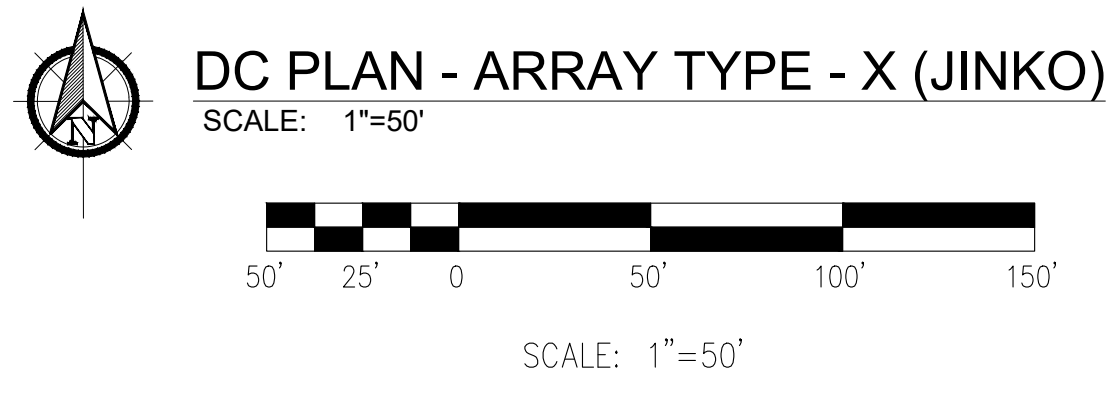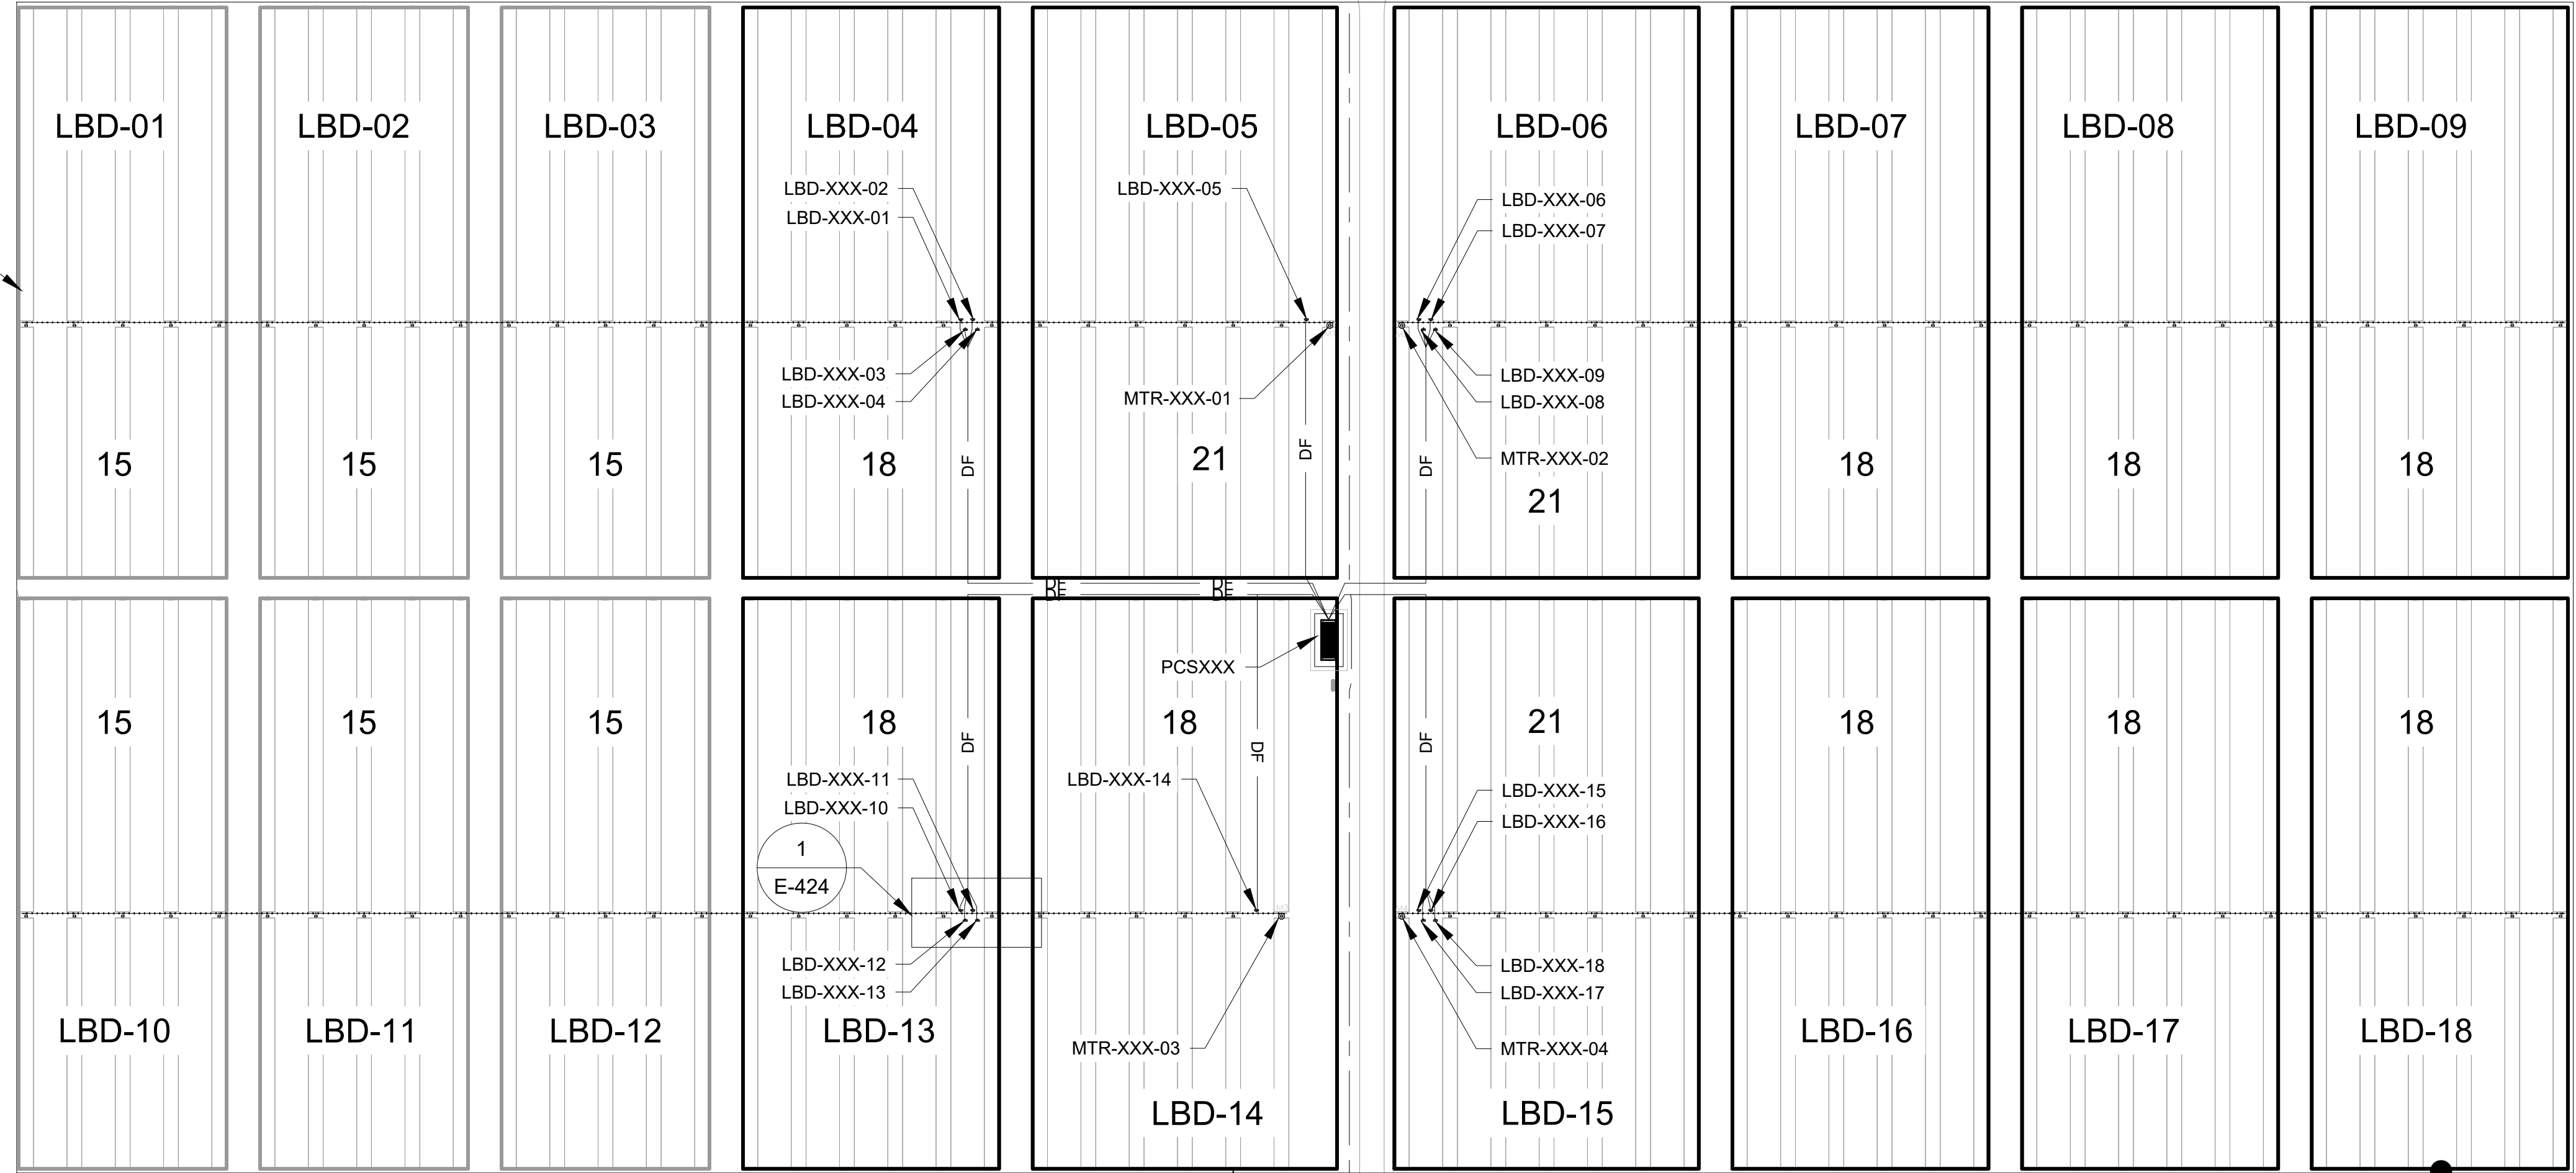

1 LBD LAYOUT DETAIL


- NOTES:
- DC FEEDER TAGS ARE SAME AS LBD TAGS EXCEPT SUBSTITUTING 'DF' IN PLACE OF 'LBD'.
 - REFER TO SHEET E-005 - BLOCK SCHEDULE AND SHEET E-011 - MODULE ALLOCATION PLAN FOR SPECIFIC INFORMATION REGARDING MODULE QUANTITIES ASSOCIATED WITH PCS-SPECIFIC ARRAY TYPES.

LEGEND:

— DF — DC FEEDER

— | — HANGER SYSTEM

ARRAY TYPE	ASSOCIATED PCS
A	PCS104 PCS105 PCS106 PCS107 PCS201 PCS207 PCS301 PCS302 PCS303 PCS304 PCS401 PCS402 PCS403 PCS404 PCS405 PCS406 PCS502 PCS503 PCS504 PCS505 PCS506
B	PCS204 PCS507
C	PCS501
D	PCS202 PCS206
E	PCS205
F	PCS103 PCS907 PCS1007 PCS1101 PCS1102 PCS1103 PCS1104 PCS1106 PCS1107 PCS1108 PCS1201 PCS1202 PCS1204 PCS1205 PCS1206 PCS1207 PCS1301 PCS1302 PCS1303 PCS1304 PCS1306 PCS1307 PCS1402 PCS1404 PCS1405 PCS1406
G	PCS101 PCS906 PCS1203
H	PCS1208
I	PCS1305
J	PCS102 PCS1401
K	PCS1408
L	PCS1407
M	PCS1105
N	PCS604
O	PCS606
P	PCS607
Q	PCS1308
R	PCS305 PCS306 PCS307 PCS407 PCS705 PCS706 PCS707 PCS803 PCS804 PCS805 PCS806 PCS807 PCS902 PCS903 PCS904 PCS905 PCS1001 PCS1002 PCS1003 PCS1004 PCS1005
S	PCS1006
T	PCS802 PCS901
U	PCS203
V	PCS704
W	PCS701 PCS702 PCS703 PCS801
X	PCS601 PCS602 PCS603 PCS605
Y	PCS1403
Z	PCS1008

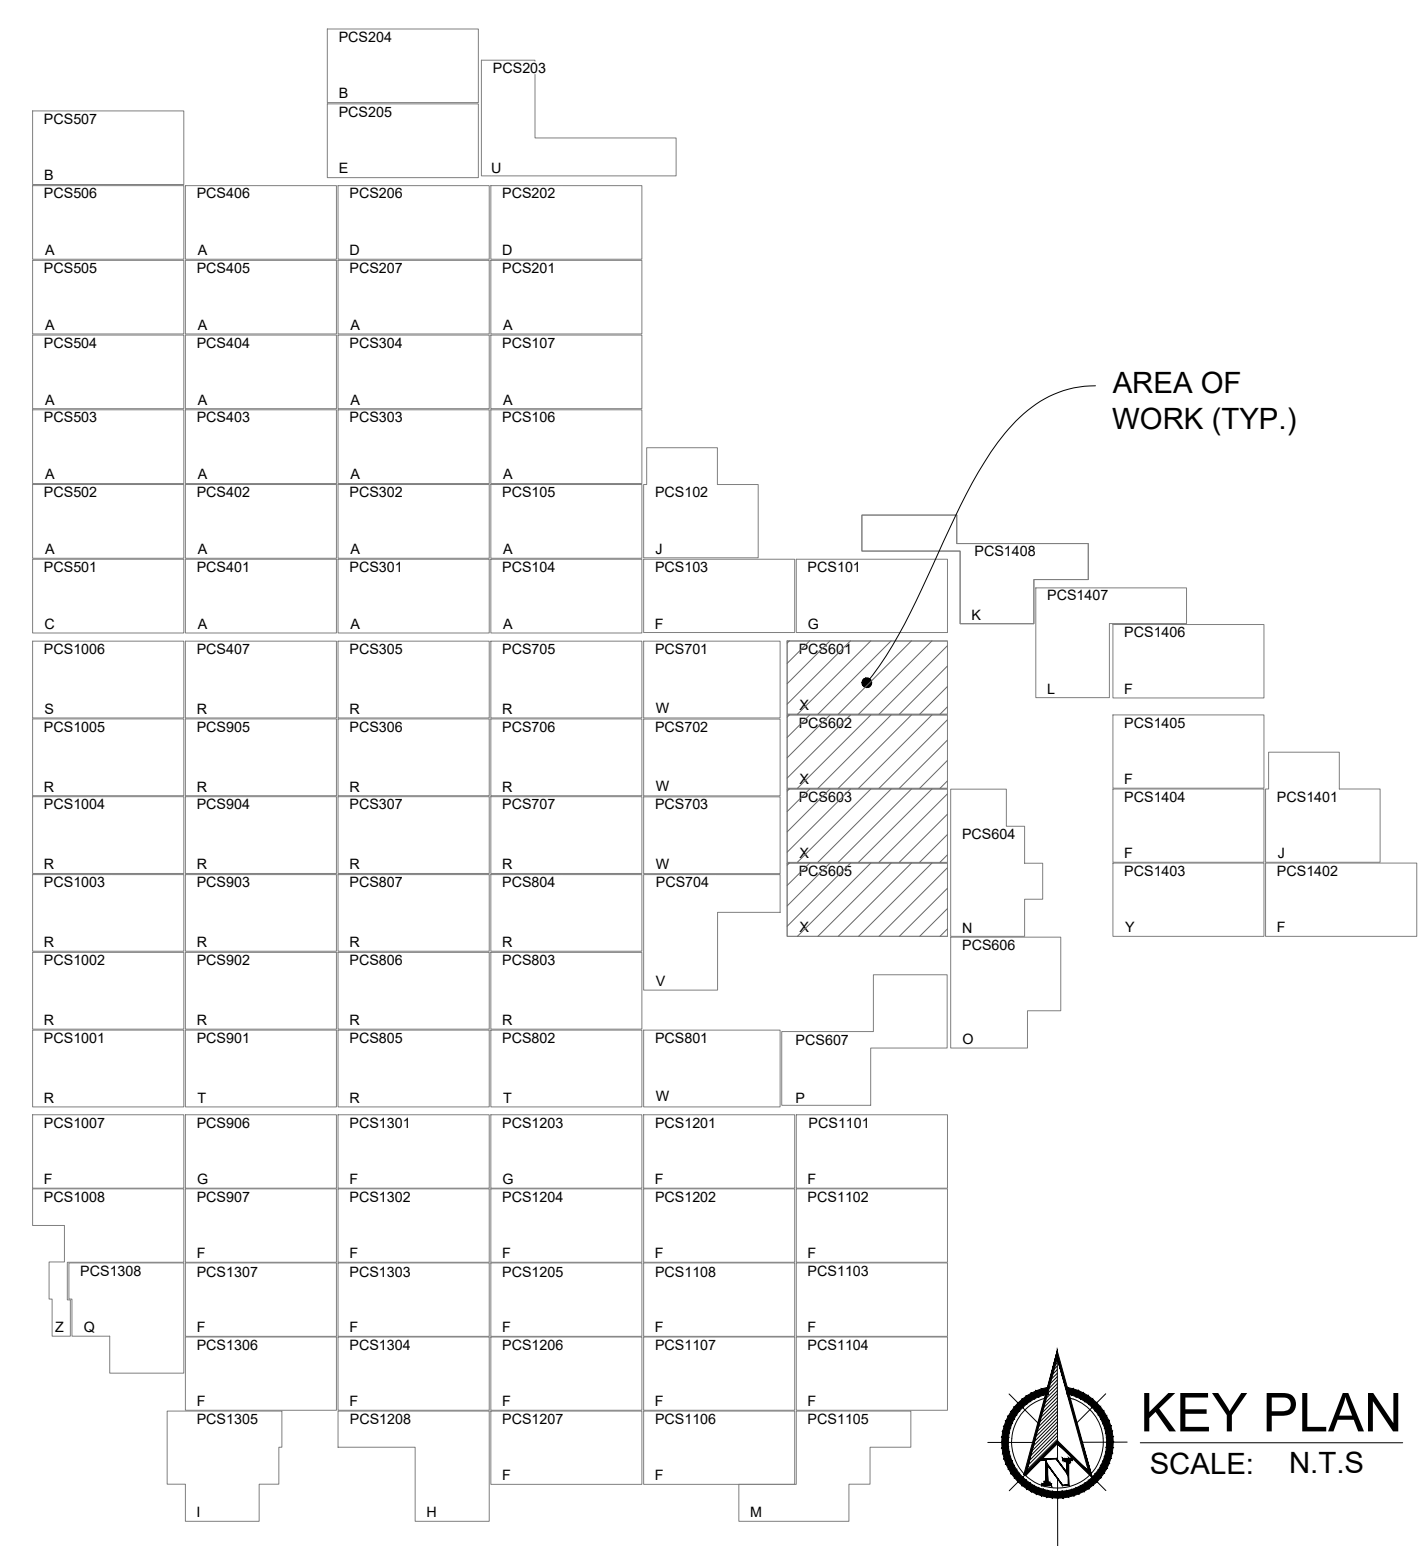

FastGrid

FastGrid, LLC
225 E Germann Road
Suite 301
Gilbert, AZ 85297

REV	DESCRIPTION	DATE
4	RECORD DRAWINGS	06/08/2023

PROJECT NAME:
EAGLE SHADOW MOUNTAIN
PV SOLAR POWER
GENERATION FACILITY

PROJECT ADDRESS:
I-15
CRYSTAL, NV
CLARK COUNTY

SEAL:

DATE:
10/16/2020

PROJECT #:
190067.03

DRAWN BY:
NK



CHECKED BY:
EL

SHEET NAME:
DC PLAN - ARRAY TYPE X (JINKO)


SHEET #:
E-424


REV #:
4


RECORD DRAWING

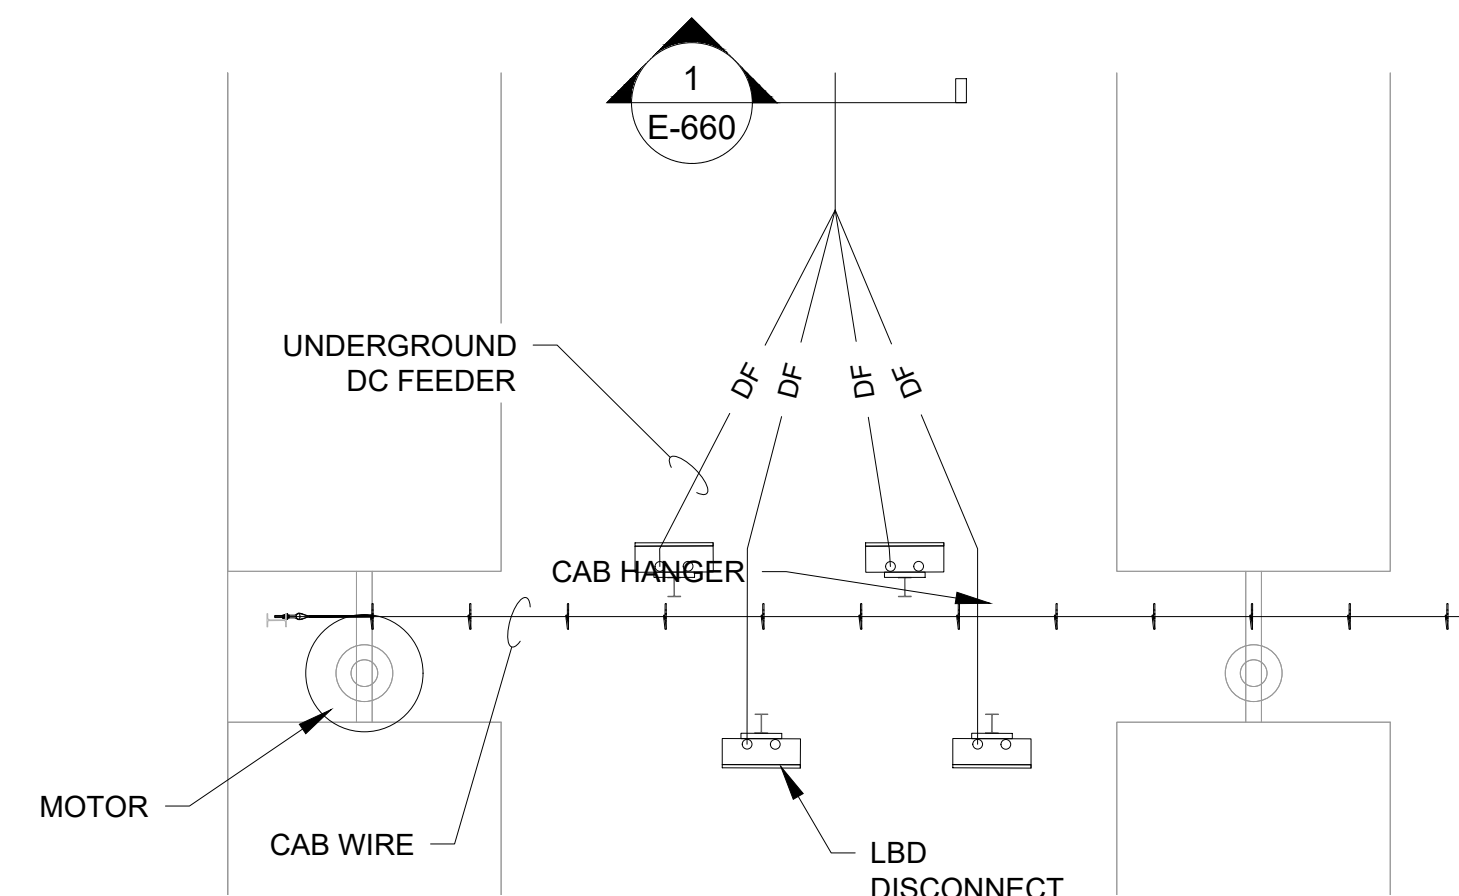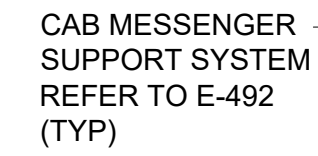


1 LBD LAYOUT DETAIL

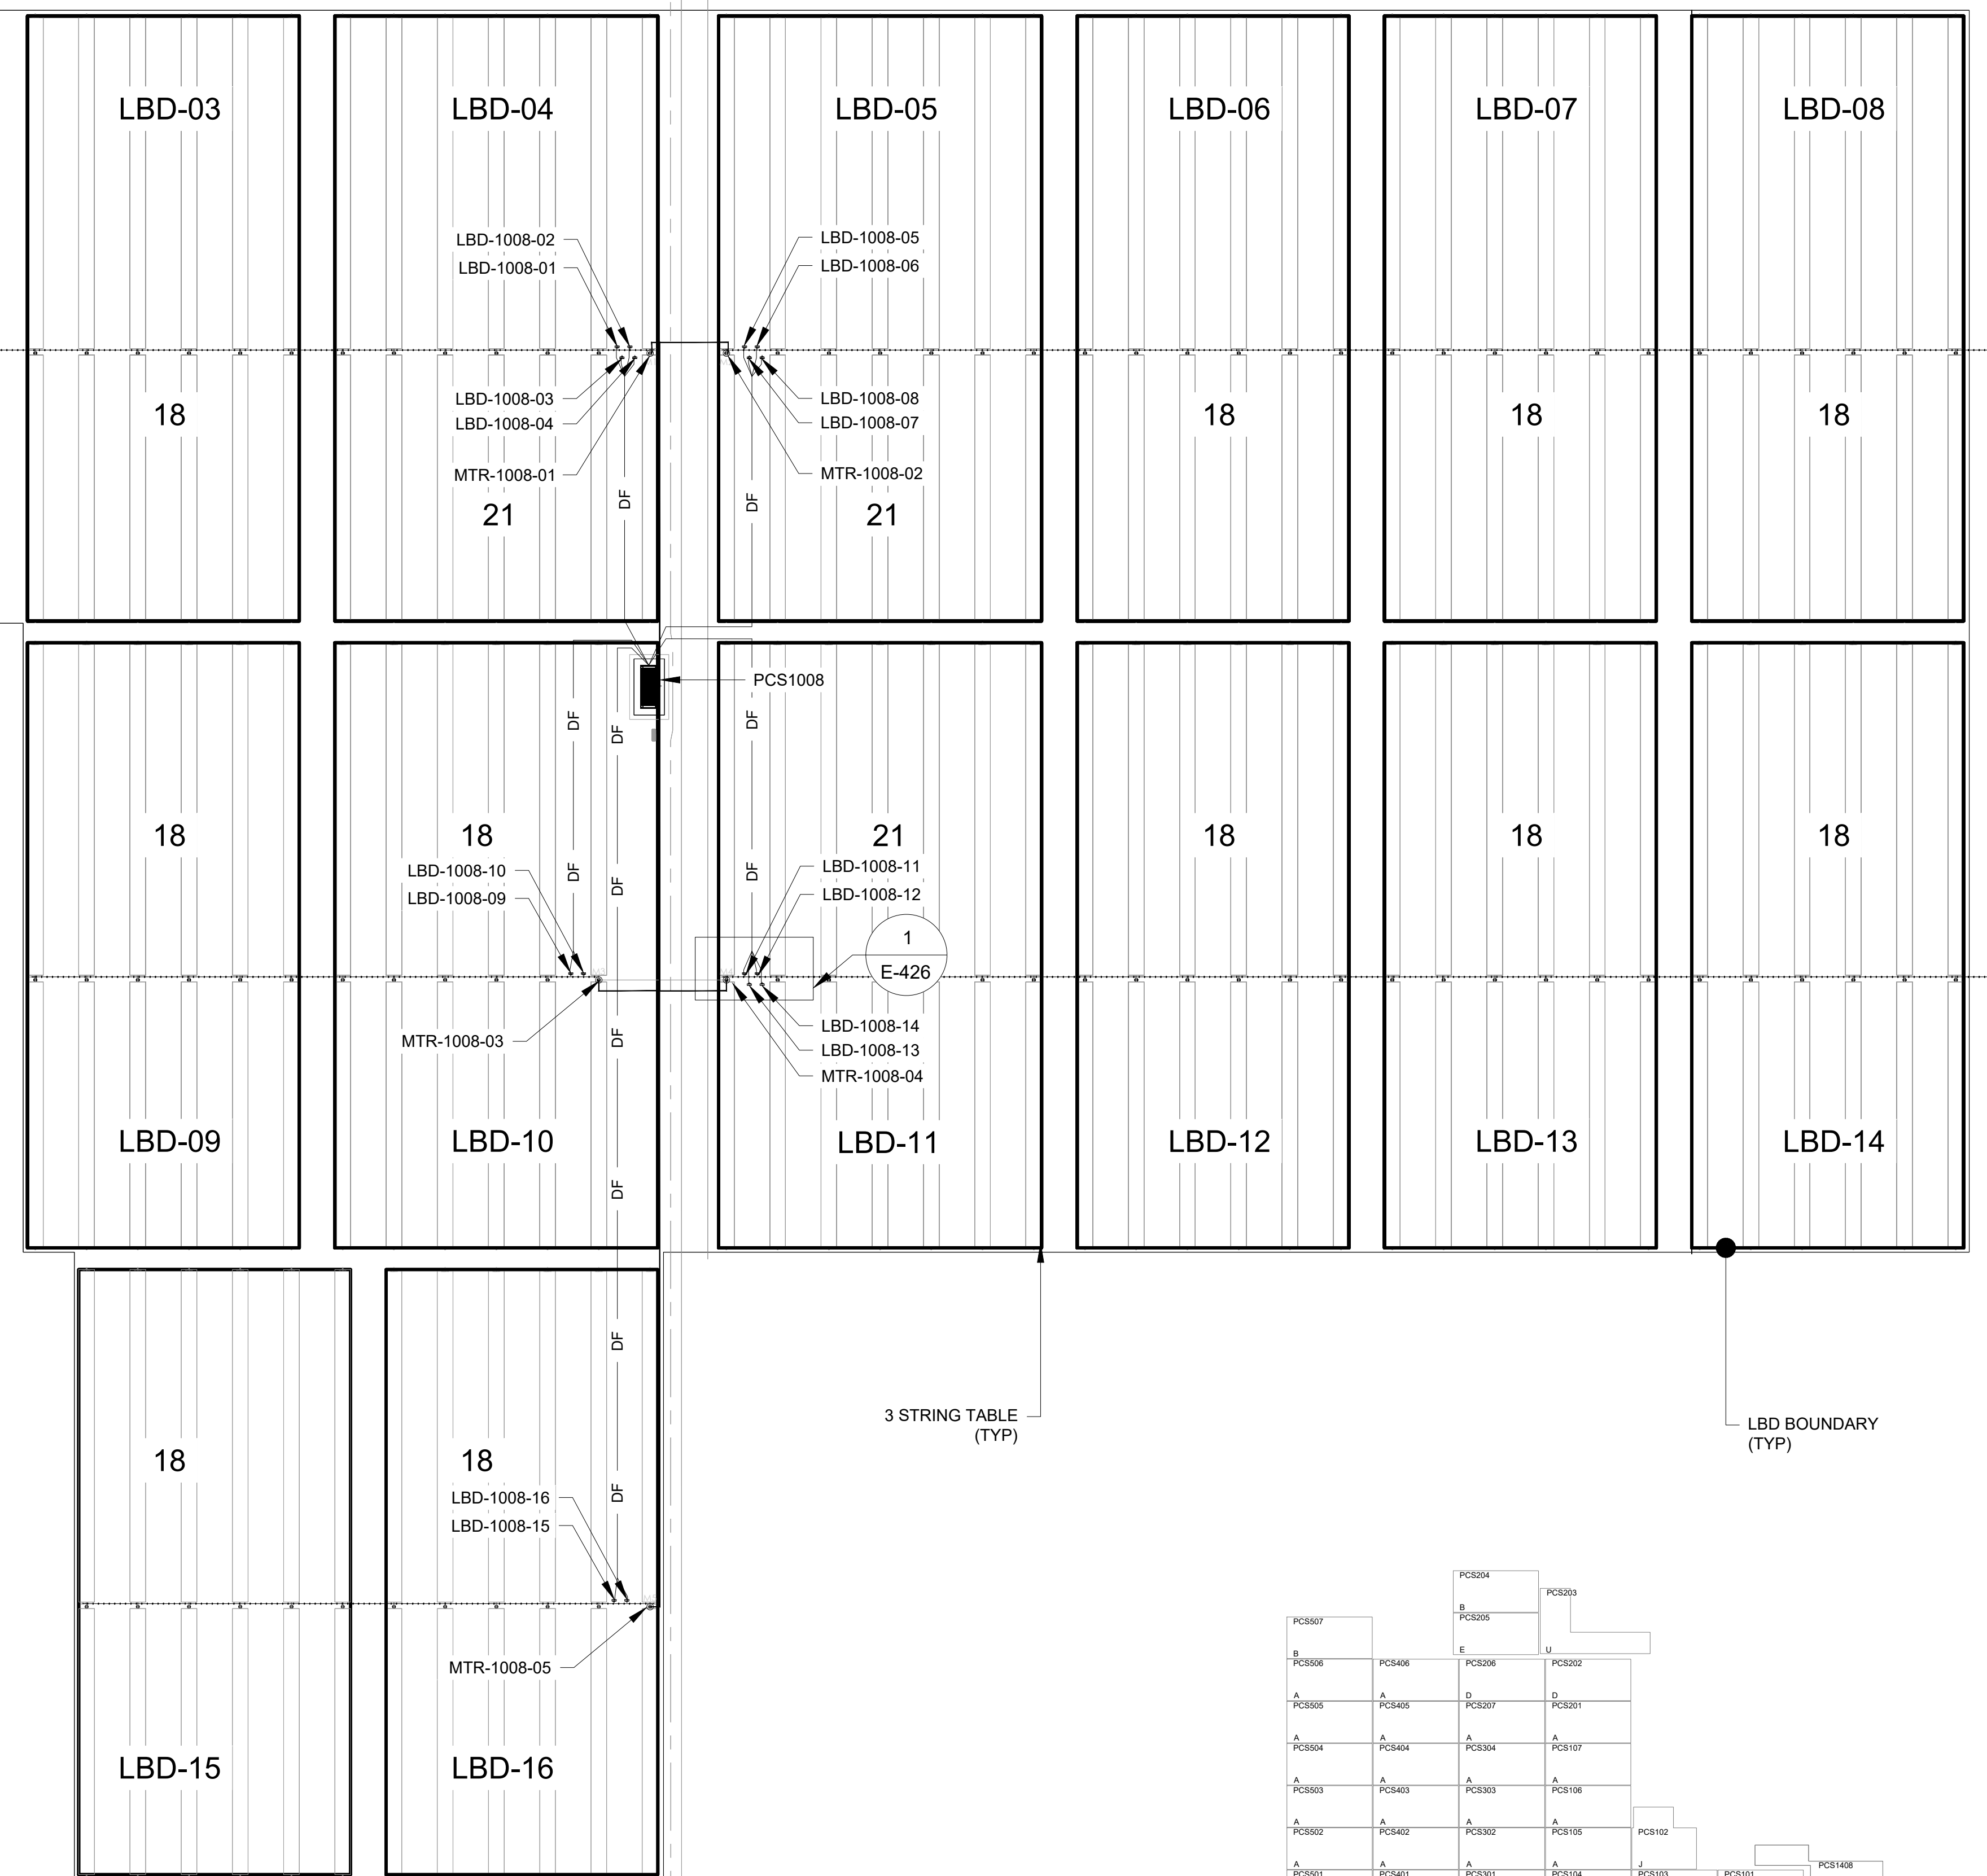

 **DC PLAN - ARRAY TYPE - Z (JINKO)**
SCALE: 1"=50'

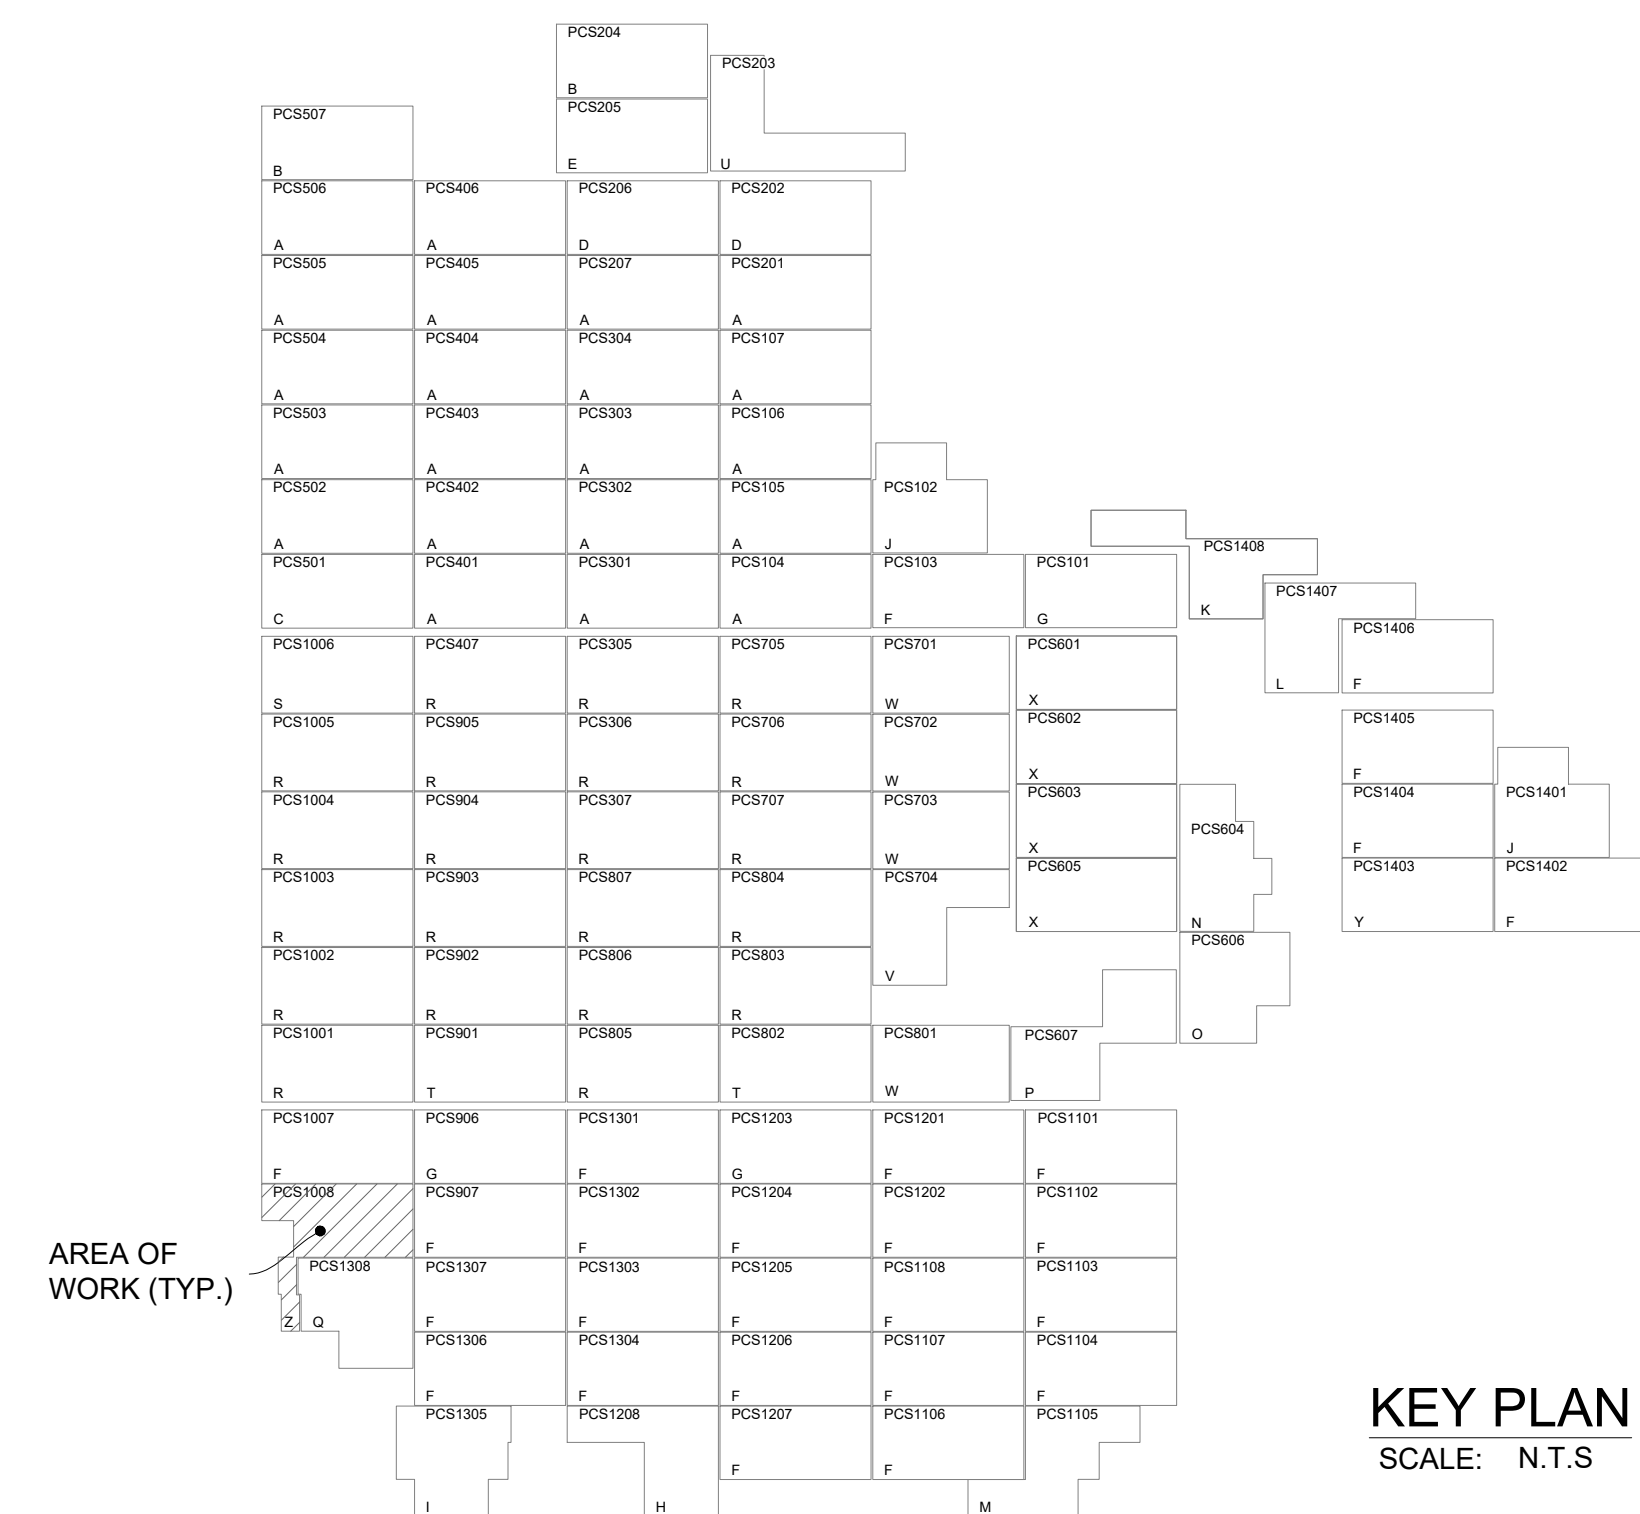


SCALE: 1"=50'



- NOTES:


1. DC FEEDER TAGS ARE SAME AS LBD TAGS EXCEPT SUBSTITUTING 'DF' IN PLACE OF 'LBD'.
2. REFER TO SHEET E-005 - BLOCK SCHEDULE AND SHEET E-011 - MODULE ALLOCATION PLAN FOR SPECIFIC INFORMATION REGARDING MODULE QUANTITIES ASSOCIATED WITH PCS-SPECIFIC ARRAY TYPES.

LEGEND:

DC FEEDER
 HANGER SYSTEM

ARRAY TYPE	ASSOCIATED PCS
A	PCS104 PCS105 PCS106 PCS107 PCS201 PCS207 PCS301 PCS302 PCS303 PCS304 PCS401 PCS402 PCS403 PCS404 PCS405 PCS406 PCS502 PCS503 PCS504 PCS505 PCS506
	PCS204 PCS507
	PCS501
	PCS202 PCS206
E	PCS205
F	PCS103 PCS907 PCS1007 PCS1101 PCS1102 PCS1103 PCS1104 PCS1106 PCS1107 PCS1108 PCS1201 PCS1202 PCS1204 PCS1205 PCS1206 PCS1207 PCS1301 PCS1302 PCS1303 PCS1304 PCS1306 PCS1307 PCS1402 PCS1404 PCS1405 PCS1406
	PCS101 PCS906 PCS1203
	PCS1208
	PCS1305
J	PCS102 PCS1401
K	PCS1408
L	PCS1407
M	PCS1105
N	PCS604
O	PCS606
P	PCS607
Q	PCS1308
R	PCS305 PCS306 PCS307 PCS407 PCS705 PCS706 PCS707 PCS803 PCS804 PCS805 PCS806 PCS807 PCS902 PCS903 PCS904 PCS905 PCS1001 PCS1002 PCS1003 PCS1004 PCS1005
	PCS1006
	PCS802 PCS901
	PCS203
V	PCS704
W	PCS701 PCS702 PCS703 PCS801
X	PCS601 PCS602 PCS603 PCS605
Y	PCS1403
Z	PCS1008



 FastGrid		FastGrid, LLC 225 E Germann Road Suite 301 Gilbert, AZ 85297	
REV	DESCRIPTION	DATE	
4	RECORD DRAWINGS	06/08/2023	

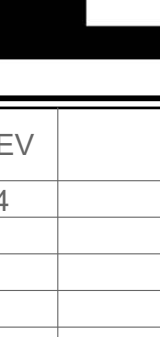PROJECT NAME: <div style="text-align: center; font-size: 1.2em; font-weight: bold; margin-top: 10px;"> EAGLE SHADOW MOUNTAIN PV SOLAR POWER GENERATION FACILITY </div>	
PROJECT ADDRESS: <div style="text-align: center; font-size: 1.2em; font-weight: bold; margin-top: 10px;"> I-15 CRYSTAL, NV CLARK COUNTY </div>	



SEAL:	<table border="1" style="width: 100%; border-collapse: collapse;"> <tr> <td style="padding: 5px;">DATE:</td> <td style="text-align: center; font-size: 1.1em;">10/16/2020</td> </tr> <tr> <td style="padding: 5px;">PROJECT #:</td> <td style="text-align: center; font-size: 1.1em;">190067.03</td> </tr> <tr> <td style="padding: 5px;">DRAWN BY:</td> <td style="text-align: center;">LR</td> </tr> <tr> <td style="padding: 5px;">CHECKED BY:</td> <td style="text-align: center;">EL</td> </tr> </table>	DATE:	10/16/2020	PROJECT #:	190067.03	DRAWN BY:	LR	CHECKED BY:	EL
DATE:	10/16/2020								
PROJECT #:	190067.03								
DRAWN BY:	LR								
CHECKED BY:	EL								

SHEET NAME: <div style="text-align: center; font-size: 1.2em; font-weight: bold; margin-top: 10px;"> DC PLAN - ARRAY TYPE Z (JINKO) </div>
--

SHEET #: <div style="text-align: center; font-size: 1.2em; font-weight: bold; margin-top: 10px;"> E-426 </div>	REV #: <div style="text-align: center; font-size: 1.2em; font-weight: bold; margin-top: 10px;"> 4 </div>
---	---

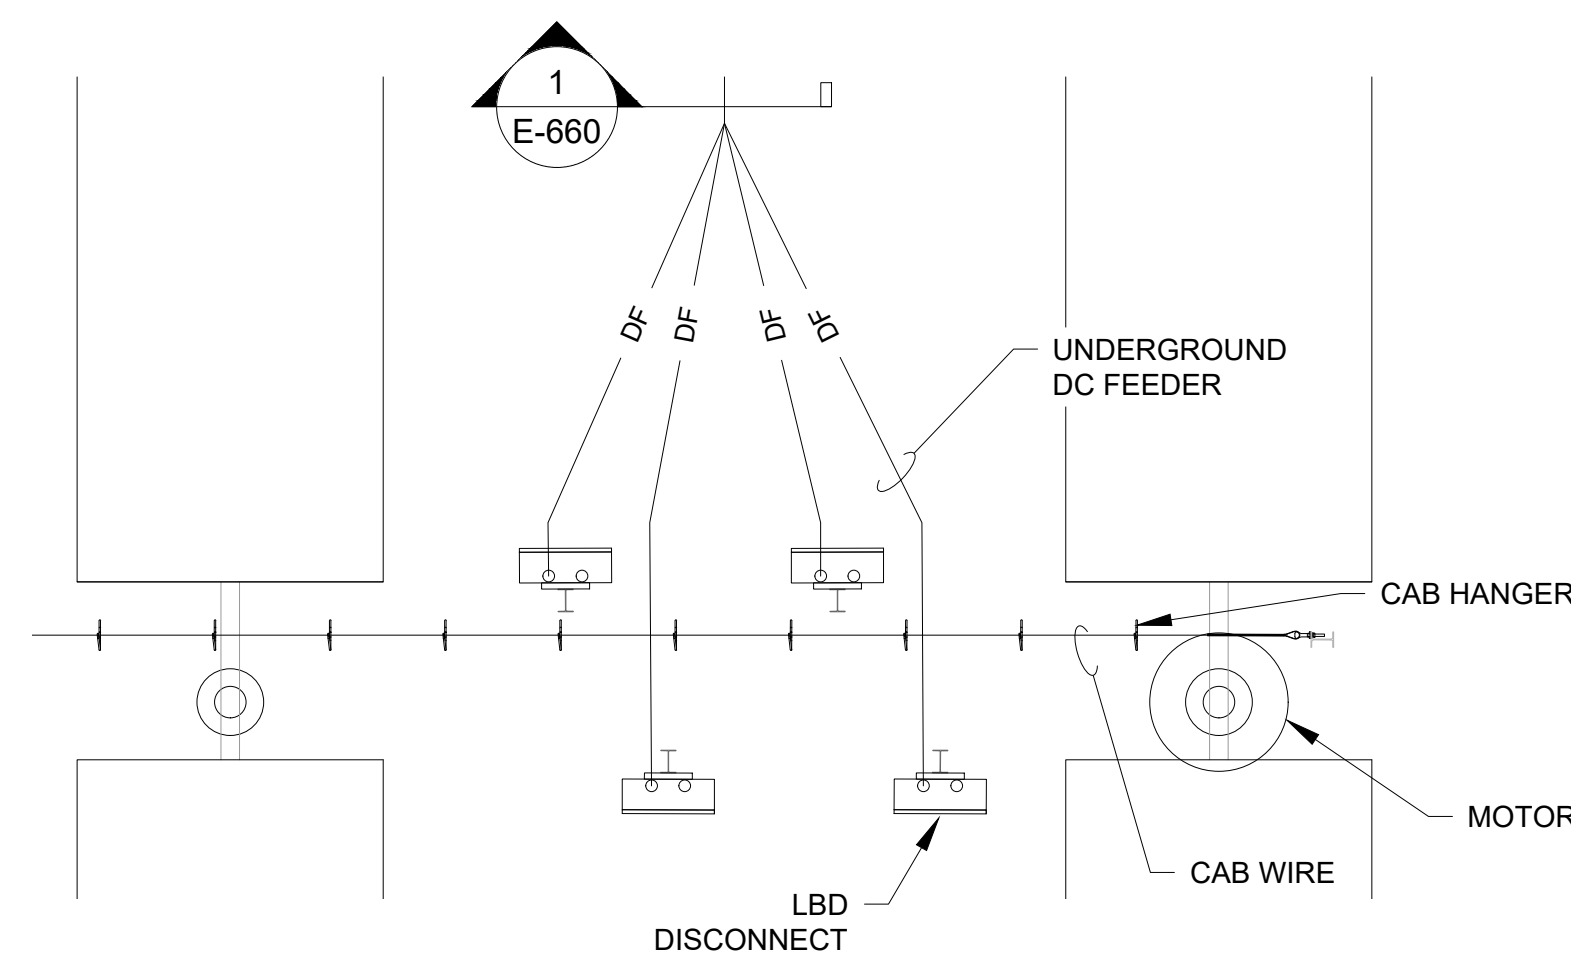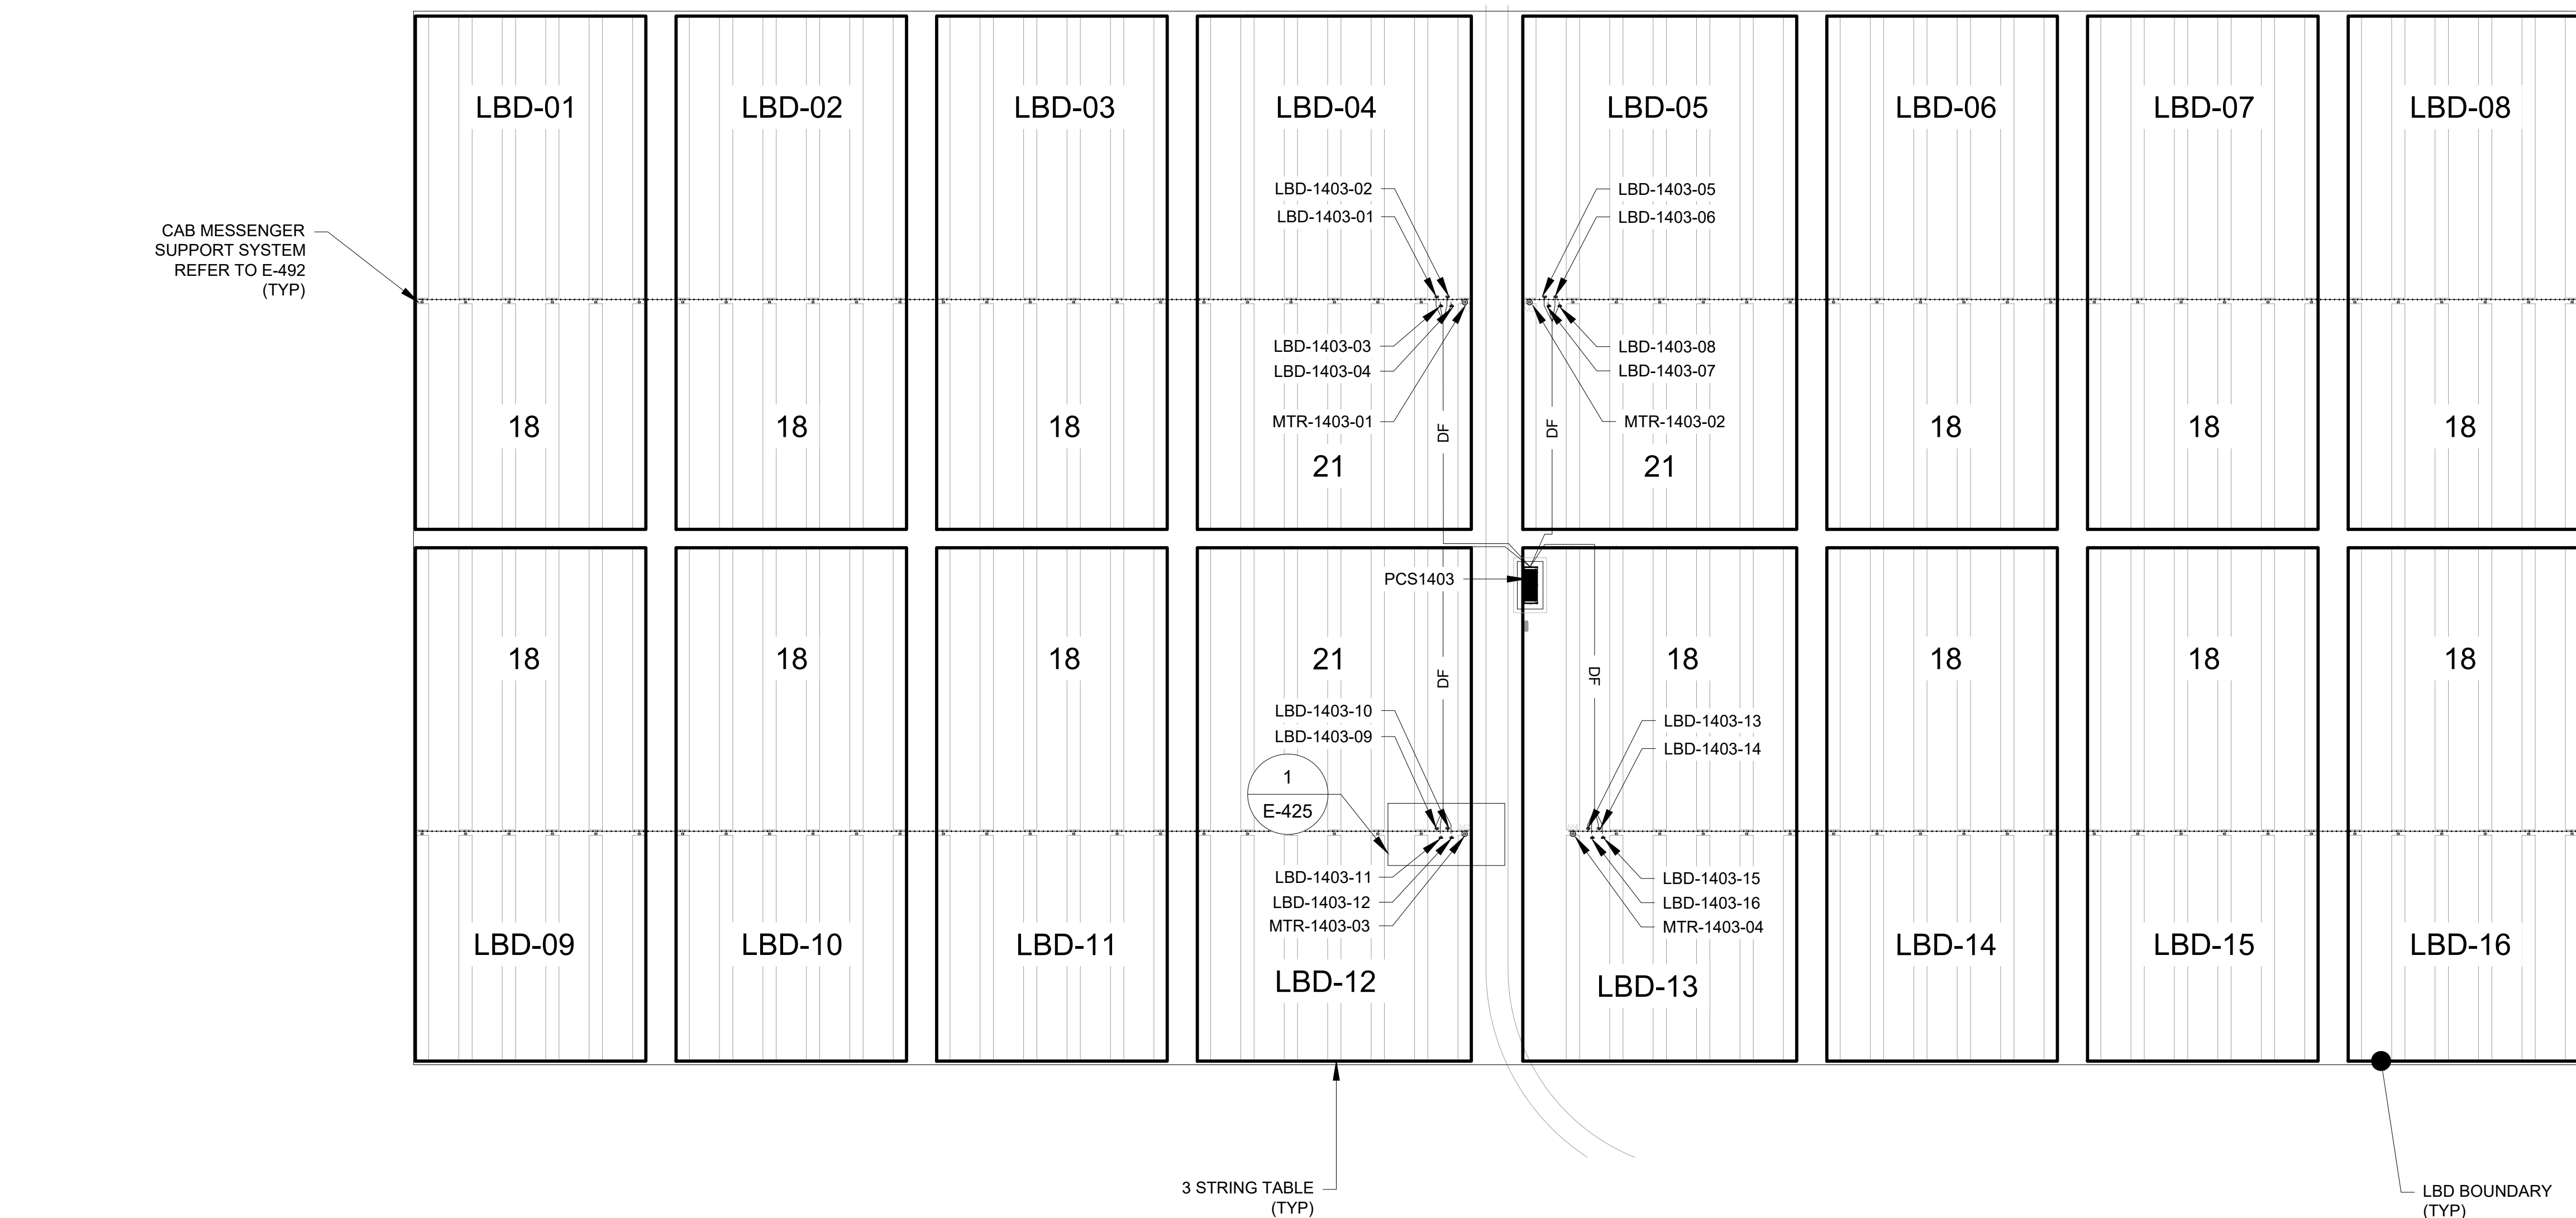

1 LBD LAYOUT DETAIL

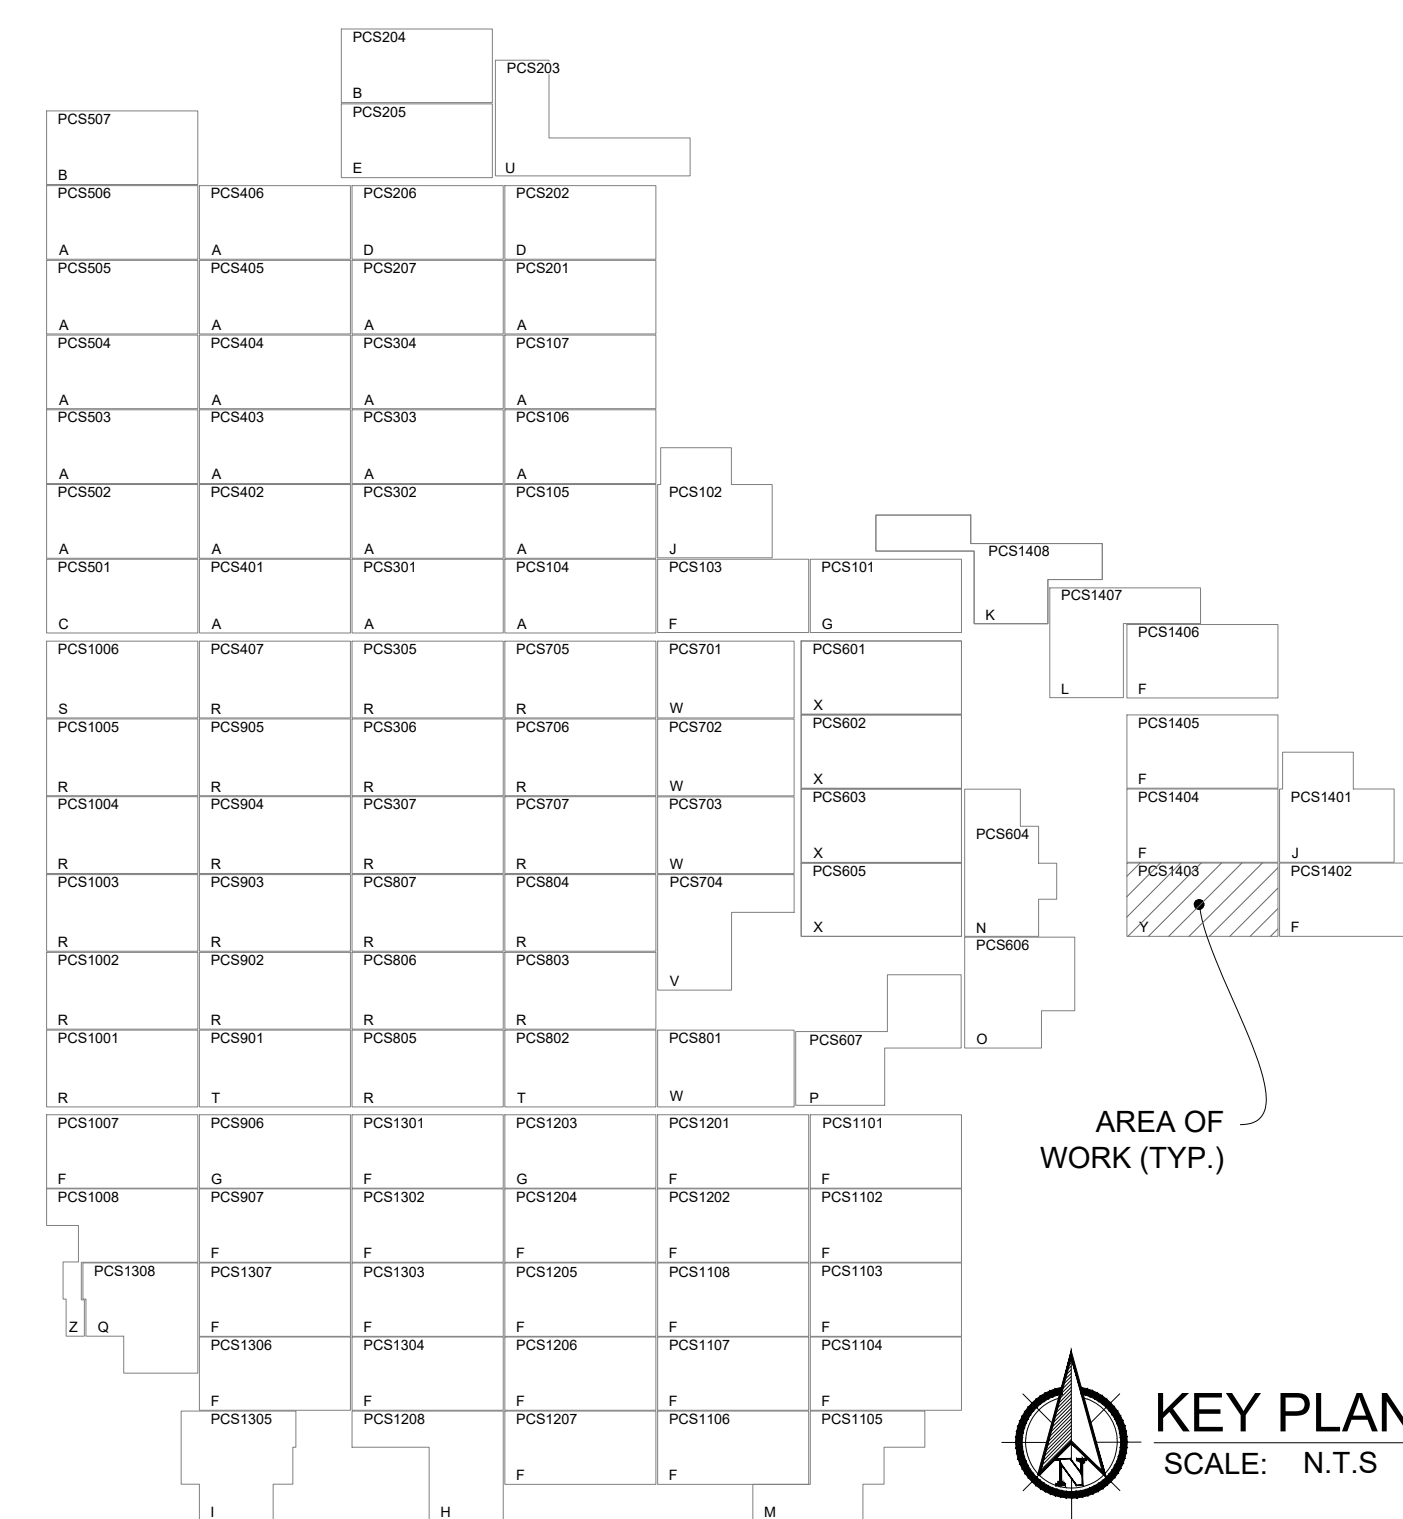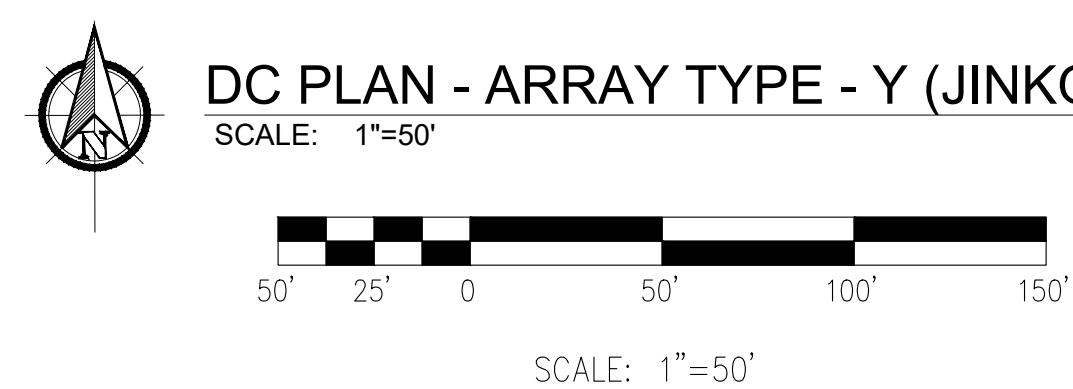

KEY PLAN
SCALE: N.T.S

NOTES:


1. DC FEEDER TAGS ARE SAME AS LBD TAGS EXCEPT SUBSTITUTING 'D' IN PLACE OF 'LBD'.
2. REFER TO SHEET E-005 - BLOCK SCHEDULE AND SHEET E-011 - MODULE ALLOCATION PLAN FOR SPECIFIC INFORMATION REGARDING MODULE QUANTITIES ASSOCIATED WITH PCS-SPECIFIC ARRAY TYPES.

LEGEND:

— DF — DC FEEDER

— CAB SYSTEM

ARRAY TYPE	ASSOCIATED PCS
A	PCS104 PCS105 PCS106 PCS107 PCS201 PCS207 PCS301 PCS302 PCS303 PCS304 PCS401 PCS402 PCS403 PCS404 PCS405 PCS406 PCS502 PCS503 PCS504 PCS505 PCS506
B	PCS204 PCS3507
C	PCS501
D	PCS202 PCS3206
E	PCS205
F	PCS103 PCS3907 PCS1007 PCS1101 PCS1102 PCS1103 PCS1104 PCS1106 PCS1107 PCS1108 PCS1201 PCS1202 PCS1204 PCS1205 PCS1206 PCS1207 PCS1301 PCS1302 PCS1303 PCS1304 PCS1306 PCS1307 PCS1402 PCS1404 PCS1405 PCS1406
G	PCS101 PCS3906 PCS1203
H	PCS1208
I	PCS1305
J	PCS102 PCS31401
K	PCS1408
L	PCS1407
M	PCS1105
N	PCS604
O	PCS606
P	PCS607
Q	PCS1308
R	PCS305 PCS306 PCS307 PCS407 PCS705 PCS706 PCS707 PCS803 PCS804 PCS805 PCS806 PCS807 PCS902 PCS903 PCS904 PCS905 PCS1001 PCS1002 PCS1003 PCS1004 PCS1005
S	PCS1006
T	PCS802 PCS901
U	PCS203
V	PCS704
W	PCS701 PCS702 PCS703 PCS801
X	PCS601 PCS602 PCS603 PCS605
Y	PCS1403
Z	PCS1008

 <div style="display: inline-block; vertical-align: middle; text-align: left;"> <p>FastGrid, LLC 225 E Germann Road Suite 301 Gilbert, AZ 85297</p> </div>		
REV	DESCRIPTION	DATE
4	RECORD DRAWINGS	06/08/2023

PROJECT NAME:

EAGLE SHADOW MOUNTAIN PV SOLAR POWER GENERATION FACILITY

PROJECT ADDRESS:

I-15 CRYSTAL, NV CLARK COUNTY

SEAL:	DATE:
	10/16/2020
	PROJECT #:
	190067.03
	DRAWN BY:
	TLR
	CHECKED BY:
	EL

SHEET NAME:

DC PLAN - ARRAY TYPE Y (JINKO)

SHEET #:	REV #:
E-425	4

1

2

3

4

5

6


7

DETAIL 2 NOTES:


- THIS DETAIL IS DIAGRAMMATIC AND IS MEANT TO CONVEY THE STRING NUMBERING SCHEME FOR BLOCKS WITH CANADIAN SOLAR AND JINKO MODULES. THE ARRANGEMENT SHOWN IS TYPICAL AND DOES NOT NECESSARILY REPRESENT THAT OF ACTUAL INVERTER AND DISCONNECTS USED.
- NOT ALL BOUNDARY SHAPES ARE NECESSARILY REPRESENTED HERE, APPLY METHOD AS DENOTED IN THE NOTES TO STRING NUMBERING.
- TABLE SPACING AND LOAD BREAK DISCONNECT BOUNDARY SPACING MAY NOT REPRESENT ACTUAL DESIGN CONDITIONS. REFER TO THE DC PLAN DRAWINGS FOR ACTUAL LAYOUT.

2 TYPICAL STRING NUMBERING METHOD (CANADIAN SOLAR / JINKO)


SCALE: N.T.S.

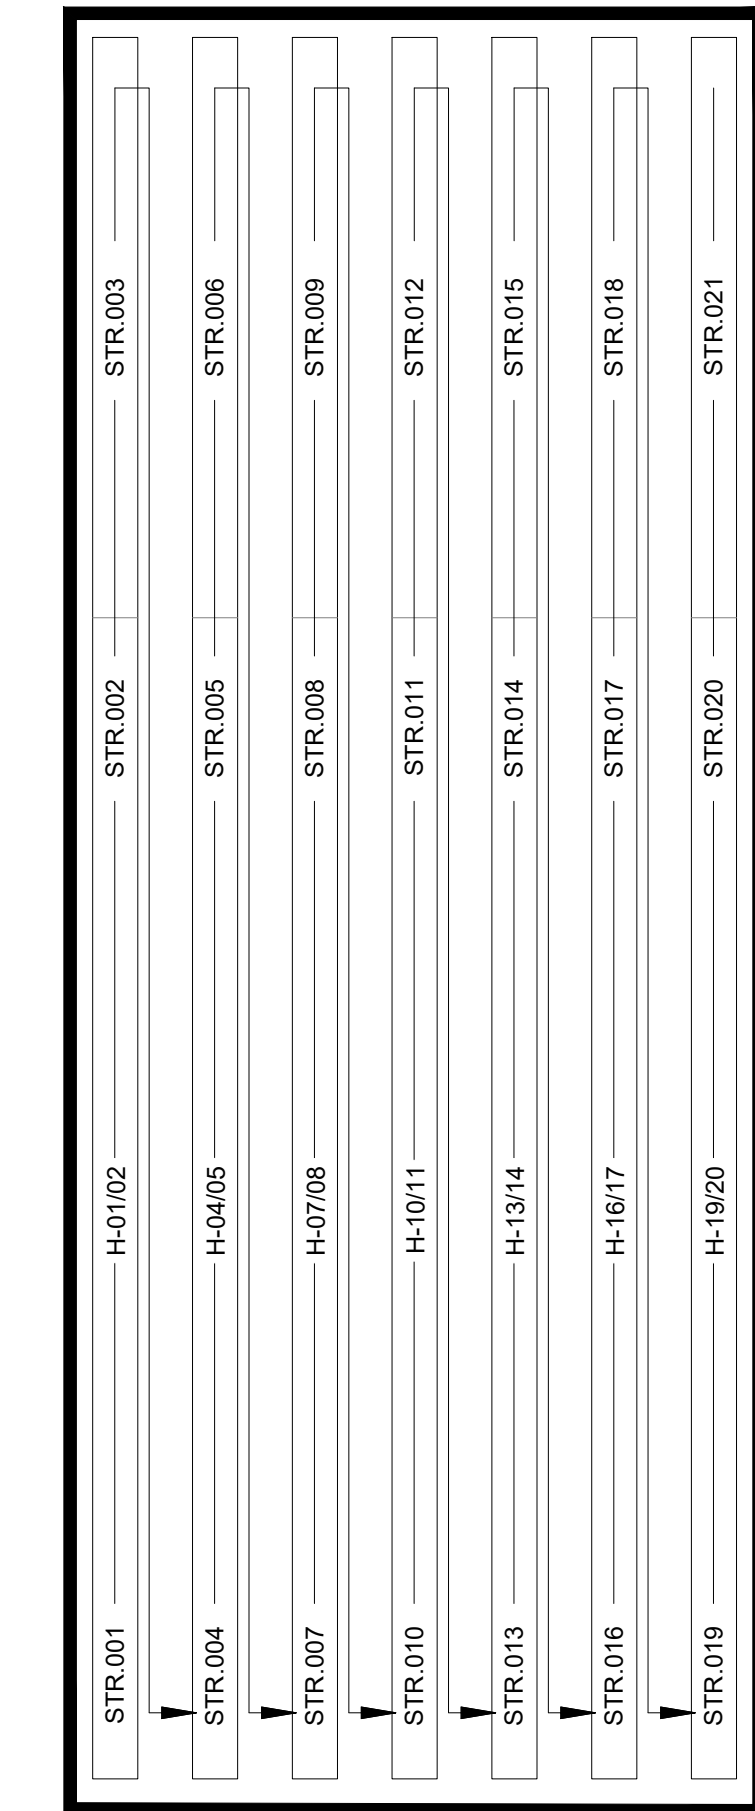

NOTE 1 (TYP)

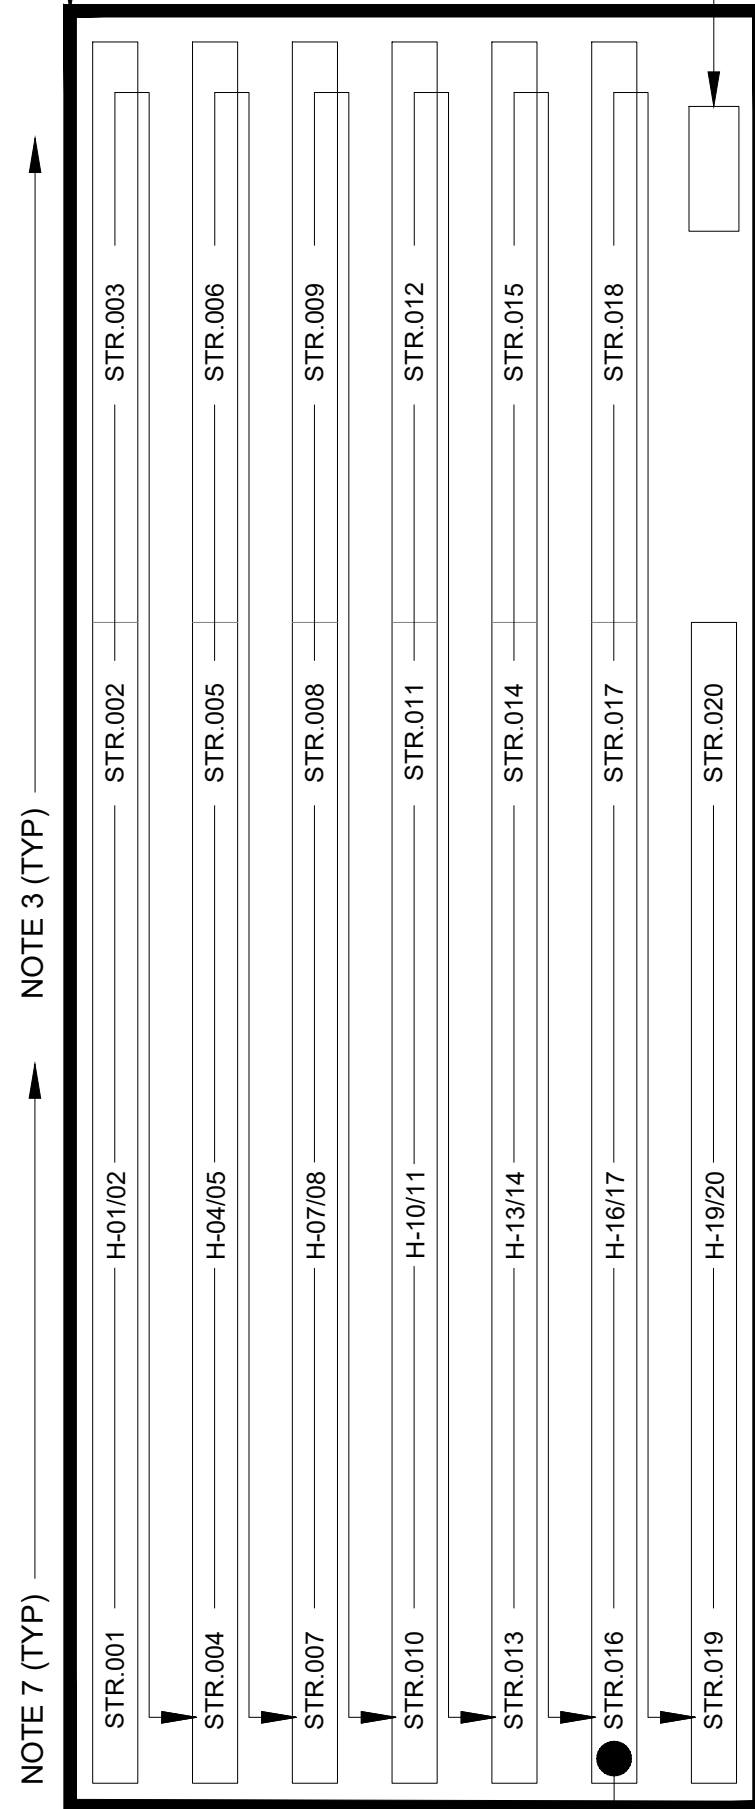


NOTE 4 (TYP)

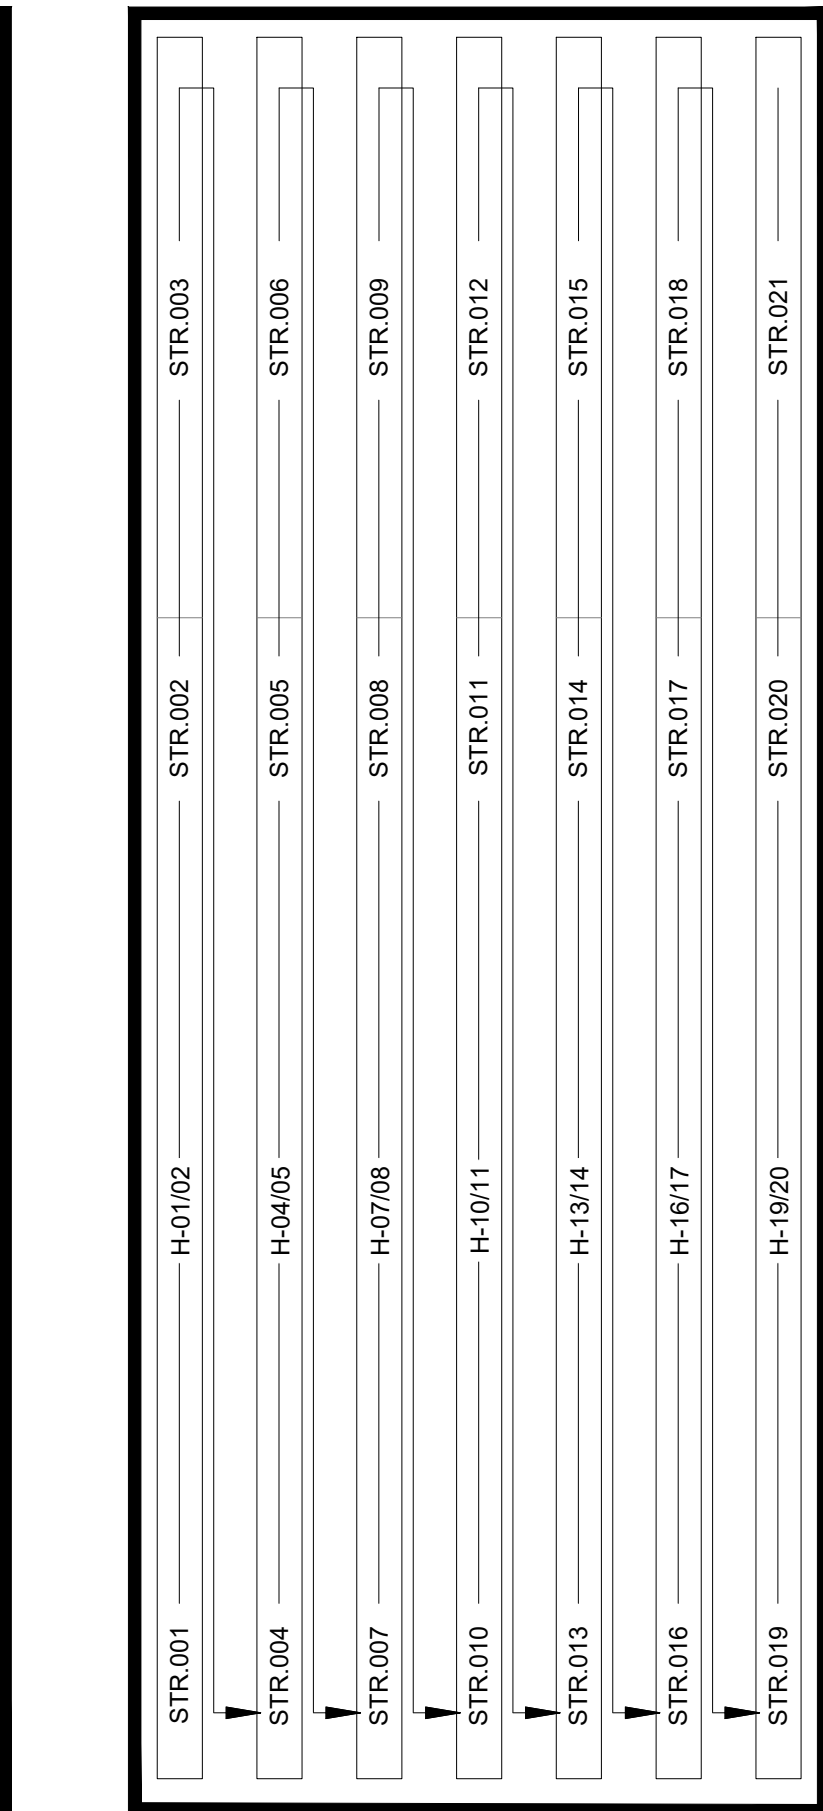

TYPICAL POWER CONVERSION STATION

TYPICAL LOAD BREAK DISCONNECT BOUNDARY

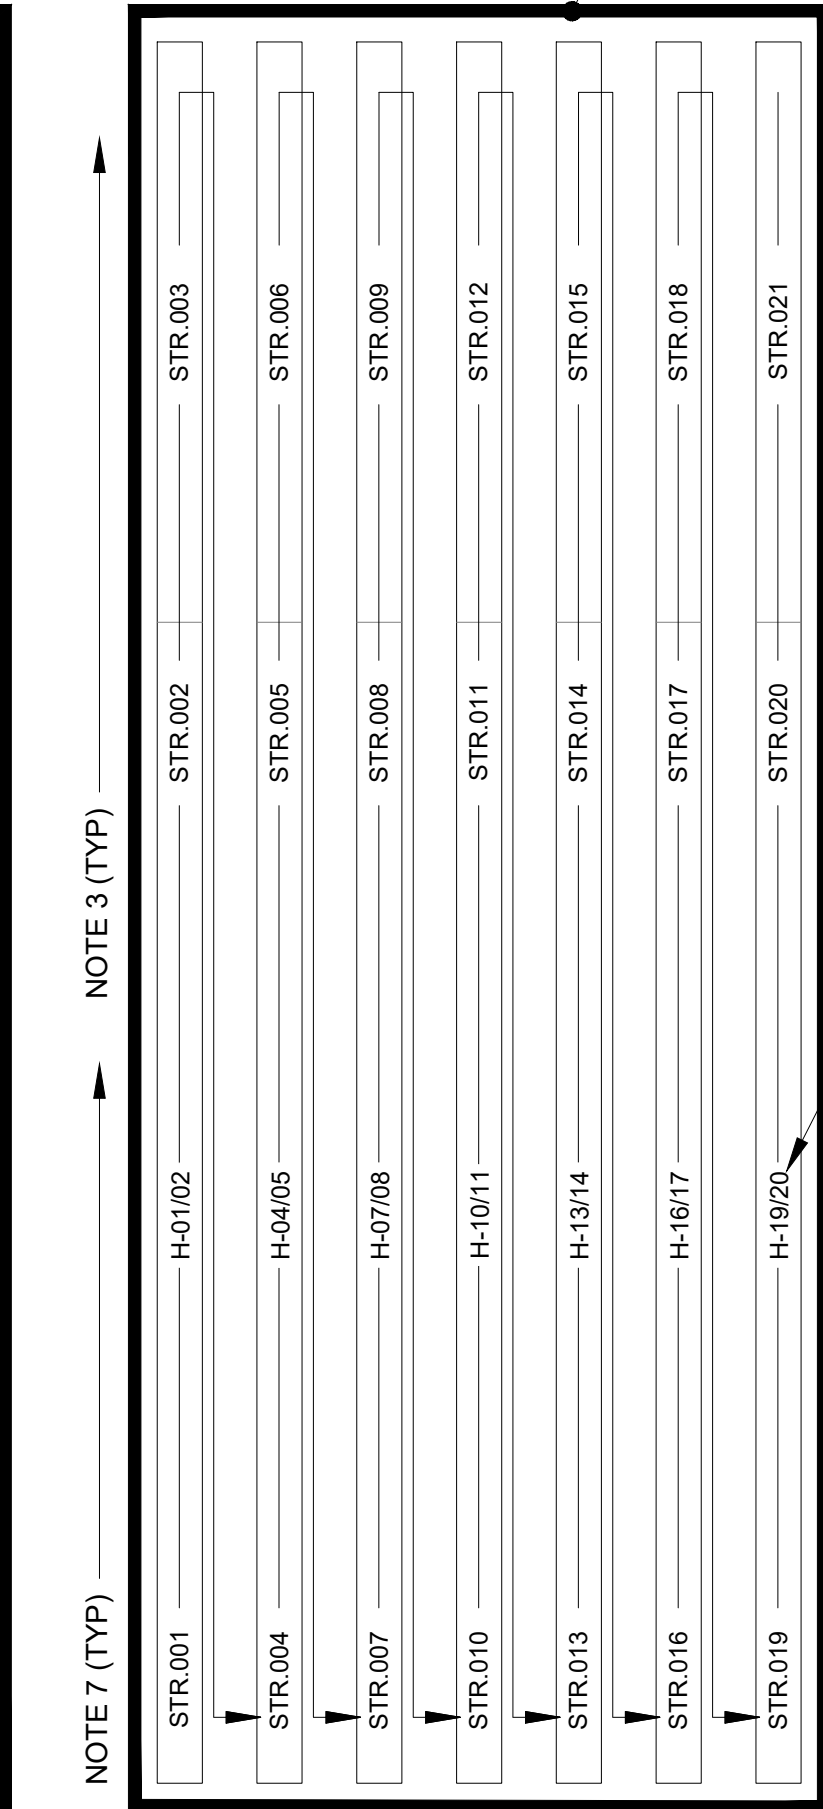

NOTE 7 (TYP)

1 E-481 3 E-481


SEE CABLE TAG LEGEND

DETAIL 1 NOTES:

- THIS DETAIL IS DIAGRAMMATIC AND IS MEANT TO CONVEY THE STRING NUMBERING SCHEME FOR BLOCKS WITH TRINA MODULES. THE ARRANGEMENT SHOWN IS TYPICAL AND DOES NOT NECESSARILY REPRESENT THAT OF ACTUAL INVERTER AND DISCONNECTS USED.
- NOT ALL BOUNDARY SHAPES ARE NECESSARILY REPRESENTED HERE, APPLY METHOD AS DENOTED IN THE NOTES TO STRING NUMBERING.
- TABLE SPACING AND LOAD BREAK DISCONNECT BOUNDARY SPACING MAY NOT REPRESENT ACTUAL DESIGN CONDITIONS. REFER TO THE DC PLAN DRAWINGS FOR ACTUAL LAYOUT.


1 TYPICAL STRING NUMBERING METHOD (TRINA)

SCALE: N.T.S.

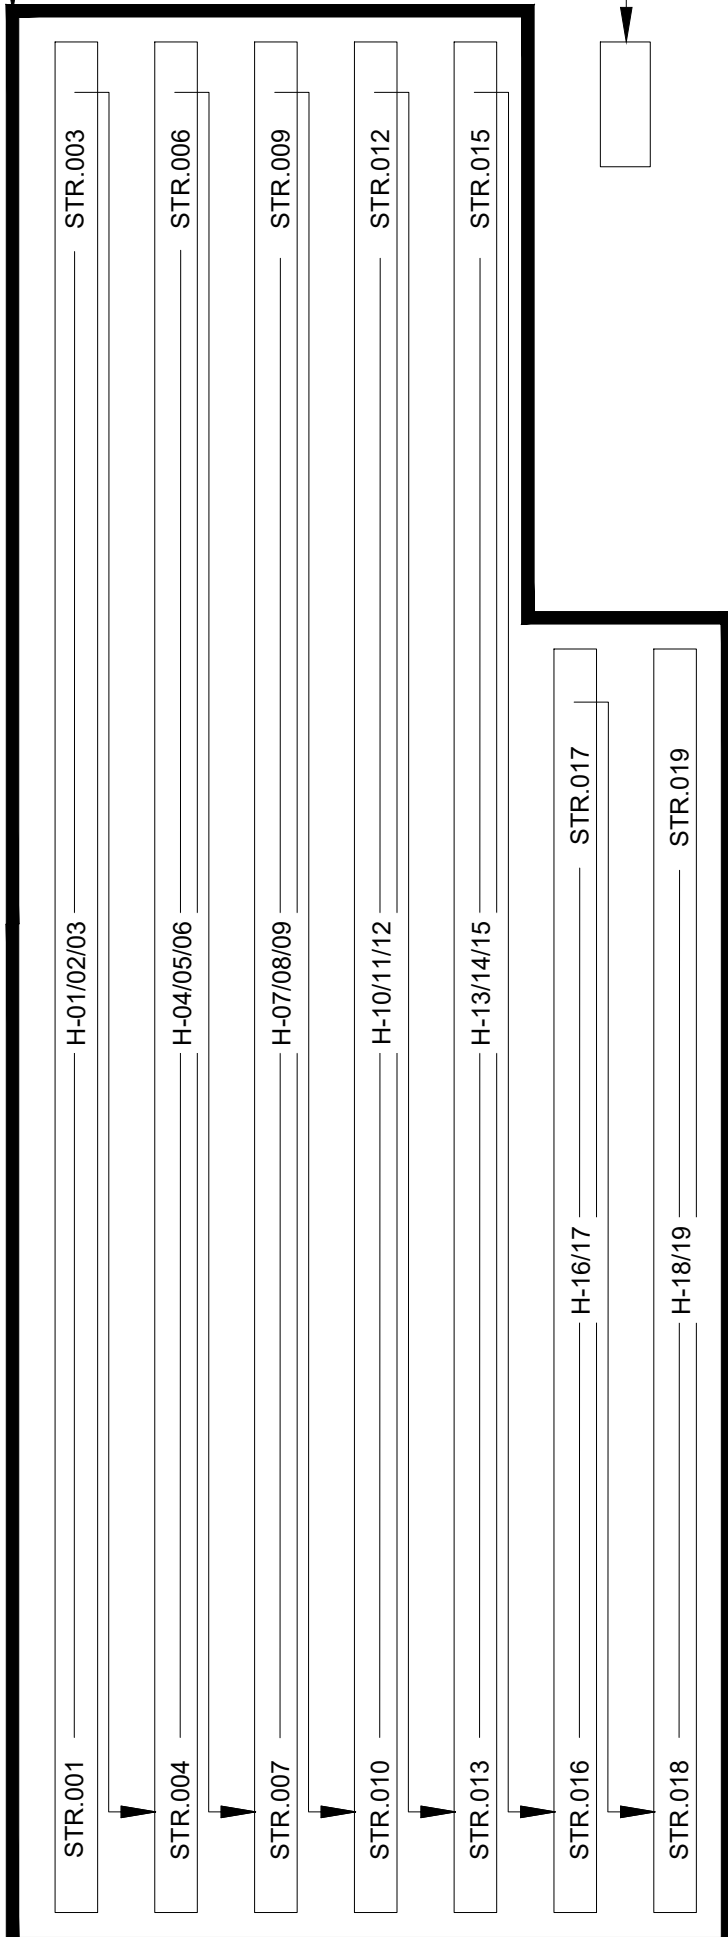


NOTE 2 (TYP)

NOTE 1 (TYP)

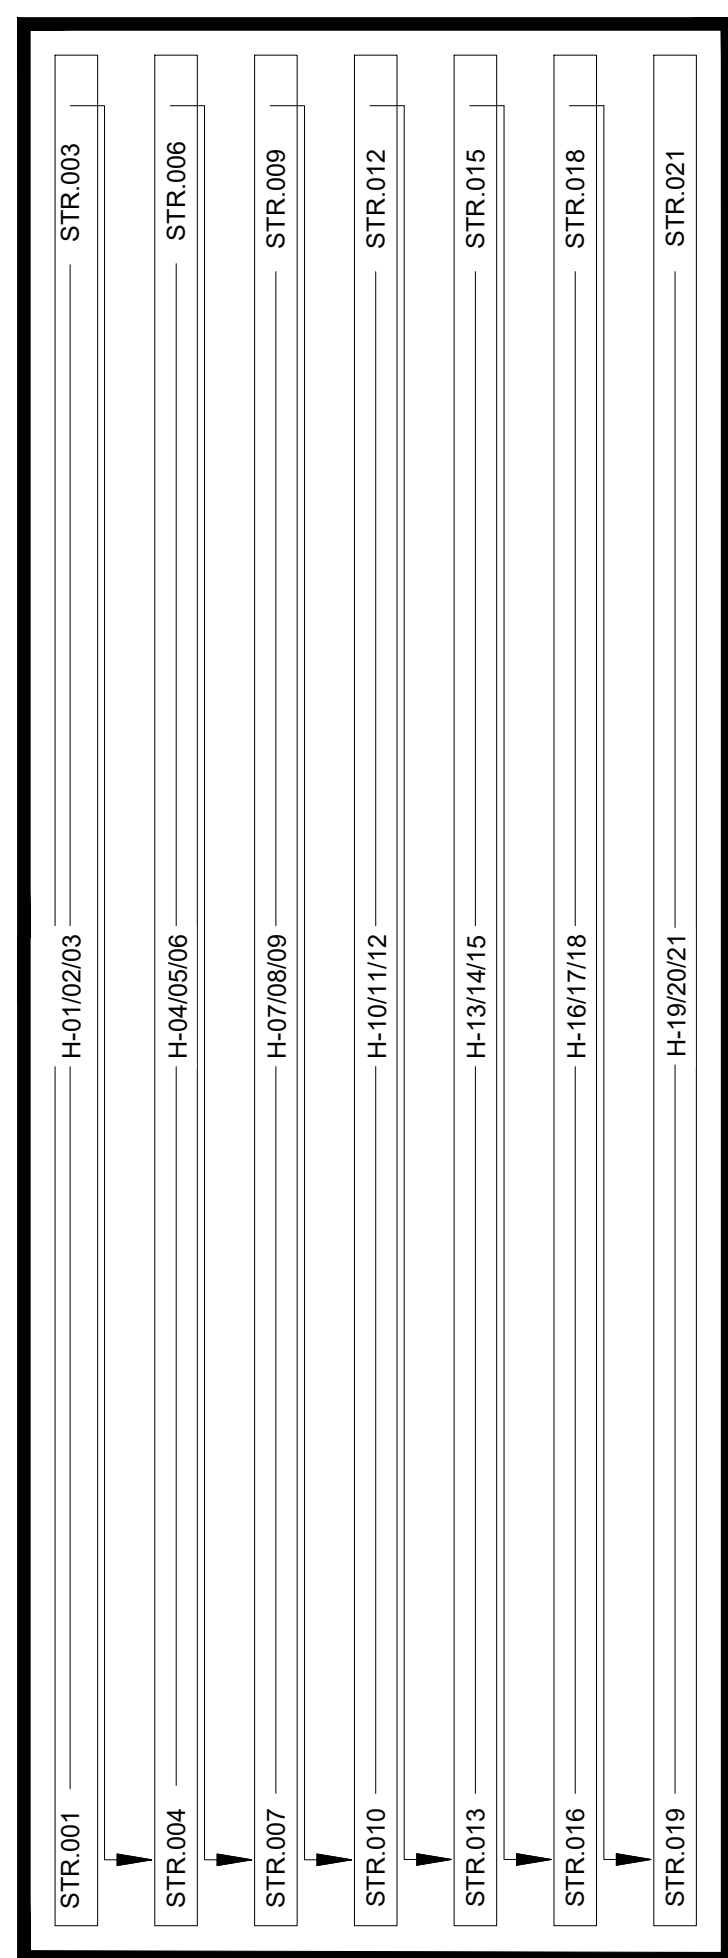

TYPICAL POWER CONVERSION STATION


TYPICAL LOAD BREAK DISCONNECT BOUNDARY

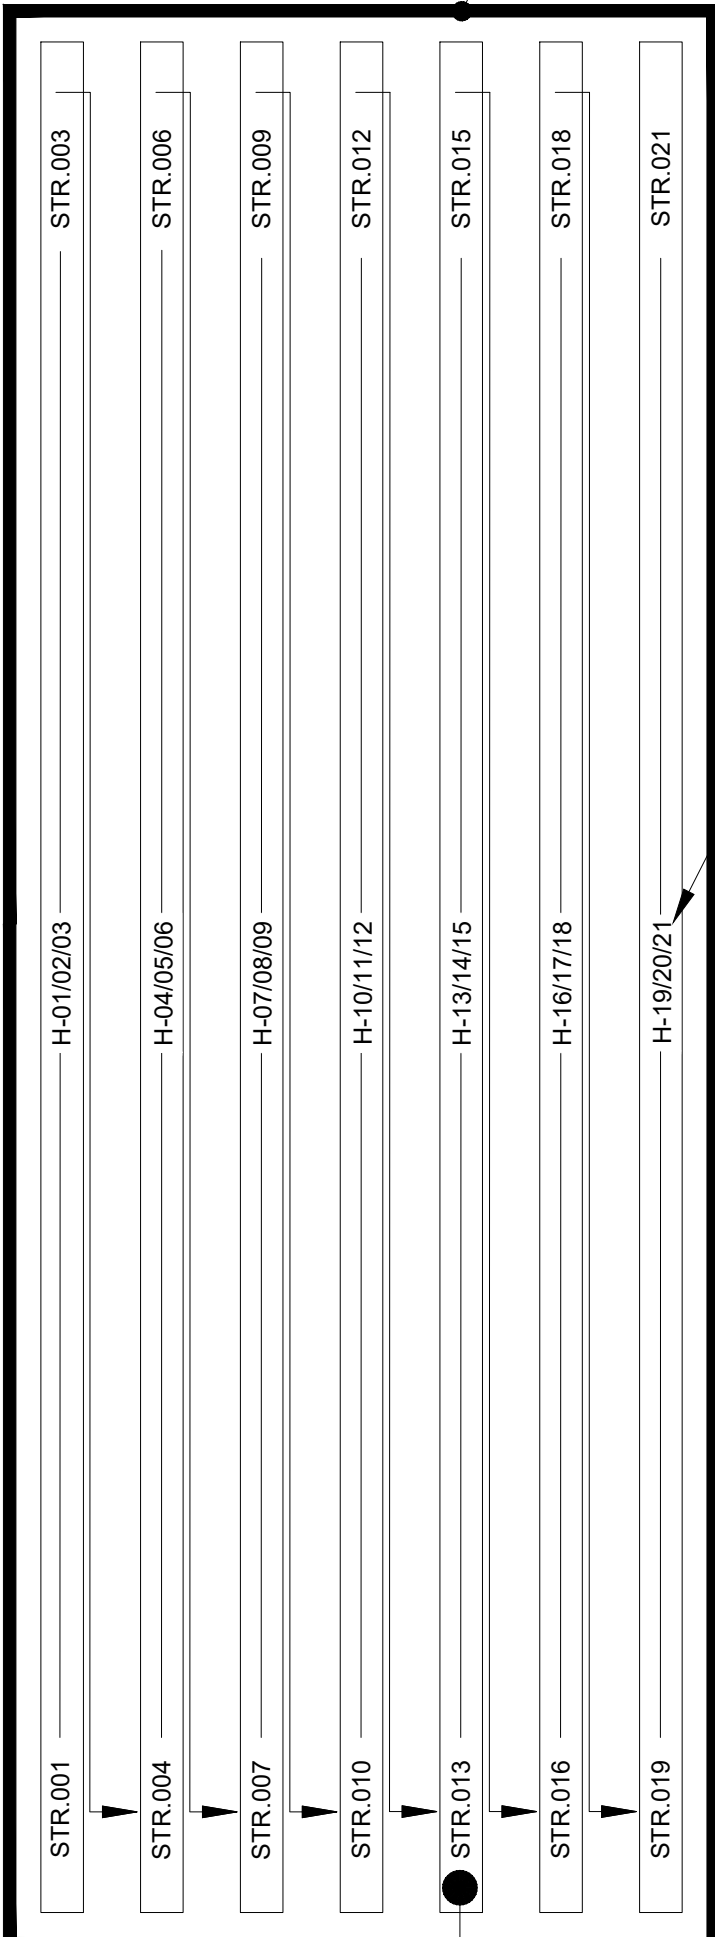

NOTE 2 (TYP)

NOTE 3 (TYP)

SEE CABLE TAG LEGEND

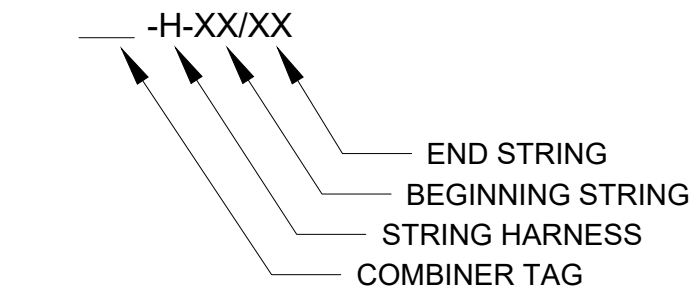

NOTES:
GENERAL RULE TO STRING NUMBERING SHALL BE AS FOLLOWS:

- HARNESS AND STRING NUMBERING BEGINS AT THE FARTHEST SOUTHWEST CORNER OF EACH LOAD BREAK DISCONNECT BOUNDARY AND INCREASES SEQUENTIALLY CONTINUING TO THE NEXT STRING AND CONSECUTIVE HARNESS NORTH. AFTER ALL HARNESSES ARE NUMBERED FROM SOUTH TO NORTH THEN NUMBERING SHALL PROGRESS TO THE NEXT COLUMN OF TABLES TO THE EAST BEGINNING AGAIN AT THE SOUTHERN MOST HARNESS / STRING. EACH STRING, HARNESS AND RESPECTIVE JUMPER TO THE LOAD BREAK DISCONNECT PANEL SHALL HAVE A UNIQUE SEQUENTIAL NUMBER. REFER TO E-211 THROUGH E-236 SHEETS FOR SPECIFIC NUMBERING FOR THIS PROJECT.
- 3-STRING TABLES HAVE ONE (1) 3-STRING HARNESS EACH, 2-STRING TABLES HAVE ONE (1) 2-STRING HARNESS EACH.
- STRING NUMBERING SHALL BEGIN AT LOWER SOUTHERN MOST CORNER FOR EACH COMBINER GROUP OF STRINGS AS DEFINED BY EACH LOAD BREAK SWITCH BOUNDARY (BOUNDARIES AS SHOWN ON SHEETS E-401 THROUGH E-426).
- BEGINNING IN THE SOUTHERN MOST CORNER WITH-IN THE LOAD BREAK DISCONNECT BOUNDARY NUMBERING STARTS WITH STRING.01 (STR.001) AND INCREASES INCREMENTALLY WITH-IN EACH TABLE. REFER TO DETAIL 1 AND DETAIL 2 THIS SHEET.
- NUMBERING PROGRESSES TO THE NEXT TABLE DIRECTLY TO THE NORTH BEFORE PROGRESSING TO THE NEXT COLUMN TO THE EAST, TYPICAL FOR WITH-IN DISCONNECT BOUNDARY.
- NUMBERING PROGRESSES TO THE EAST (NEXT CONSECUTIVE TABLE COLUMN) AFTER ALL TABLES NUMBERING TO THE NORTH ARE COMPLETED. THE PROCESS CONTINUES UNTIL ALL STRINGS ARE NUMBERED SEQUENTIALLY WITH-IN THE LOAD BREAK DISCONNECT (LBD) BOUNDARY.
- 3-STRING TABLES HAVE ONE (1) 2-STRING HARNESS AND 1-SINGLE STRING CIRCUIT ROUTED TO IPC AT TRUNK BUS.
- REFER TO E-908 FOR HARNESS SPECIFICATIONS AND ADDITIONAL INFORMATION.

CABLE TAG LEGEND:



REV	DESCRIPTION	DATE
4	RECORD DRAWINGS	06/08/2023

PROJECT NAME:
**EAGLE SHADOW MOUNTAIN
PV SOLAR POWER
GENERATION FACILITY**

PROJECT ADDRESS:
**I-15
CRYSTAL, NV
CLARK COUNTY**

SEAL: PROJECT #
190067.03
DRAWN BY:
CLH
CHECKED BY:
EL

SHEET NAME:
TYPICAL STRING NUMBERING

SHEET #:
E-480
REV #:
4


RECORD DRAWING

LOCATION: K:_09 PROJECTS\190067.03 - PRIMORIS - EAGLE SHADOW MOUNTAIN\05 ENGINEERING\DWG\E-480 TYPICAL STRING NUMBERING


SAVED BY: Irena Luchenta

PLOT BY: Brady Burgesson


PLOT DATE: Thursday, June 08, 2023

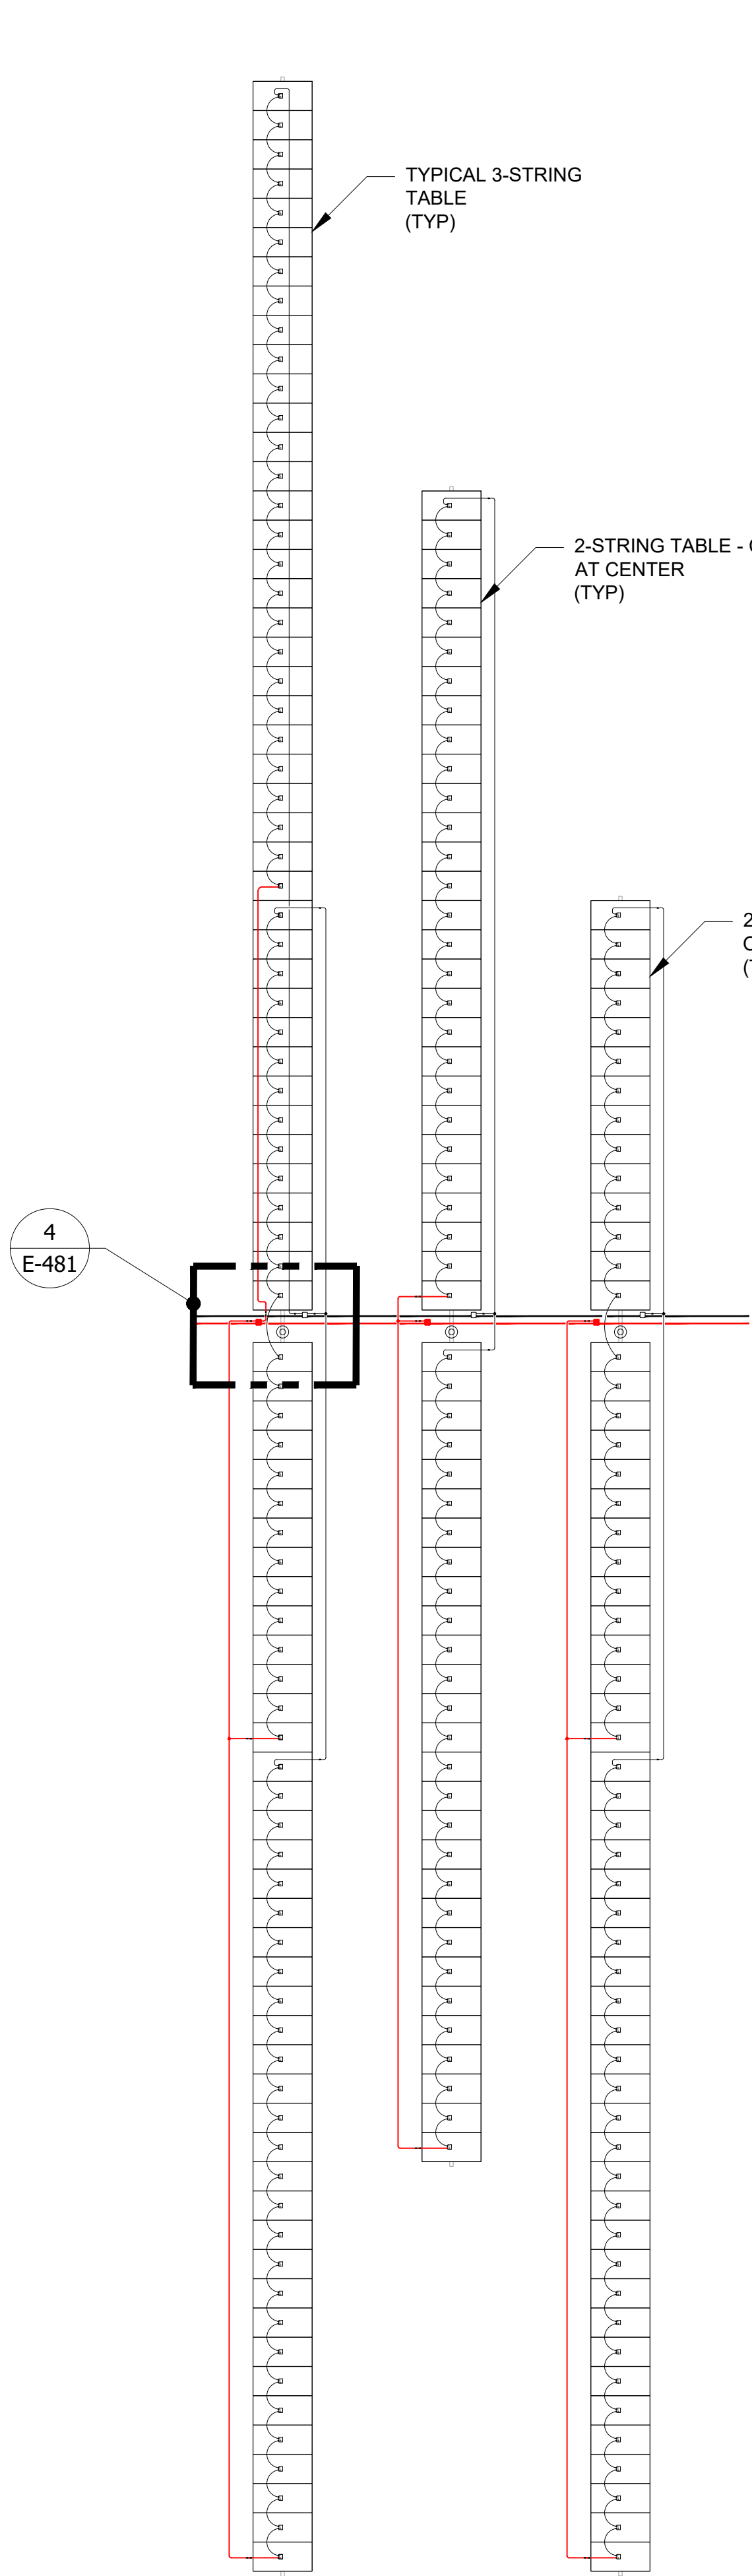


3 TYPICAL HARNESS WIRING - CANADIAN SOLAR MODULES
SCALE: N.T.S.

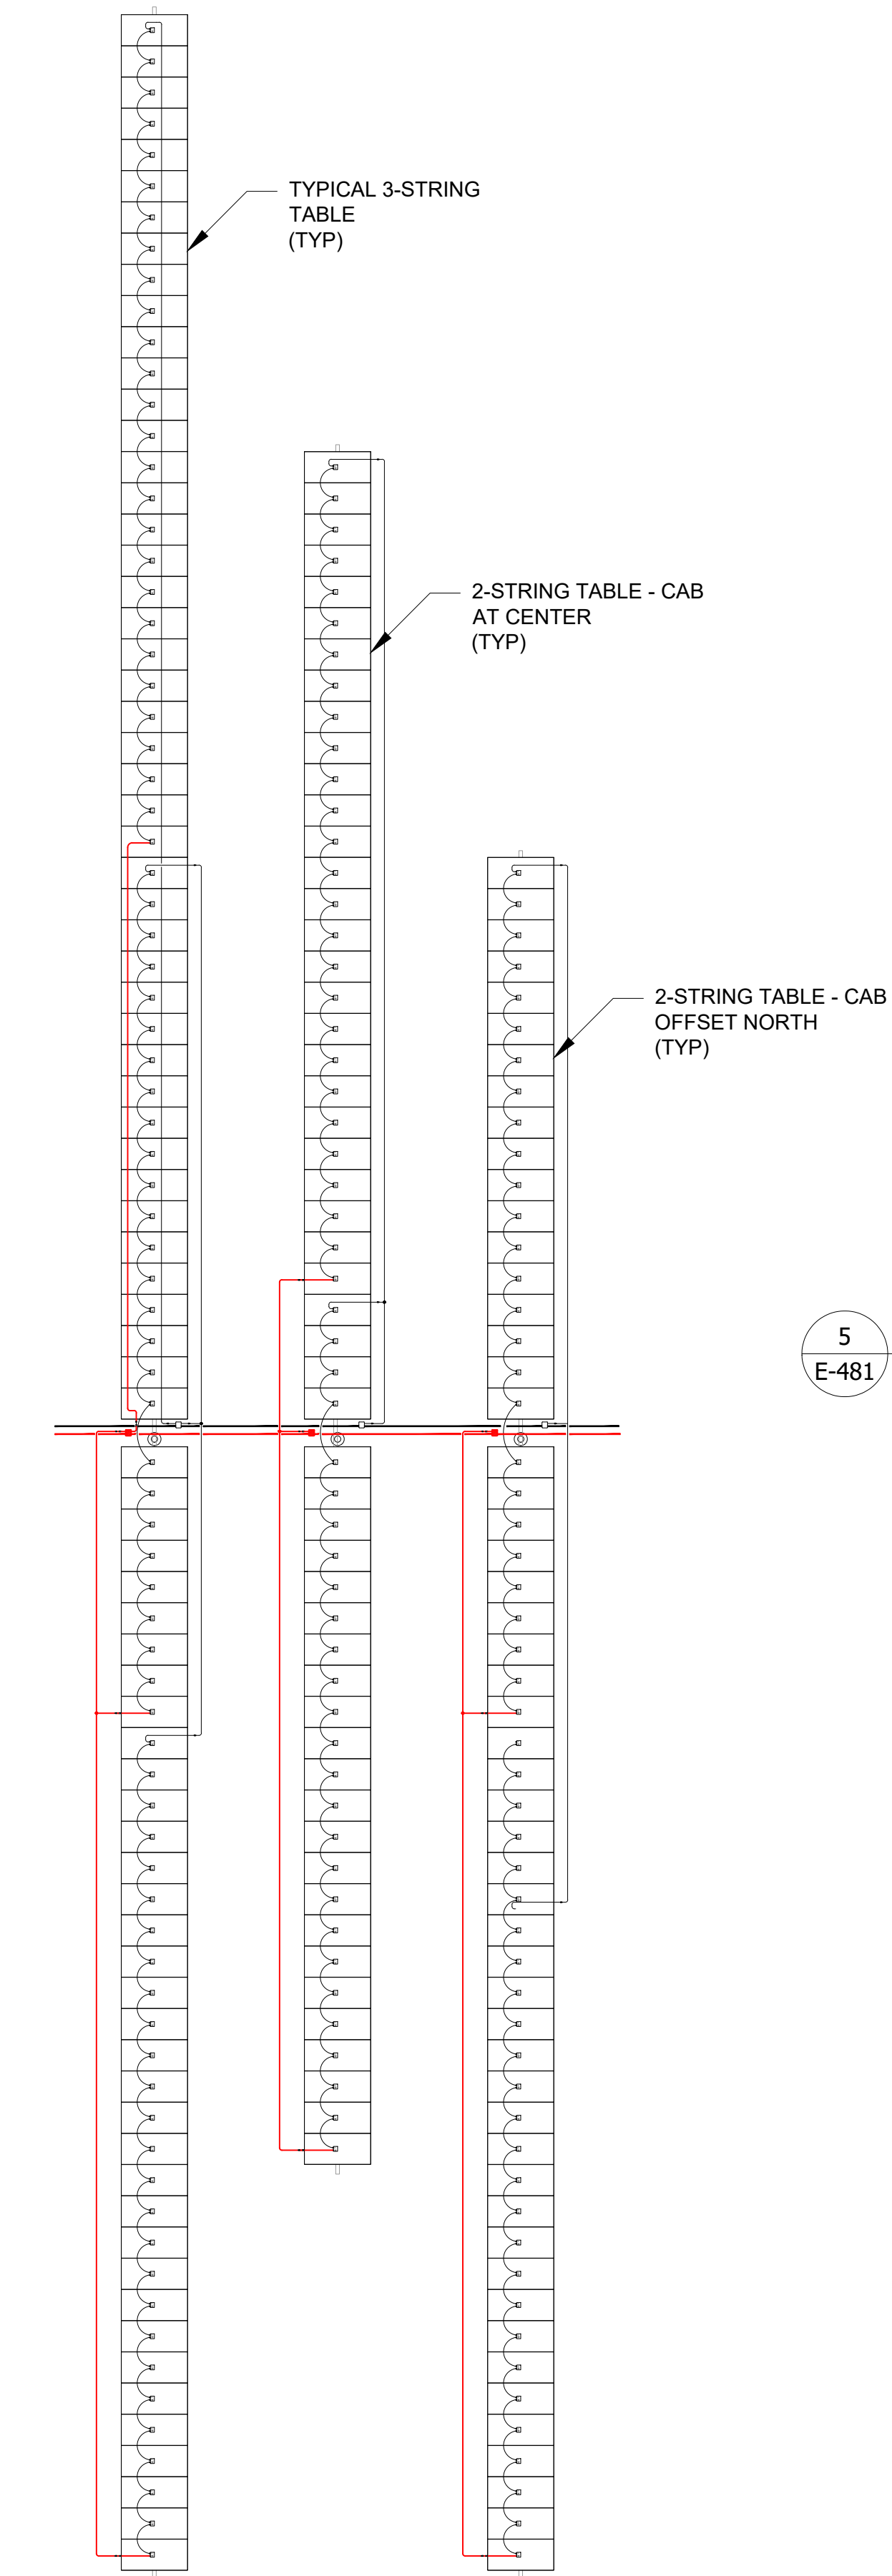


2 TYPICAL HARNESS WIRING - JINKO SOLAR MODULES
SCALE: N.T.S.

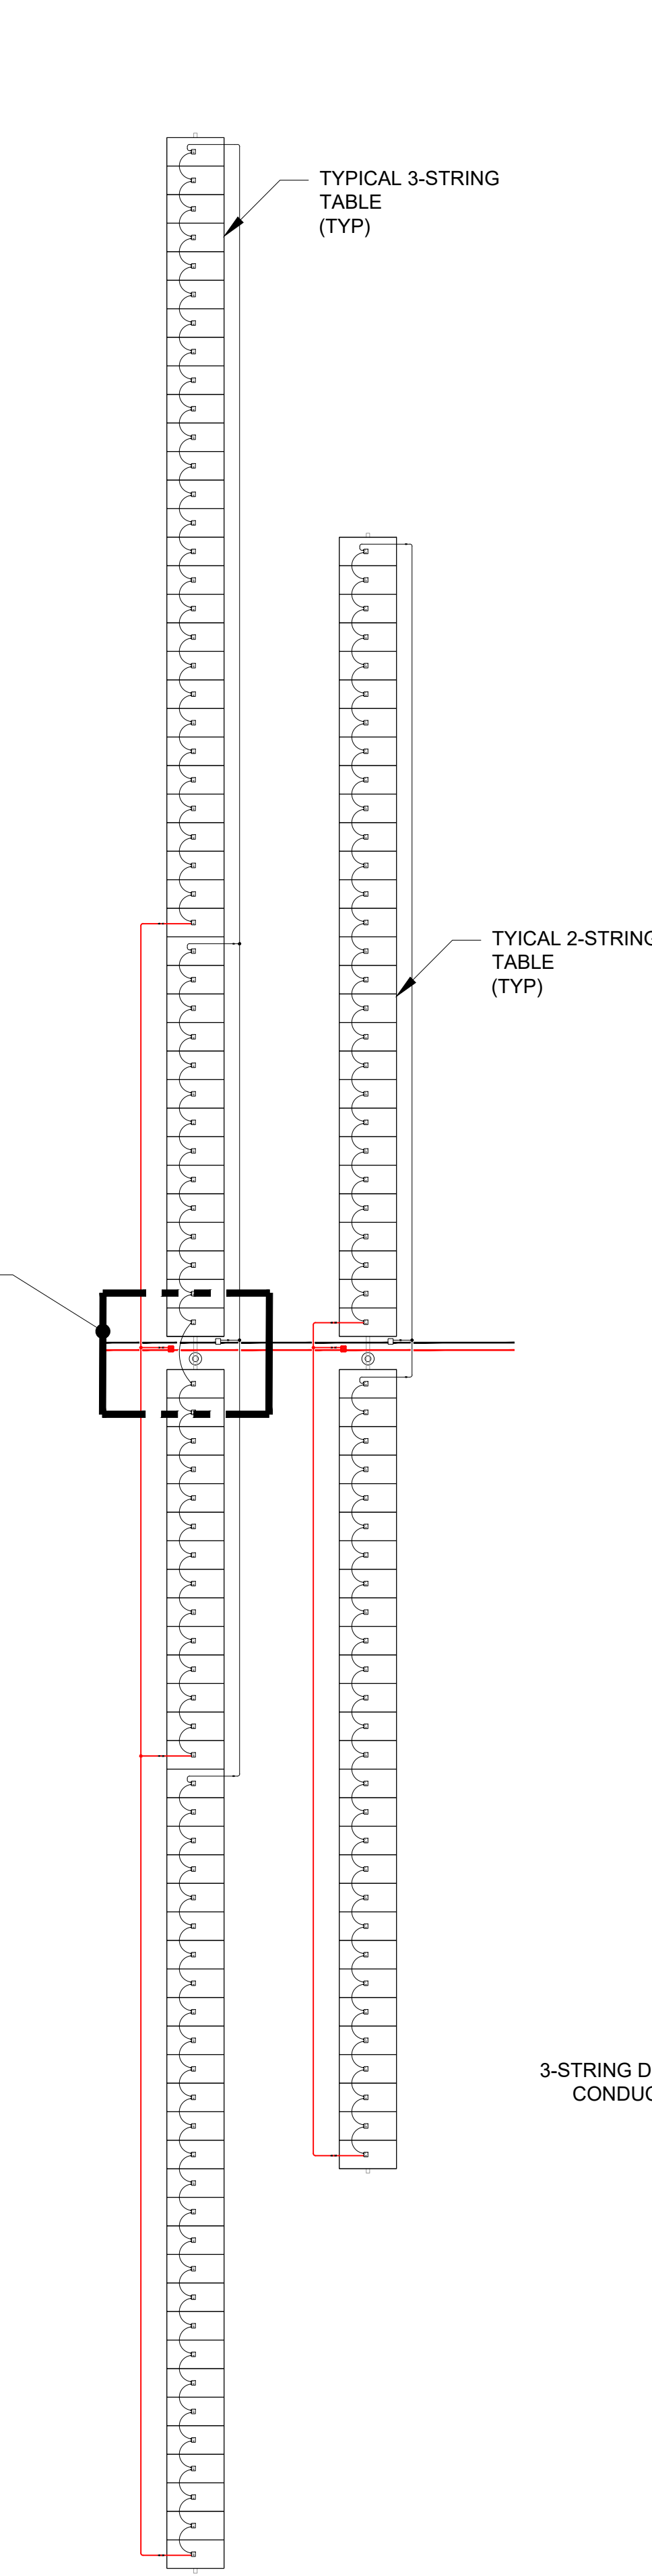

1 TYPICAL HARNESS WIRING - TRINA MODULES
SCALE: N.T.S.

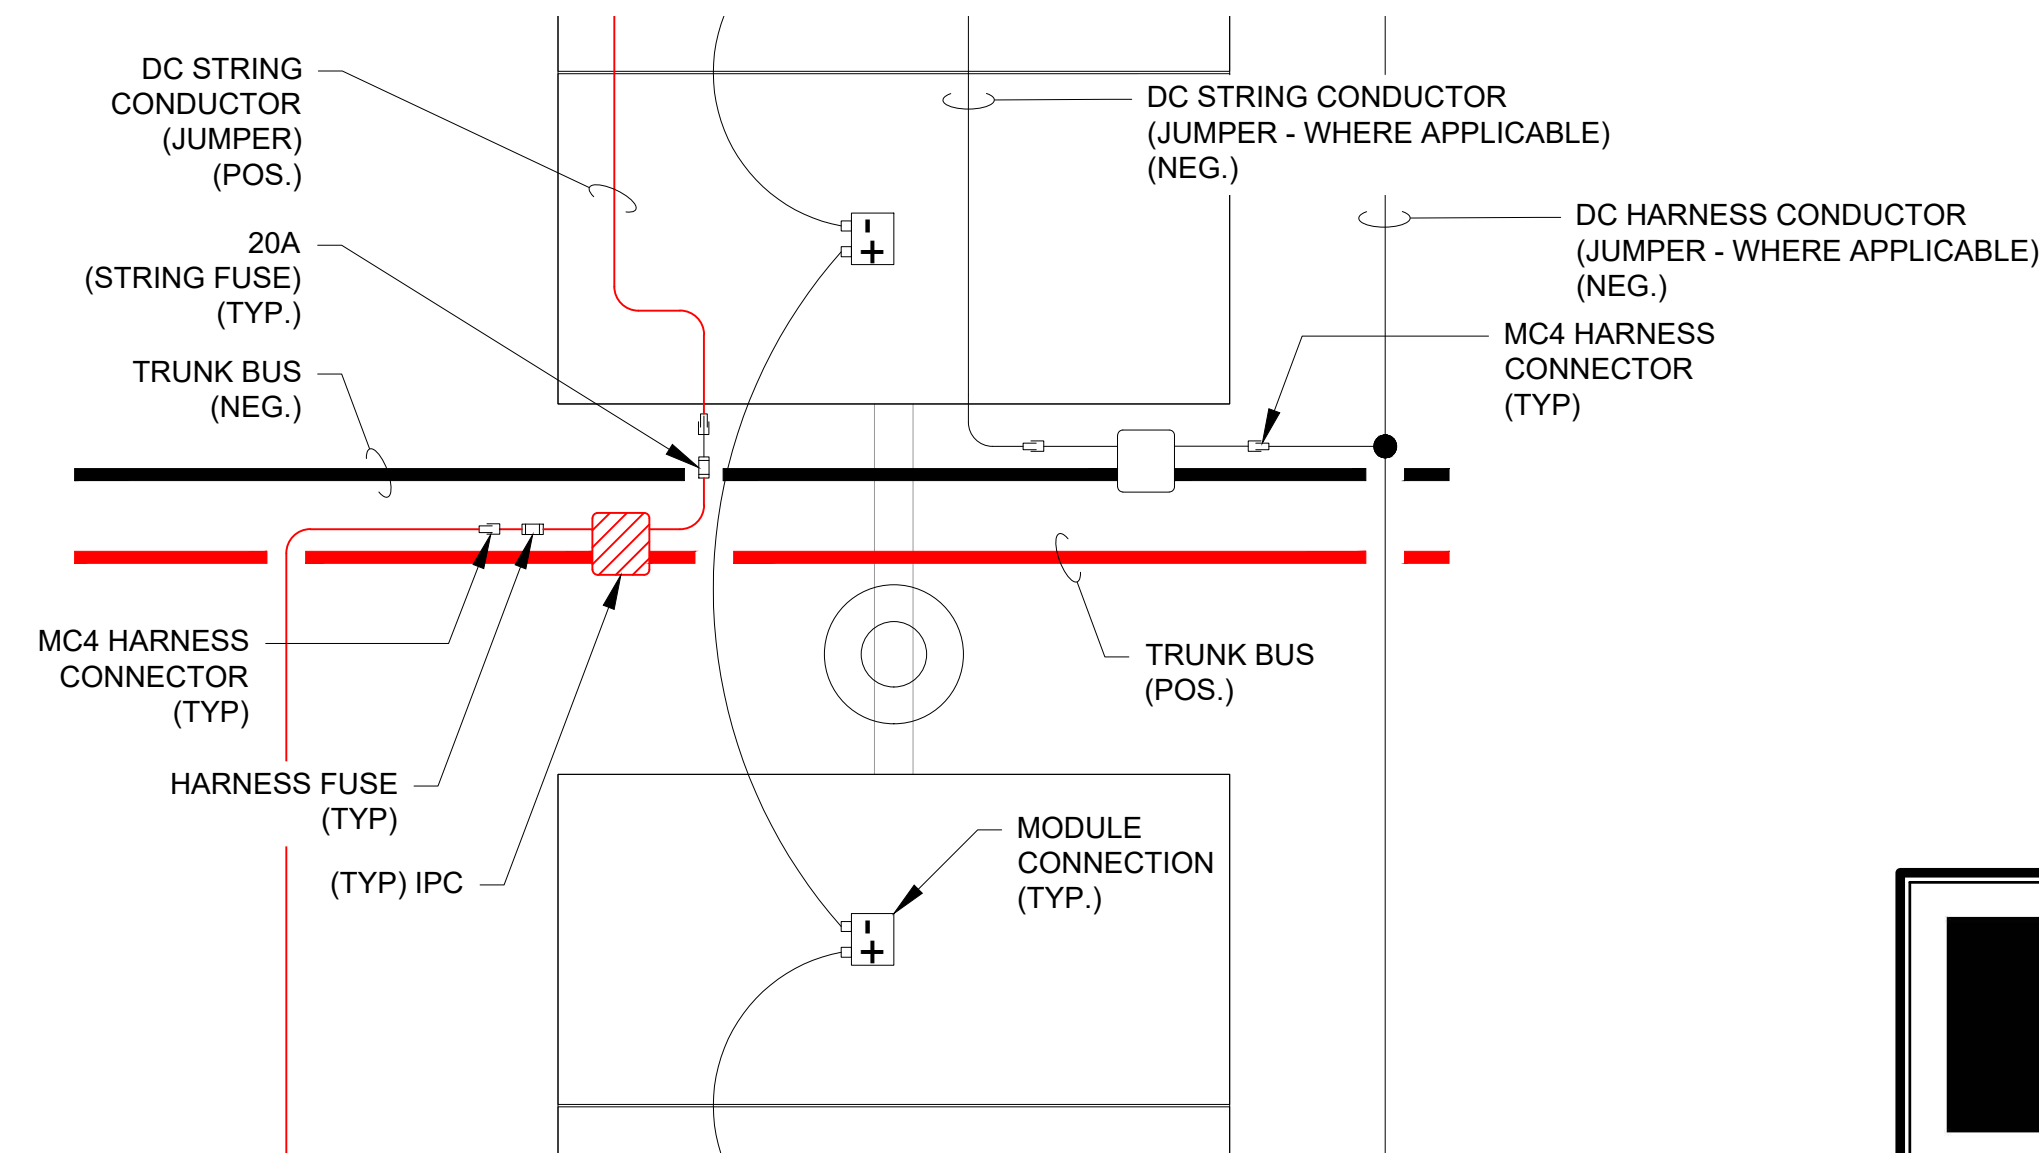

4 DETAIL VIEW
SCALE: N.T.S.

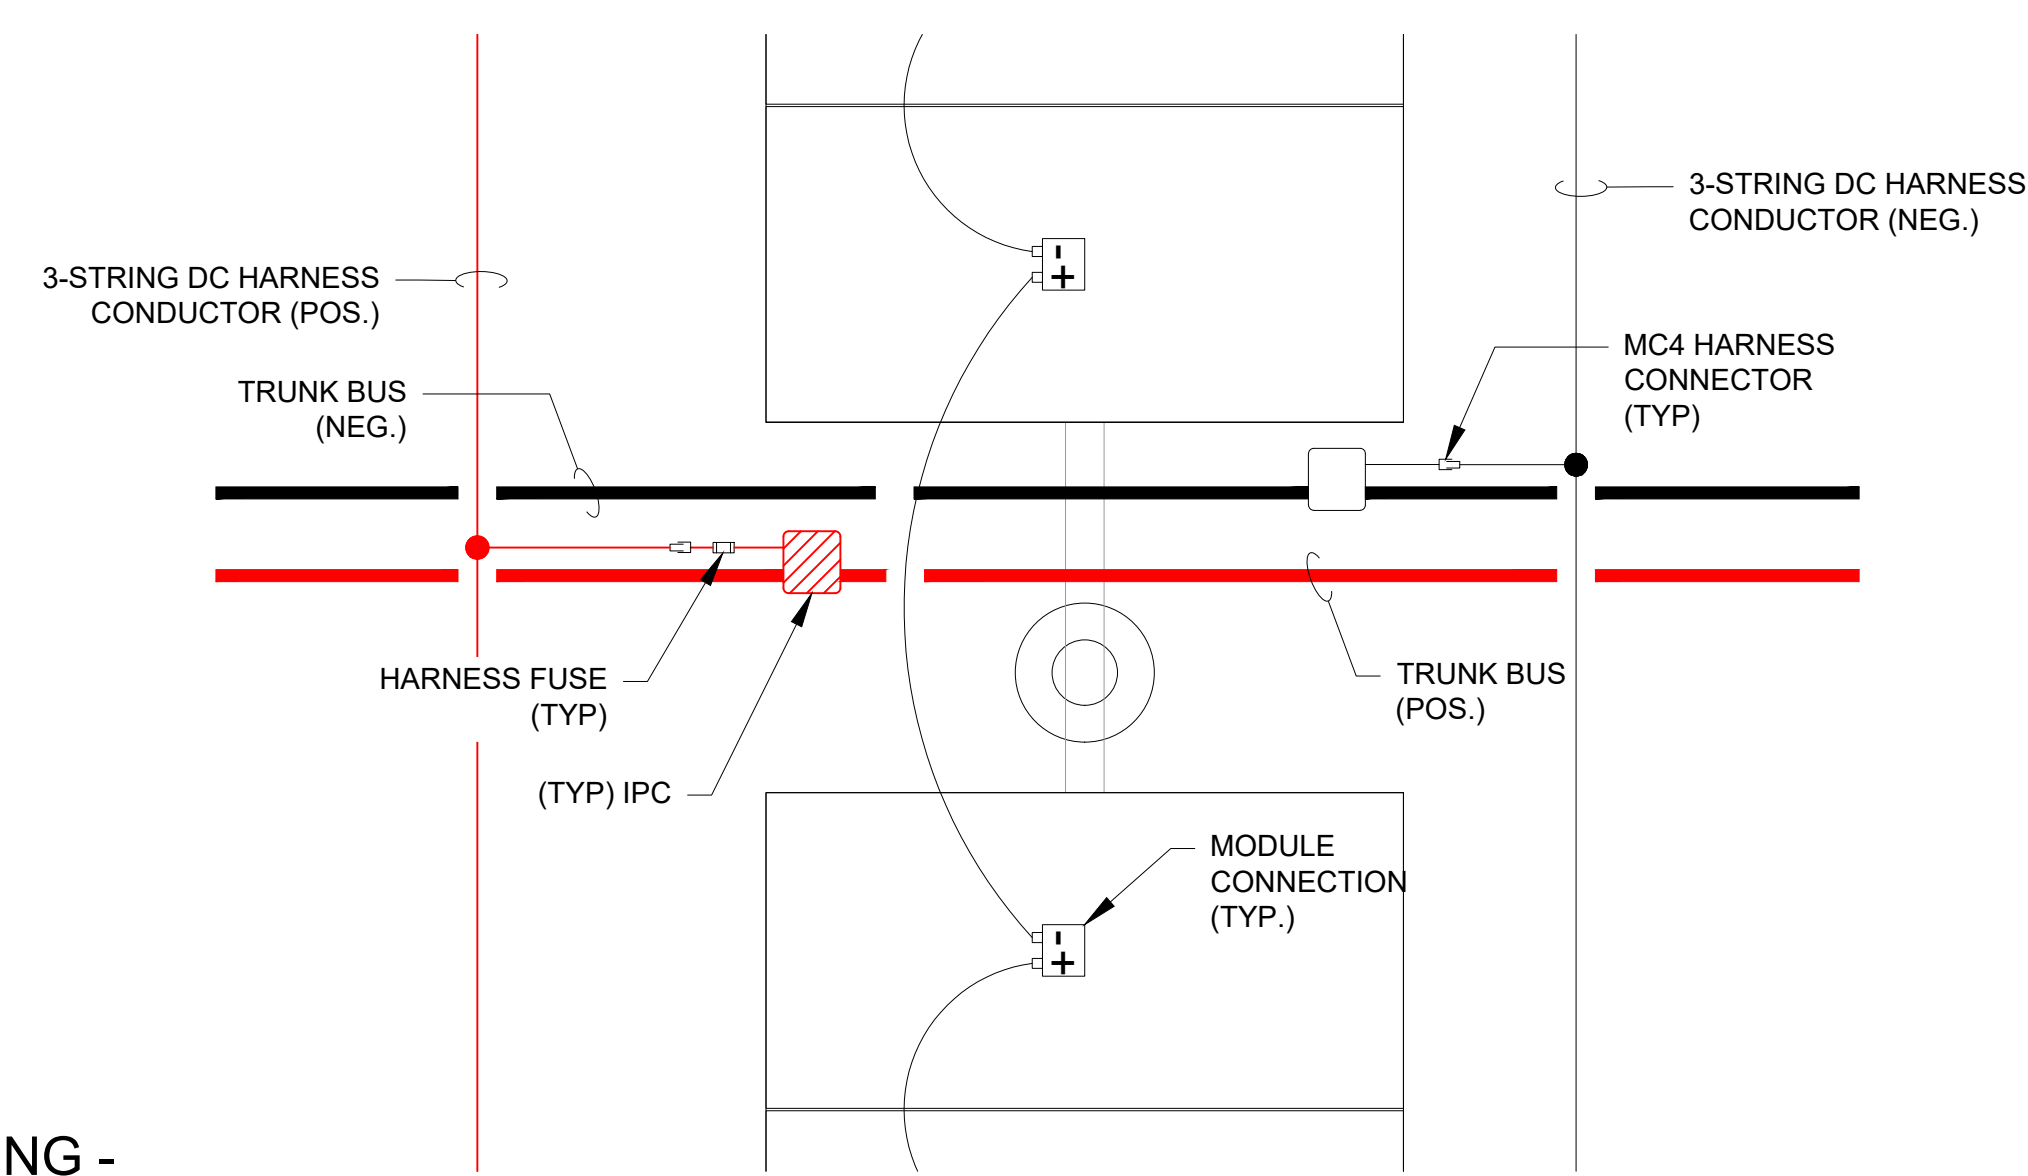

5 DETAIL VIEW
SCALE: N.T.S.

- NOTES:
- THIS DRAWING IS DIAGRAMMATIC AND INTENDED TO SHOW TYPICAL TABLE STRING AND HARNESS DC WIRING. INSULATION PIERCING CONNECTORS (IPC), AND ASSOCIATED TRUNK BUS. WIRE MANAGEMENT SYSTEM NOT SHOWN FOR CLARITY.
 - EACH FULL TABLE CONSISTS OF 2 OR 3 TOTAL STRINGS WITH TRUNK BUS AND ASSOCIATED INSULATION PIERCING CONNECTORS.
 - ALL 2-STRING TABLES SHALL UTILIZE 2-STRING HARNESSES.
 - 3-STRING TABLES SHALL UTILIZE THE FOLLOWING:
 - TRINA MODULES: ONE (1) 3-STRING HARNESSES.
 - JINKO/CS MODULES: ONE (1) 3-STRING HARNESSES.
 - REFER TO SHEETS E-211 THRU E-236 FOR FUSE SIZES AND ADDITIONAL STRING INFORMATION PER ARRAY TYPE

- LEGEND:
- INSULATION PIERCING CONNECTOR 'IPC' (NEG.)
 - INSULATION PIERCING CONNECTOR 'IPC' (POS.)
 - TRUNK BUS (NEG.)
 - TRUNK BUS (POS.)

FastGrid

FastGrid, LLC
225 E Germann Road
Suite 301
Gilbert, AZ 85297

REV	DESCRIPTION	DATE
4	RECORD DRAWINGS	06/08/2023

PROJECT NAME:
**EAGLE SHADOW MOUNTAIN
PV SOLAR POWER
GENERATION FACILITY**

PROJECT ADDRESS:
**I-15
CRYSTAL, NV
CLARK COUNTY**

SEAL:

DATE:
10/16/2020

PROJECT #:
190067.03

DRAWN BY:
CH


CHECKED BY:
EL

SHEET NAME:
TYPICAL STRING WIRING


SHEET #:
E-481

REV #:
4


RECORD DRAWING

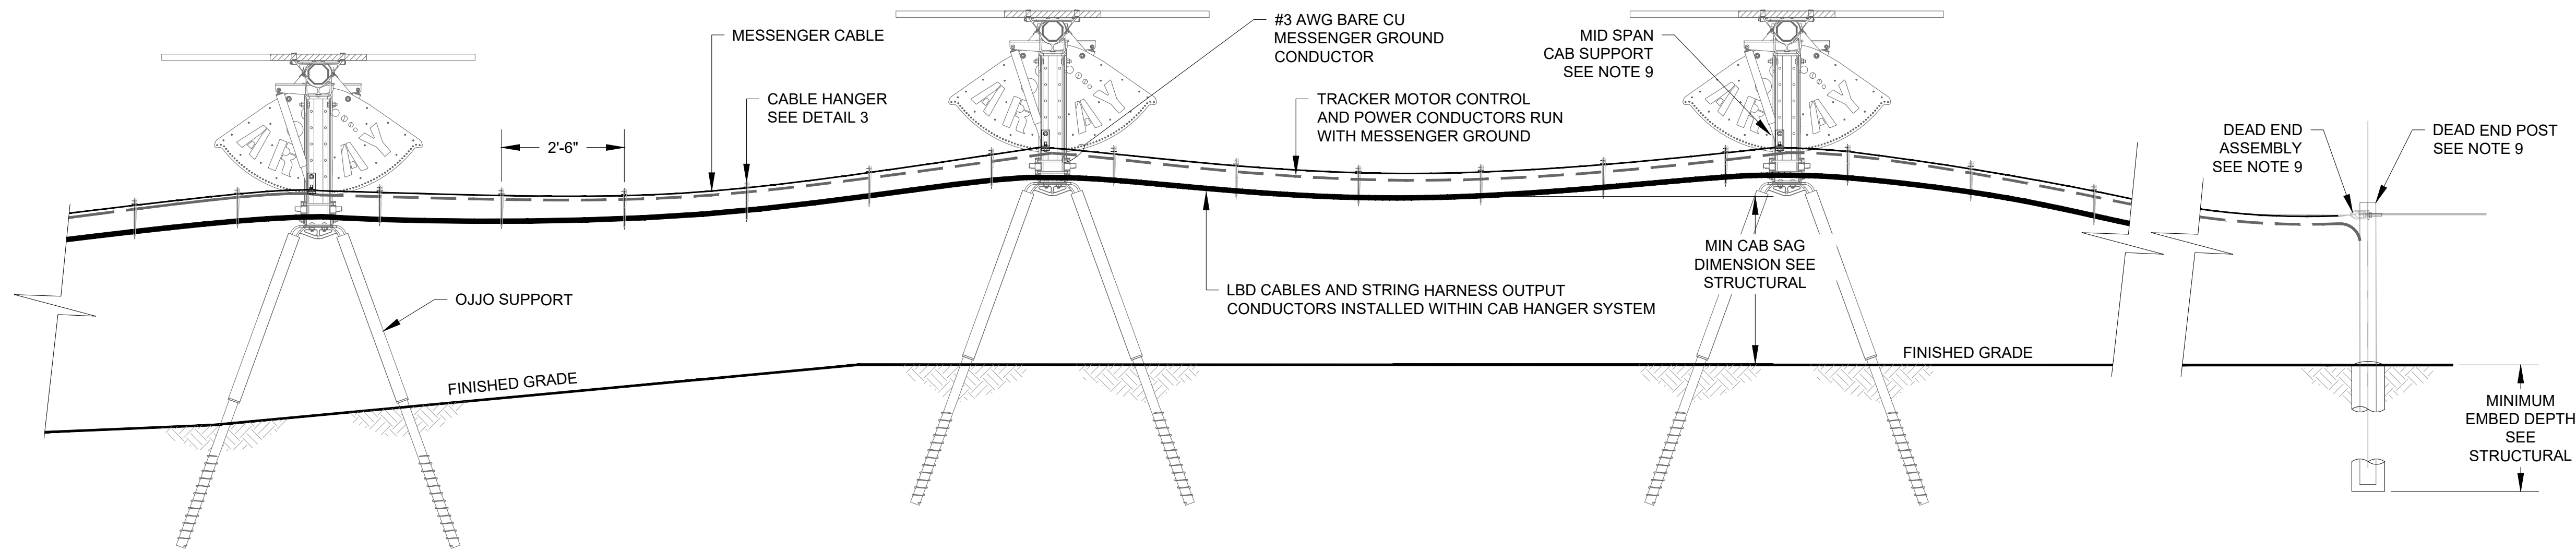


1 CABLE MESSENGER / OJJO RACK SUPPORTS - (JINKO & CANADIAN SOLAR BLOCKS)
SCALE: N.T.S.

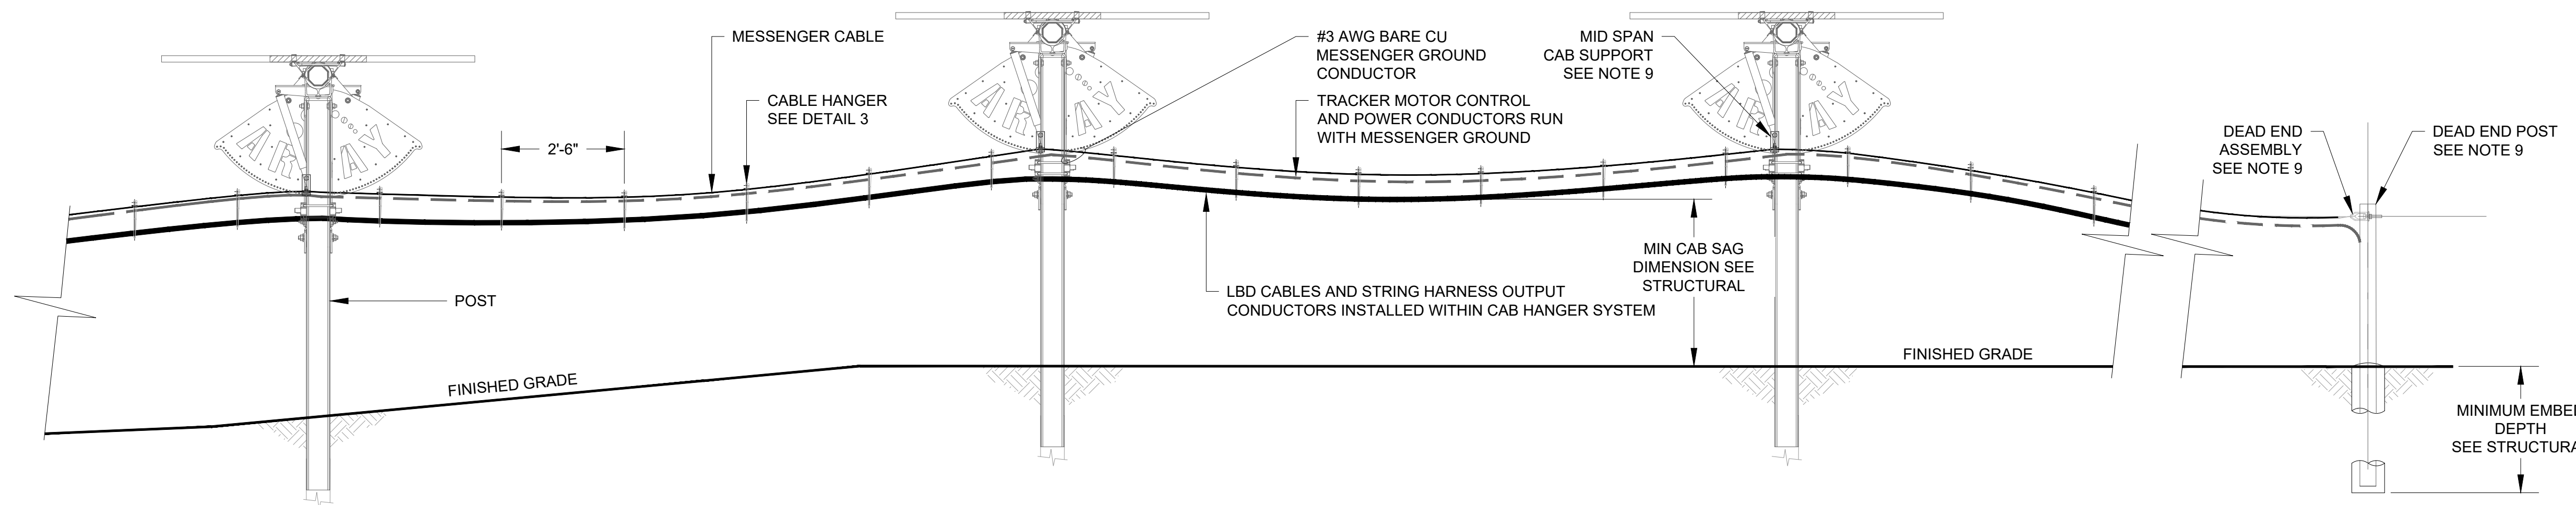


2 CABLE MESSENGER / POST RACK SUPPORTS - (TRINA BLOCKS)
SCALE: N.T.S.

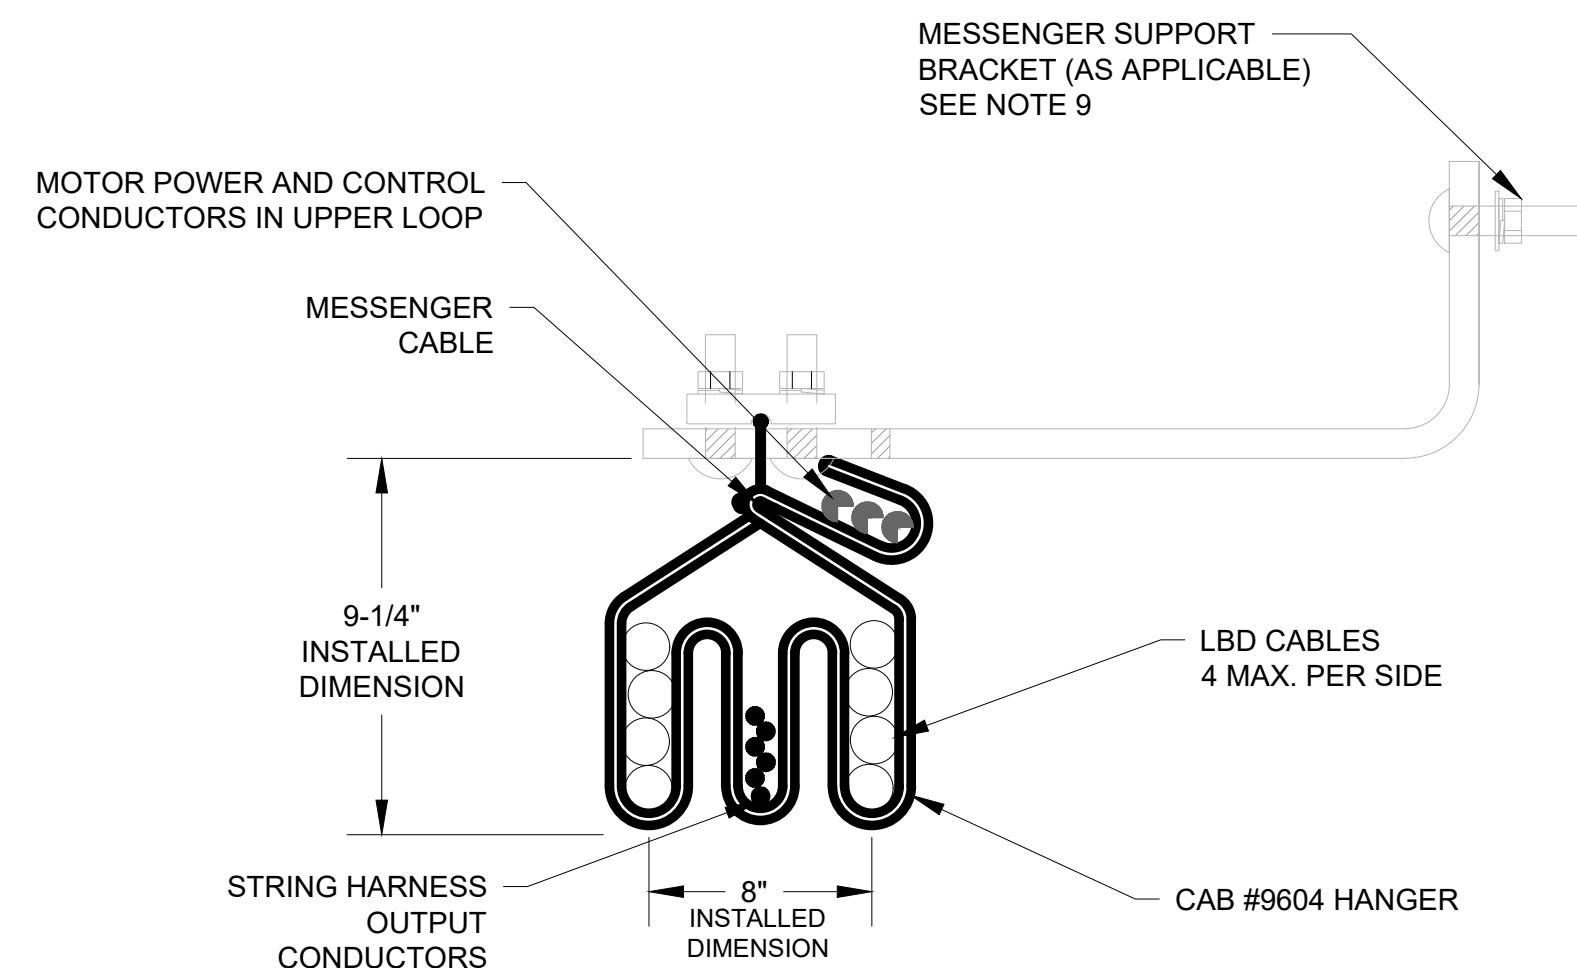

3 TYPICAL CABLE HANGER
SCALE: N.T.S.

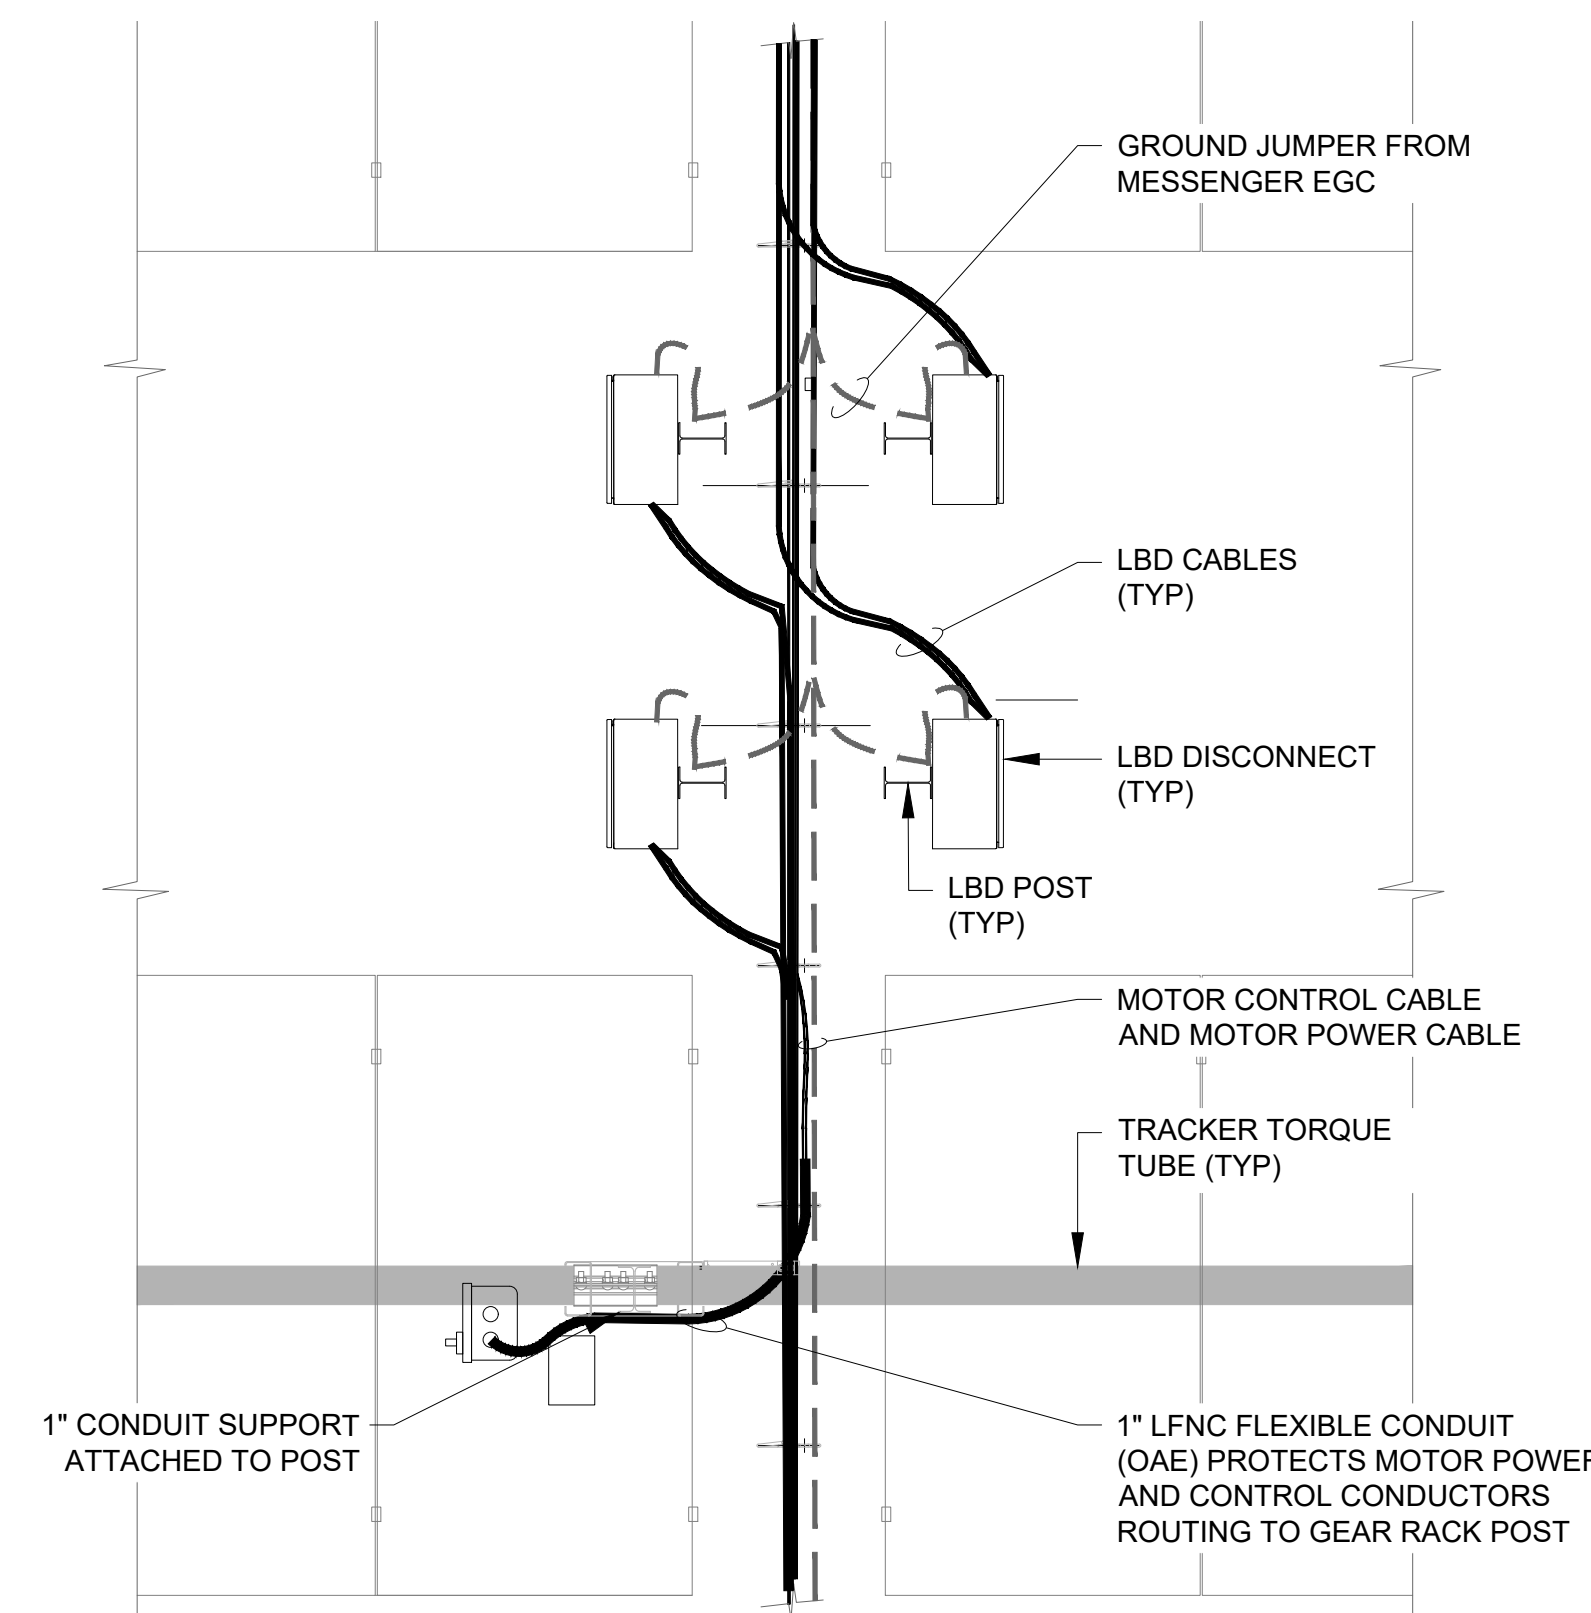

4 LBD DISCONNECT AND TRACKER CAB INTERFACE
SCALE: N.T.S.

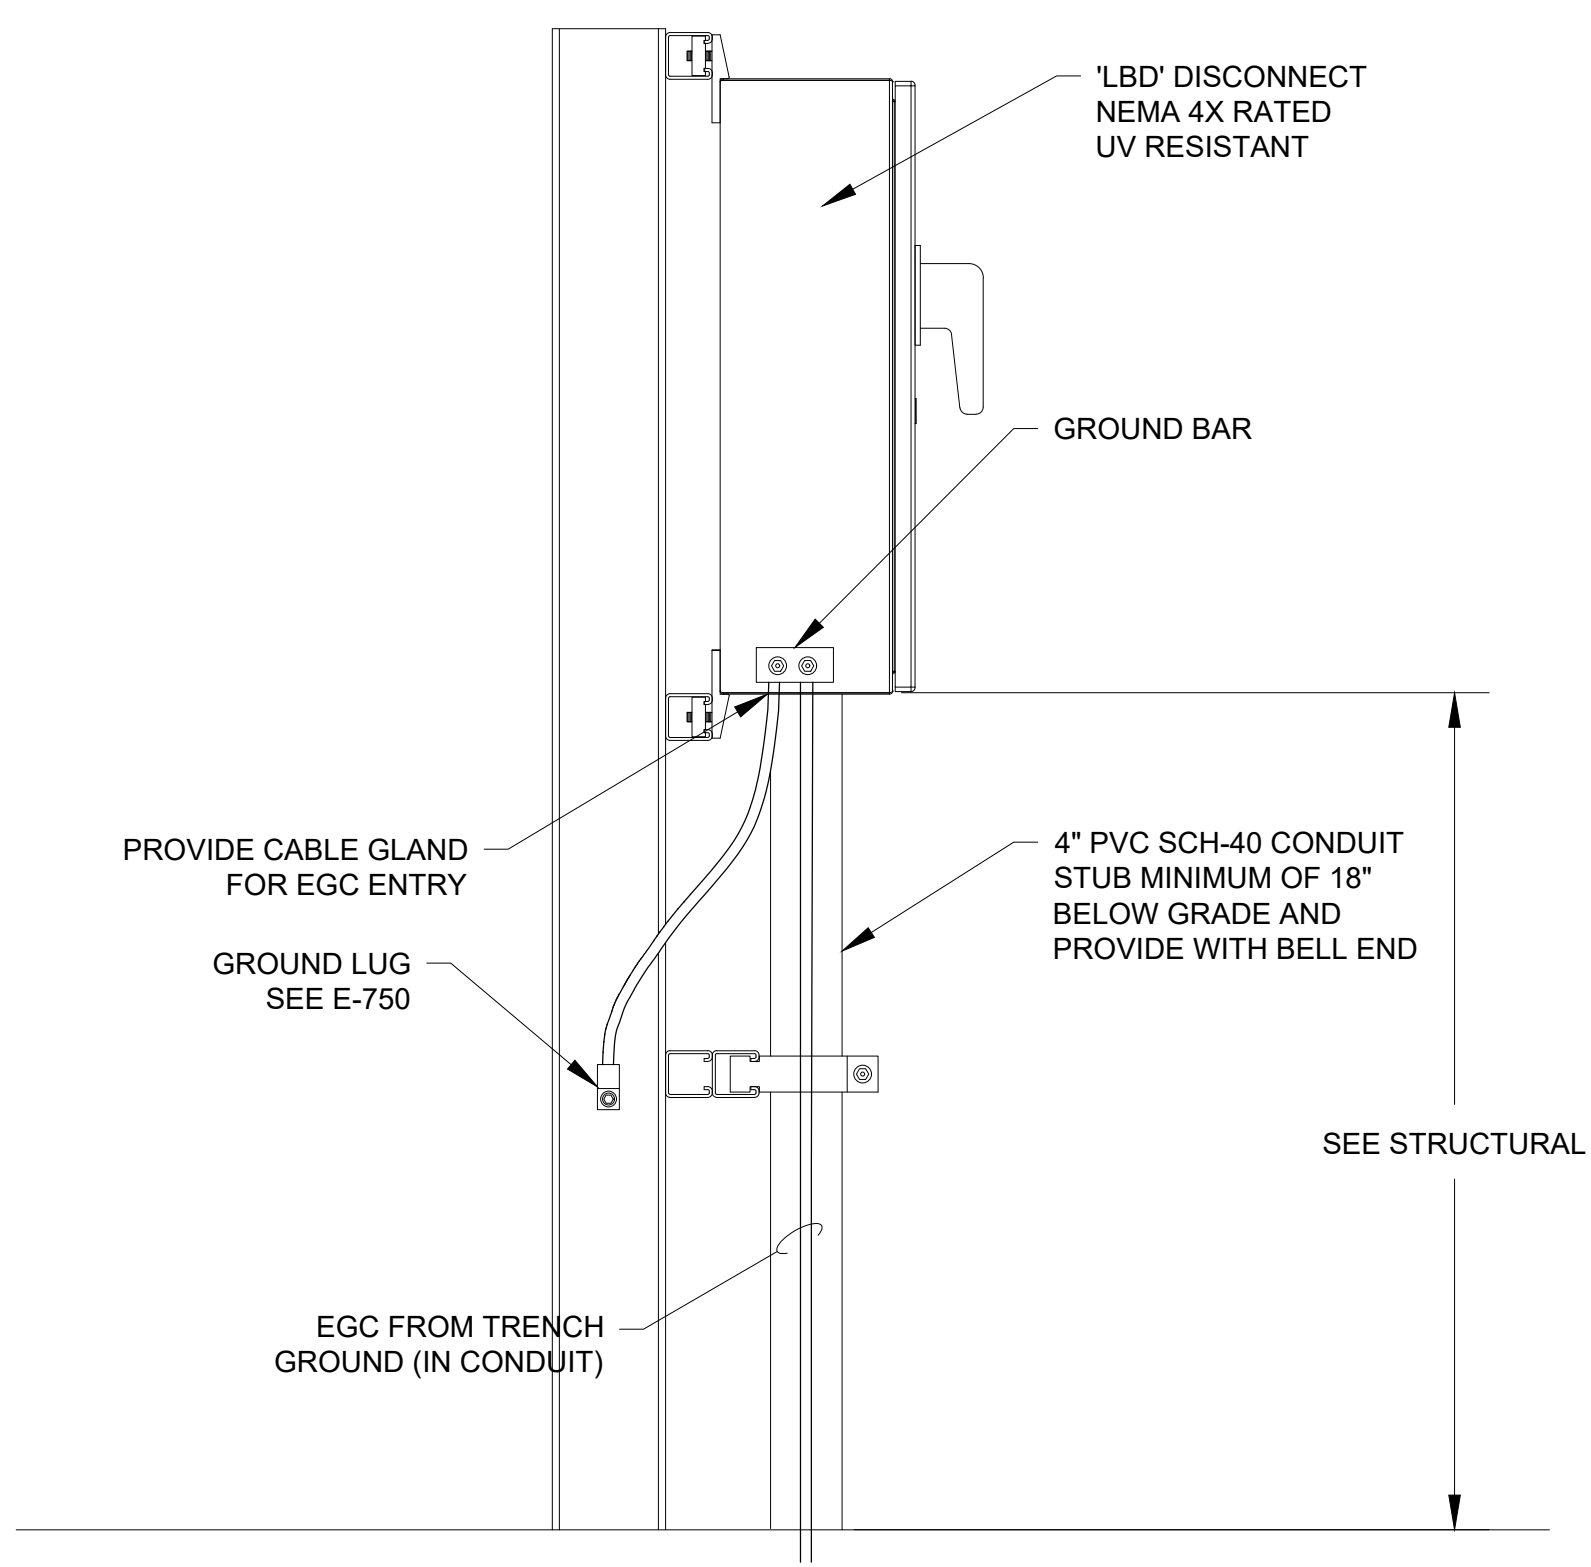

5 LBD DISCONNECT MOUNTING
SCALE: N.T.S.

- NOTES:
1. SECURE ALL CABLES AT EACH CABLE HANGER USING UV-RESISTANT CABLE TIES.
 2. SIMILAR CABLES ARE TO BE SEGREGATED BY CABLE HANGER CARRIER POSITIONS. THE TWO OUTSIDE CARRIER POSITIONS FOR THE LBD CABLES AND LBD OUTPUT CIRCUIT CONDUCTORS. THE UPPER LOOP FOR THE TRACKER MOTOR POWER, CONTROL CABLES, AND #3 GROUND CABLE. SEE DETAIL 3.
 3. THE AMOUNT OF "INITIAL SAG" FOR EACH RUN OF MESSENGER WIRE IS TO BE DETERMINED AT THE TIME OF INSTALLATION, PRIOR TO INSTALLING THE HANGERS AND CABLES. THE "INITIAL SAG" DIMENSION IS TO BE DETERMINED USING TABLE 1 LOCATED IN CAB DOCUMENTATION.
 4. ROUTE POSITIVE AND NEGATIVE LBD CABLES IN THE SAME HANGER POSITION.
 5. PROVIDE A CONTROL CABLE FROM EACH MOTOR CONTROL BOX TO THE 6X CONTROLLER LOCATED AT EACH PCS AREA. PROVIDE MOTOR POWER FROM THE PCS AREA TO EACH MOTOR. MOTOR POWER CABLES MAY BE DAISY CHAINED; REFER TO DRAWINGS E-290 THROUGH E-293 FOR TRACKER MOTOR SLD.
 6. ROUTE MOTOR POWER AND CONTROL CABLE IN CAB SYSTEM AFTER PASSING THROUGH CAB/CONDUIT TRANSITION. SEE NOTE 2.
 7. MOTOR AND DRIVE SHAFT ALWAYS LOCATED ON SOUTH SIDE OF GAP.
 8. REFER TO VENDOR DRAWINGS FOR FURTHER DETAILS AND RECOMMENDATIONS REGARDING TRACKER MOTOR AND LBD DISCONNECT INSTALLATION.
 9. REFER TO STRUCTURAL DRAWINGS FOR THE FOLLOWING INFORMATION:
 - 9.1. END PIER HARDWARE SPECIFICATION AND MOUNTING DETAIL
 - 9.2. MID-PIER HARDWARE SPECIFICATION AND MOUNTING DETAIL
 - 9.3. DEAD END POST DESIGN
 - 9.4. CABLE SAG CALCULATIONS
 - 9.5. CABLE INSTALLATION DIMENSION, MUST MEET FREEBOARD REQUIREMENTS AS INDICATED IN THE HYDROLOGY STUDY.
 - 9.6. COMBINER BOX MOUNTING HEIGHT, MUST MEET FREEBOARD REQUIREMENTS AS INDICATED IN THE HYDROLOGY STUDY.

FastGrid

FastGrid, LLC
225 E Germann Road
Suite 301
Gilbert, AZ 85297

REV	DESCRIPTION	DATE
4	RECORD DRAWINGS	06/08/2023

PROJECT NAME:
**EAGLE SHADOW MOUNTAIN
PV SOLAR POWER
GENERATION FACILITY**

PROJECT ADDRESS:
**I-15
CRYSTAL, NV
CLARK COUNTY**

SEAL:

DATE:
10/16/2020

PROJECT #:
190067.03

DRAWN BY:
NK


CHECKED BY:
EL

SHEET NAME:
CAB DETAILS

SHEET #:
E-492

REV #:
4

RECORD DRAWING

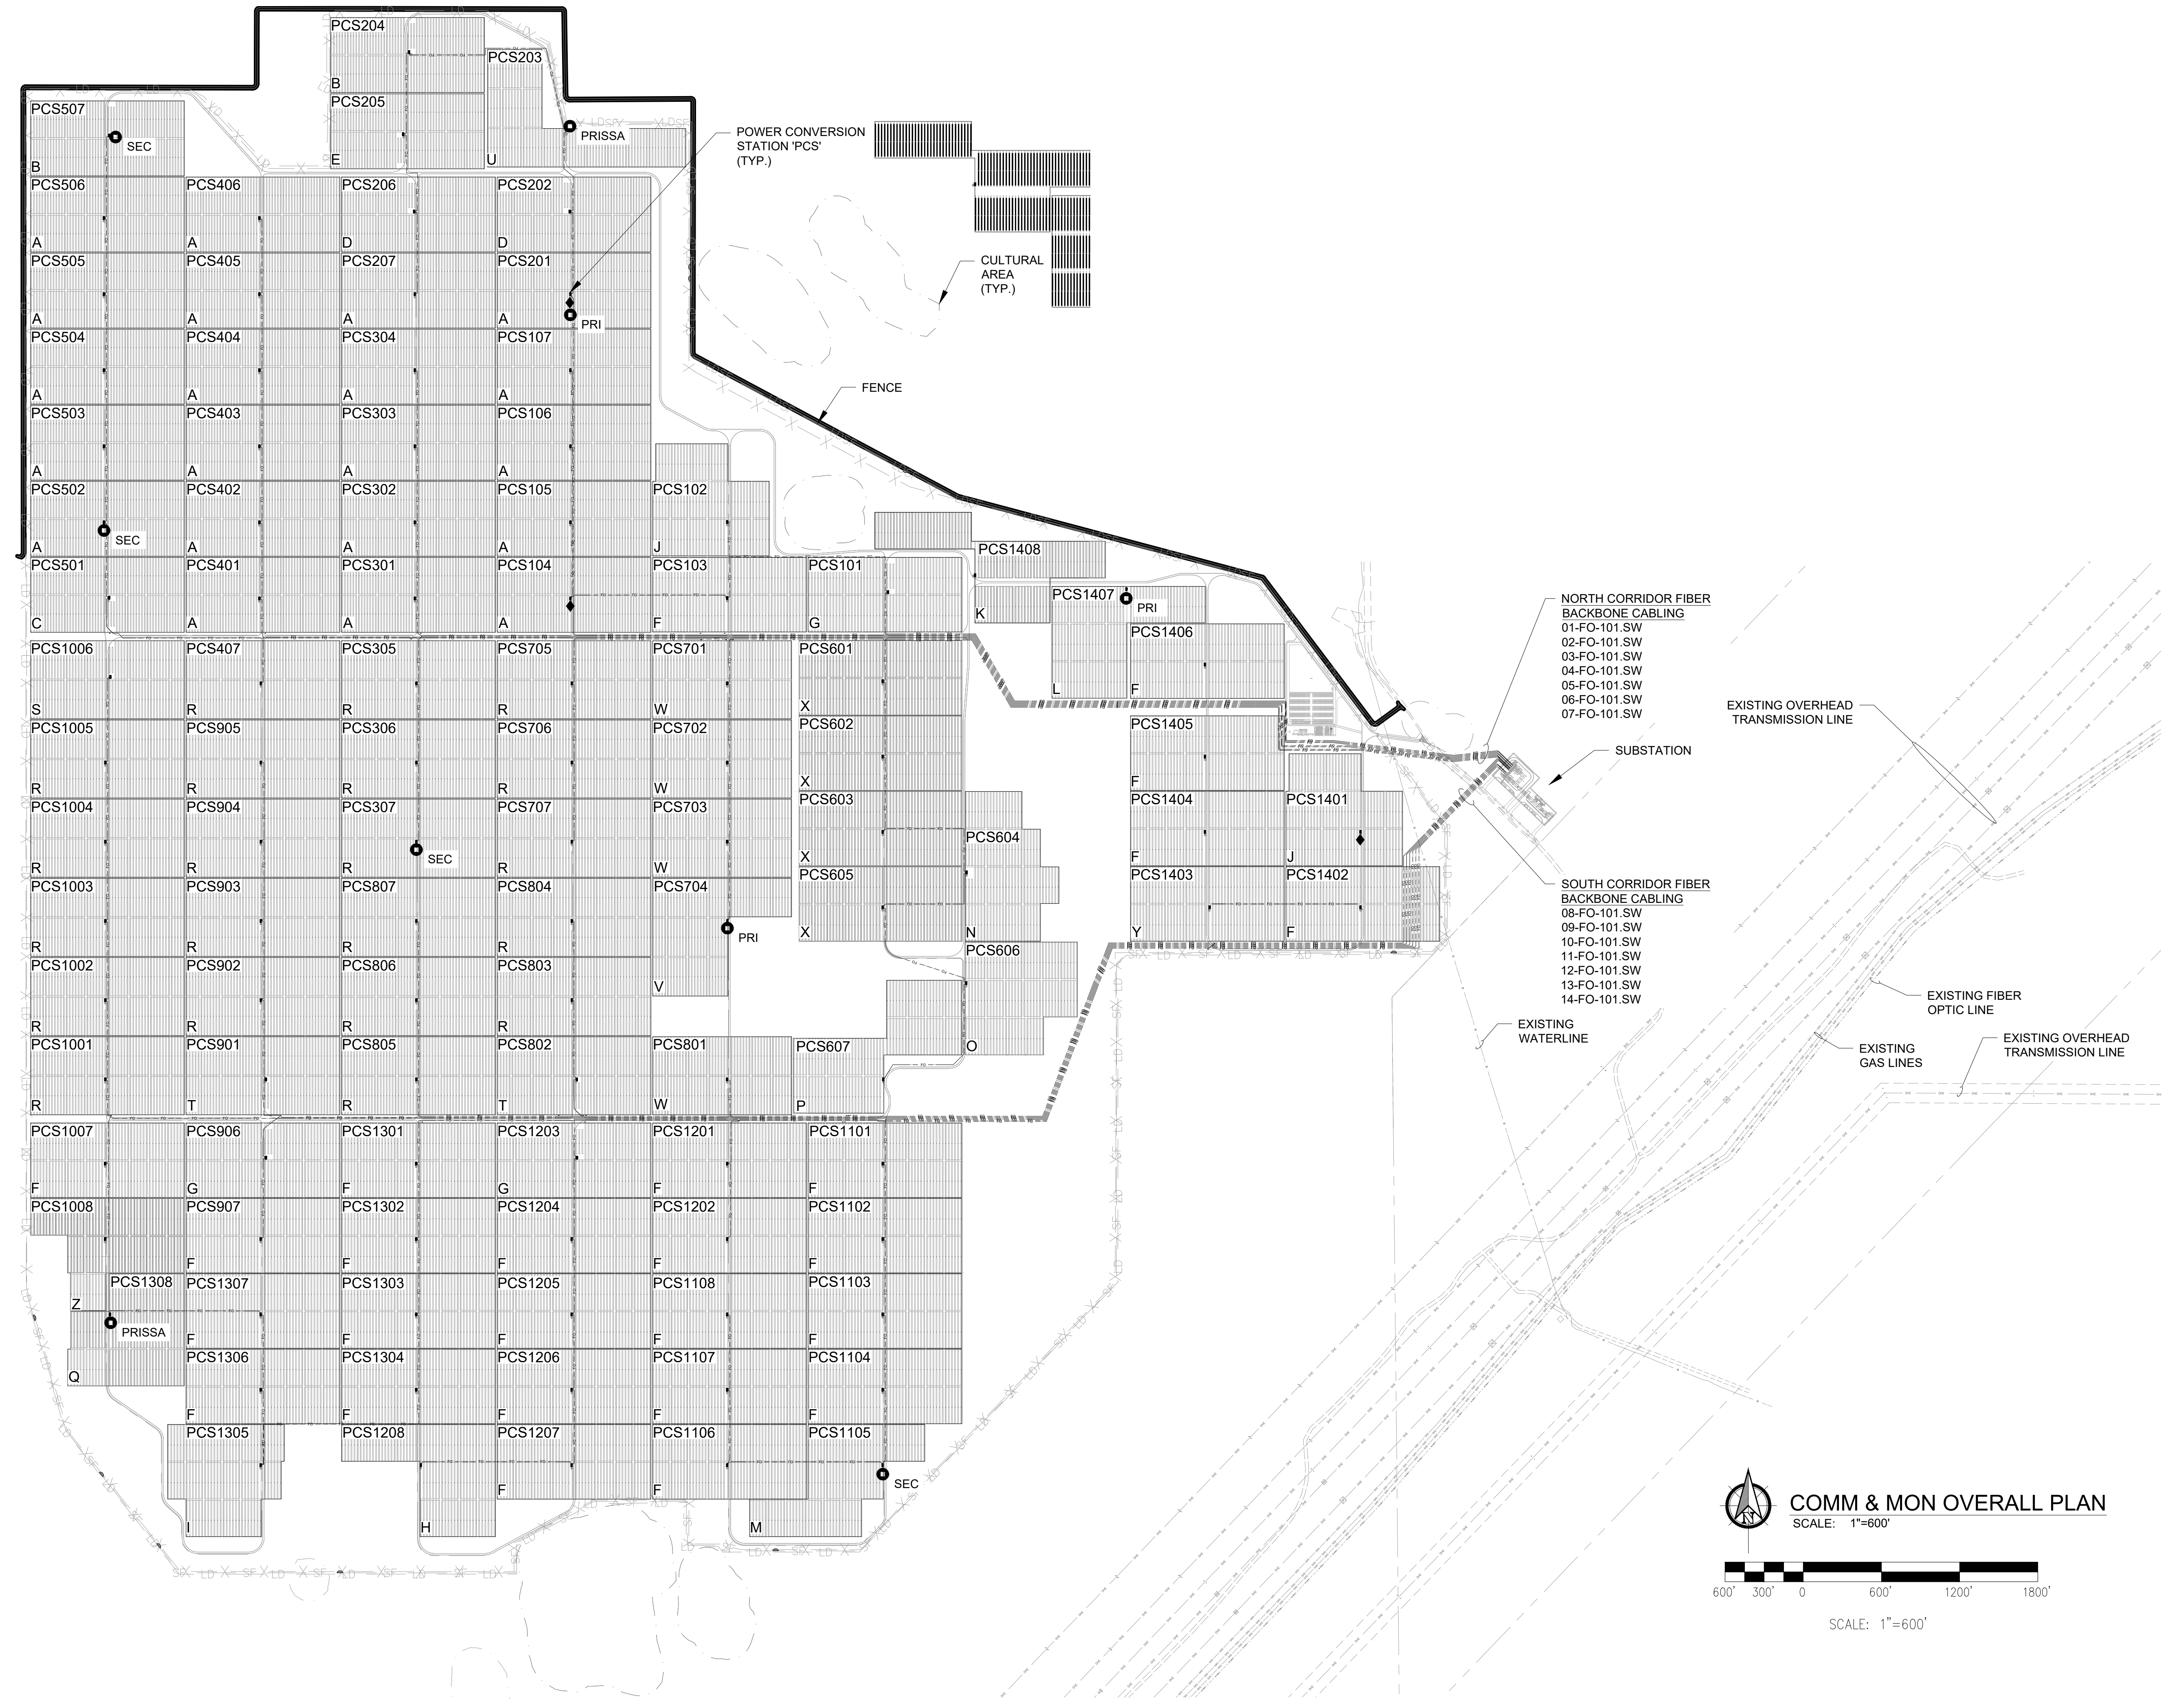

- NOTES:
1. THIS DRAWING IS DIAGRAMMATIC AND INTENDED TO SHOW THE OVERALL TYPICAL ROUTING OF THE FIBER OPTIC CABLE. THE FO CABLE SHALL BE INSTALLED TO SUIT ACTUAL FIELD CONDITIONS AND OTHER DESIGN DRAWINGS
 2. ALL UNDERGROUND CABLES SHALL BE SUITABLE FOR DIRECT BURIAL INSTALLATION.
 3. FIBER OPTIC CABLE INSTALLATION MUST BE COORDINATED TO AVOID ALL OBSTRUCTIONS. REFERENCE STRUCTURAL AND CIVIL DRAWINGS FOR EQUIPMENT LOCATION COORDINATES, GRADING, AND UNDERGROUND OBSTRUCTIONS.
 4. FIBER OPTIC CABLE SHALL BE A MINIMUM DEPTH OF 18" BELOW FINISHED GRADE. WHEN FIBER OPTIC CABLE CROSSES A ROADWAY IT SHALL BE AT A MINIMUM DEPTH OF 30" BELOW FINISHED GRADE.
 5. FIBER OPTIC ROUTING AROUND THE INVERTER IS DIAGRAMMATIC AND INTENDED TO SHOW THE OVERALL INTERCONNECTION. ROUTING IN AND OUT OF THE PCS SHALL BE DETERMINED IN THE FIELD DEPENDING ON THE INSTALLATION METHOD.
 6. REFER TO DRAWINGS E-511 AND E-512 FOR FIBER SINGLE LINE DIAGRAM.

- LEGEND:
- FO FIBER OPTIC CABLE, 24-STRAND
 - ◆ SITE CONTROLLER WITH GPS
 - X MET STATION (X: SEE DESIGNATORS)
- DESIGNATORS:
- PRISSA PRIMARY STATION WITH SOILING STATION AND ALBEDOMETER
 - PRI PRIMARY STATION
 - SEC SECONDARY STATION

NORTH CORRIDOR FIBER BACKBONE CABLING
01-FO-101.SW
02-FO-101.SW
03-FO-101.SW
04-FO-101.SW
05-FO-101.SW
06-FO-101.SW
07-FO-101.SW

SOUTH CORRIDOR FIBER BACKBONE CABLING
08-FO-101.SW
09-FO-101.SW
10-FO-101.SW
11-FO-101.SW
12-FO-101.SW
13-FO-101.SW
14-FO-101.SW

EXISTING OVERHEAD TRANSMISSION LINE

SUBSTATION

EXISTING FIBER OPTIC LINE

EXISTING OVERHEAD TRANSMISSION LINE

EXISTING GAS LINES

EXISTING WATERLINE

COMM & MON OVERALL PLAN
SCALE: 1"=600'

600' 300' 0 600' 1200' 1800'

SCALE: 1"=600'

FastGrid
FastGrid, LLC
225 E Germann Road
Suite 301
Gilbert, AZ 85297

REV	DESCRIPTION	DATE
4	RECORD DRAWINGS	06/08/2023

PROJECT NAME:
**EAGLE SHADOW MOUNTAIN
PV SOLAR POWER
GENERATION FACILITY**

PROJECT ADDRESS:
**I-15
CRYSTAL, NV
CLARK COUNTY**

SEAL: DATE: **10/16/2020**
PROJECT #: **190067.03**
DRAWN BY: **CLH**
CHECKED BY: **EL**

SHEET NAME:
COMM & MON OVERALL PLAN

SHEET #: **E-500** REV #: **4**

RECORD DRAWING



- NOTES:
1. REFER TO DRAWING E-531 FOR DETAILS.
 2. COORDINATE WITH SCADA MANUFACTURER FOR ALL FIBER TERMINATION DETAILS CONNECTORS.
 3. REFER TO DRAWING E-909 FOR FIBER OPTIC DATA SHEETS.

LEGEND:

FO

24-STRAND OS2 SINGLE-MODE FIBER OPTIC CABLE

FPP24

24 PORT FIBER

FastGrid

FastGrid, LLC

225 E Germann Road

Suite 301

Gilbert, AZ 85297

REV	DESCRIPTION	DATE
4	RECORD DRAWINGS	06/08/2023


PROJECT NAME:
**EAGLE SHADOW MOUNTAIN
PV SOLAR POWER
GENERATION FACILITY**

PROJECT ADDRESS:
**I-15
CRYSTAL, NV
CLARK COUNTY**

SEAL:	DATE: 10/16/2020
	PROJECT #: 190067.03
	DRAWN BY: LR
	CHECKED BY: EL

SHEET NAME:
COMM SLD NORTH CORRIDOR

SHEET #: E-511	REV #: 4
--------------------------	--------------------




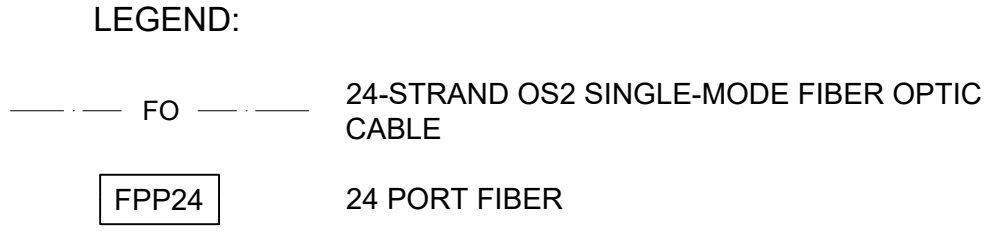


SHEET NAME:	
COMM SLD SOUTH CORRIDOR	
SHEET #:	REV
E-512	#: 4

1 COMMUNICATIONS SLD SOUTH CORRIDOR

SCALE: N.T.S.

MERIT SI MET STATION
FOR REFERENCE ONLY

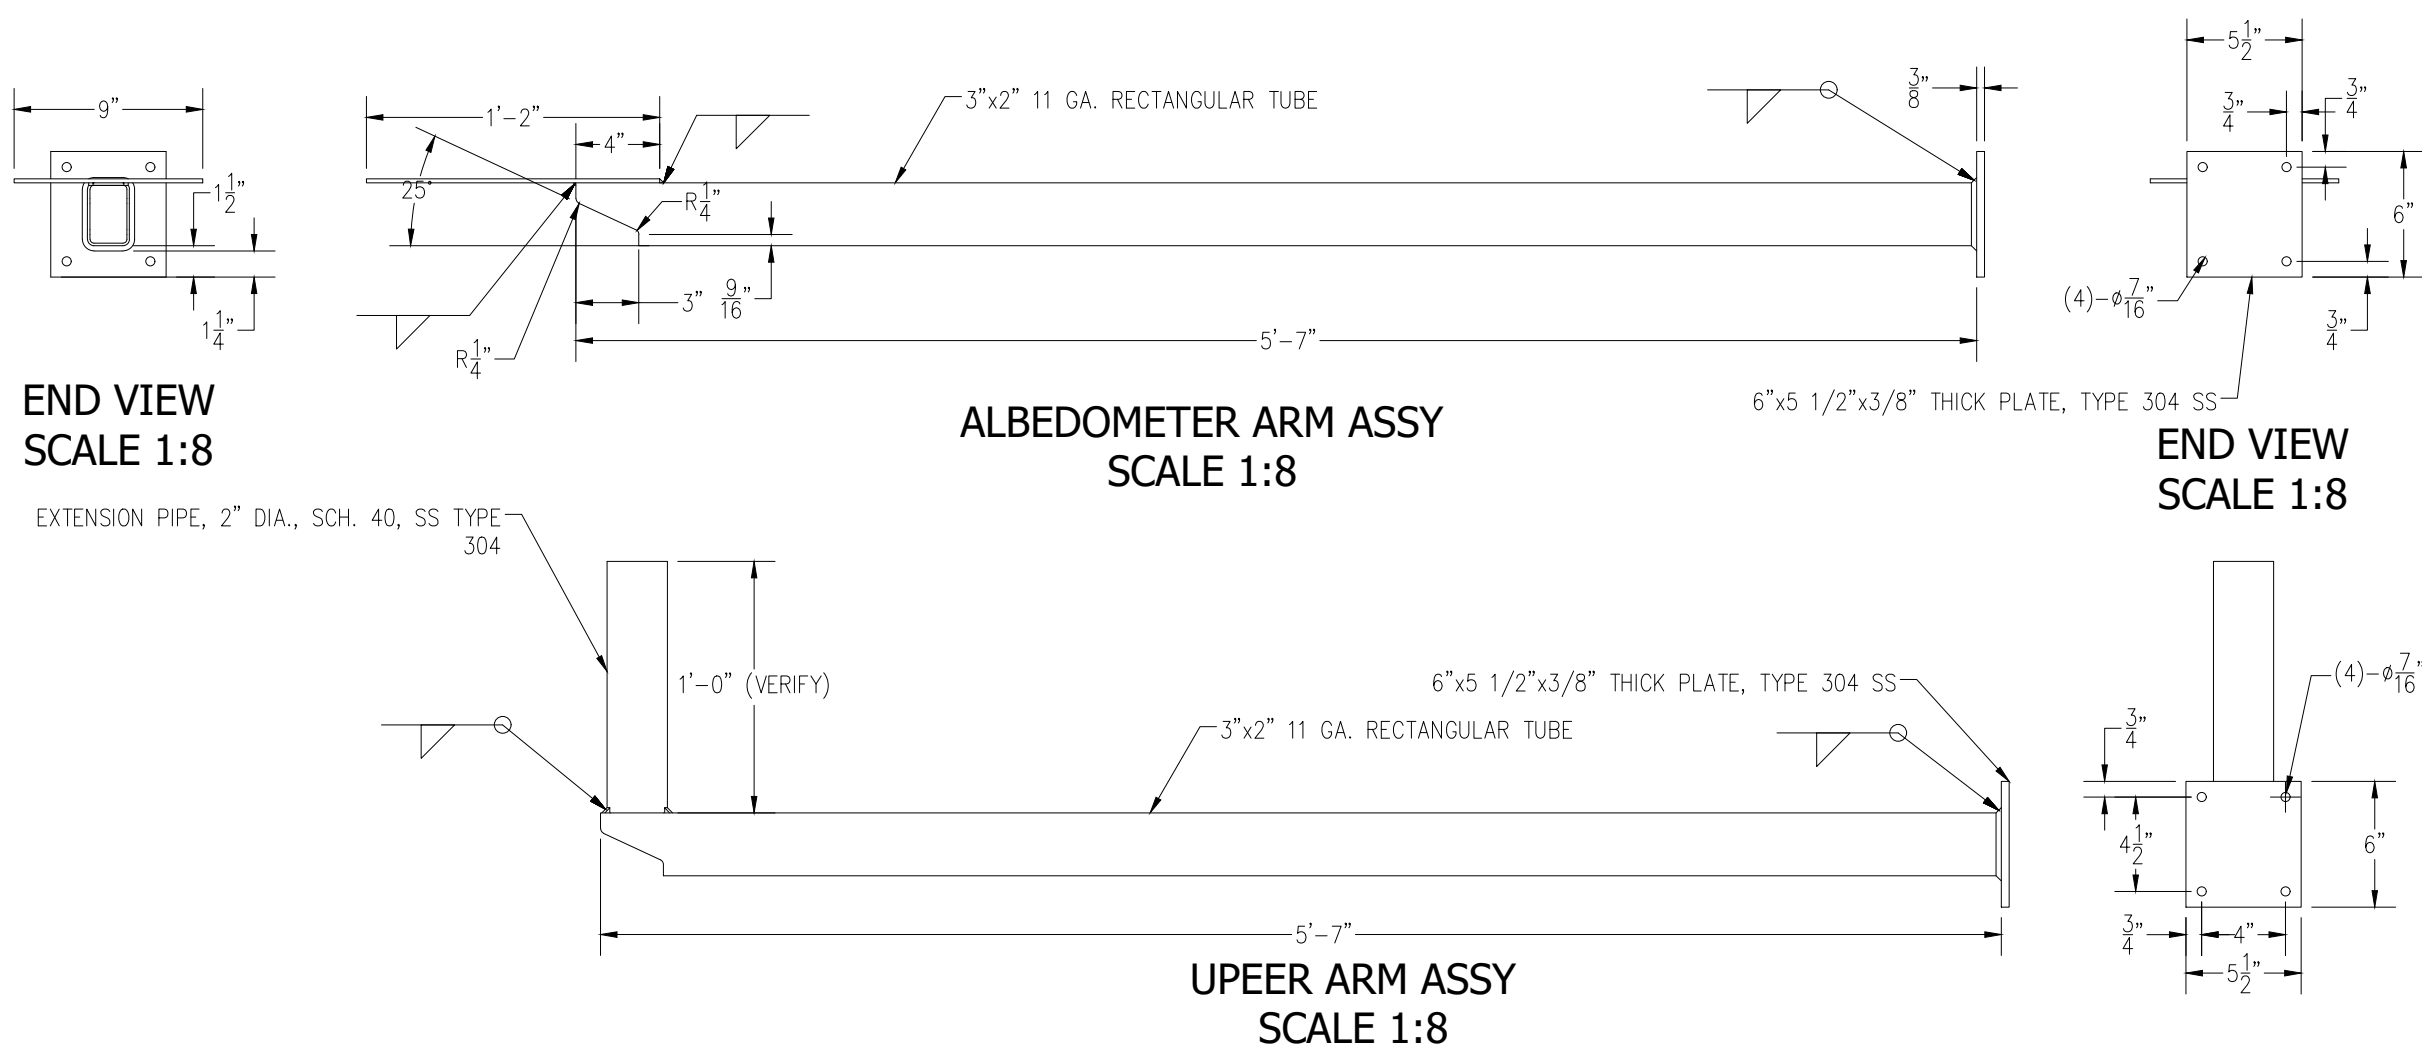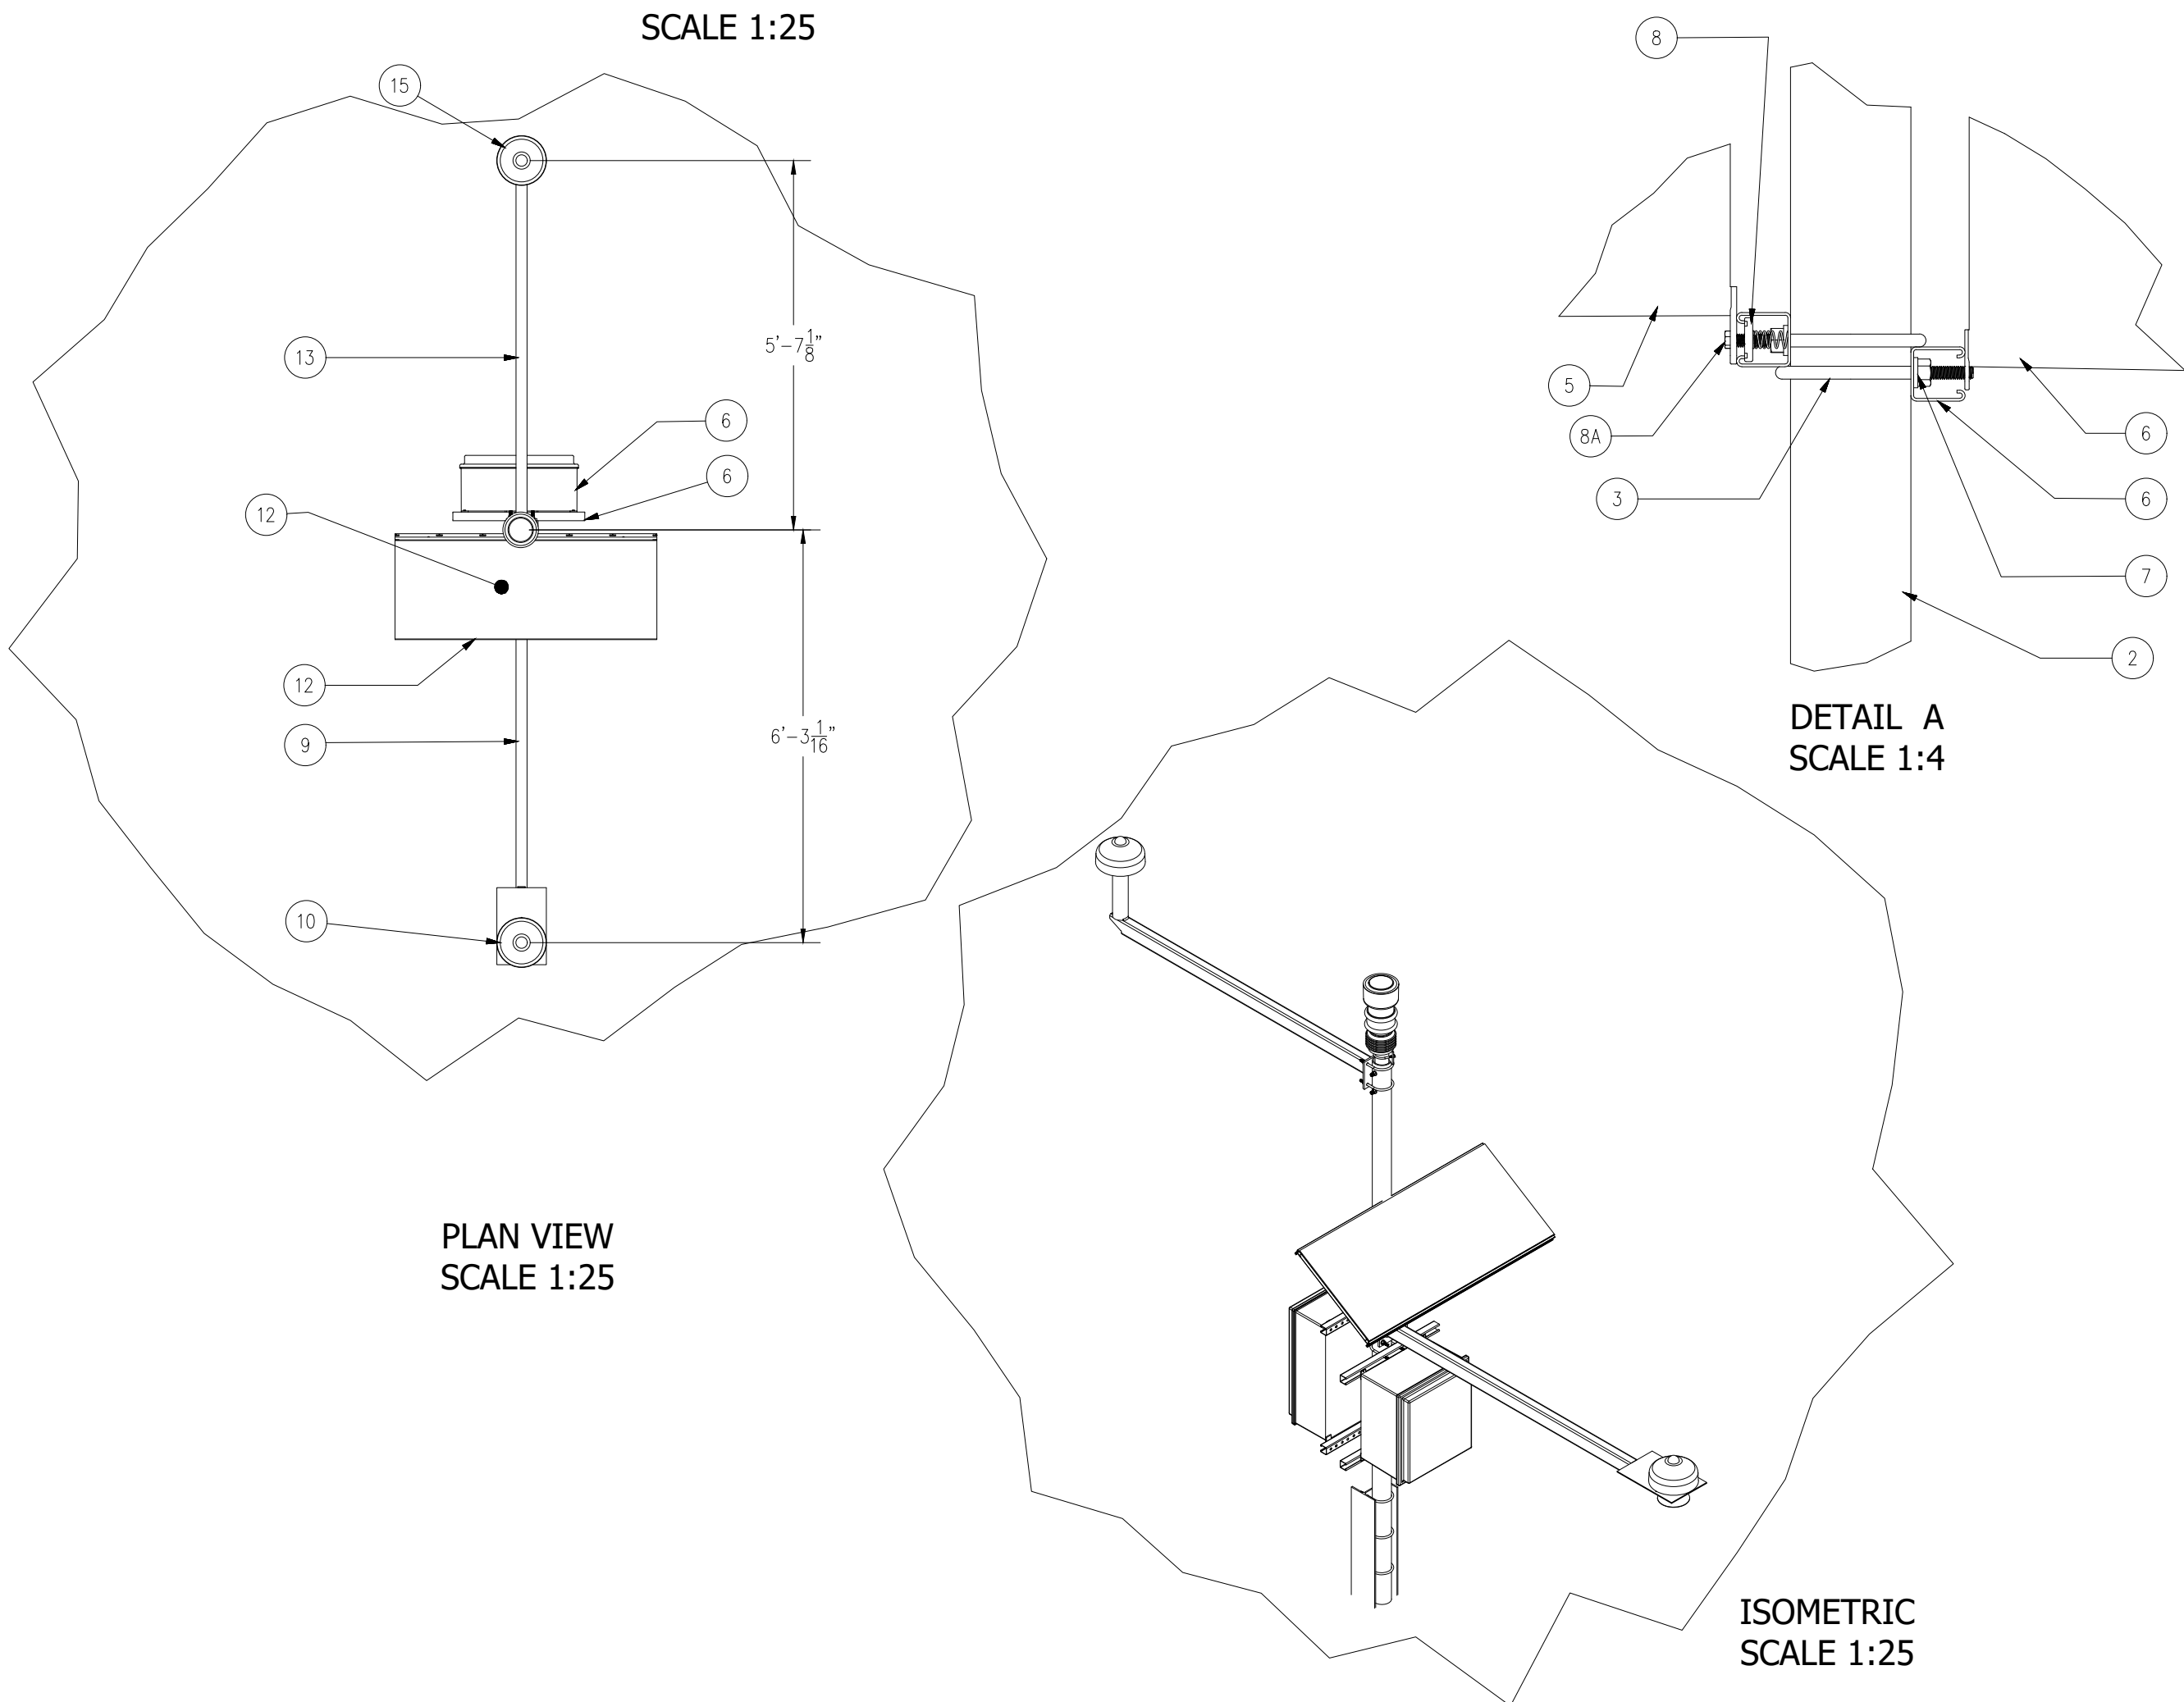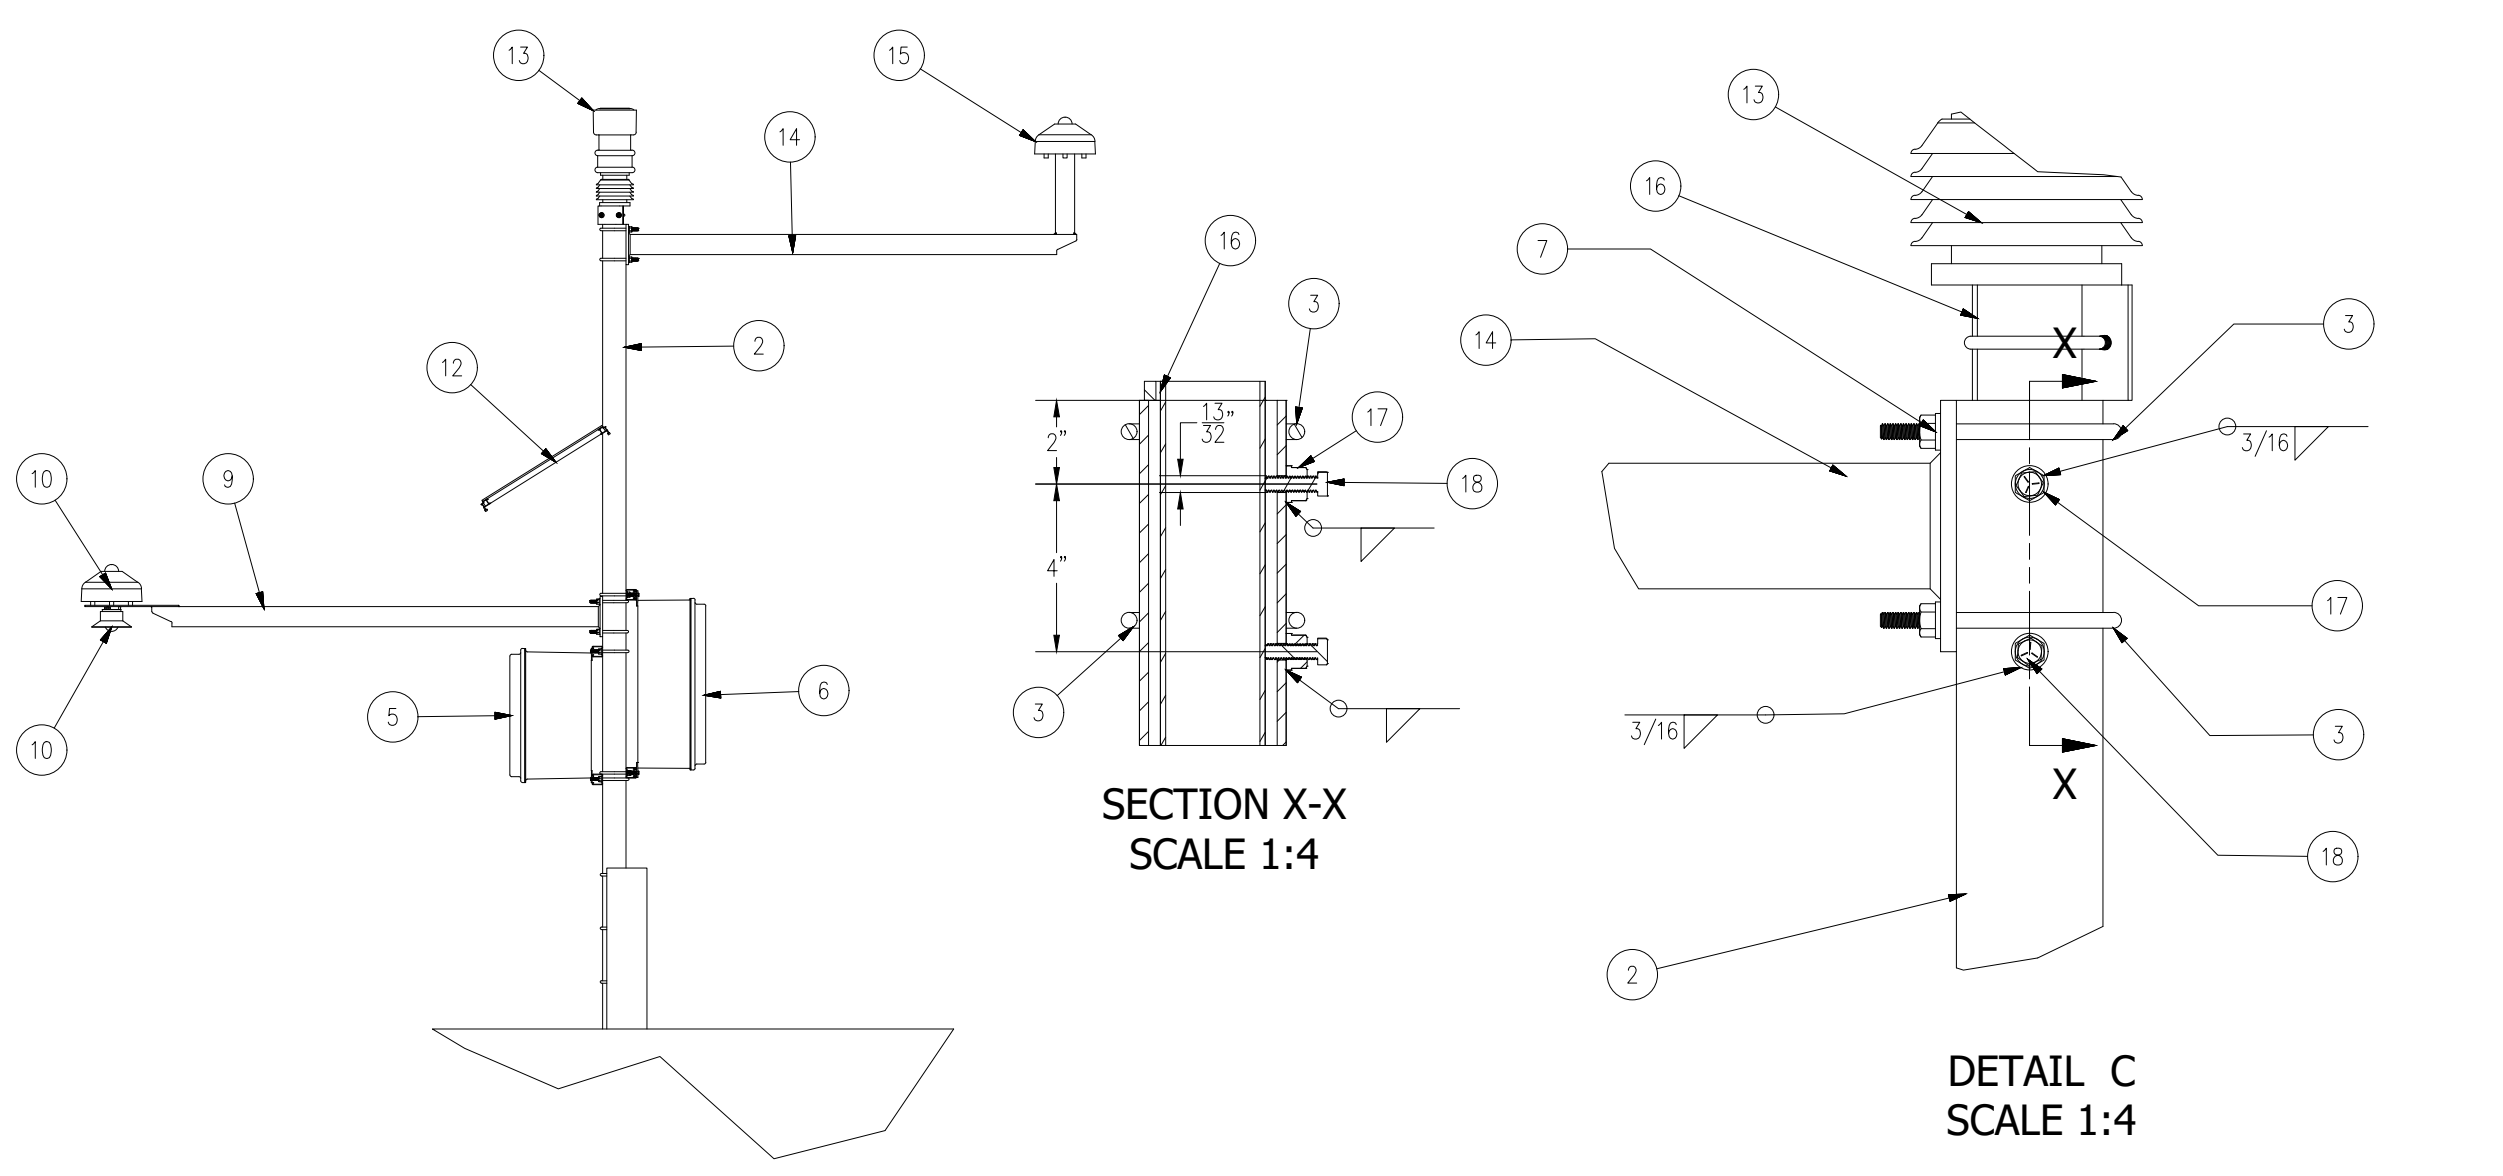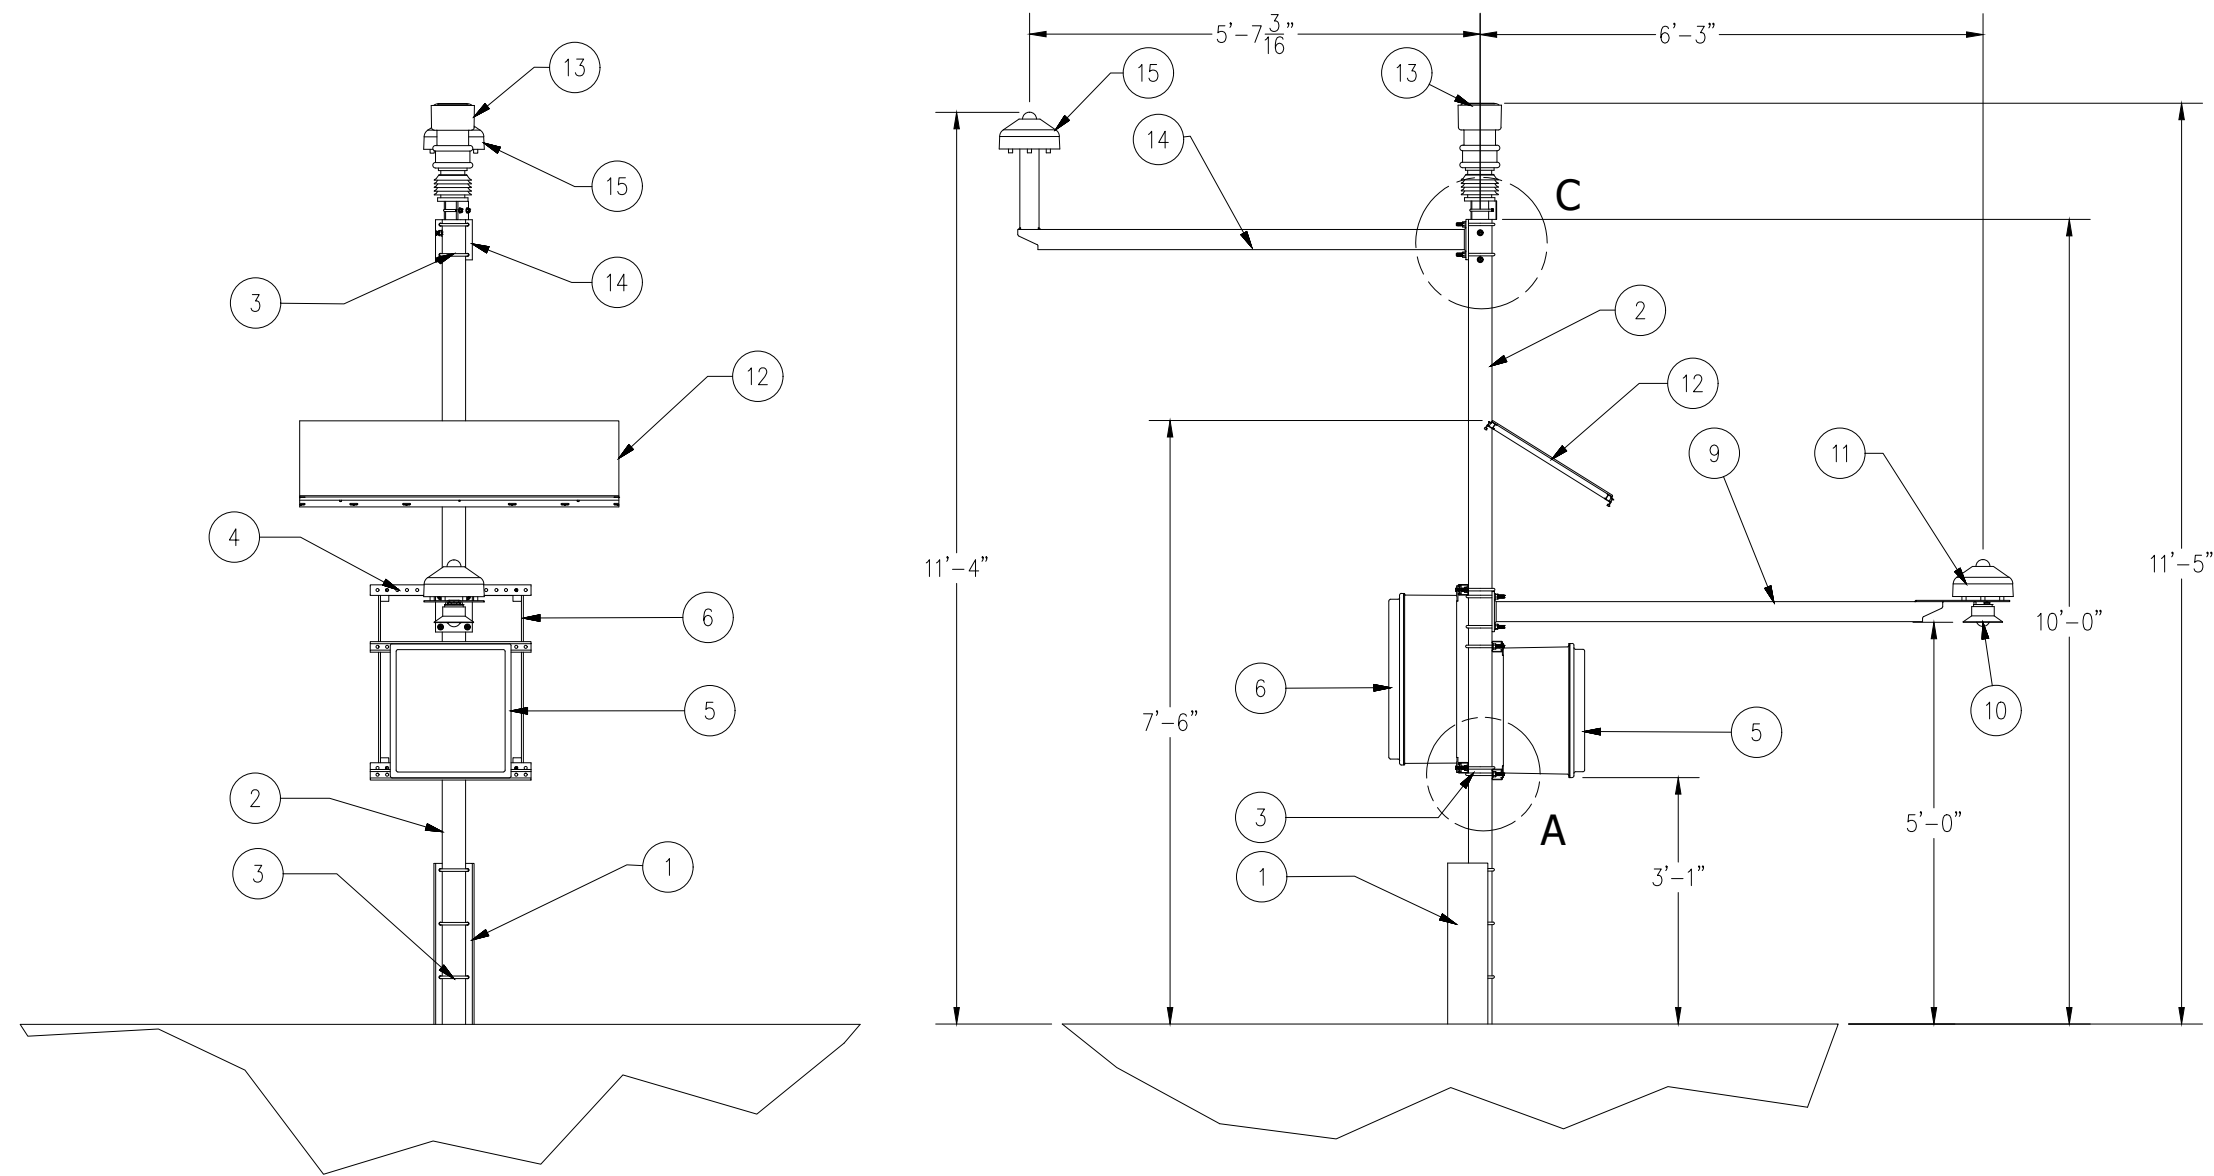

PARTS LIST		
ITEM	QTY	PART NUMBER
1	1	W6 PILE PER EPC WITH (6) 7/16" DIA. HOLES
2	1	PIPE, 3.0" DIA.x10FT. SCH. 40, (3.5" O.D.) TYPE 304, SS
3	11	304 SS U-BOLT-3.625x0.375
4	4	1 5/8"x1-5/8"x 2.0 FT. 12GA. STRUT, TYPE 304 SS
5	1	BATTERY ENCLOSURE
6	1	DATA LOGGER ENCLOSURE
7	1	3/8" -16 TYPE 304, SS FLANGE NUT
8	8	1/4" DIA.-STRUT SPRING NUT WASHER
8A	8	1/4" DIA. x 1" CAP SCREW, TYPE 304, SS
9	1	ALBEDOMETER ARM ASSY, SEE DETAIL
10	1	CMP10 BOHI & CLARE SCREEN
11	1	CMP10 GH
12	1	SOLAR PANEL ASSY WITH COMPLETE ATTACHMENT
13	1	W6601
14	1	UPPER ARM ASSY, SEE DETAIL
15	1	SPNI GH
16	1	PIPE, 2.0" DIA.x12", SCH. 40, TYPE 304, SS
17	2	3/8"-16 NUT WELDED TO PIPE MAST, TYPE 304, SS
18	2	3/8"-16x1 1/2 FULLY THREADED, HEX HEAD CAP SCREW, TYPE 304 SS

FastGrid

FastGrid, LLC
225 E Germann Road
Suite 301
Gilbert, AZ 85297

REV	DESCRIPTION	DATE
4	RECORD DRAWINGS	06/08/2023

PROJECT NAME:
**EAGLE SHADOW MOUNTAIN
PV SOLAR POWER
GENERATION FACILITY**

PROJECT ADDRESS:
**I-15
CRYSTAL, NV
CLARK COUNTY**

SEAL:

DATE:
10/16/2020

PROJECT #:
190067.03


DRAWN BY:
NK

CHECKED BY:
EL


SHEET NAME:
MET STATION DETAILS

SHEET #:
E-521

REV #:
4

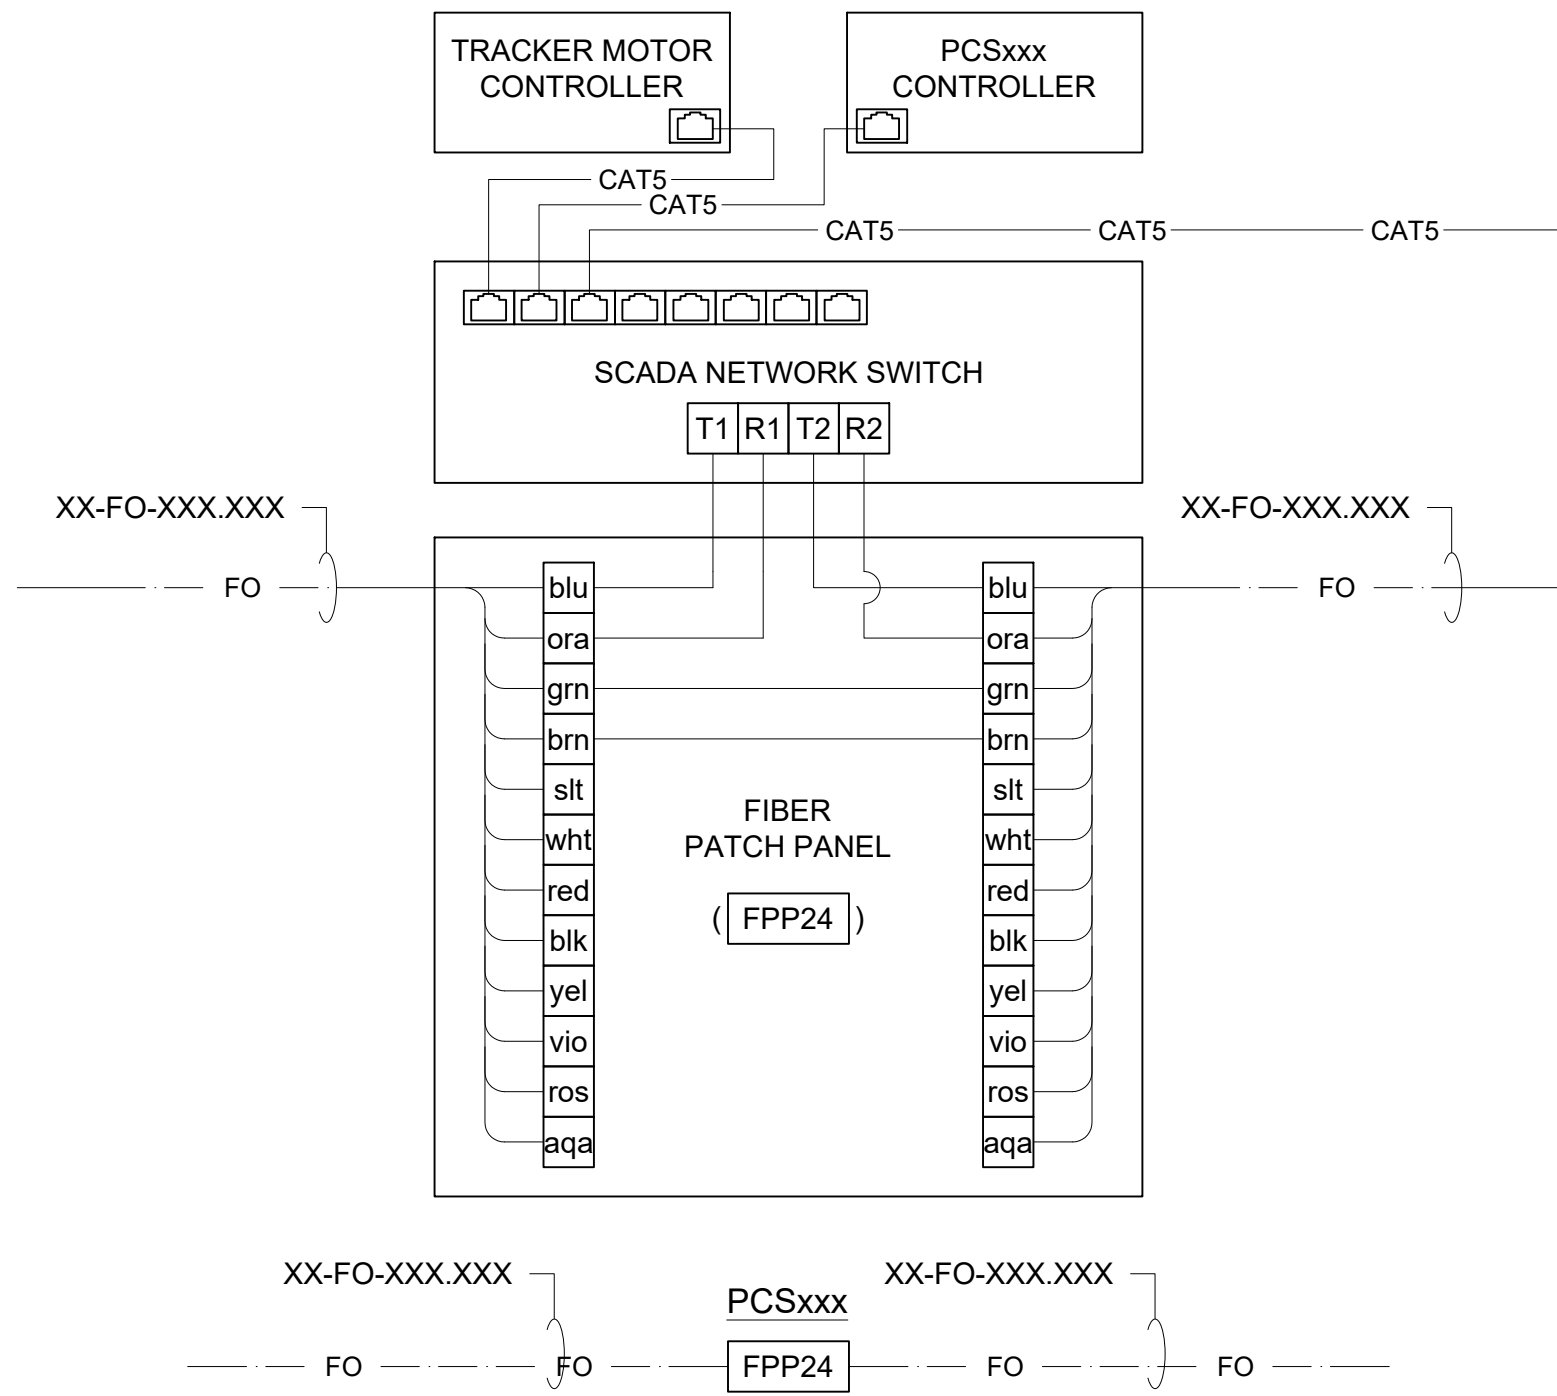

1 SCADA PATCH-THROUGH CONNECTIONS AT PCSxxx
SCALE: N.T.S.

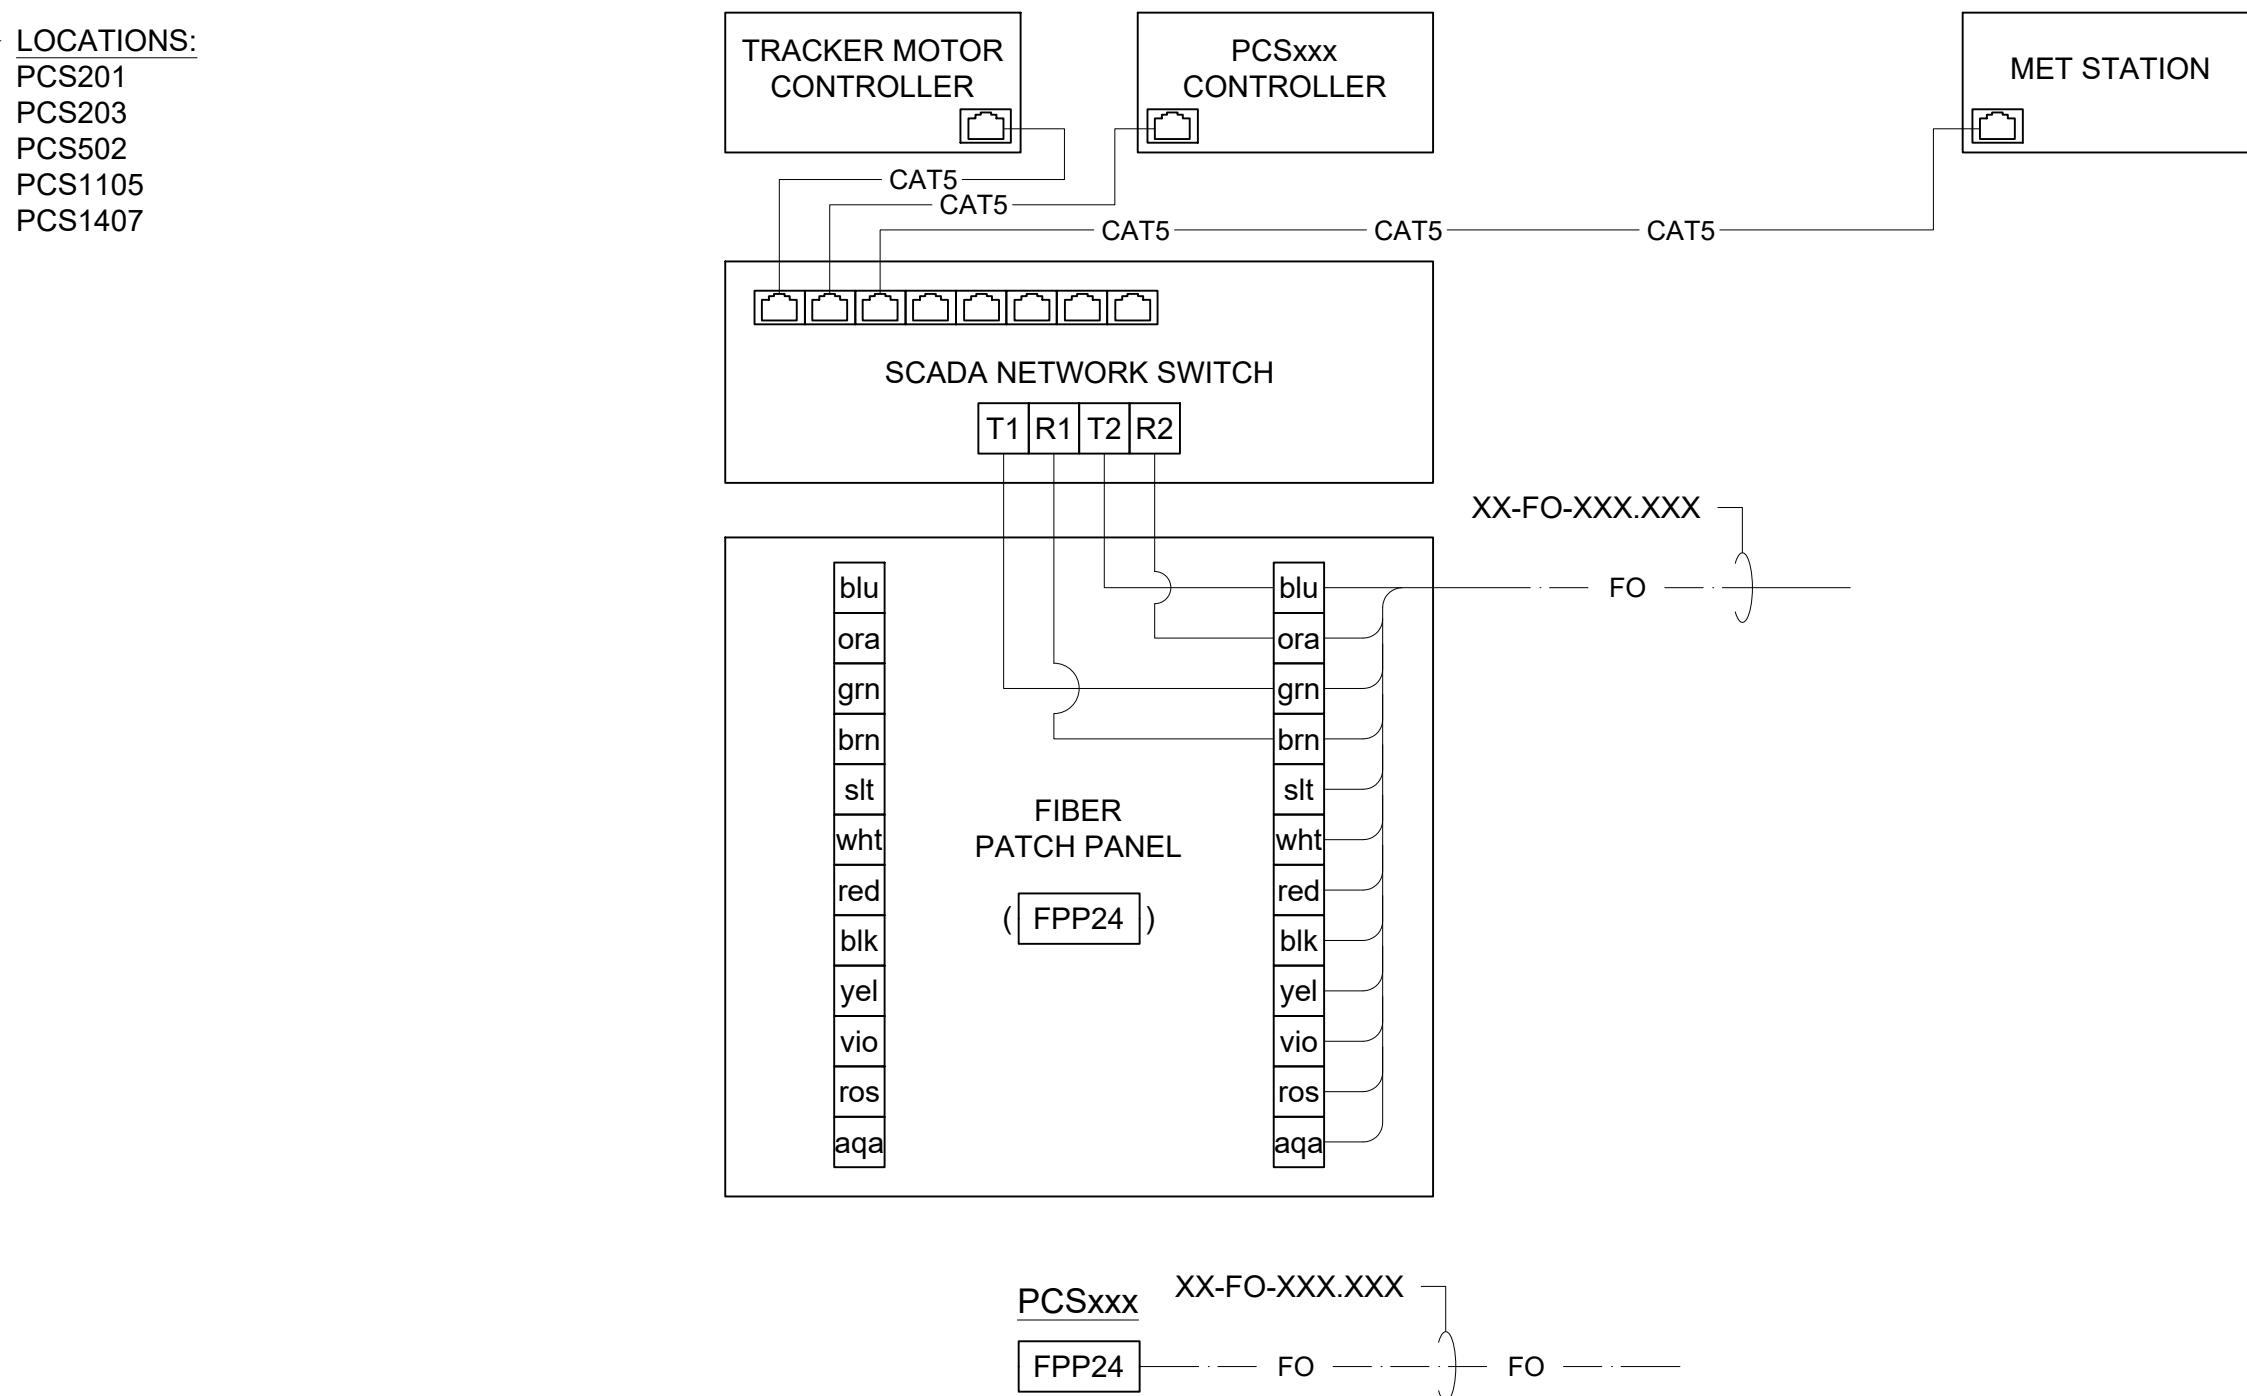

2 SCADA END-OF-LINE CONNECTIONS AT PCSxxx
SCALE: N.T.S.

- NOTES:
- REFER TO DRAWING E-531 FOR DETAILS.
 - PROVIDE FIBER OPTIC CABLING WITH TYPE ST CONNECTORS.
 - REFER TO DRAWING E-909 FOR FIBER OPTIC DATA SHEETS.

- LEGEND:
- FO 24-STRAND OS2 SINGLE-MODE FIBER OPTIC CABLE
 - CAT5 CAT5E CABLE
 - FPP24 24 PORT FIBER



REV	DESCRIPTION	DATE
4	RECORD DRAWINGS	06/08/2023

PROJECT NAME:
EAGLE SHADOW MOUNTAIN
PV SOLAR POWER
GENERATION FACILITY

PROJECT ADDRESS:
I-15
CRYSTAL, NV
CLARK COUNTY

SEAL:	DATE: 10/16/2020
	PROJECT #: 190067.03
	DRAWN BY: LR
	CHECKED BY: EL

SHEET NAME:
COMM DETAILS

SHEET #: E-531	REV #: 4
-------------------	-------------


AS BUILT

SAVED BY: EridLoos

PLOT BY: Brady Burgesson

PLOT DATE: Thursday, June 08, 2023

LOCATION: K:\09_PROJECTS\190067.03 - PRIMORIS - EAGLE SHADOW MOUNTAIN\05 ENGINEERING\DWG\E-531 COMM DETAILS

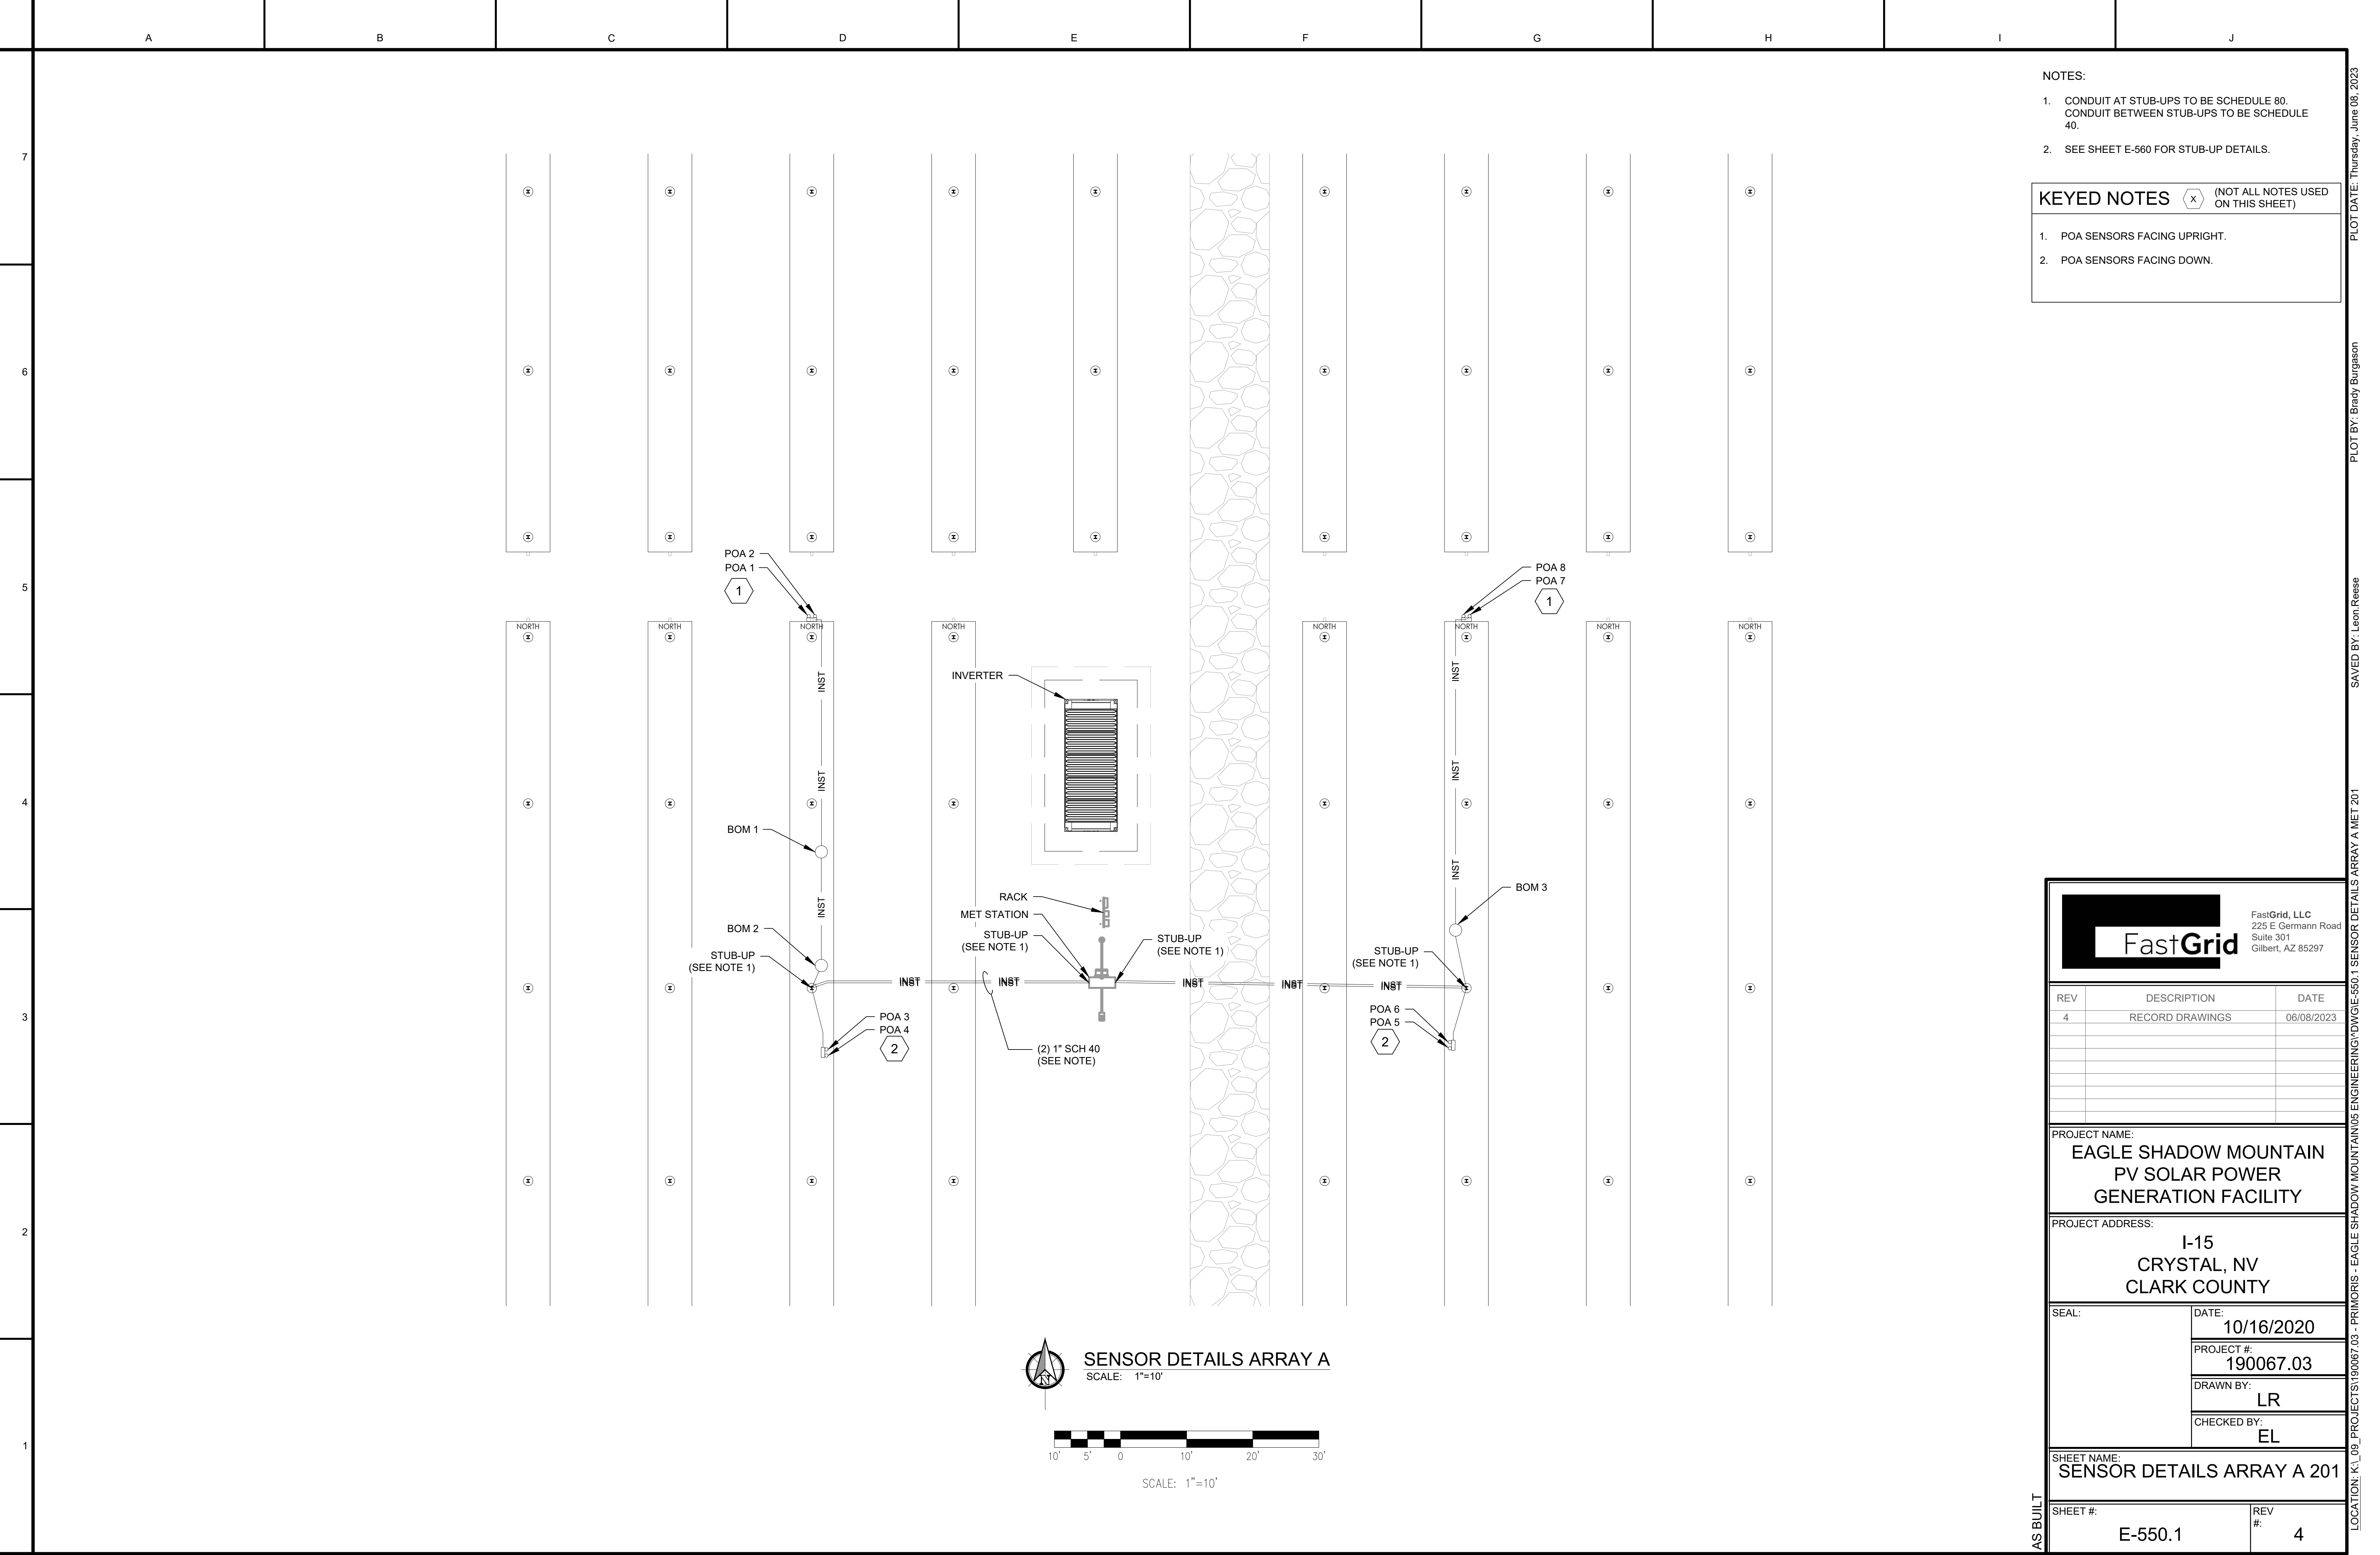

NOTES:

1. CONDUIT AT STUB-UPS TO BE SCHEDULE 80.
CONDUIT BETWEEN STUB-UPS TO BE SCHEDULE 40.

2. SEE SHEET E-560 FOR STUB-UP DETAILS.

KEYED NOTES

1. POA SENSORS FACING UPRIGHT.

2. POA SENSORS FACING DOWN.

FastGrid

FastGrid, LLC

225 E Germann Road

Suite 301

Gilbert, AZ 85297

REV	DESCRIPTION	DATE
4	RECORD DRAWINGS	06/08/2023

PROJECT NAME:

EAGLE SHADOW MOUNTAIN
PV SOLAR POWER
GENERATION FACILITY

PROJECT ADDRESS:

I-15
CRYSTAL, NV
CLARK COUNTY

SEAL:

DATE:
10/16/2020

PROJECT #:
190067.03

DRAWN BY:
LR

CHECKED BY:
EL

SHEET NAME:

SENSOR DETAILS ARRAY A 201

SHEET #:
E-550.1

REV #:
4

AS BUILT

SENSOR DETAILS ARRAY A

SCALE: 1"=10'

SCALE: 1"=10'


AS BUILT

LOCATION: K:\09_PROJECTS\190067.03 - PRIMORIS - EAGLE SHADOW MOUNTAIN\05_ENGINEERING\DWG\E-550.1 SENSOR DETAILS ARRAY A.MET 201

SAVED BY: Leon Reese

PLOT BY: Brady Burgess

PLOT DATE: Thursday, June 08, 2023

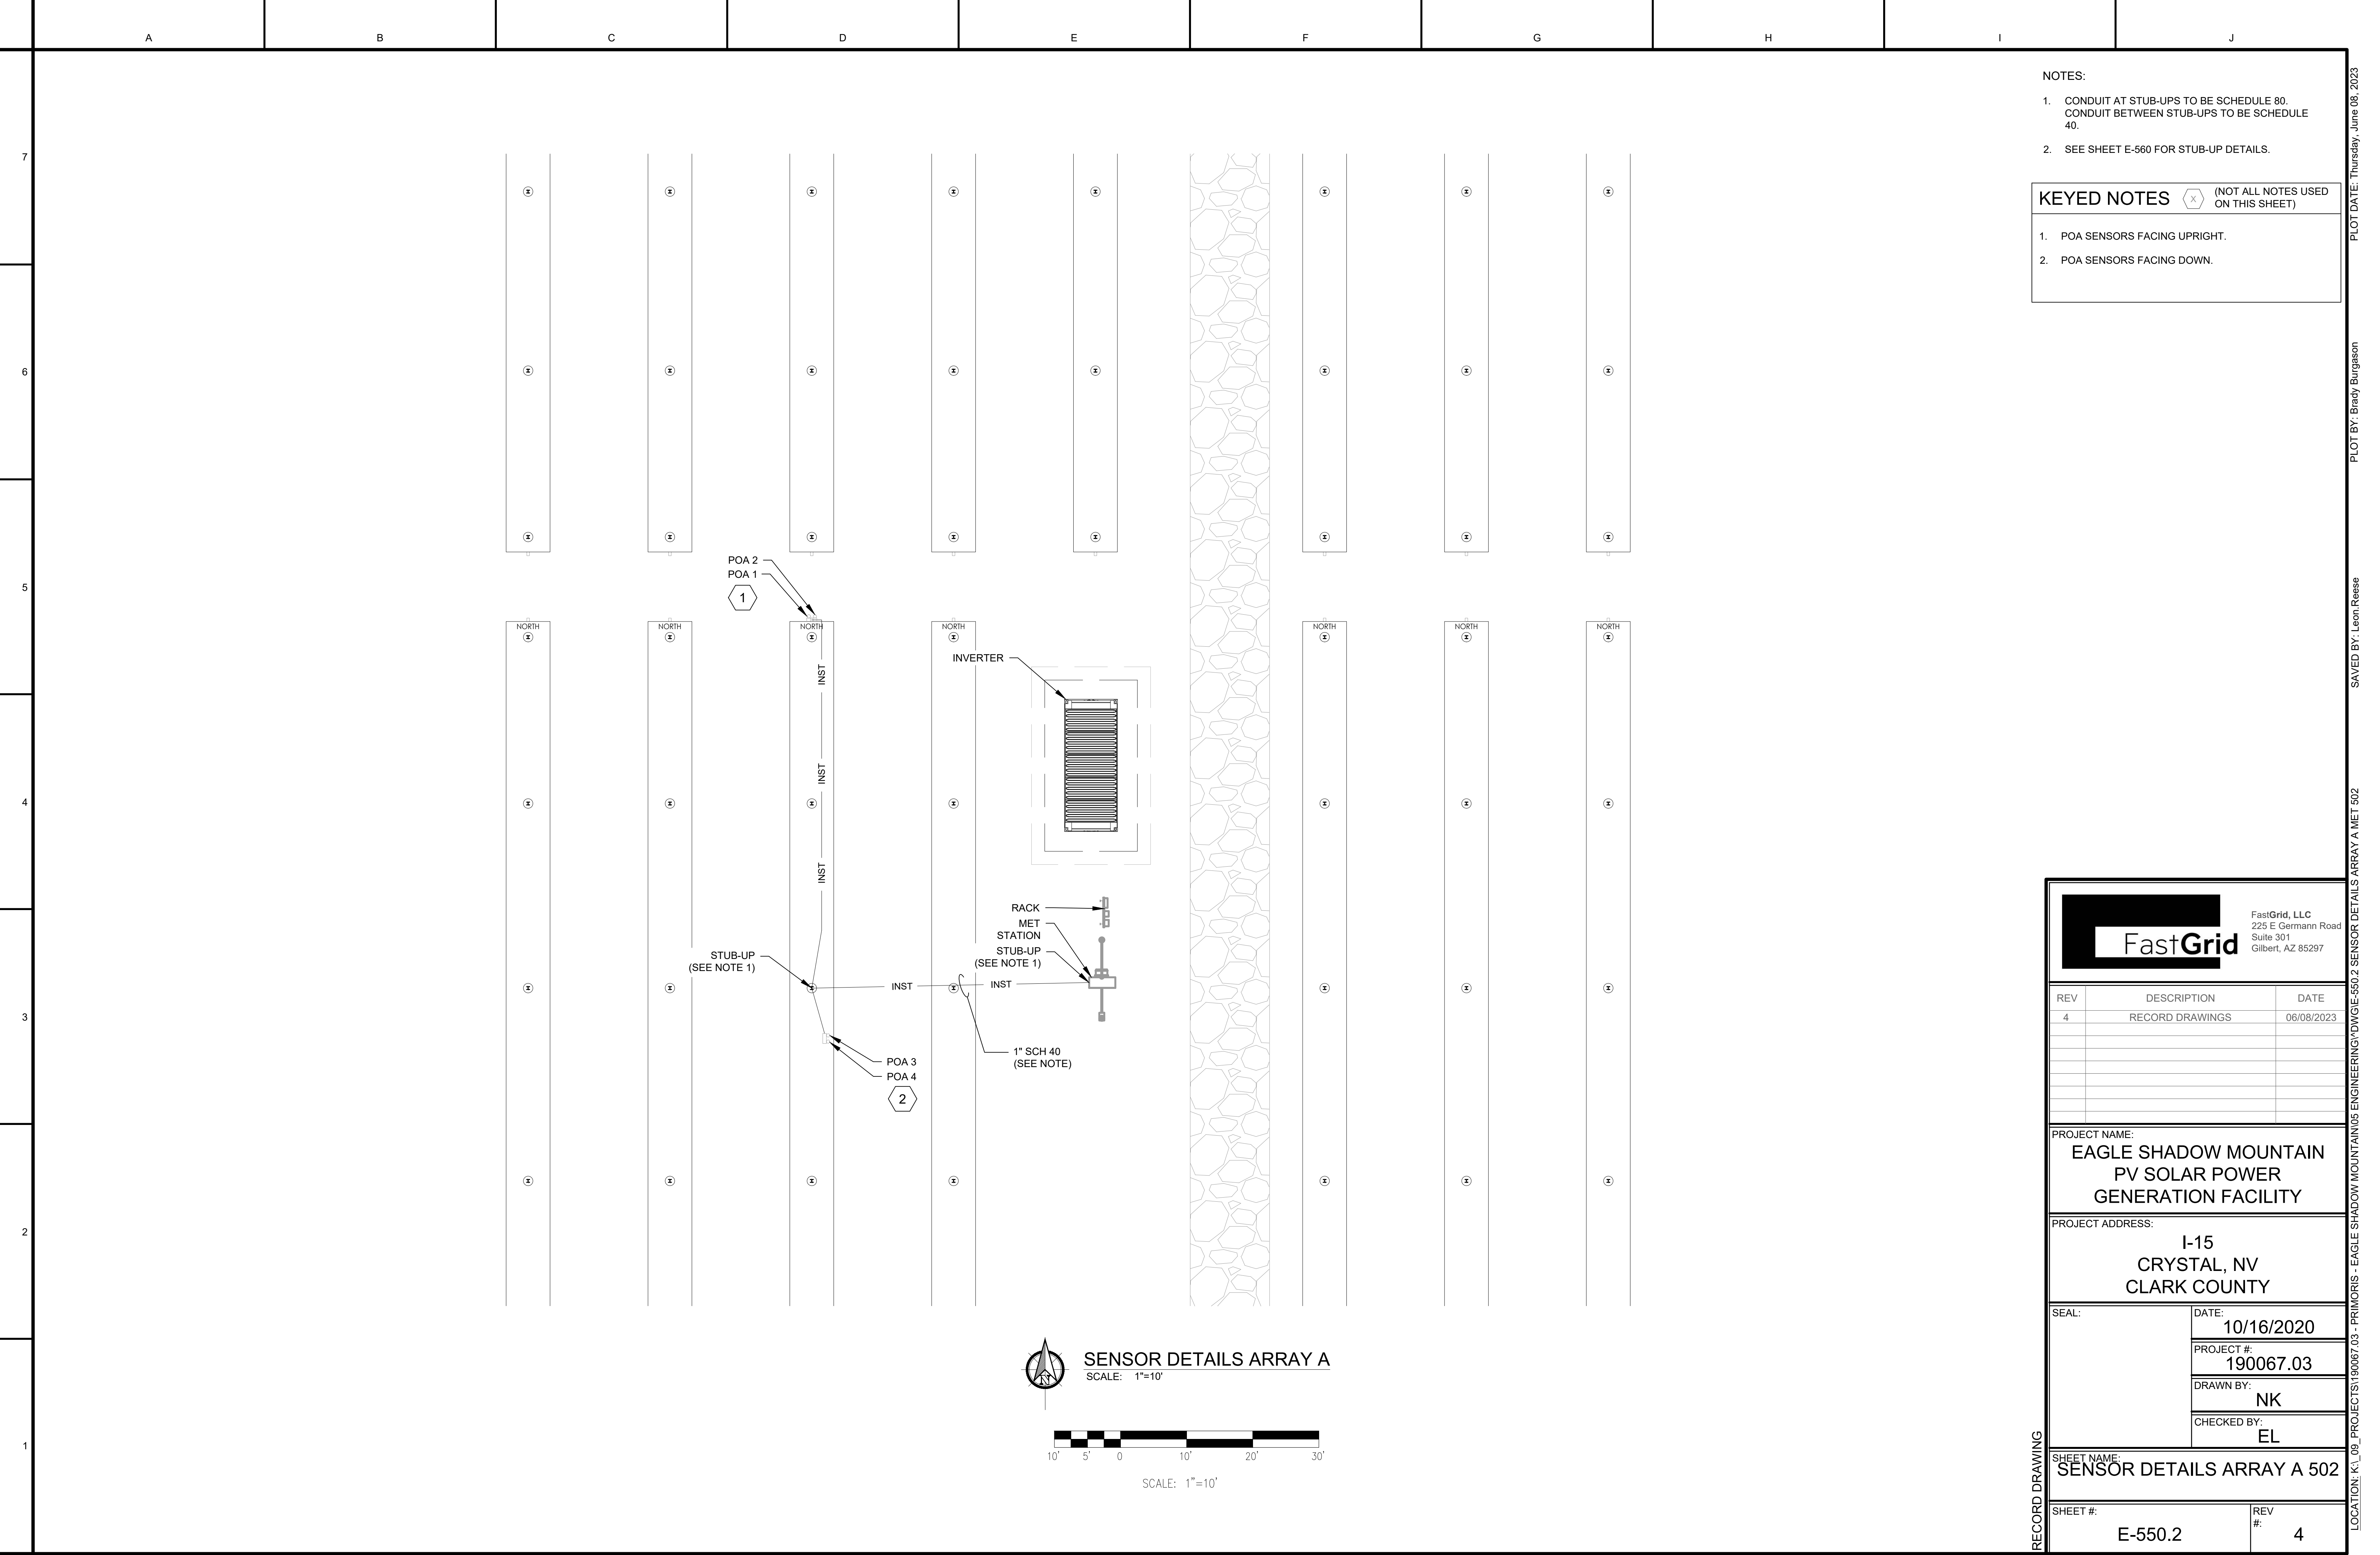

NOTES:

1. CONDUIT AT STUB-UPS TO BE SCHEDULE 80.
CONDUIT BETWEEN STUB-UPS TO BE SCHEDULE 40.

2. SEE SHEET E-560 FOR STUB-UP DETAILS.

KEYED NOTES

(NOT ALL NOTES USED ON THIS SHEET)

1. POA SENSORS FACING UPRIGHT.

2. POA SENSORS FACING DOWN.

FastGrid

FastGrid, LLC
225 E Germann Road
Suite 301
Gilbert, AZ 85297

REV	DESCRIPTION	DATE
4	RECORD DRAWINGS	06/08/2023

PROJECT NAME:

EAGLE SHADOW MOUNTAIN
PV SOLAR POWER
GENERATION FACILITY

PROJECT ADDRESS:

I-15
CRYSTAL, NV
CLARK COUNTY

SEAL:

DATE:
10/16/2020

PROJECT #:
190067.03

DRAWN BY:
NK

CHECKED BY:
EL

SHEET NAME:

SENSOR DETAILS ARRAY A 502

SHEET #:	REV #:
E-550.2	4

RECORD DRAWING

SENSOR DETAILS ARRAY A
SCALE: 1"=10'

SCALE: 1"=10'

LOCATION: K:_09_PROJECTS\190067.03 - PRIMORIS - EAGLE SHADOW MOUNTAIN\05 ENGINEERING\DWG\E-550.2 SENSOR DETAILS ARRAY A MET 502 PLOT BY: Brady Burgesson SAVED BY: Leon Reese PLOT DATE: Thursday, June 08, 2023



NOTES:

1. CONDUIT AT STUB-UPS TO BE SCHEDULE 80.
CONDUIT BETWEEN STUB-UPS TO BE SCHEDULE 40.

2. SEE SHEET E-560 FOR STUB-UP DETAILS.

KEYED NOTES

(NOT ALL NOTES USED ON THIS SHEET)

1. POA SENSORS FACING UPRIGHT.

2. POA SENSORS FACING DOWN.

FastGrid

FastGrid, LLC

225 E Germann Road

Suite 301

Gilbert, AZ 85297

REV	DESCRIPTION	DATE
4	RECORD DRAWINGS	06/08/2023

PROJECT NAME:

EAGLE SHADOW MOUNTAIN
PV SOLAR POWER
GENERATION FACILITY

PROJECT ADDRESS:

I-15
CRYSTAL, NV
CLARK COUNTY

SEAL:

DATE:
10/16/2020

PROJECT #:
190067.03

DRAWN BY:
NK

CHECKED BY:
EL


SHEET NAME:

SENSOR DETAILS ARRAY B

SHEET #:	REV #:
E-551	4

RECORD DRAWING



LOCATION: K:\09_PROJECTS\190067.03 - PRIMORIS - EAGLE SHADOW MOUNTAIN\05 ENGINEERING\DWG\E-551 SENSOR DETAILS ARRAY B PLOT DATE: Thursday, June 08, 2023
SAVED BY: Leon Reese
PLOT BY: Brady Burgesson

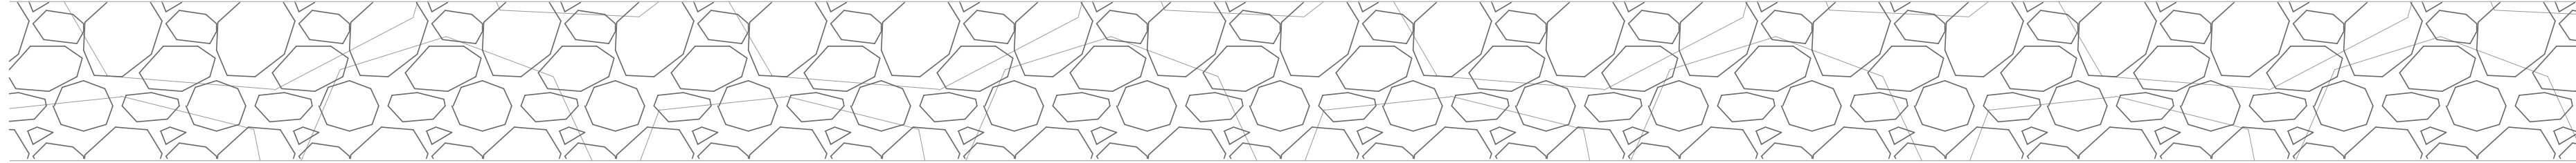


- NOTES:
- CONDUIT AT STUB-UPS TO BE SCHEDULE 80.
CONDUIT BETWEEN STUB-UPS TO BE SCHEDULE 40.
 - SEE SHEET E-560 FOR STUB-UP DETAILS.

KEYED NOTES (NOT ALL NOTES USED ON THIS SHEET)

- POA SENSORS FACING UPRIGHT.
- POA SENSORS FACING DOWN.

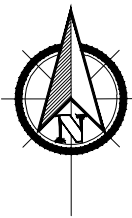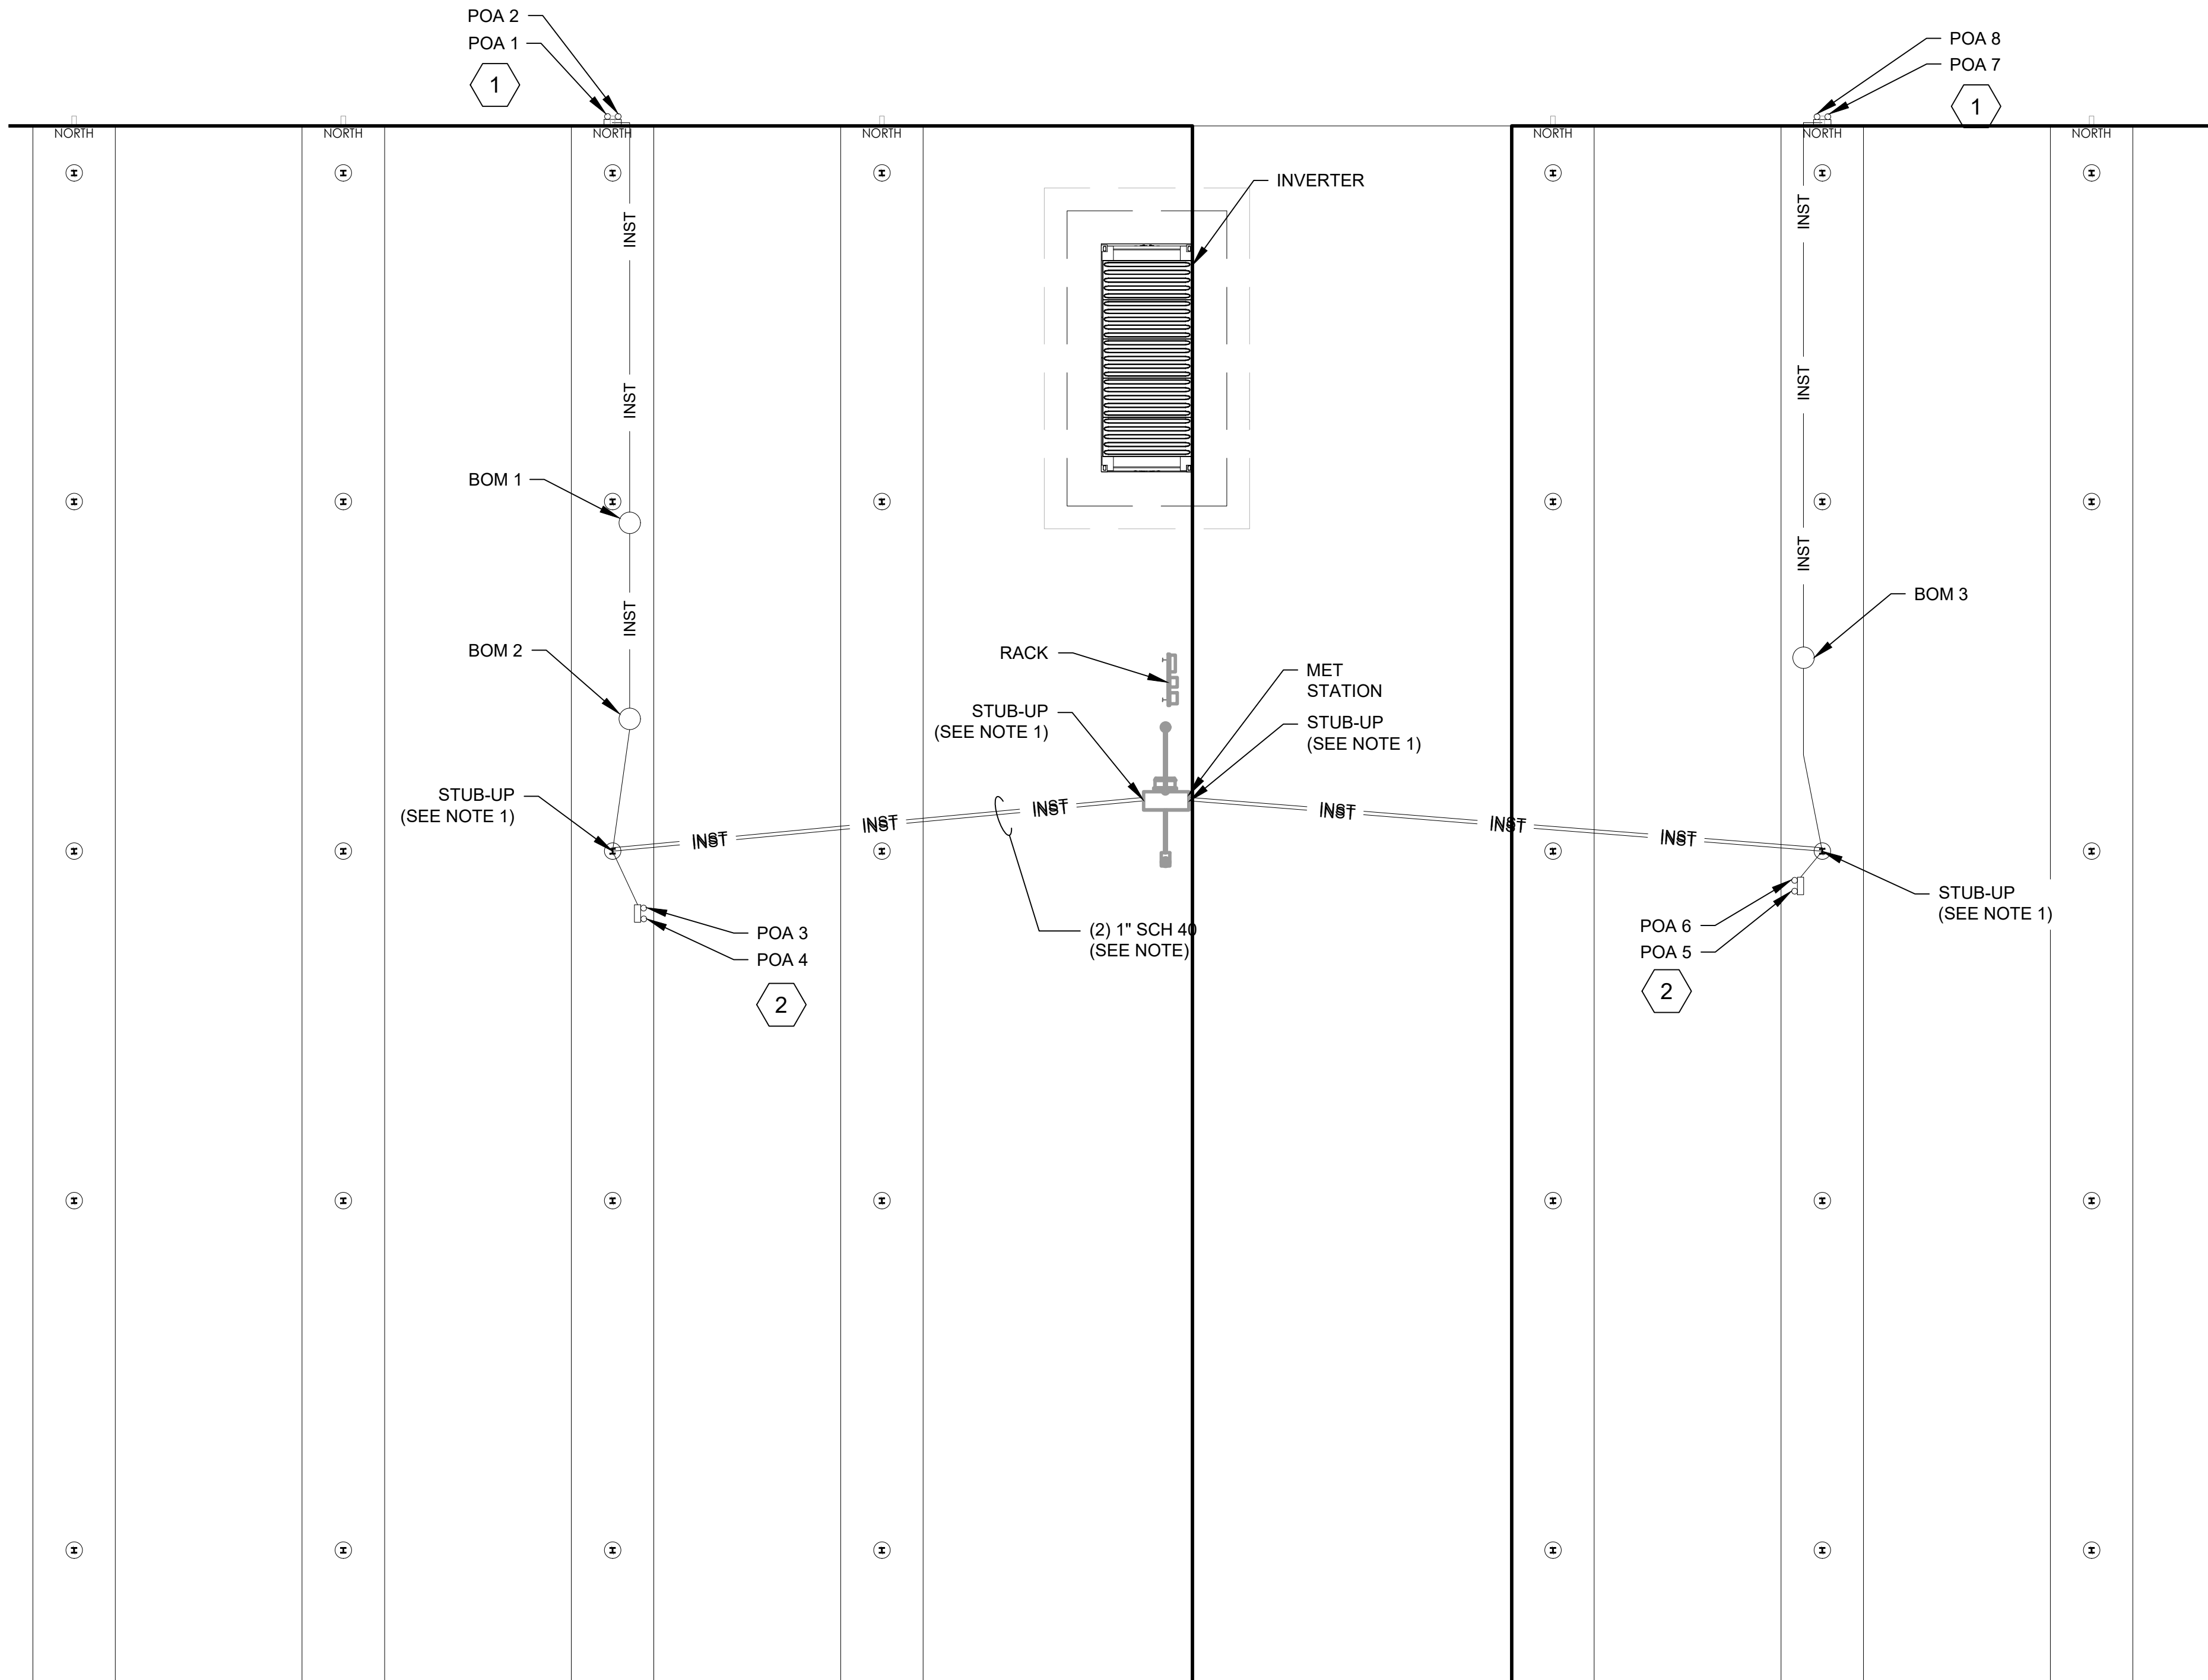

SENSOR DETAILS ARRAY L
SCALE: 1"=10'

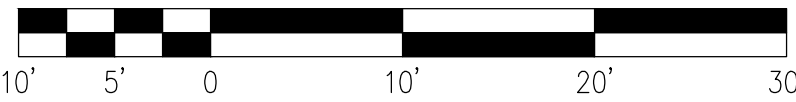

SCALE: 1"=10'

KEY PLAN
SCALE: N.T.S

FastGrid

FastGrid, LLC
225 E Germann Road
Suite 301
Gilbert, AZ 85297

REV	DESCRIPTION	DATE
4	RECORD DRAWINGS	06/08/2023

PROJECT NAME:
EAGLE SHADOW MOUNTAIN
PV SOLAR POWER
GENERATION FACILITY

PROJECT ADDRESS:
I-15
CRYSTAL, NV
CLARK COUNTY

SEAL:

DATE:
10/16/2020

PROJECT #:
190067.03


DRAWN BY:
NK

CHECKED BY:
EL

SHEET NAME:
SENSOR DETAILS ARRAY L

SHEET #:	REV #:
E-552	4

RECORD DRAWING

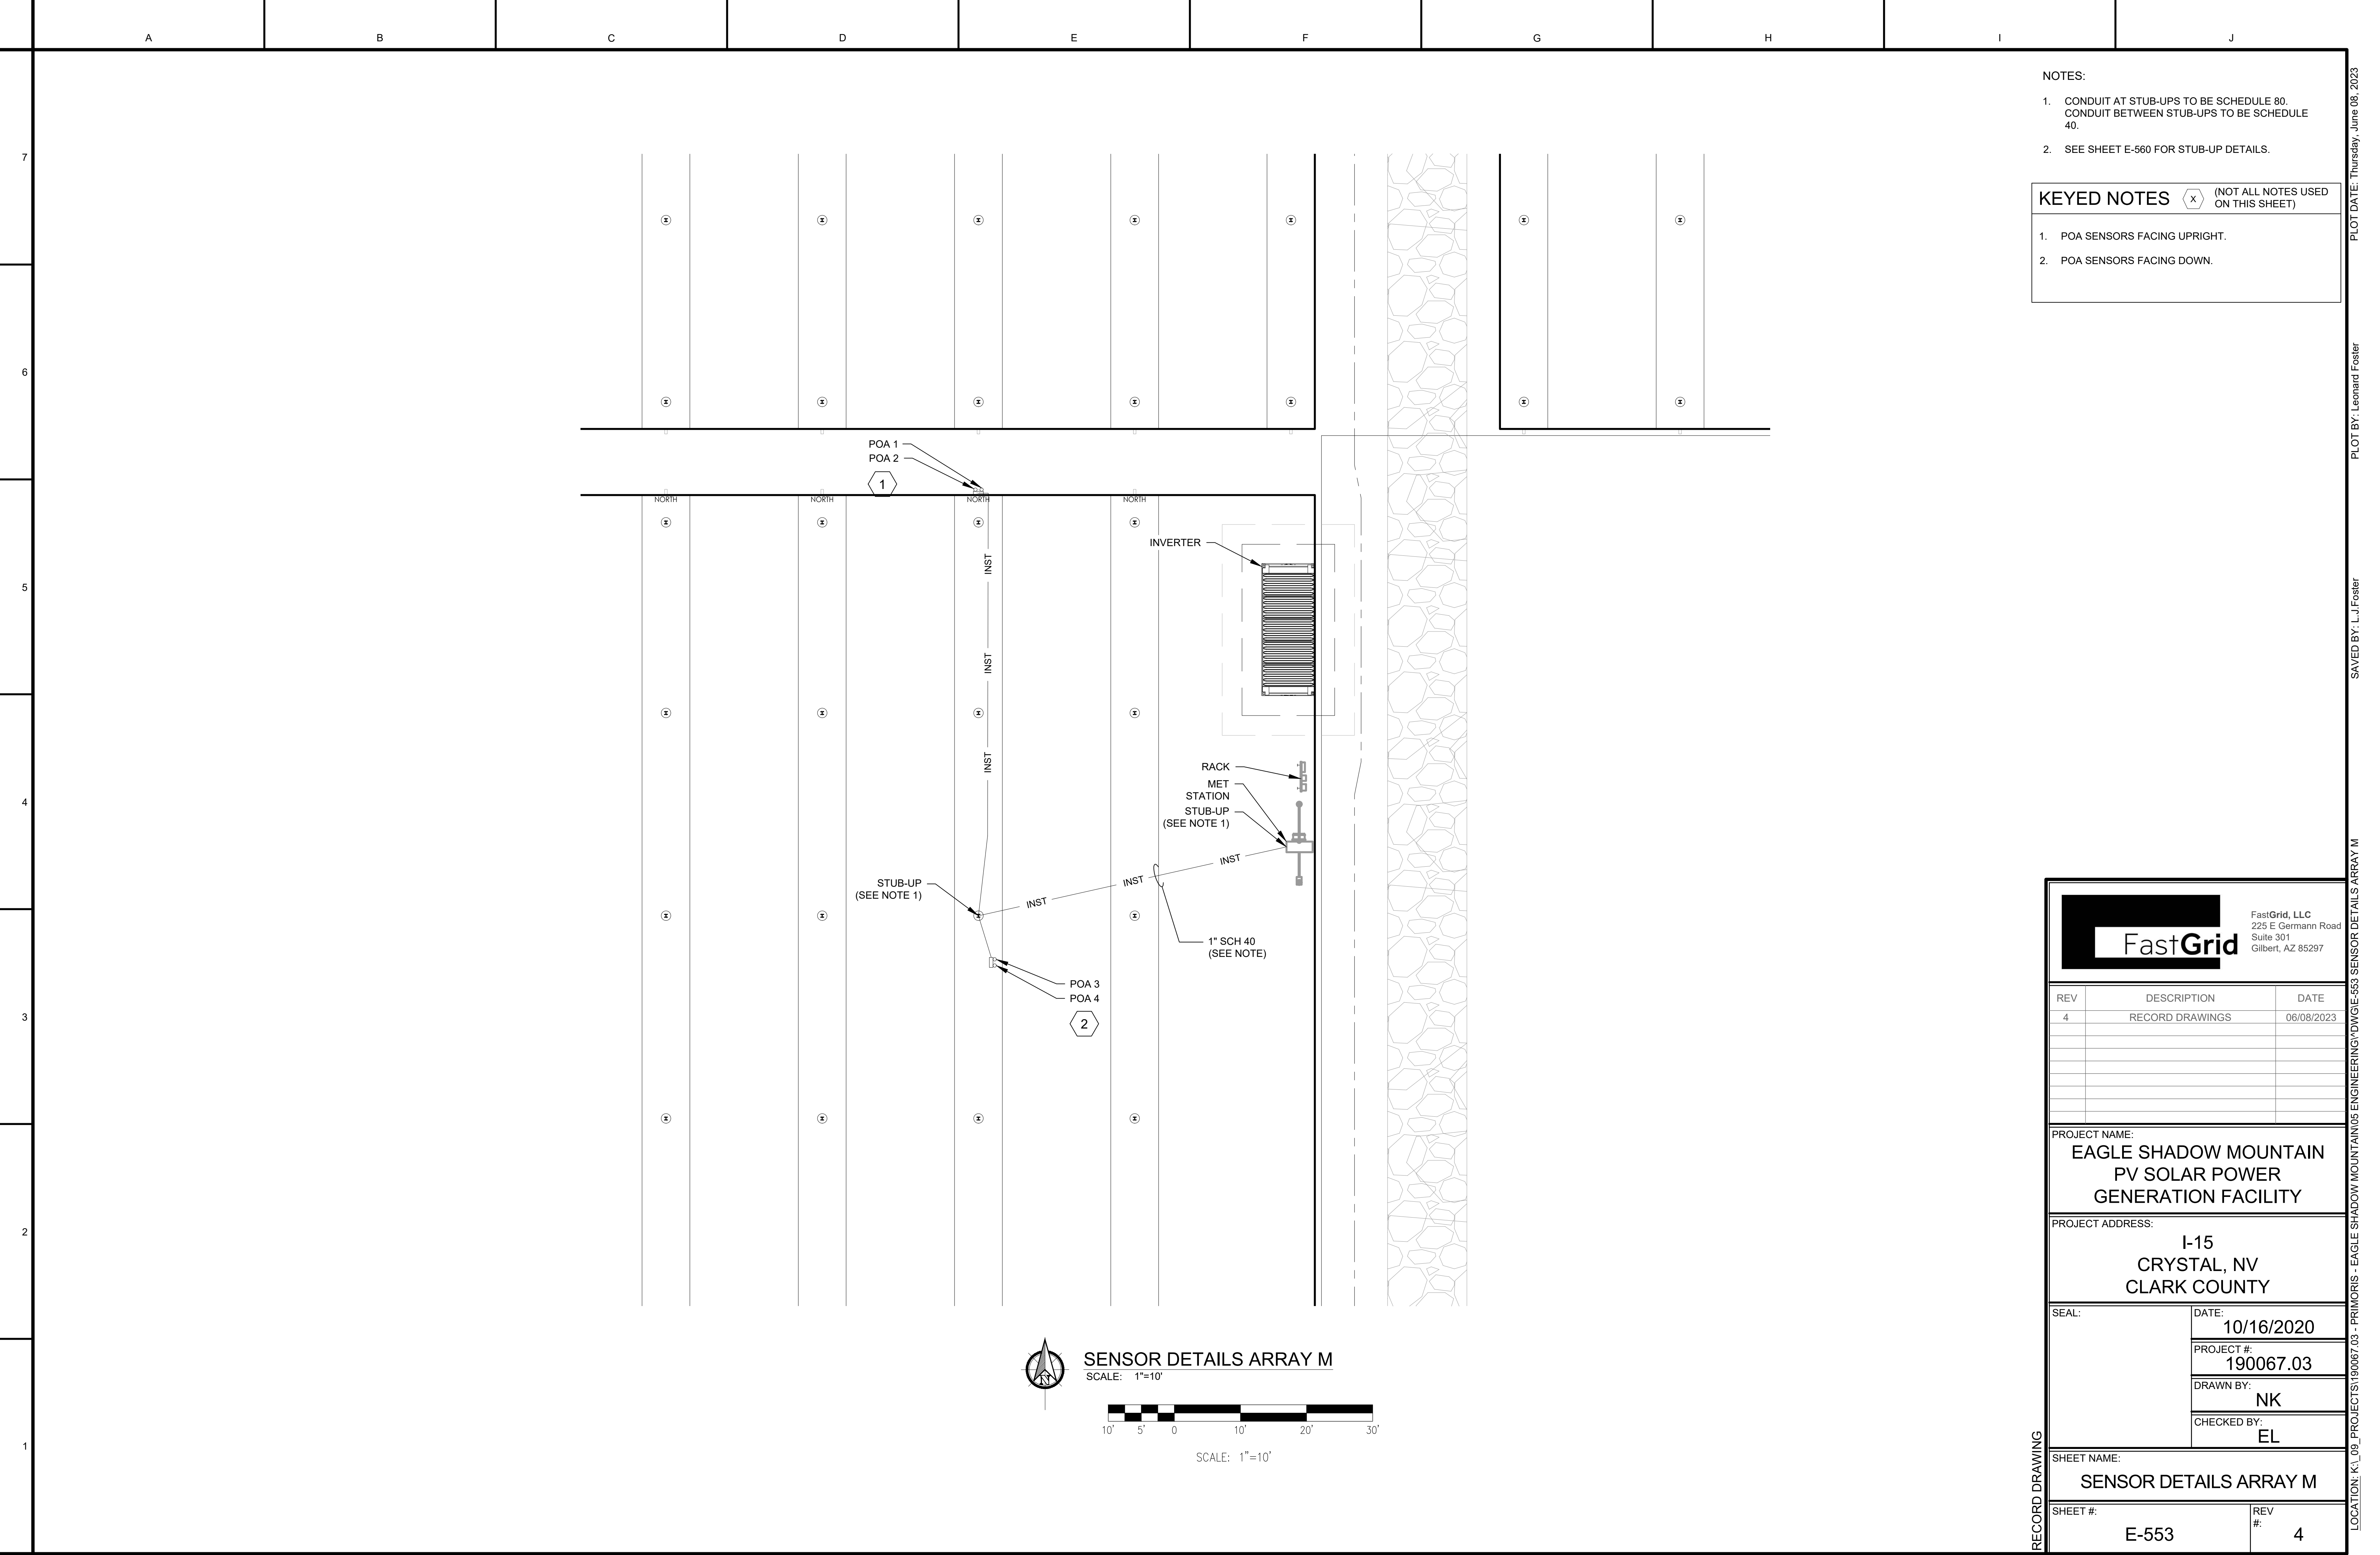

NOTES:

1. CONDUIT AT STUB-UPS TO BE SCHEDULE 80.
CONDUIT BETWEEN STUB-UPS TO BE SCHEDULE 40.

2. SEE SHEET E-560 FOR STUB-UP DETAILS.

KEYED NOTES

X

(NOT ALL NOTES USED
ON THIS SHEET)

1. POA SENSORS FACING UPRIGHT.

2. POA SENSORS FACING DOWN.

FastGrid

FastGrid, LLC

225 E Germann Road

Suite 301

Gilbert, AZ 85297

REV	DESCRIPTION	DATE
4	RECORD DRAWINGS	06/08/2023

PROJECT NAME:

EAGLE SHADOW MOUNTAIN
PV SOLAR POWER
GENERATION FACILITY

PROJECT ADDRESS:

I-15
CRYSTAL, NV
CLARK COUNTY

SEAL:

DATE:
10/16/2020

PROJECT #:
190067.03

DRAWN BY:
NK


CHECKED BY:
EL

SHEET NAME:

SENSOR DETAILS ARRAY M

SHEET #:	REV #:
E-553	4

LOCATION: K:\09_PROJECTS\190067.03 - PRIMORIS - EAGLE SHADOW MOUNTAIN\05_ENGINEERING\DWG\E-553_SENSOR_DETAILS_ARRAY.M PLOT BY: Leonard Foster PLOT DATE: Thursday, June 08, 2023

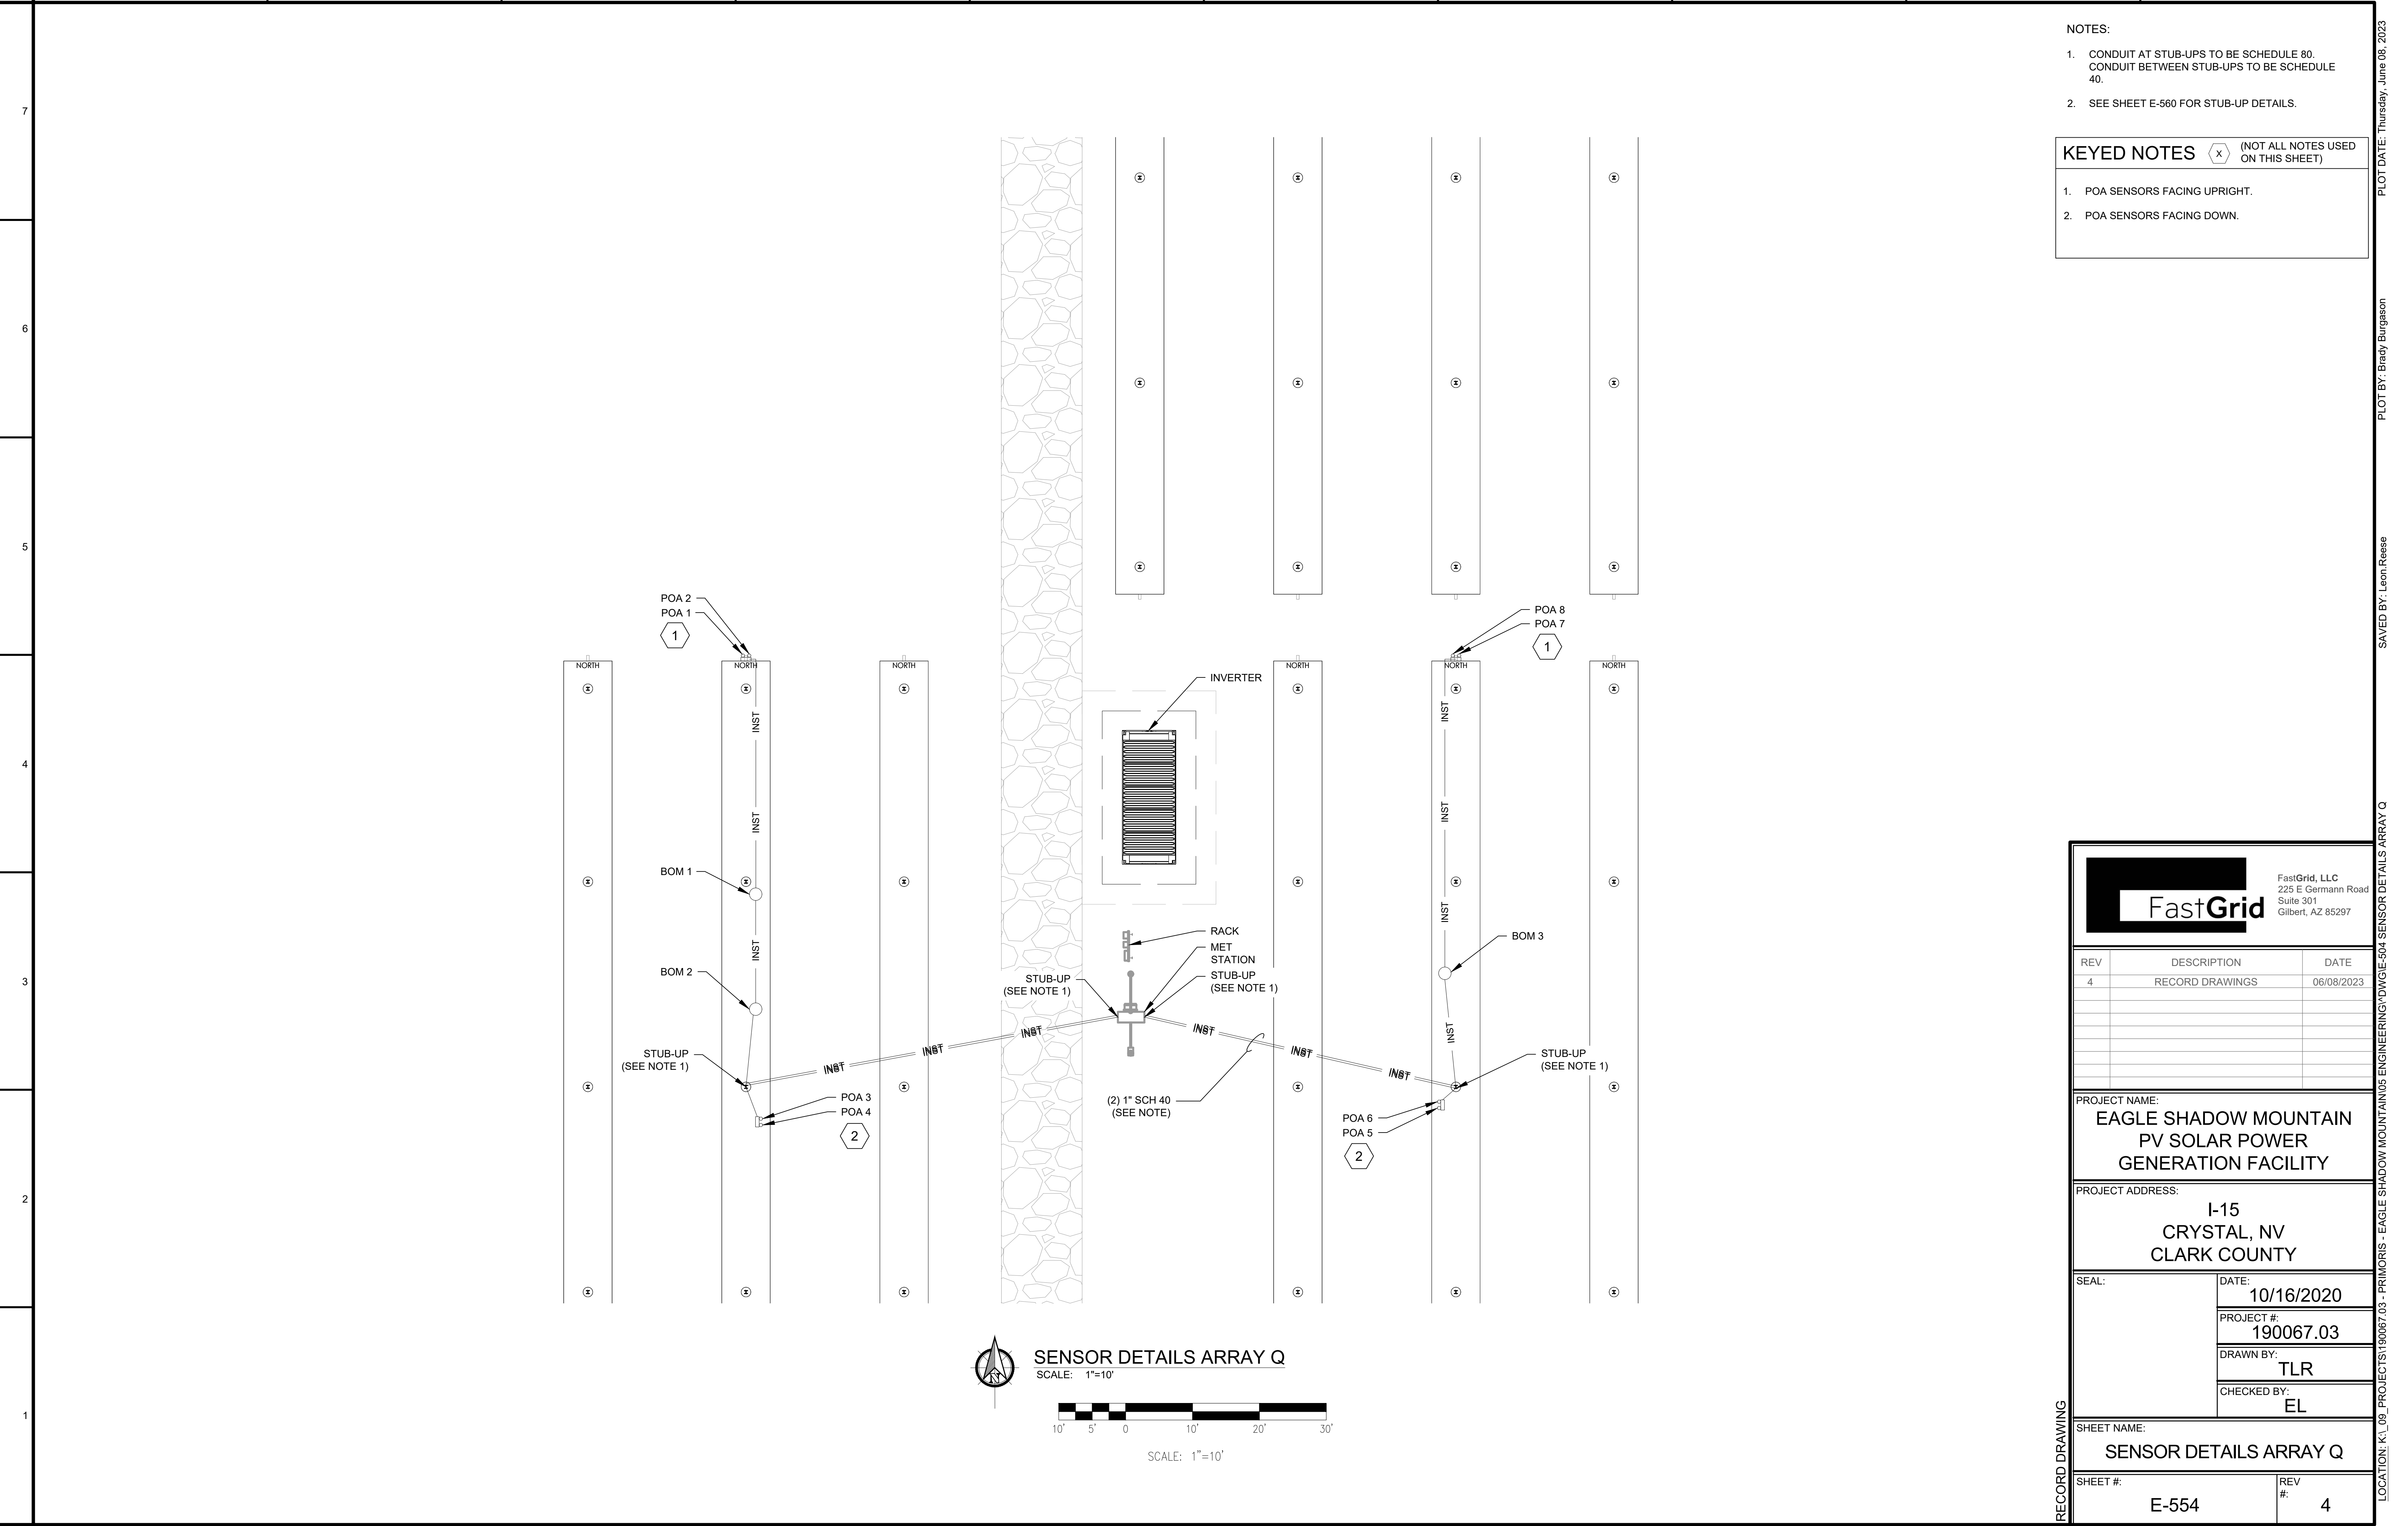

NOTES:

1.

CONDUIT AT STUB-UPS TO BE SCHEDULE 80.
CONDUIT BETWEEN STUB-UPS TO BE SCHEDULE 40.

2.

SEE SHEET E-560 FOR STUB-UP DETAILS.

KEYED NOTES

X

(NOT ALL NOTES USED
ON THIS SHEET)

1.

POA SENSORS FACING UPRIGHT.

2.

POA SENSORS FACING DOWN.

FastGrid

FastGrid, LLC
225 E Germann Road
Suite 301
Gilbert, AZ 85297

REV	DESCRIPTION	DATE
4	RECORD DRAWINGS	06/08/2023

PROJECT NAME:
EAGLE SHADOW MOUNTAIN
PV SOLAR POWER
GENERATION FACILITY

PROJECT ADDRESS:
I-15
CRYSTAL, NV
CLARK COUNTY

SEAL:

DATE:
10/16/2020

PROJECT #:
190067.03

DRAWN BY:
TLR

CHECKED BY:
EL


SHEET NAME:
SENSOR DETAILS ARRAY Q

SHEET #:	REV #:
E-554	4

SENSOR DETAILS ARRAY Q
SCALE: 1"=10'

SCALE: 1"=10'

RECORD DRAWING

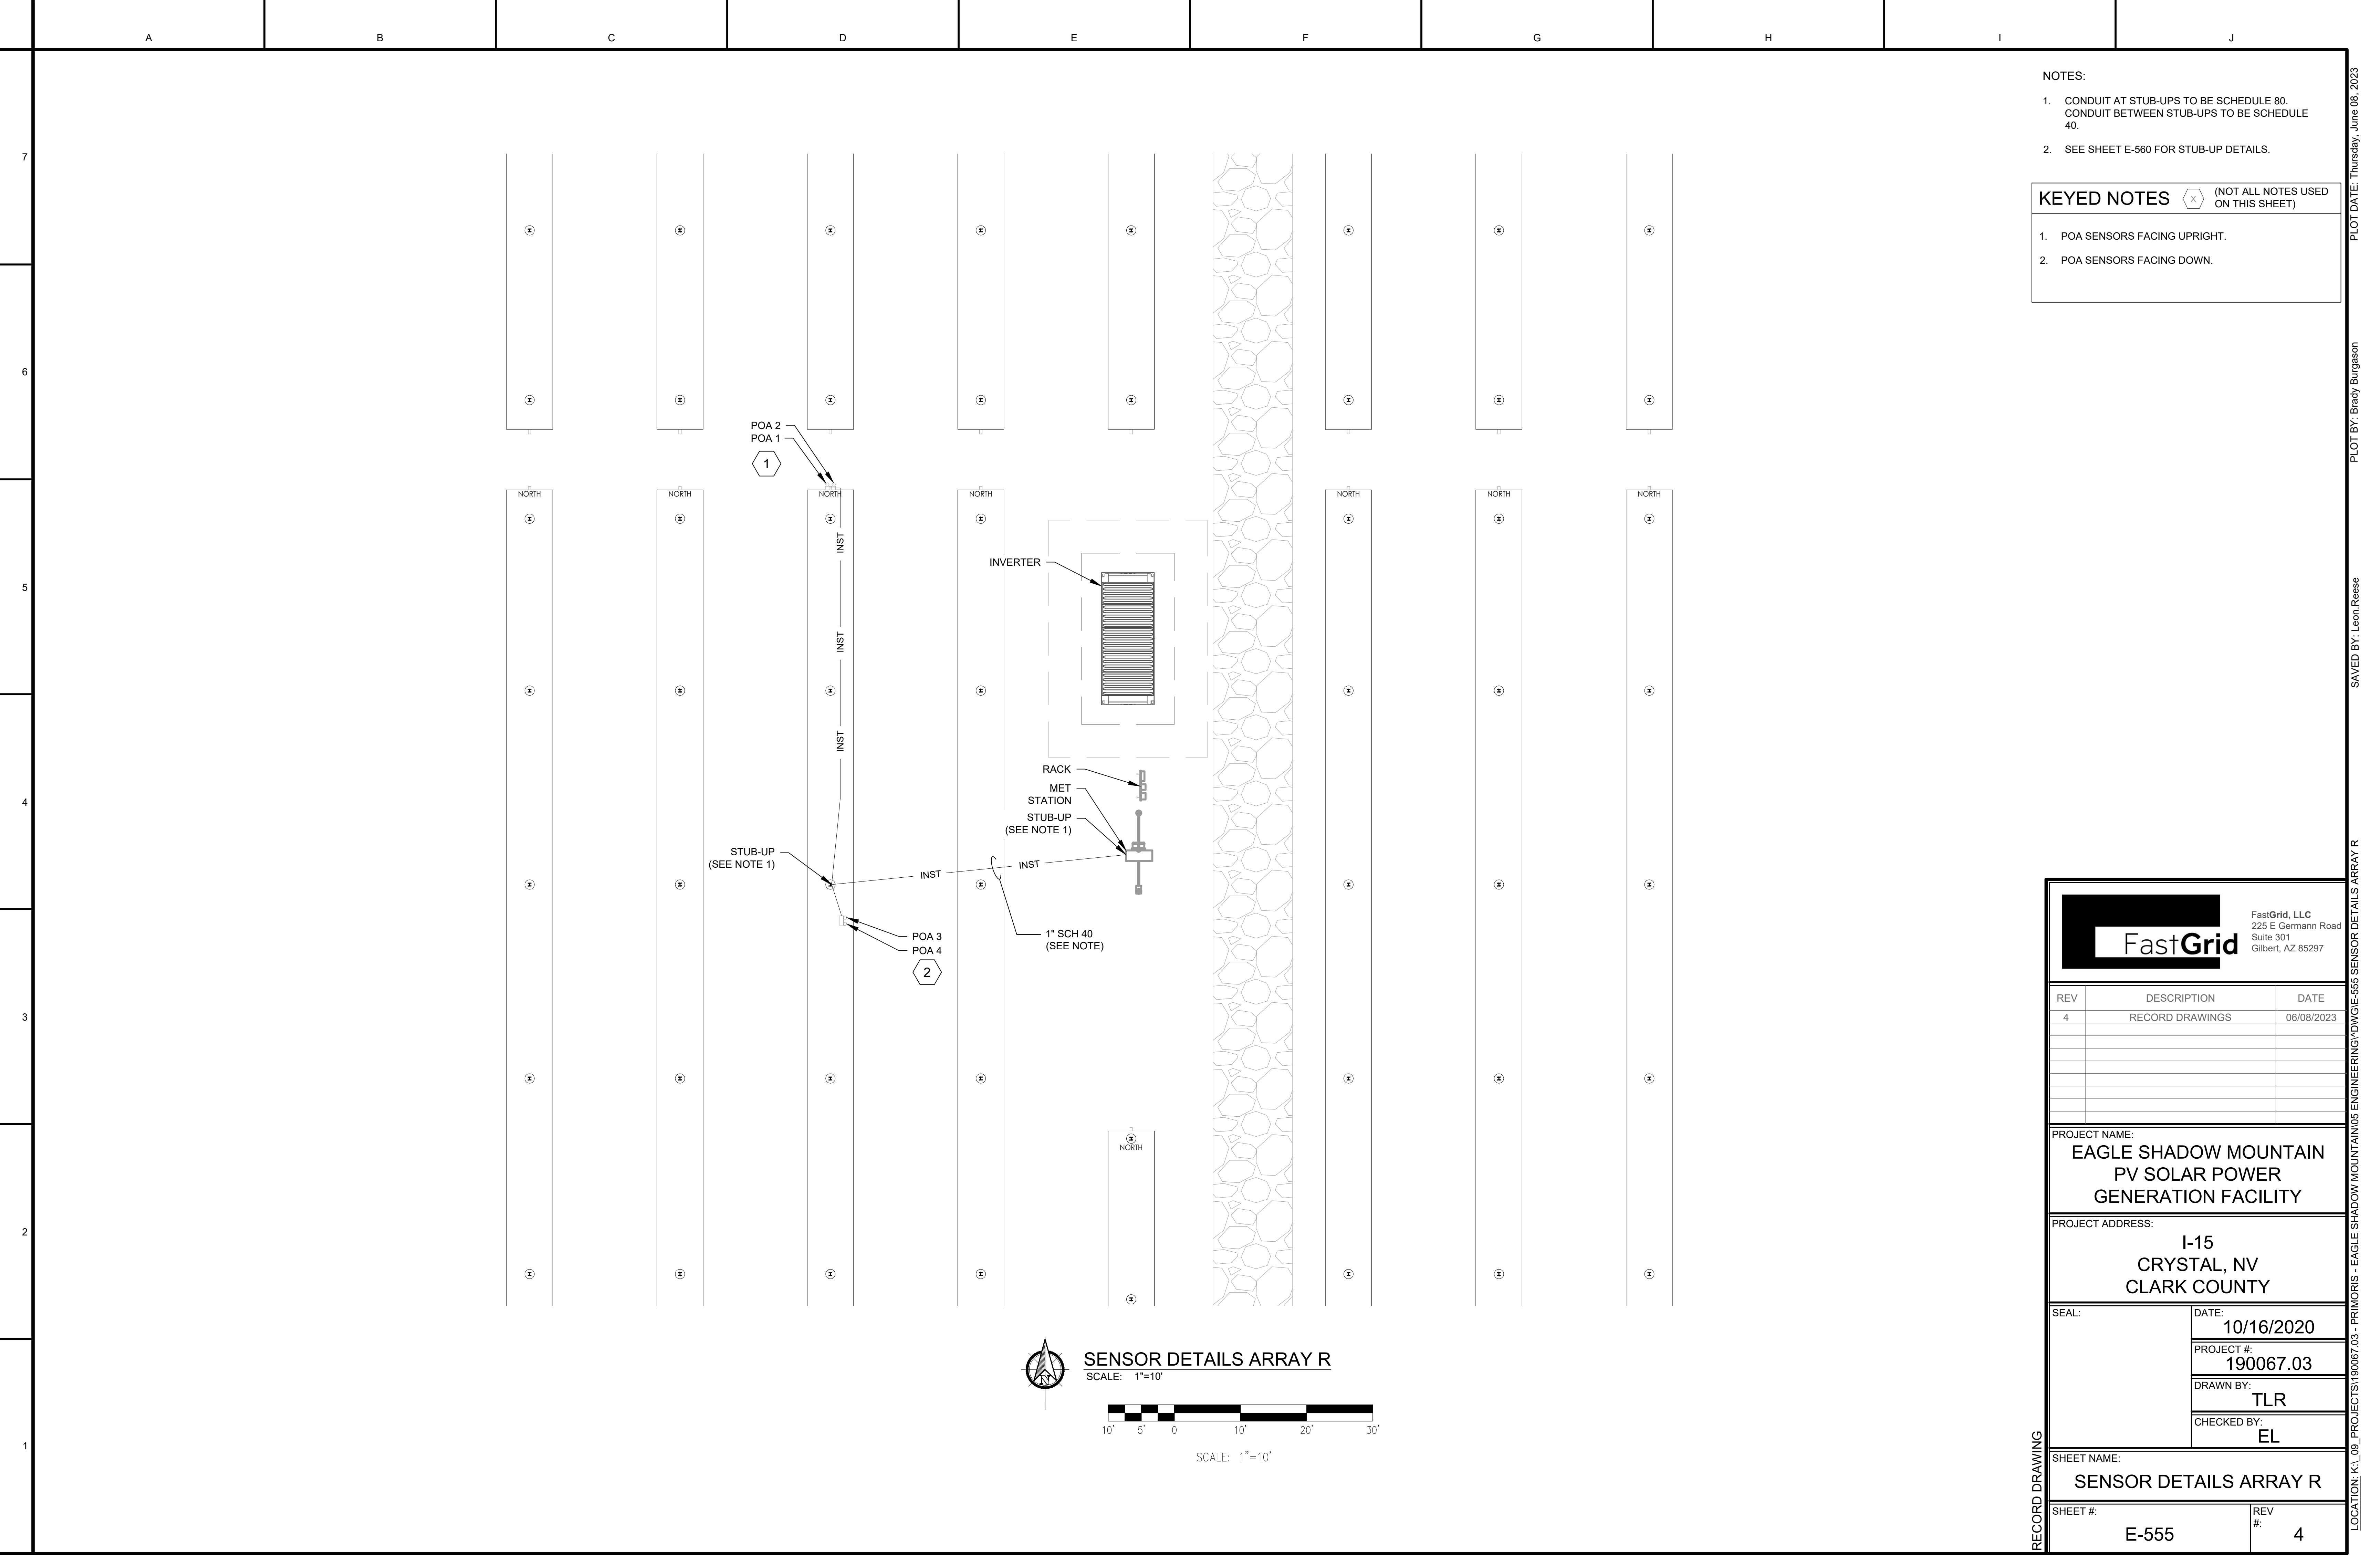

NOTES:

1. CONDUIT AT STUB-UPS TO BE SCHEDULE 80.
CONDUIT BETWEEN STUB-UPS TO BE SCHEDULE 40.

2. SEE SHEET E-560 FOR STUB-UP DETAILS.

KEYED NOTES

(NOT ALL NOTES USED ON THIS SHEET)

1. POA SENSORS FACING UPRIGHT.

2. POA SENSORS FACING DOWN.

FastGrid

FastGrid, LLC

225 E Germann Road

Suite 301

Gilbert, AZ 85297

REV	DESCRIPTION	DATE
4	RECORD DRAWINGS	06/08/2023

PROJECT NAME:

EAGLE SHADOW MOUNTAIN
PV SOLAR POWER
GENERATION FACILITY

PROJECT ADDRESS:

I-15
CRYSTAL, NV
CLARK COUNTY

SEAL:

DATE:
10/16/2020

PROJECT #:
190067.03

DRAWN BY:
TLR

CHECKED BY:
EL

SHEET NAME:



SENSOR DETAILS ARRAY R

SHEET #:	REV #:
E-555	4


PLOT DATE: Thursday, June 08, 2023

SAVED BY: Leon Reese

LOCATION: K:\09_PROJECTS\190067.03 - PRIMORIS - EAGLE SHADOW MOUNTAIN\05 ENGINEERING\DWG\E-555 SENSOR DETAILS ARRAY R

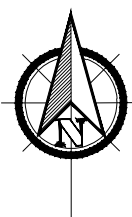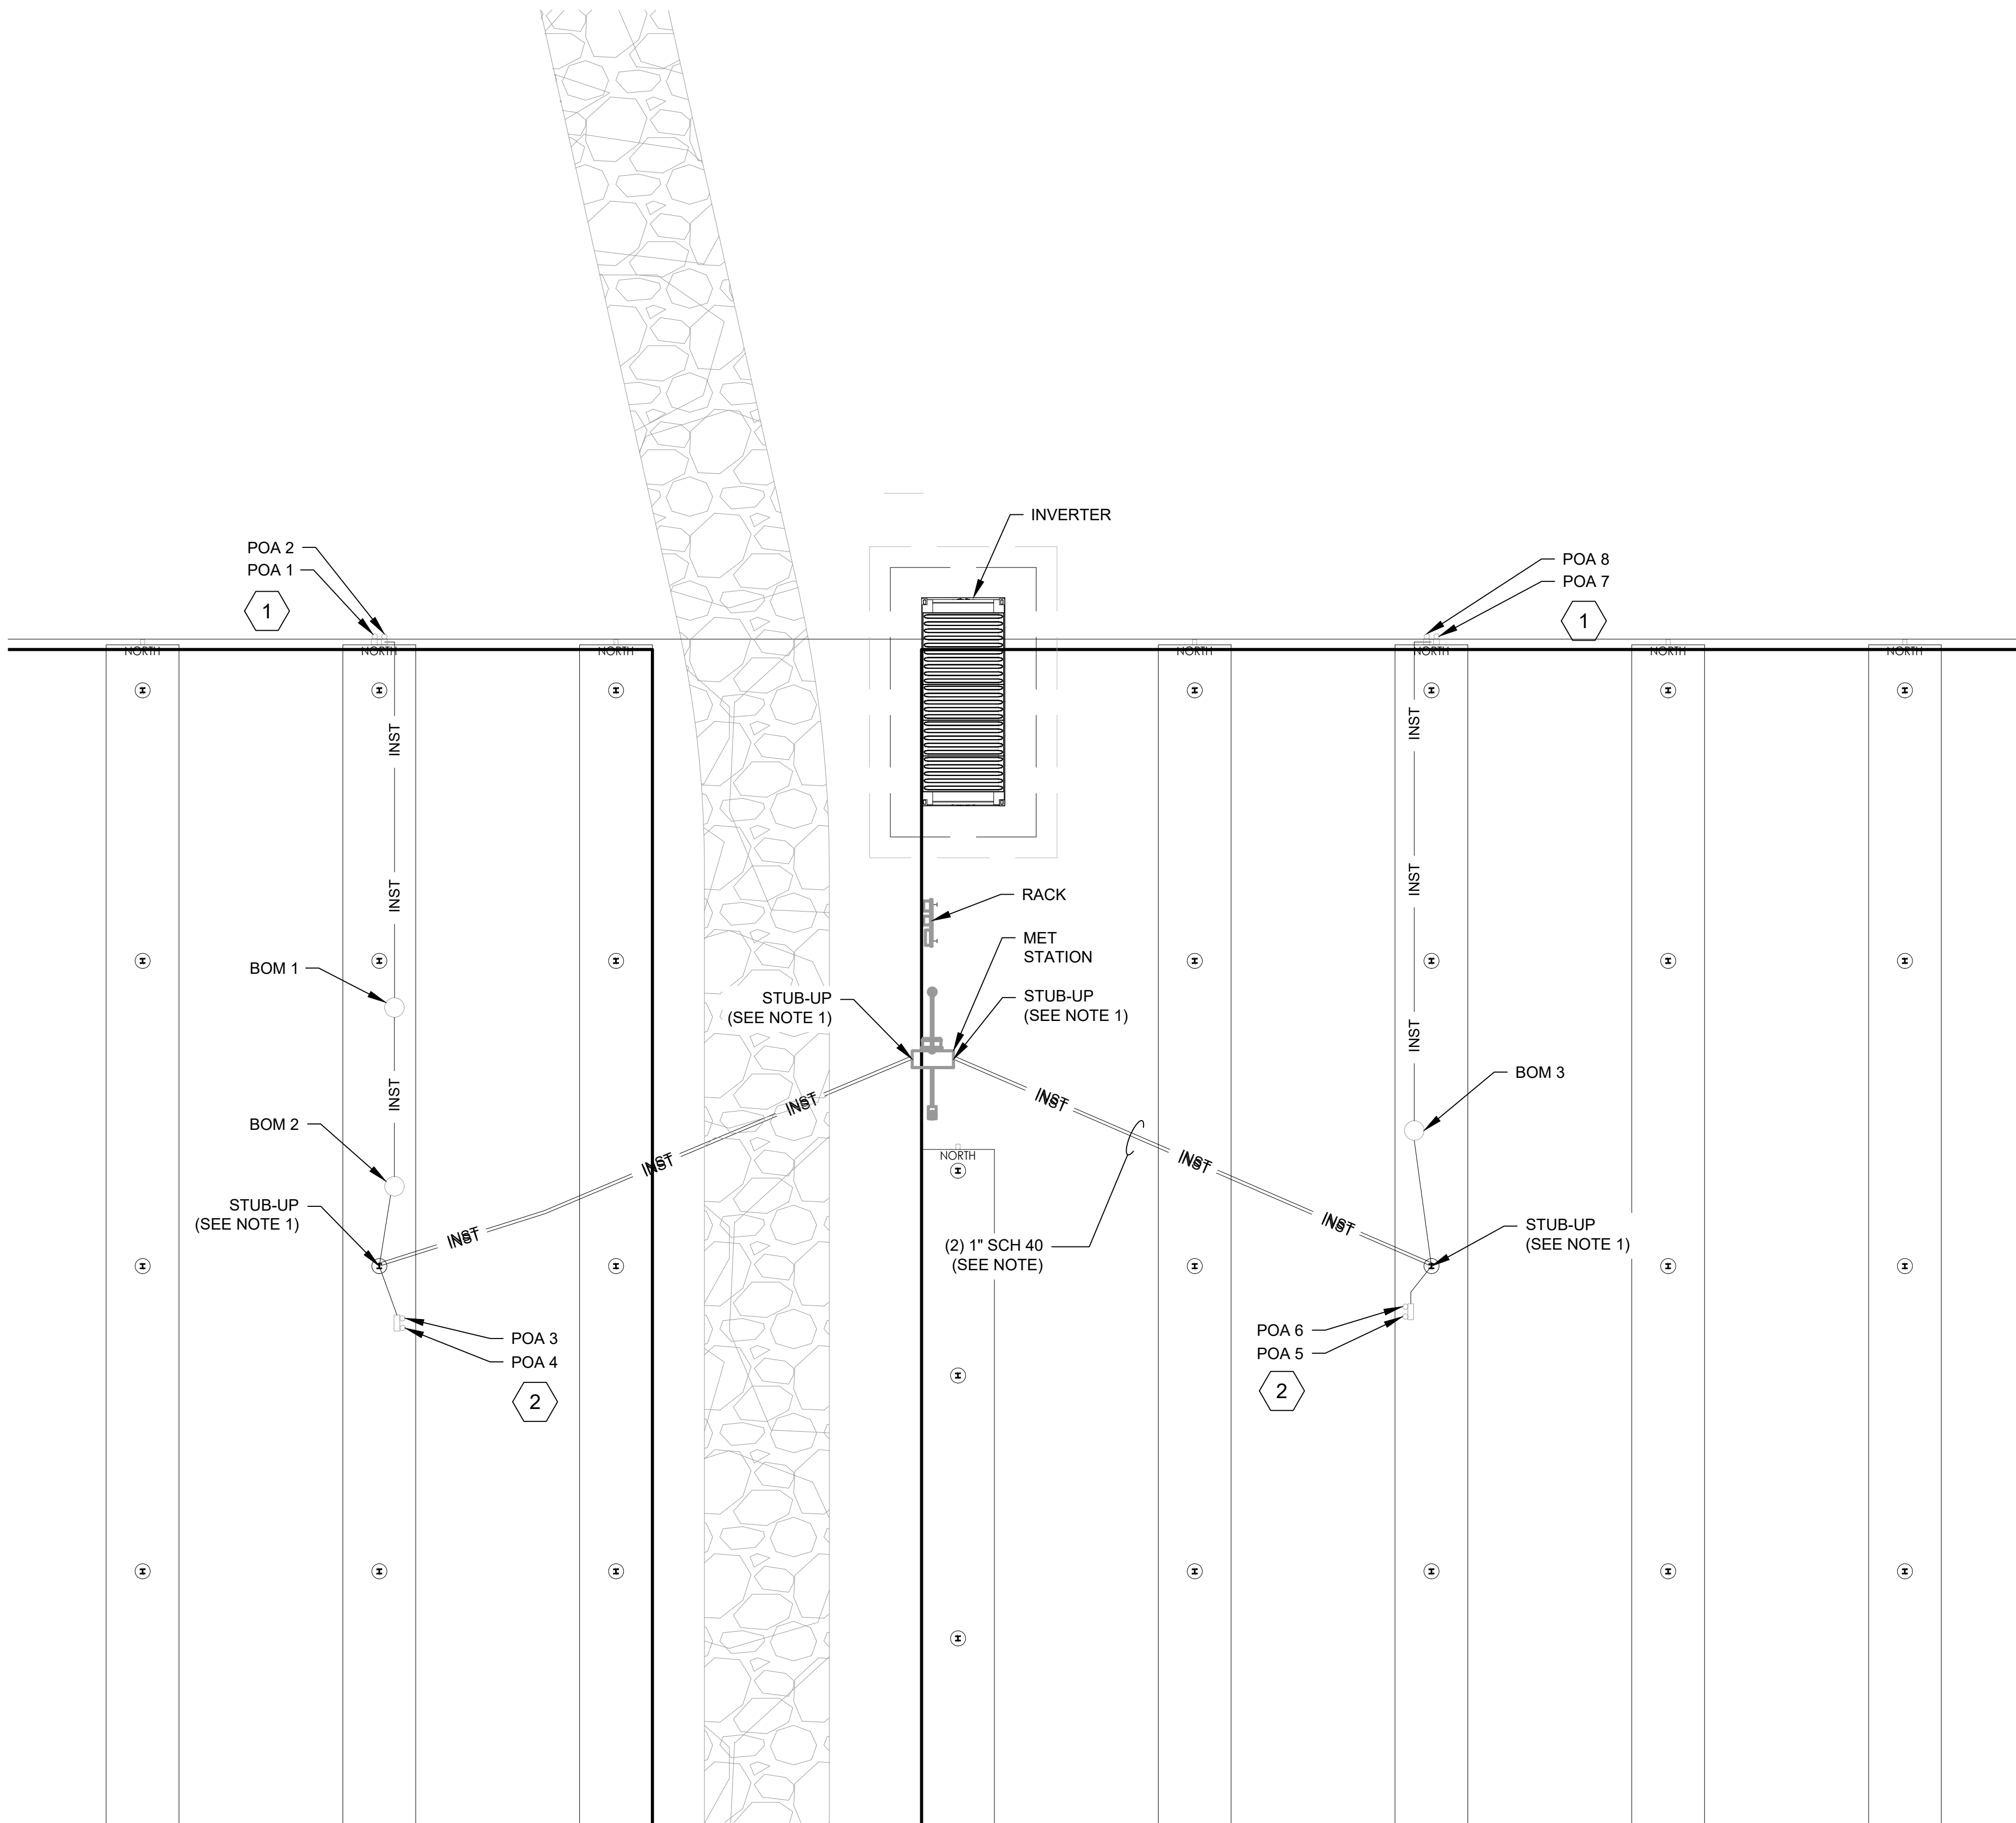

SENSOR DETAILS ARRAY U
SCALE: 1"=10'

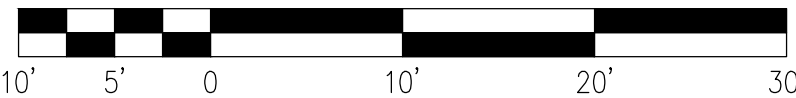

SCALE: 1"=10'

NOTES:

- CONDUIT AT STUB-UPS TO BE SCHEDULE 80.
CONDUIT BETWEEN STUB-UPS TO BE SCHEDULE 40.
- SEE SHEET E-560 FOR STUB-UP DETAILS.

KEYED NOTES

(NOT ALL NOTES USED ON THIS SHEET)

- POA SENSORS FACING UPRIGHT.
- POA SENSORS FACING DOWN.



FastGrid, LLC
225 E Germann Road
Suite 301
Gilbert, AZ 85297

REV	DESCRIPTION	DATE
4	RECORD DRAWINGS	06/08/2023

PROJECT NAME:
**EAGLE SHADOW MOUNTAIN
PV SOLAR POWER
GENERATION FACILITY**


PROJECT ADDRESS:
**I-15
CRYSTAL, NV
CLARK COUNTY**

SEAL:	DATE: 10/16/2020
	PROJECT #: 190067.03
	DRAWN BY: NK
	CHECKED BY: EL

SHEET NAME:
SENSOR DETAILS ARRAY U

SHEET #: E-556	REV #: 4
--------------------------	--------------------

RECORD DRAWING

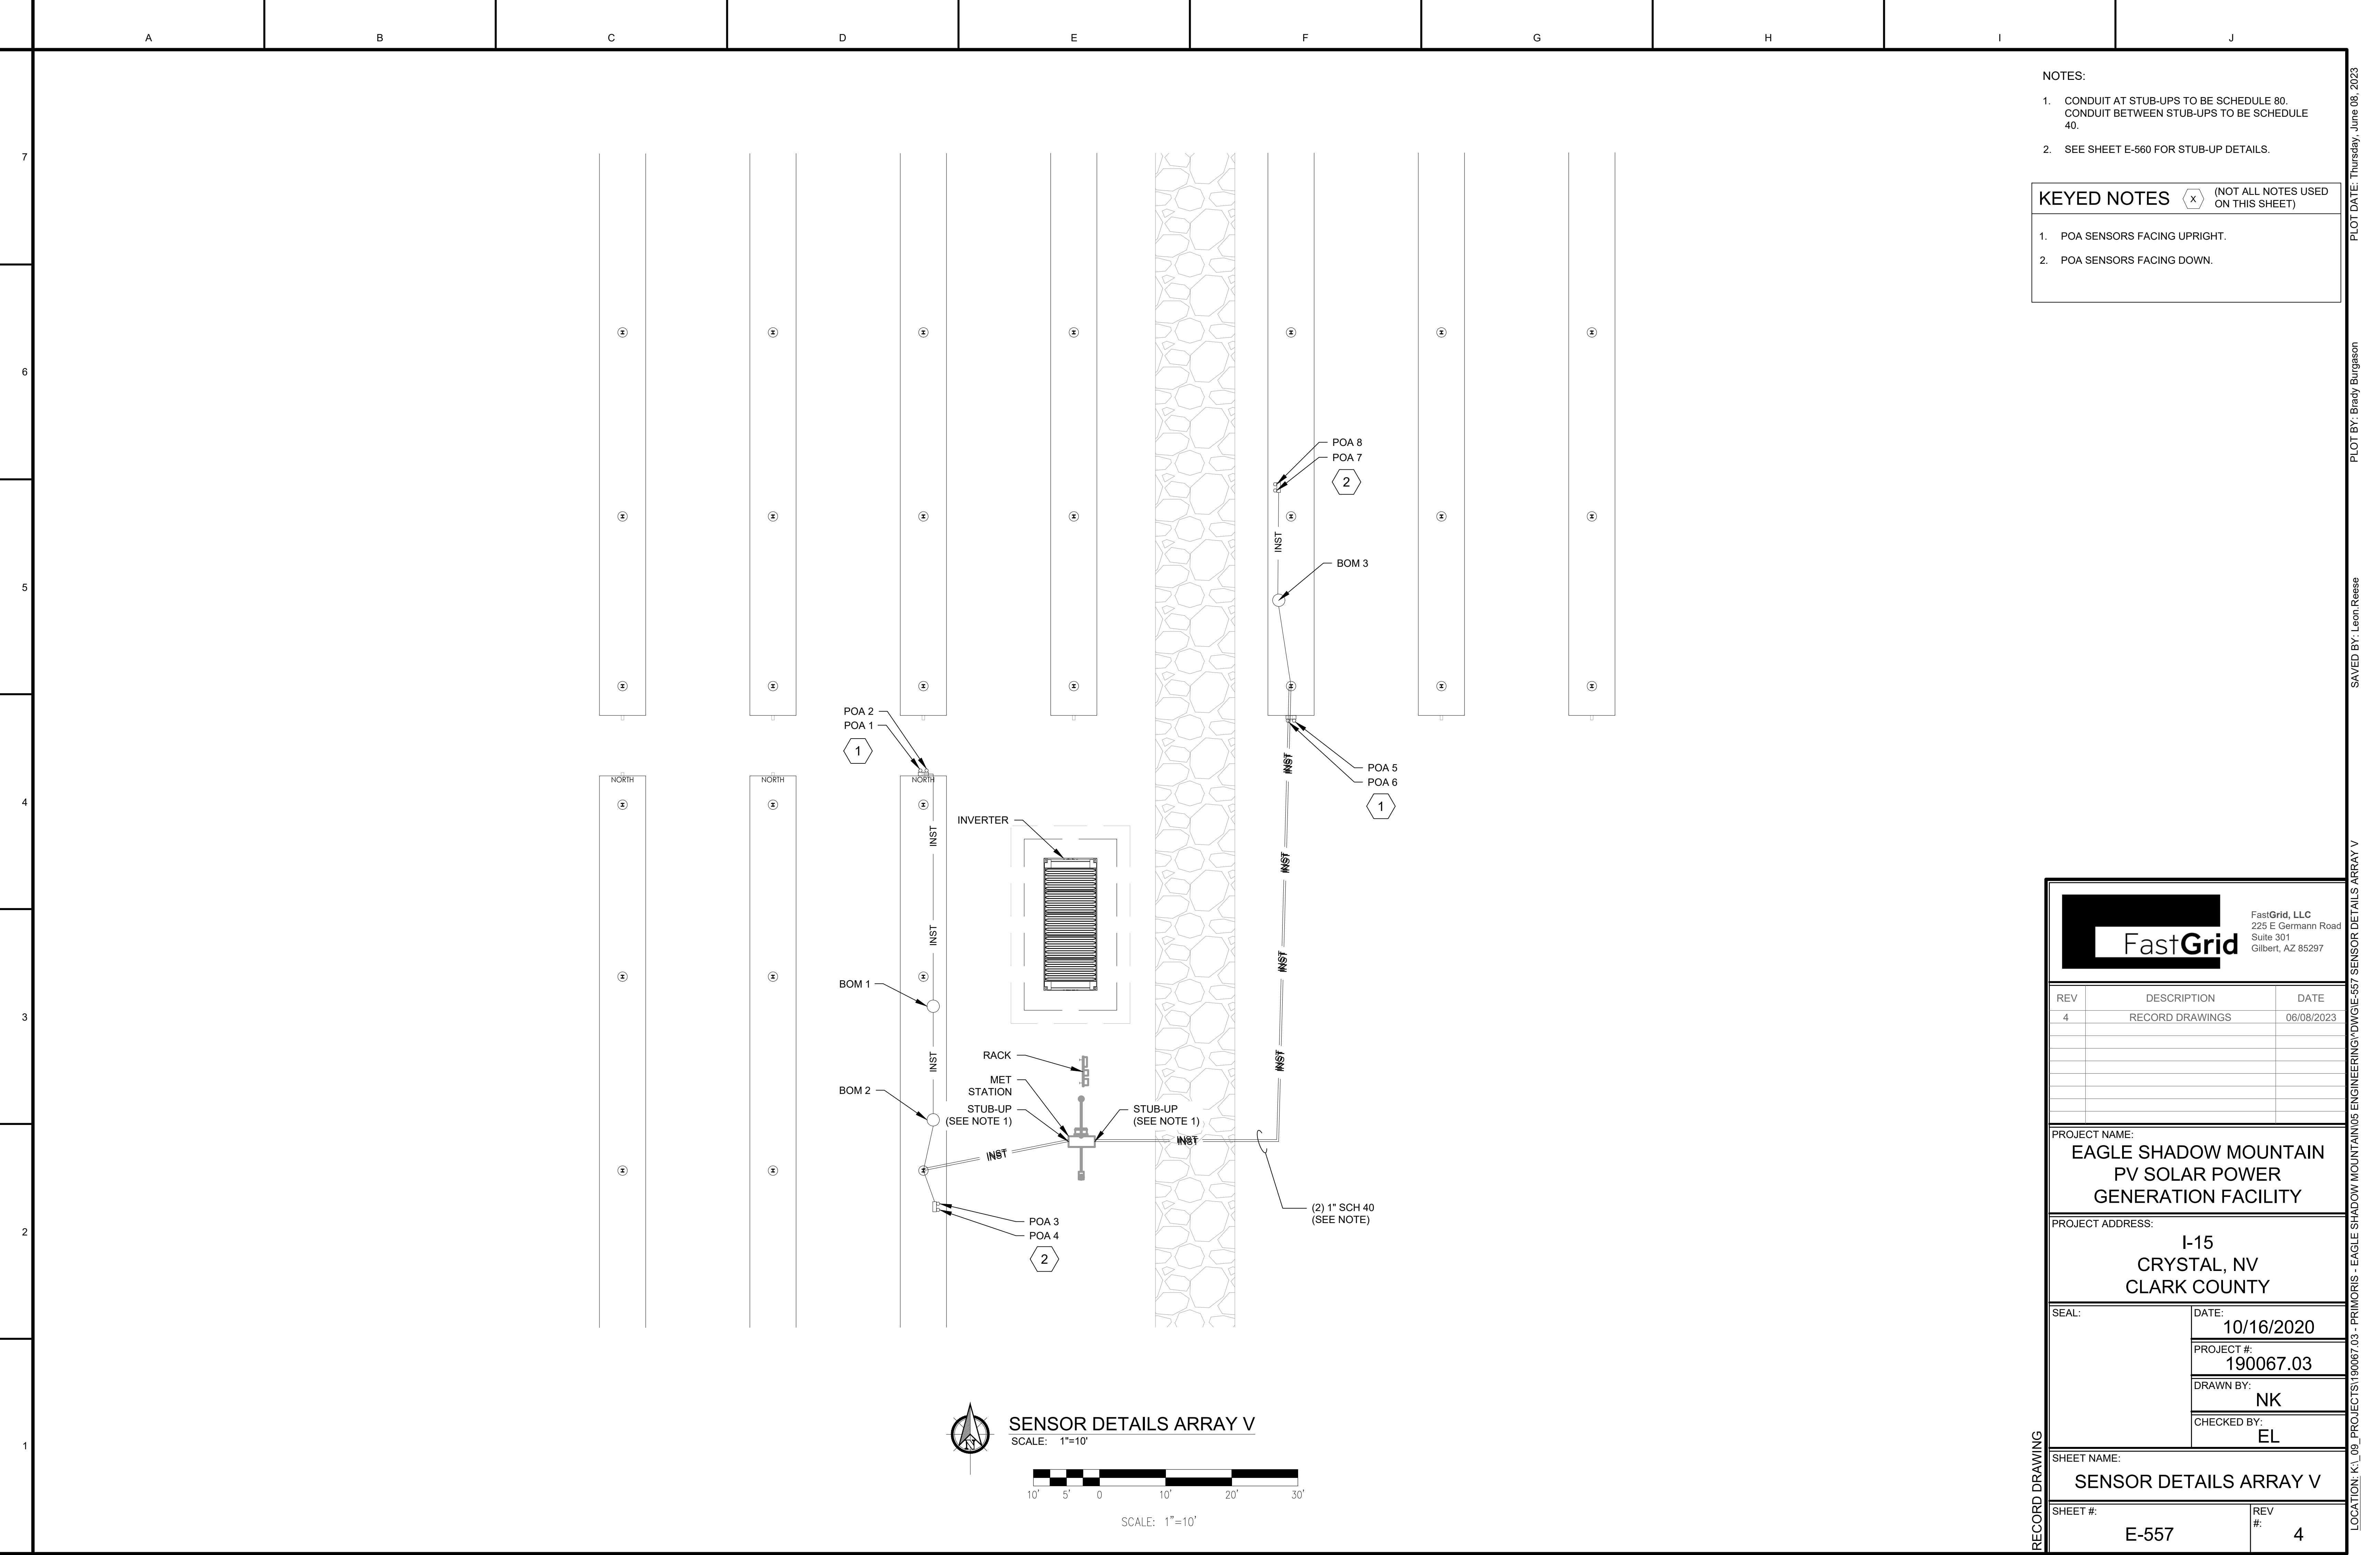

NOTES:

1. CONDUIT AT STUB-UPS TO BE SCHEDULE 80.
CONDUIT BETWEEN STUB-UPS TO BE SCHEDULE 40.

2. SEE SHEET E-560 FOR STUB-UP DETAILS.

KEYED NOTES

(NOT ALL NOTES USED ON THIS SHEET)

1. POA SENSORS FACING UPRIGHT.

2. POA SENSORS FACING DOWN.

FastGrid

FastGrid, LLC
225 E Germann Road
Suite 301
Gilbert, AZ 85297

REV	DESCRIPTION	DATE
4	RECORD DRAWINGS	06/08/2023

PROJECT NAME:

EAGLE SHADOW MOUNTAIN
PV SOLAR POWER
GENERATION FACILITY

PROJECT ADDRESS:

I-15
CRYSTAL, NV
CLARK COUNTY

SEAL:

DATE:
10/16/2020

PROJECT #:
190067.03

DRAWN BY:
NK

CHECKED BY:
EL


SHEET NAME:

SENSOR DETAILS ARRAY V


SHEET #:
E-557

REV #:
4


RECORD DRAWING

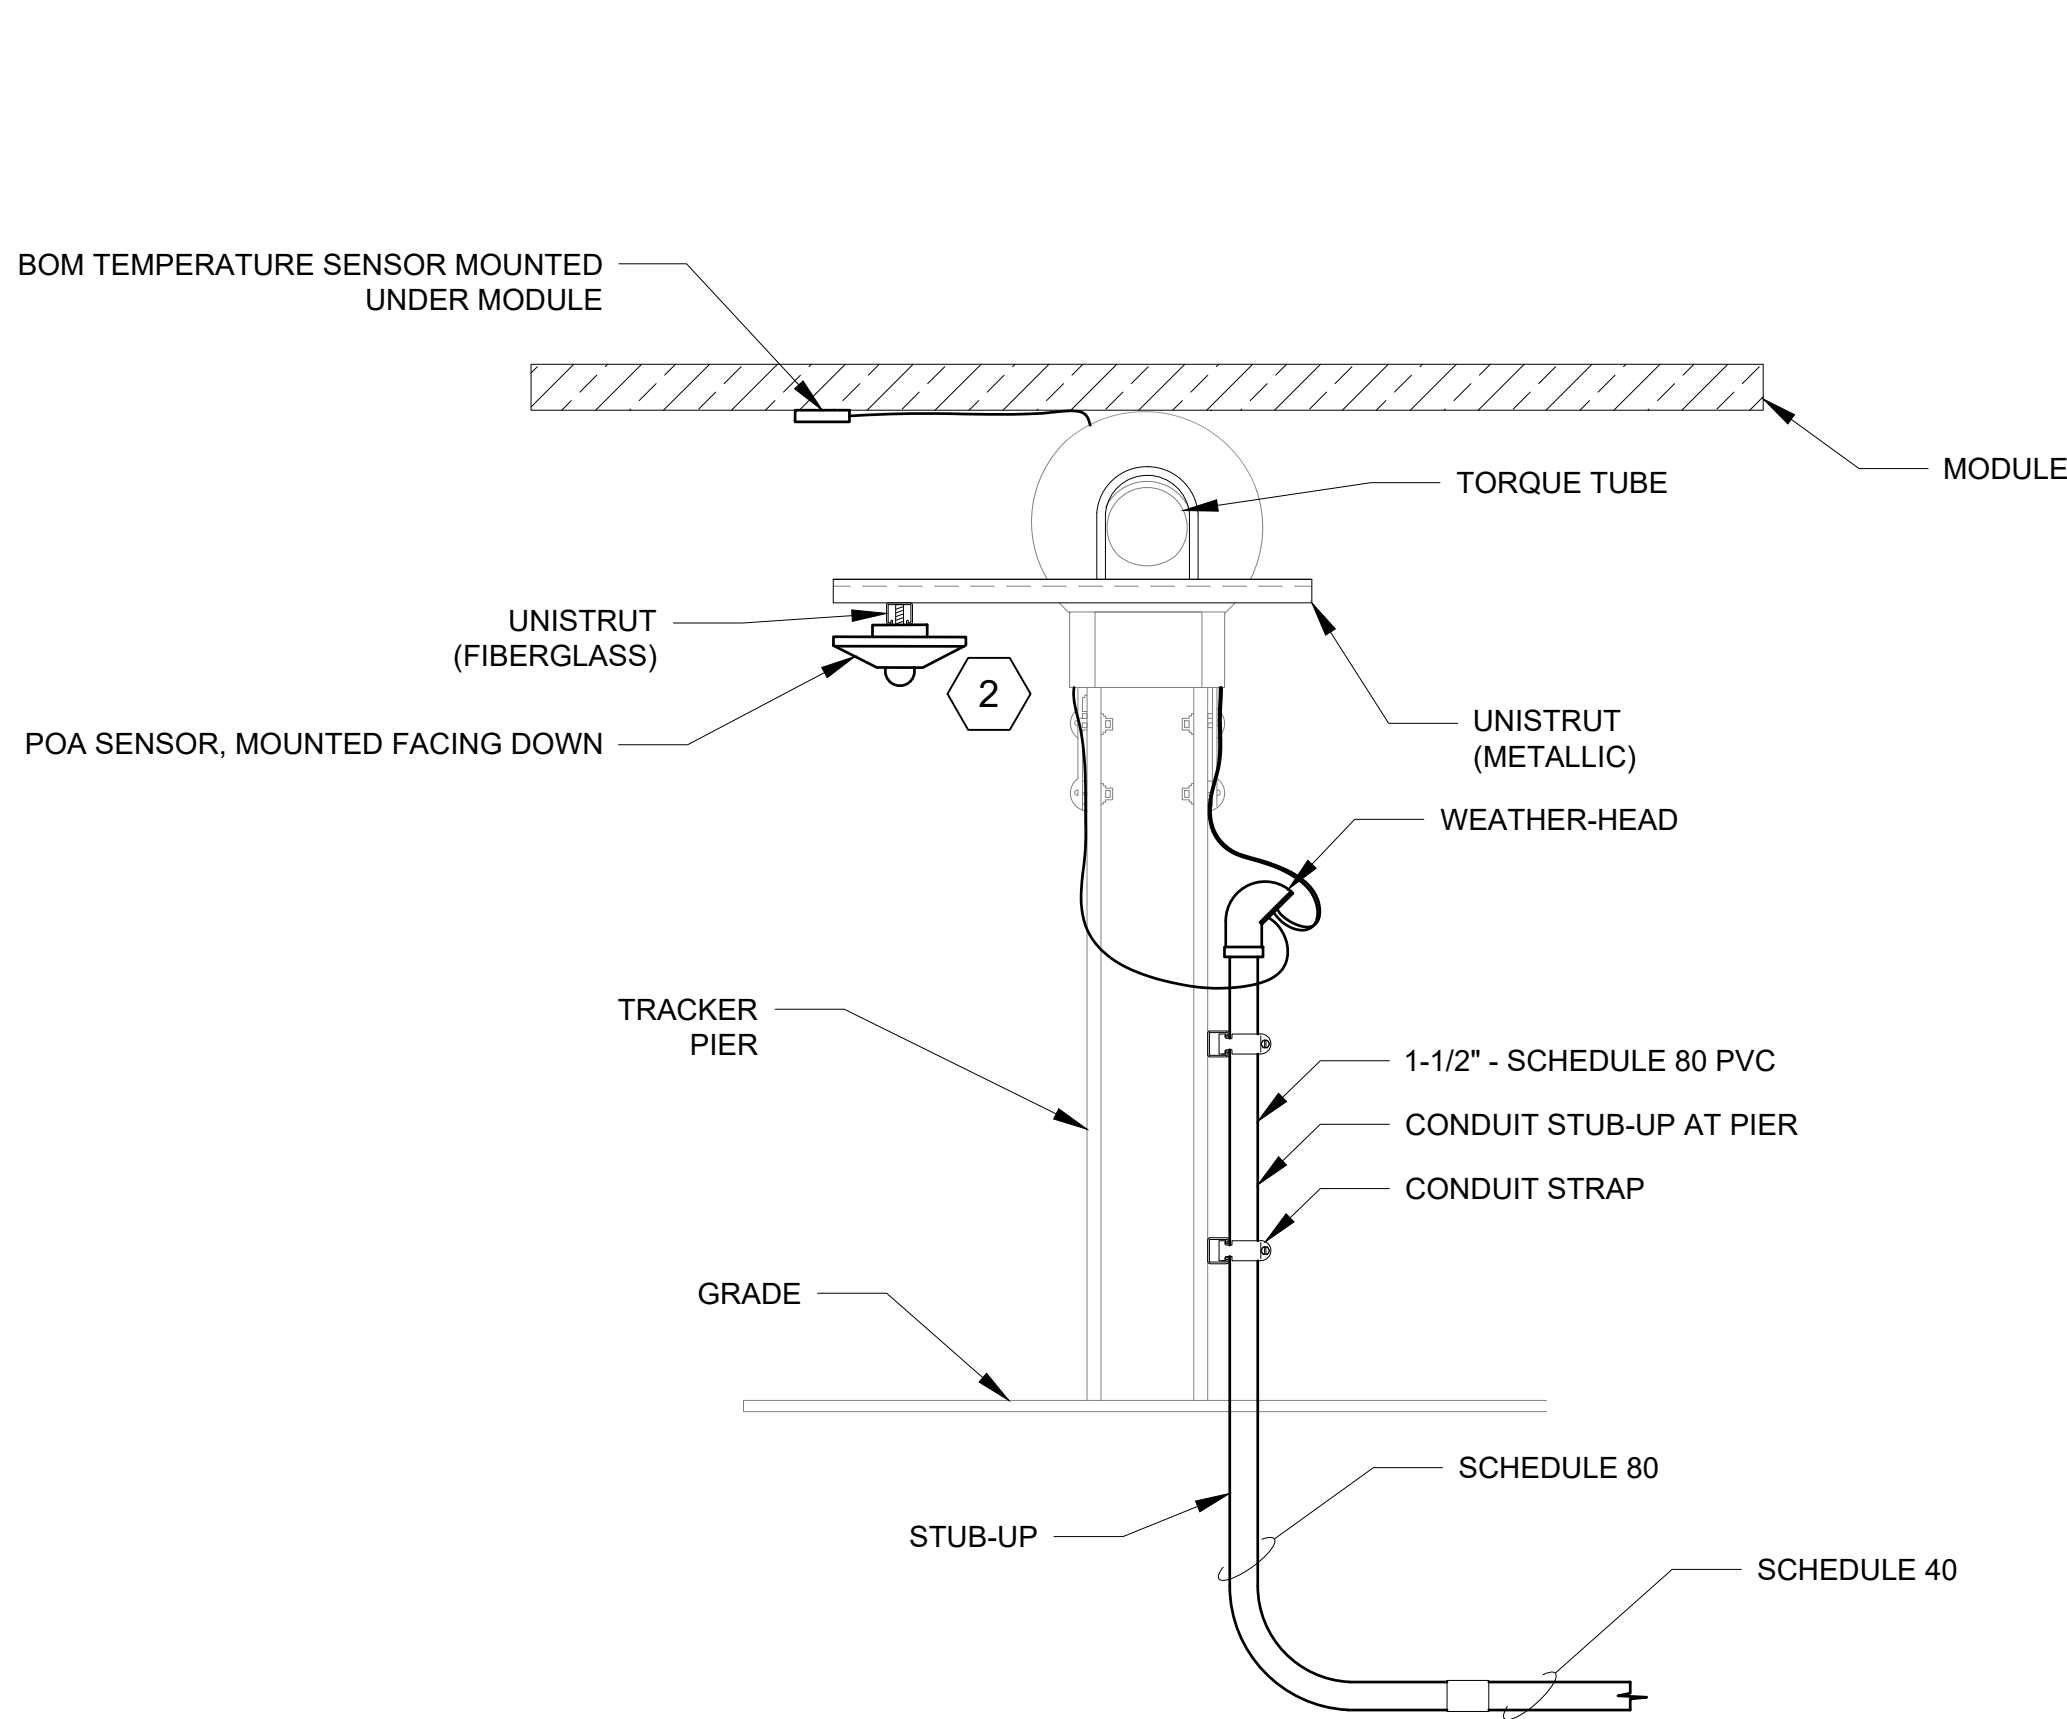

2 SENSOR MOUNTING ELEVATION AT TABLE
SCALE: N.T.S.

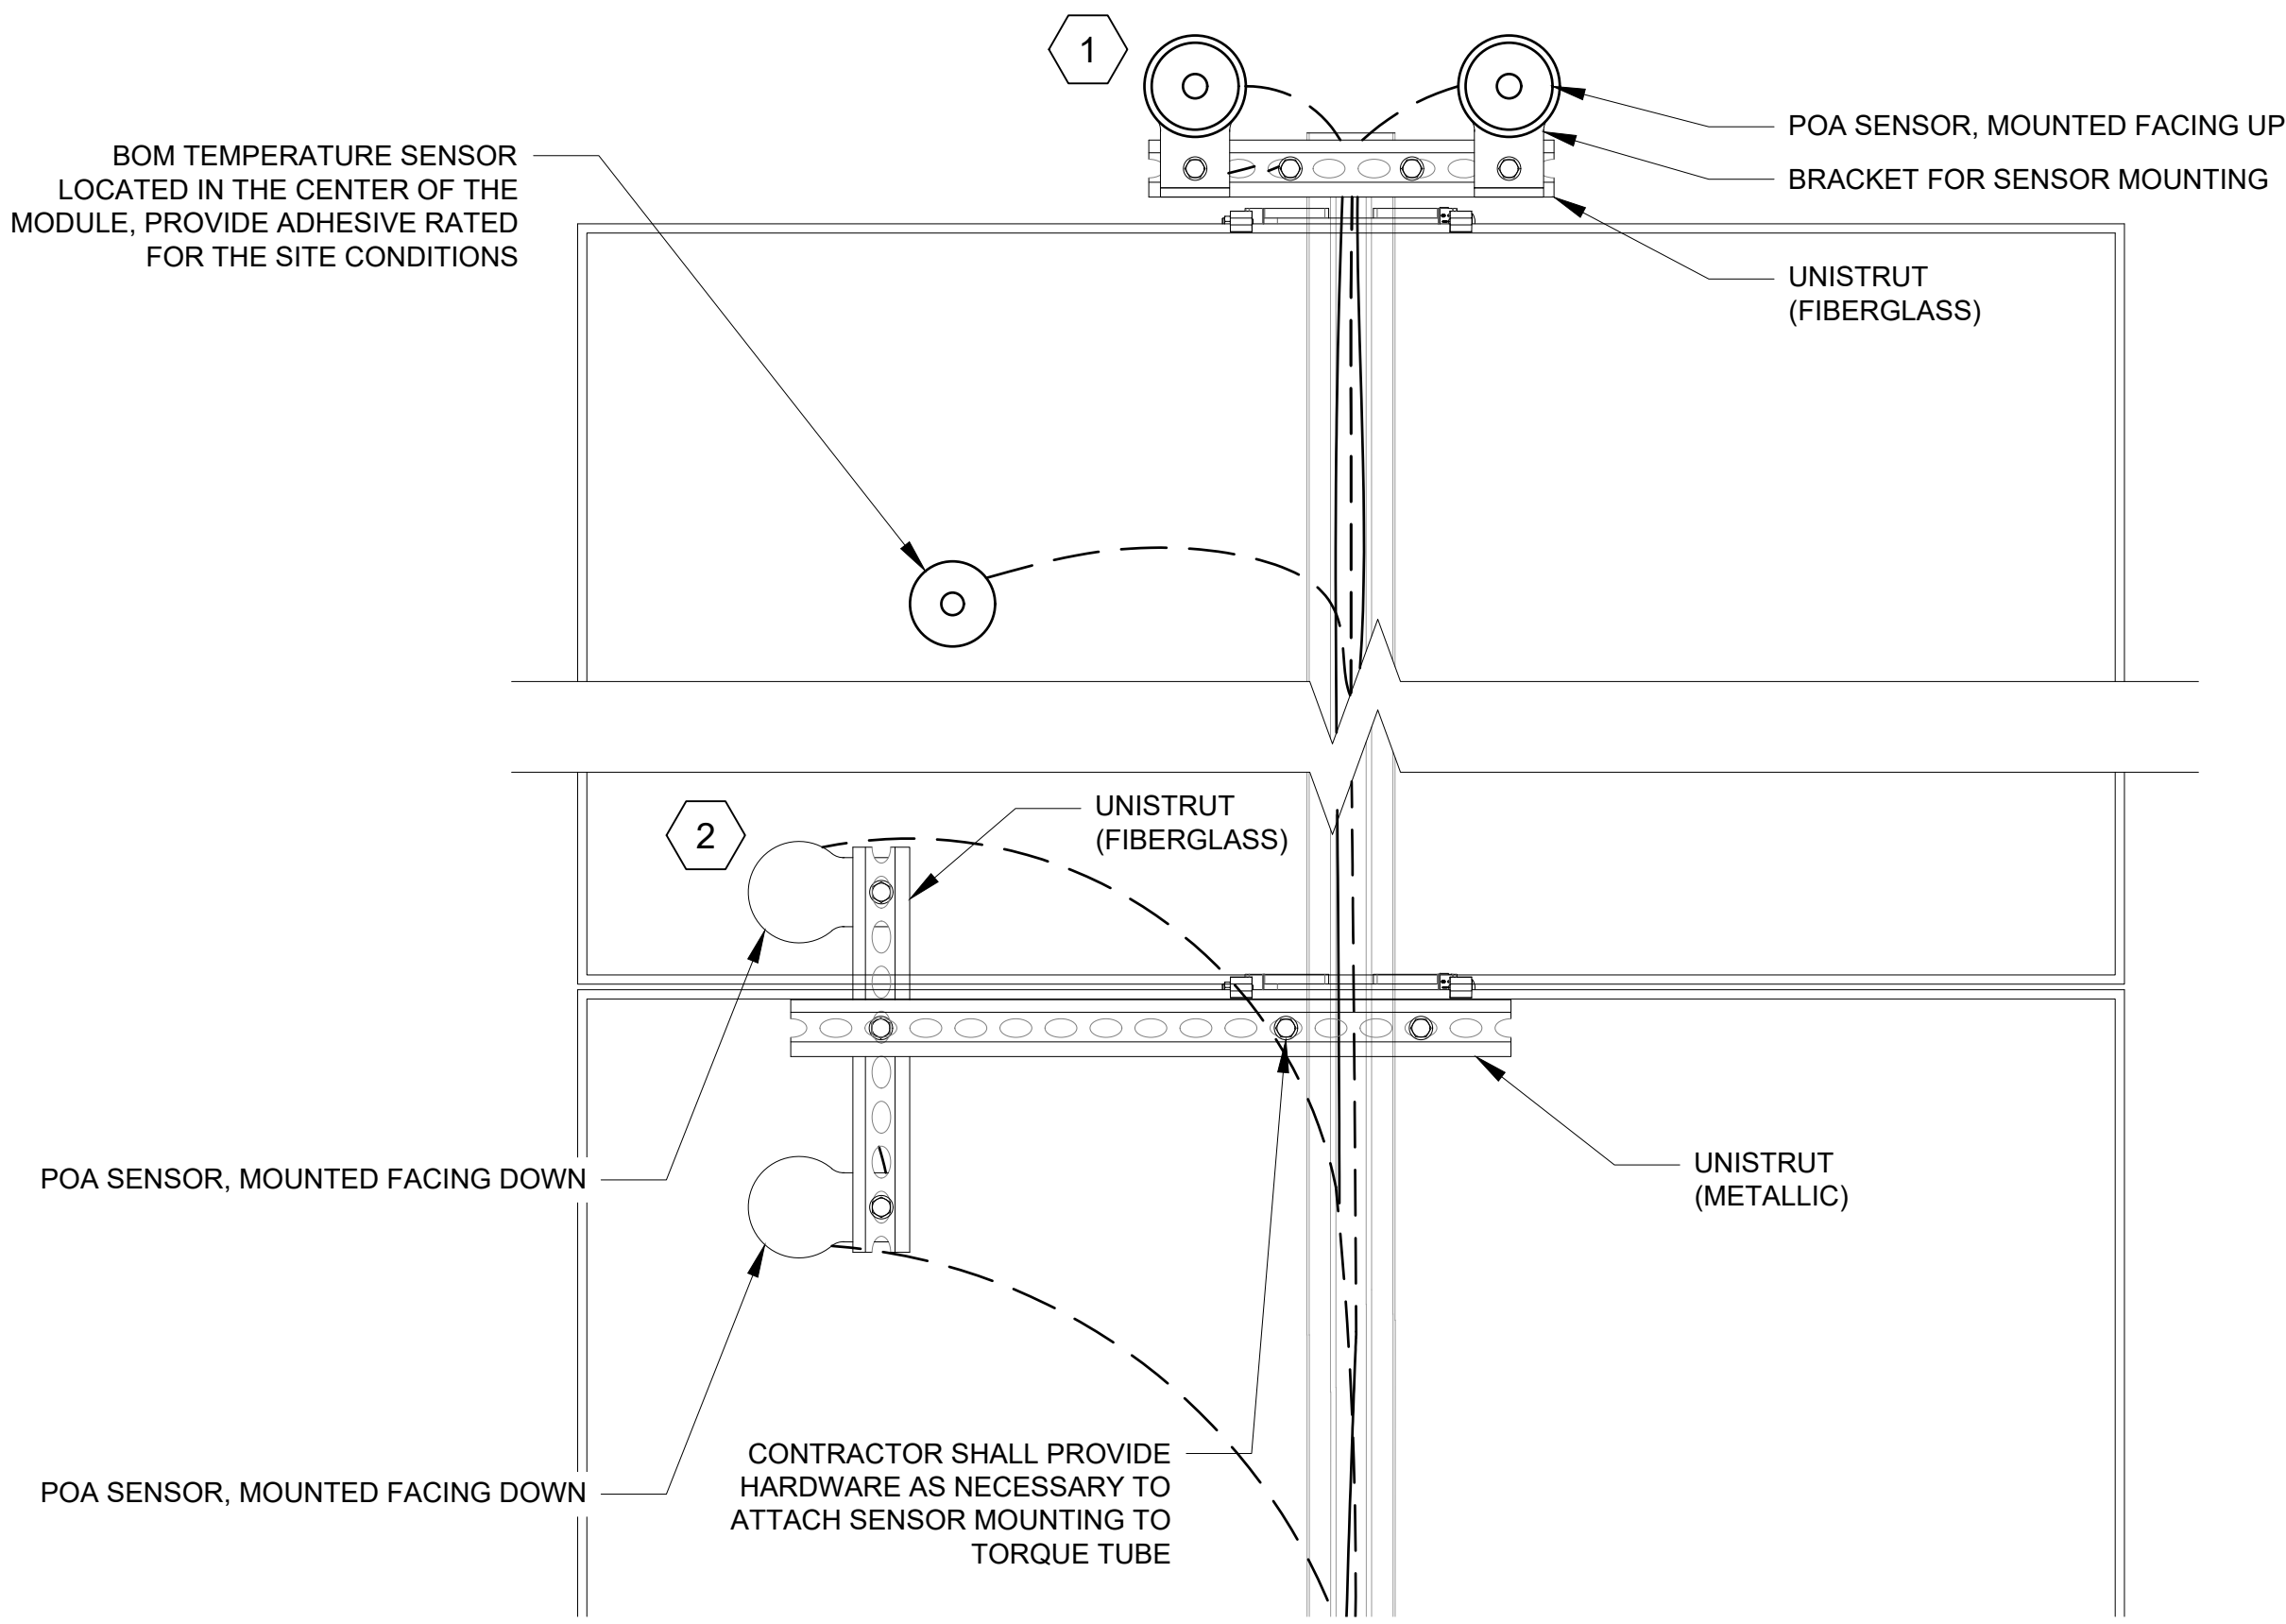

1 SENSOR MOUNTING PLAN VIEW
SCALE: N.T.S.

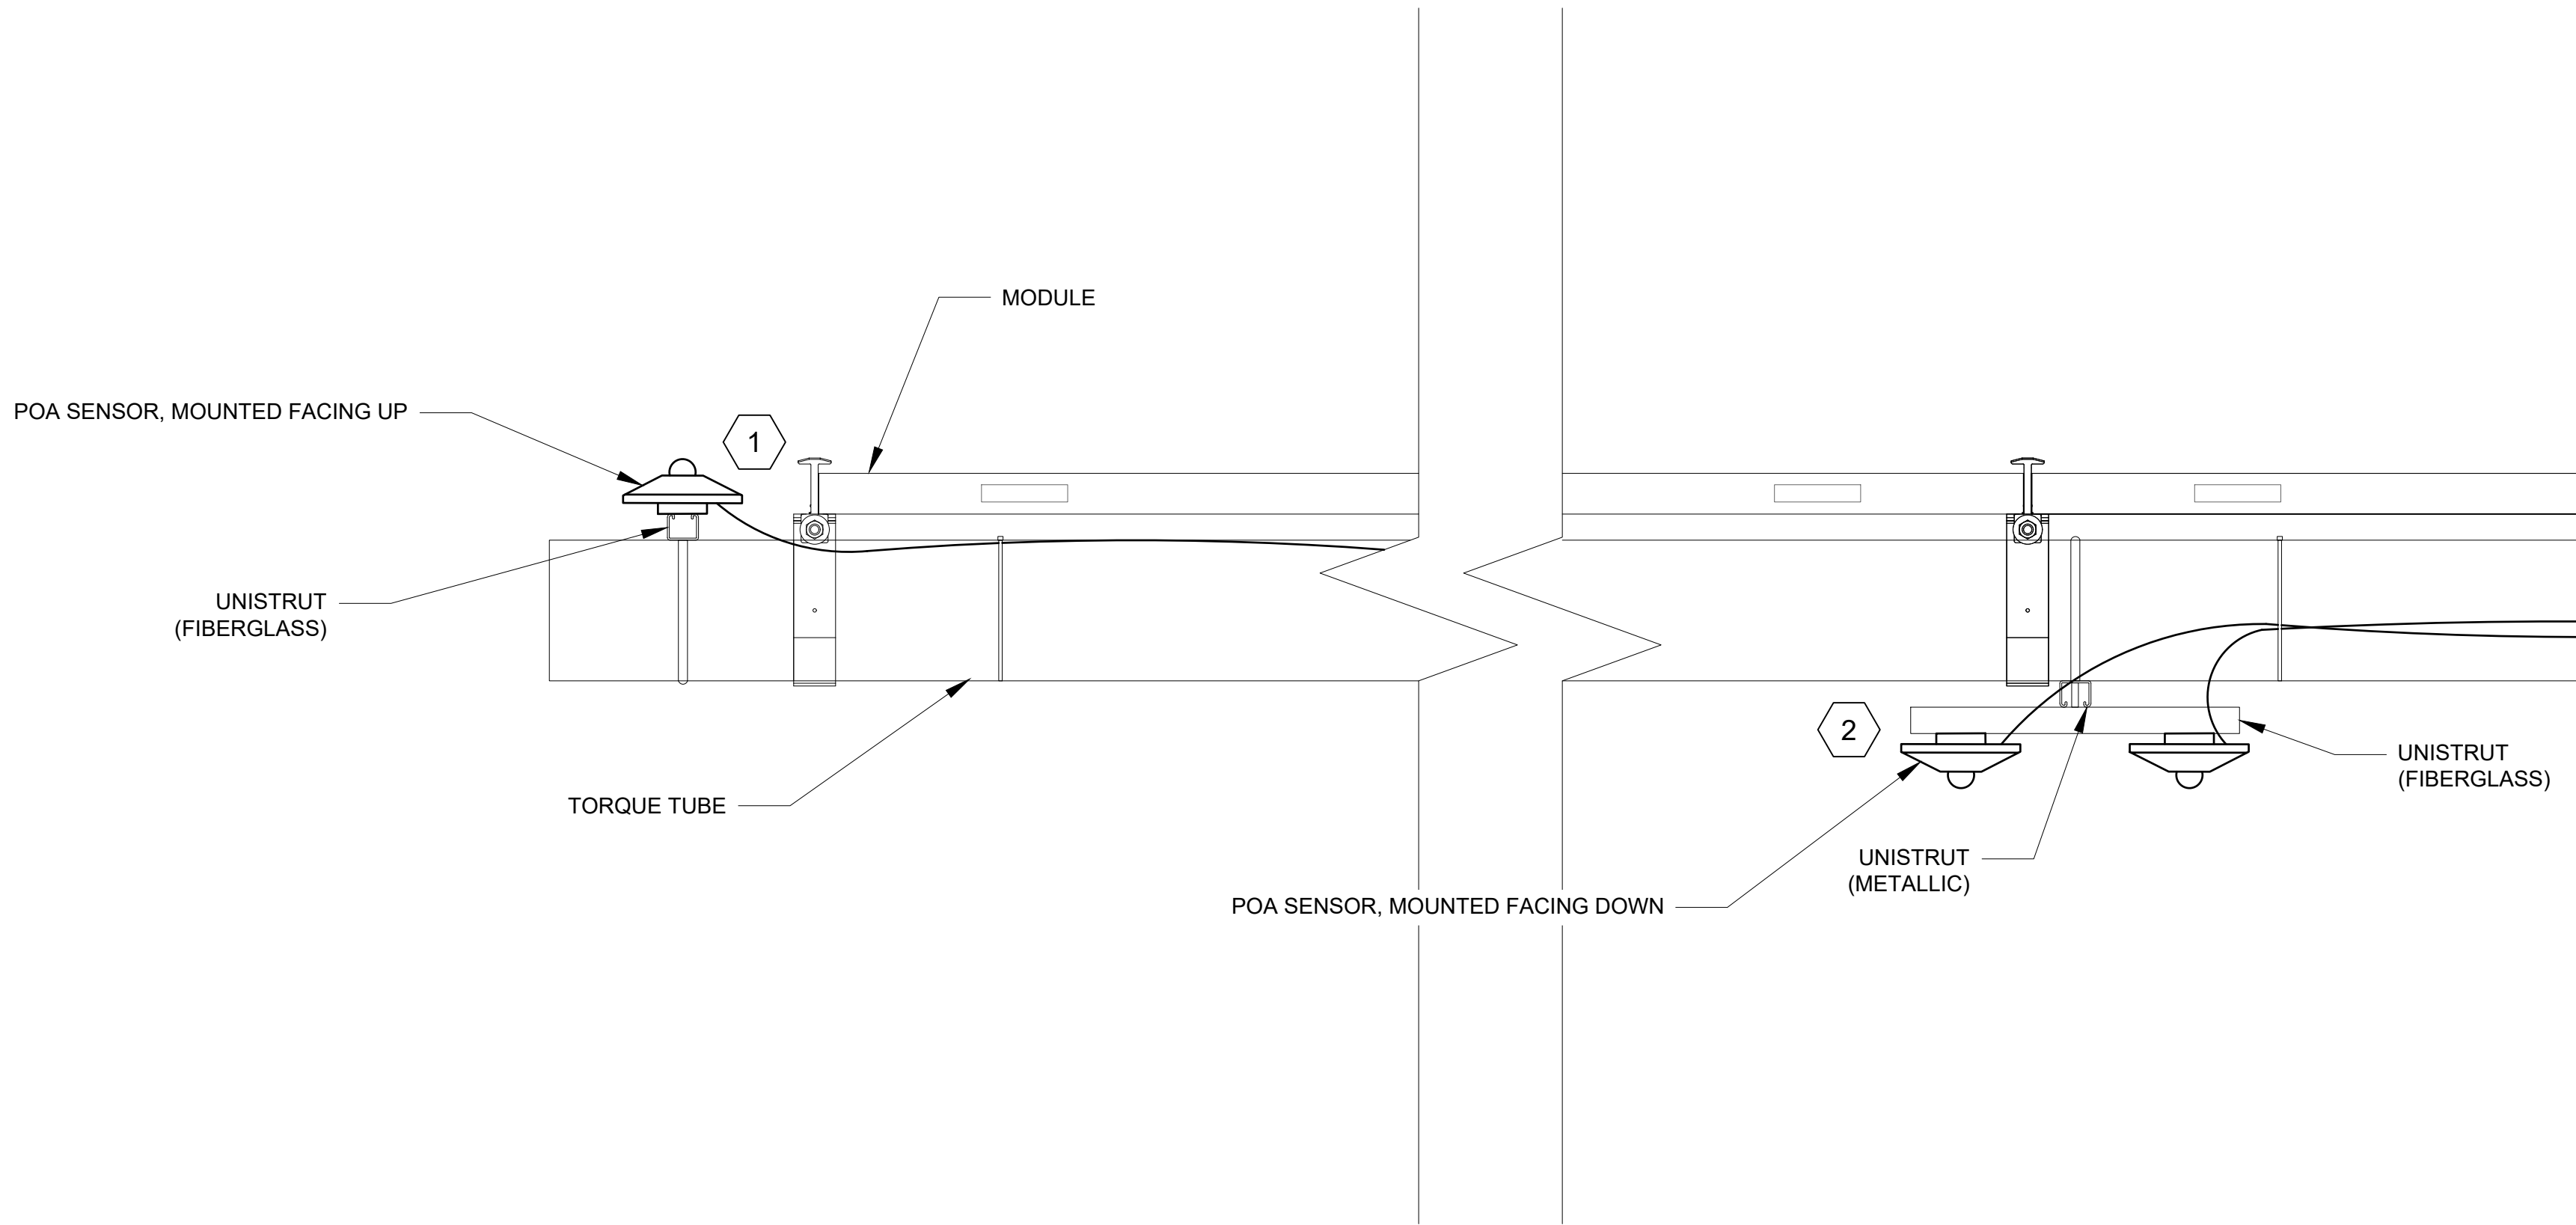

3 SENSOR MOUNTING ELEVATION AT TABLE
SCALE: N.T.S.

KEYED NOTES

(NOT ALL NOTES USED ON THIS SHEET)

1.

POA SENSORS FACING UPRIGHT.

2.

POA SENSORS FACING DOWN.

FastGrid

FastGrid, LLC
225 E Germann Road
Suite 301
Gilbert, AZ 85297

REV	DESCRIPTION	DATE
4	RECORD DRAWINGS	06/08/2023

PROJECT NAME:
EAGLE SHADOW MOUNTAIN
PV SOLAR POWER
GENERATION FACILITY

PROJECT ADDRESS:
I-15
CRYSTAL, NV
CLARK COUNTY

SEAL:

DATE:
10/16/2020

PROJECT #:
190067.03

DRAWN BY:
LF


CHECKED BY:
EL

SHEET NAME:
SENSOR DETAILS

SHEET #:
E-560

REV #:
-

RECORD DRAWING

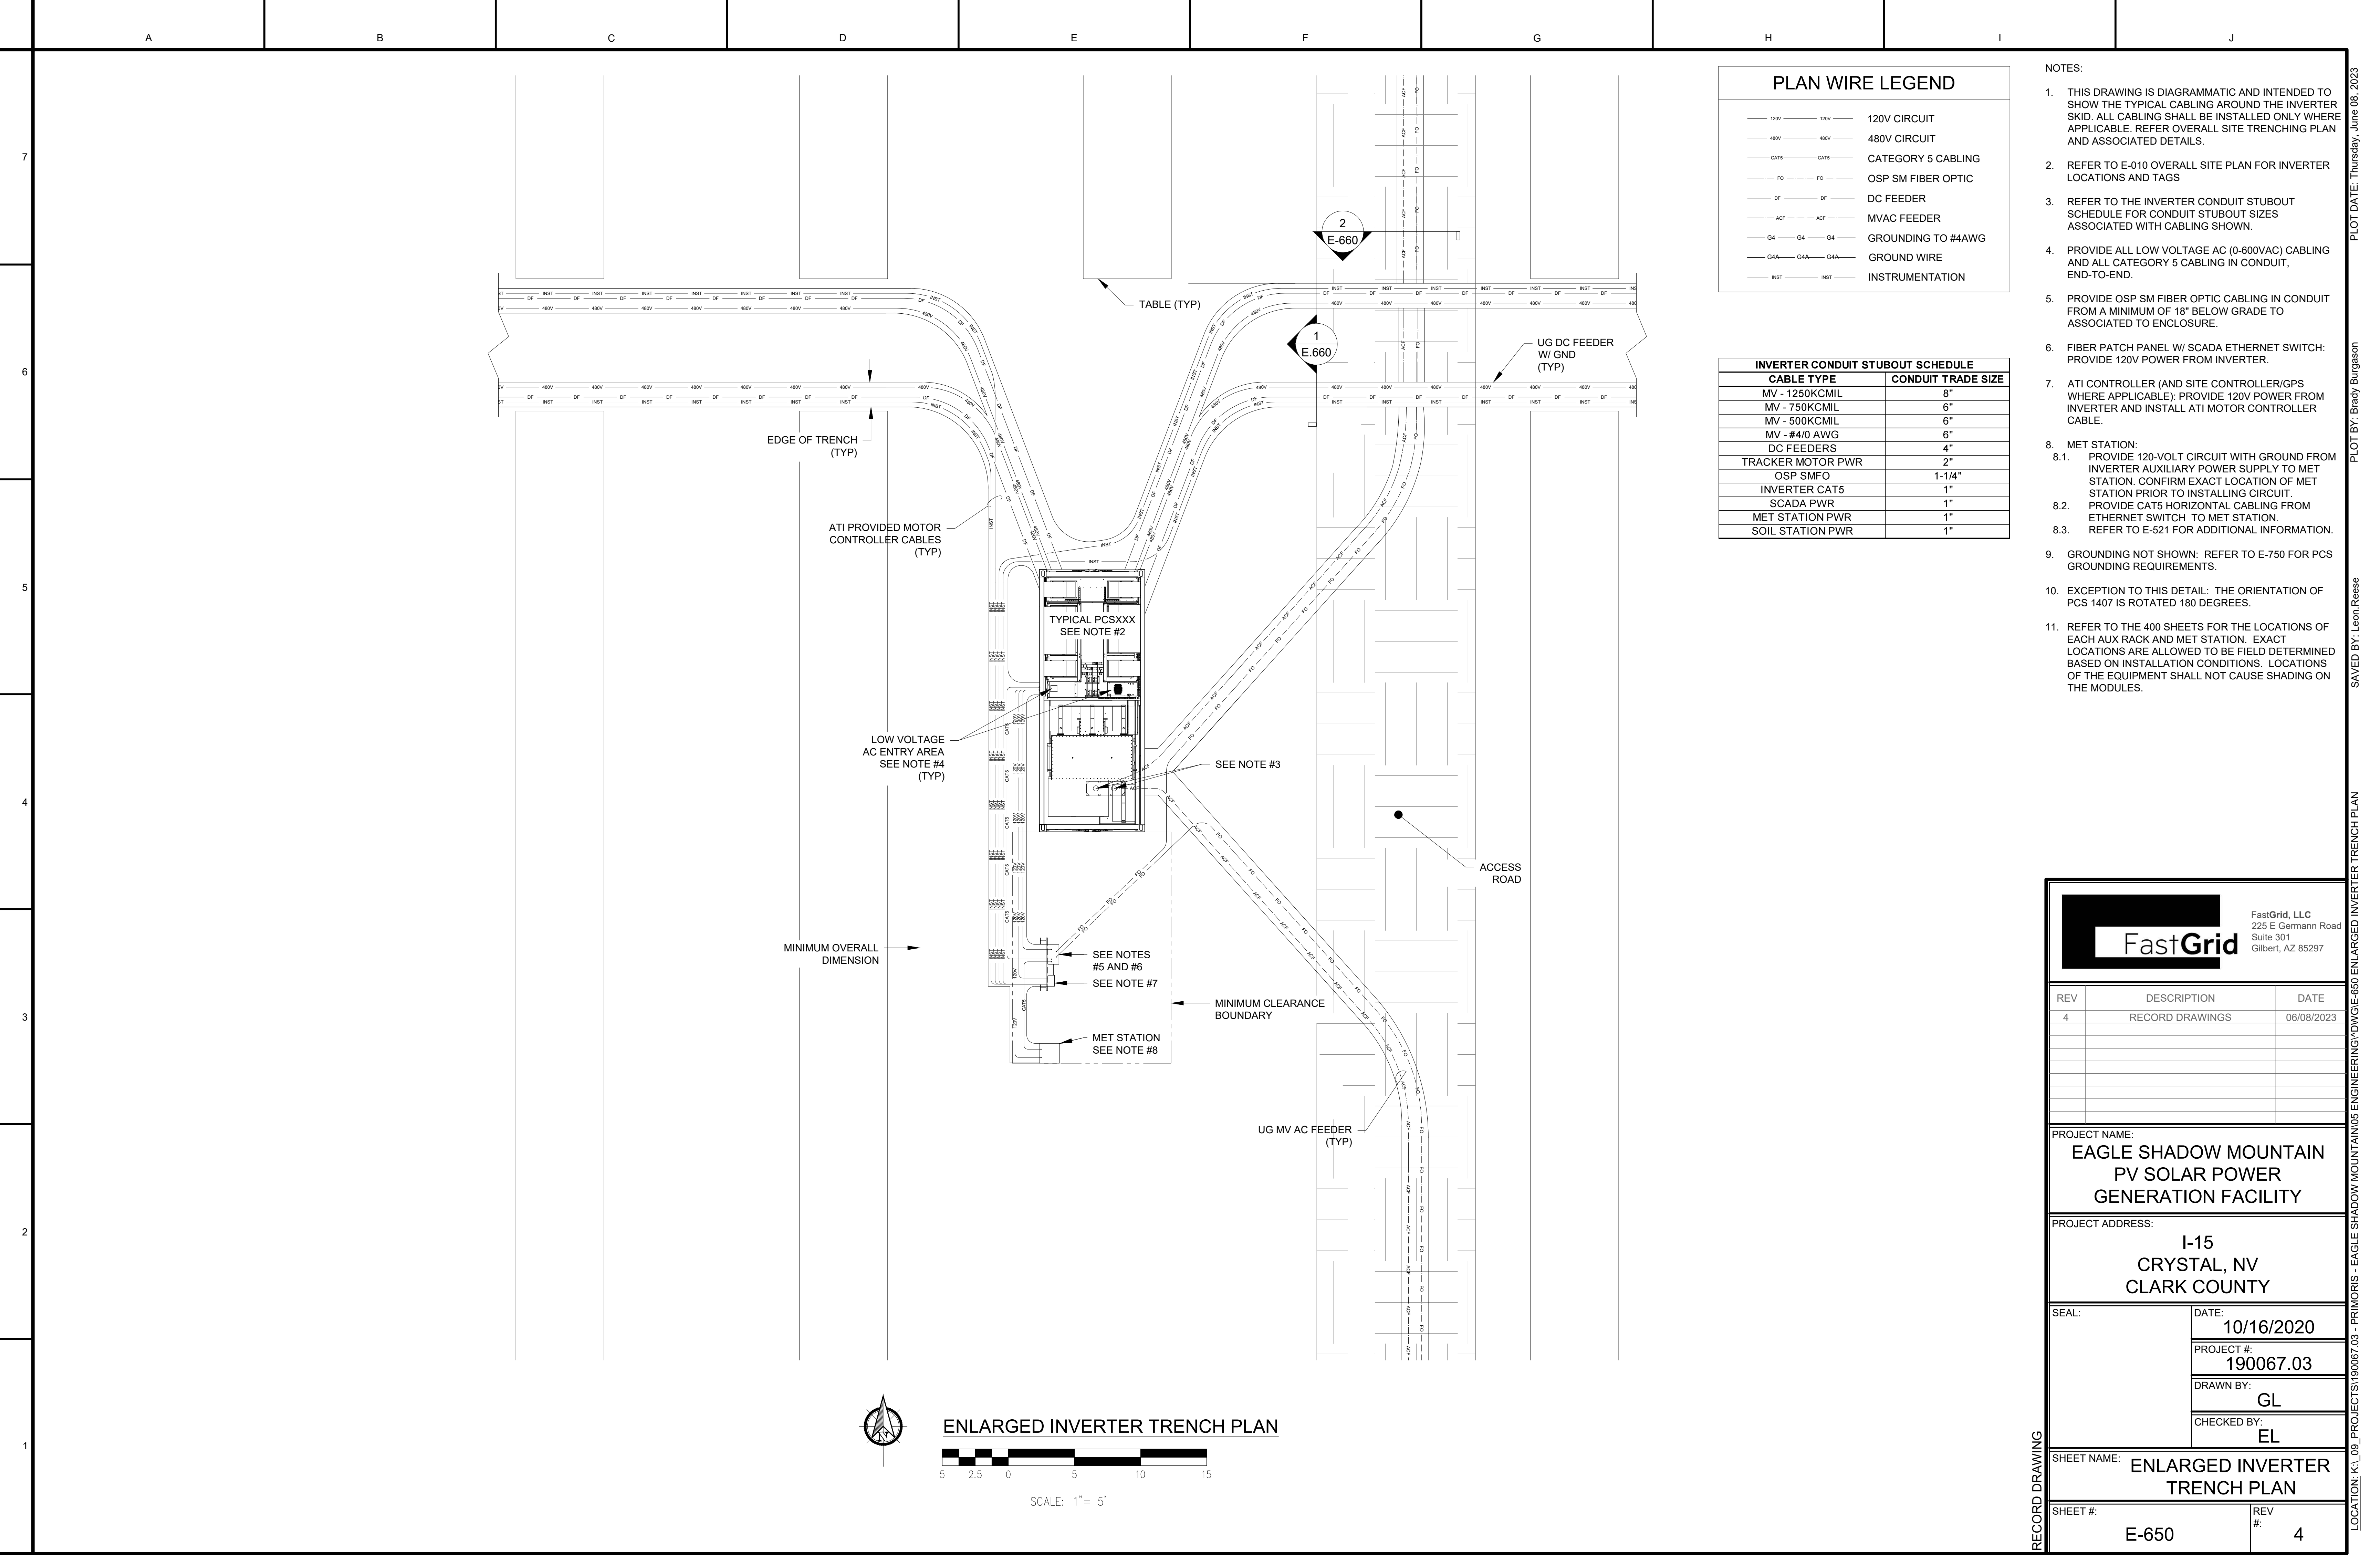

PLAN WIRE LEGEND

120V

120V

120V CIRCUIT

480V

480V

480V CIRCUIT

CAT5

CAT5

CATEGORY 5 CABLING

OSP

OSP

OSP SM FIBER OPTIC

DC

DC

DC FEEDER

MVAC

MVAC

MVAC FEEDER

G4

G4

GROUNDING TO #4AWG

G4A

G4A

GROUND WIRE

INST

INST

INSTRUMENTATION

INVERTER CONDUIT STUBOUT SCHEDULE	
CABLE TYPE	CONDUIT TRADE SIZE
MV - 1250KCMIL	8"
MV - 750KCMIL	6"
MV - 500KCMIL	6"
MV - #4/0 AWG	6"
DC FEEDERS	4"
TRACKER MOTOR PWR	2"
OSP SMFO	1-1/4"
INVERTER CAT5	1"
SCADA PWR	1"
MET STATION PWR	1"
SOIL STATION PWR	1"

- NOTES:
1.

THIS DRAWING IS DIAGRAMMATIC AND INTENDED TO SHOW THE TYPICAL CABLING AROUND THE INVERTER SKID. ALL CABLING SHALL BE INSTALLED ONLY WHERE APPLICABLE. REFER OVERALL SITE TRENCHING PLAN AND ASSOCIATED DETAILS.
2.

REFER TO E-010 OVERALL SITE PLAN FOR INVERTER LOCATIONS AND TAGS
3.

REFER TO THE INVERTER CONDUIT STUBOUT SCHEDULE FOR CONDUIT STUBOUT SIZES ASSOCIATED WITH CABLING SHOWN.
4.

PROVIDE ALL LOW VOLTAGE AC (0-600VAC) CABLING AND ALL CATEGORY 5 CABLING IN CONDUIT, END-TO-END.
5.

PROVIDE OSP SM FIBER OPTIC CABLING IN CONDUIT FROM A MINIMUM OF 18" BELOW GRADE TO ASSOCIATED TO ENCLOSURE.
6.

FIBER PATCH PANEL W/ SCADA ETHERNET SWITCH: PROVIDE 120V POWER FROM INVERTER.
7.

ATI CONTROLLER (AND SITE CONTROLLER/GPS WHERE APPLICABLE): PROVIDE 120V POWER FROM INVERTER AND INSTALL ATI MOTOR CONTROLLER CABLE.
8.

MET STATION:
- 8.1.

PROVIDE 120-VOLT CIRCUIT WITH GROUND FROM INVERTER AUXILIARY POWER SUPPLY TO MET STATION. CONFIRM EXACT LOCATION OF MET STATION PRIOR TO INSTALLING CIRCUIT.
- 8.2.

PROVIDE CAT5 HORIZONTAL CABLING FROM ETHERNET SWITCH TO MET STATION.
- 8.3.

REFER TO E-521 FOR ADDITIONAL INFORMATION.
9.

GROUNDING NOT SHOWN: REFER TO E-750 FOR PCS GROUNDING REQUIREMENTS.
10.

EXCEPTION TO THIS DETAIL: THE ORIENTATION OF PCS 1407 IS ROTATED 180 DEGREES.
11.

REFER TO THE 400 SHEETS FOR THE LOCATIONS OF EACH AUX RACK AND MET STATION. EXACT LOCATIONS ARE ALLOWED TO BE FIELD DETERMINED BASED ON INSTALLATION CONDITIONS. LOCATIONS OF THE EQUIPMENT SHALL NOT CAUSE SHADING ON THE MODULES.

FastGrid

FastGrid, LLC
225 E Germann Road
Suite 301
Gilbert, AZ 85297

REV	DESCRIPTION	DATE
4	RECORD DRAWINGS	06/08/2023

PROJECT NAME:
EAGLE SHADOW MOUNTAIN
PV SOLAR POWER
GENERATION FACILITY

PROJECT ADDRESS:
I-15
CRYSTAL, NV
CLARK COUNTY

SEAL:

DATE:
10/16/2020

PROJECT #:
190067.03

DRAWN BY:
GL

CHECKED BY:
EL

SHEET NAME:
ENLARGED INVERTER
TRENCH PLAN

SHEET #:
E-650

REV #:
4

ENLARGED INVERTER TRENCH PLAN

52.500

2.500

0


5

10

15

SCALE: 1"= 5'


RECORD DRAWING

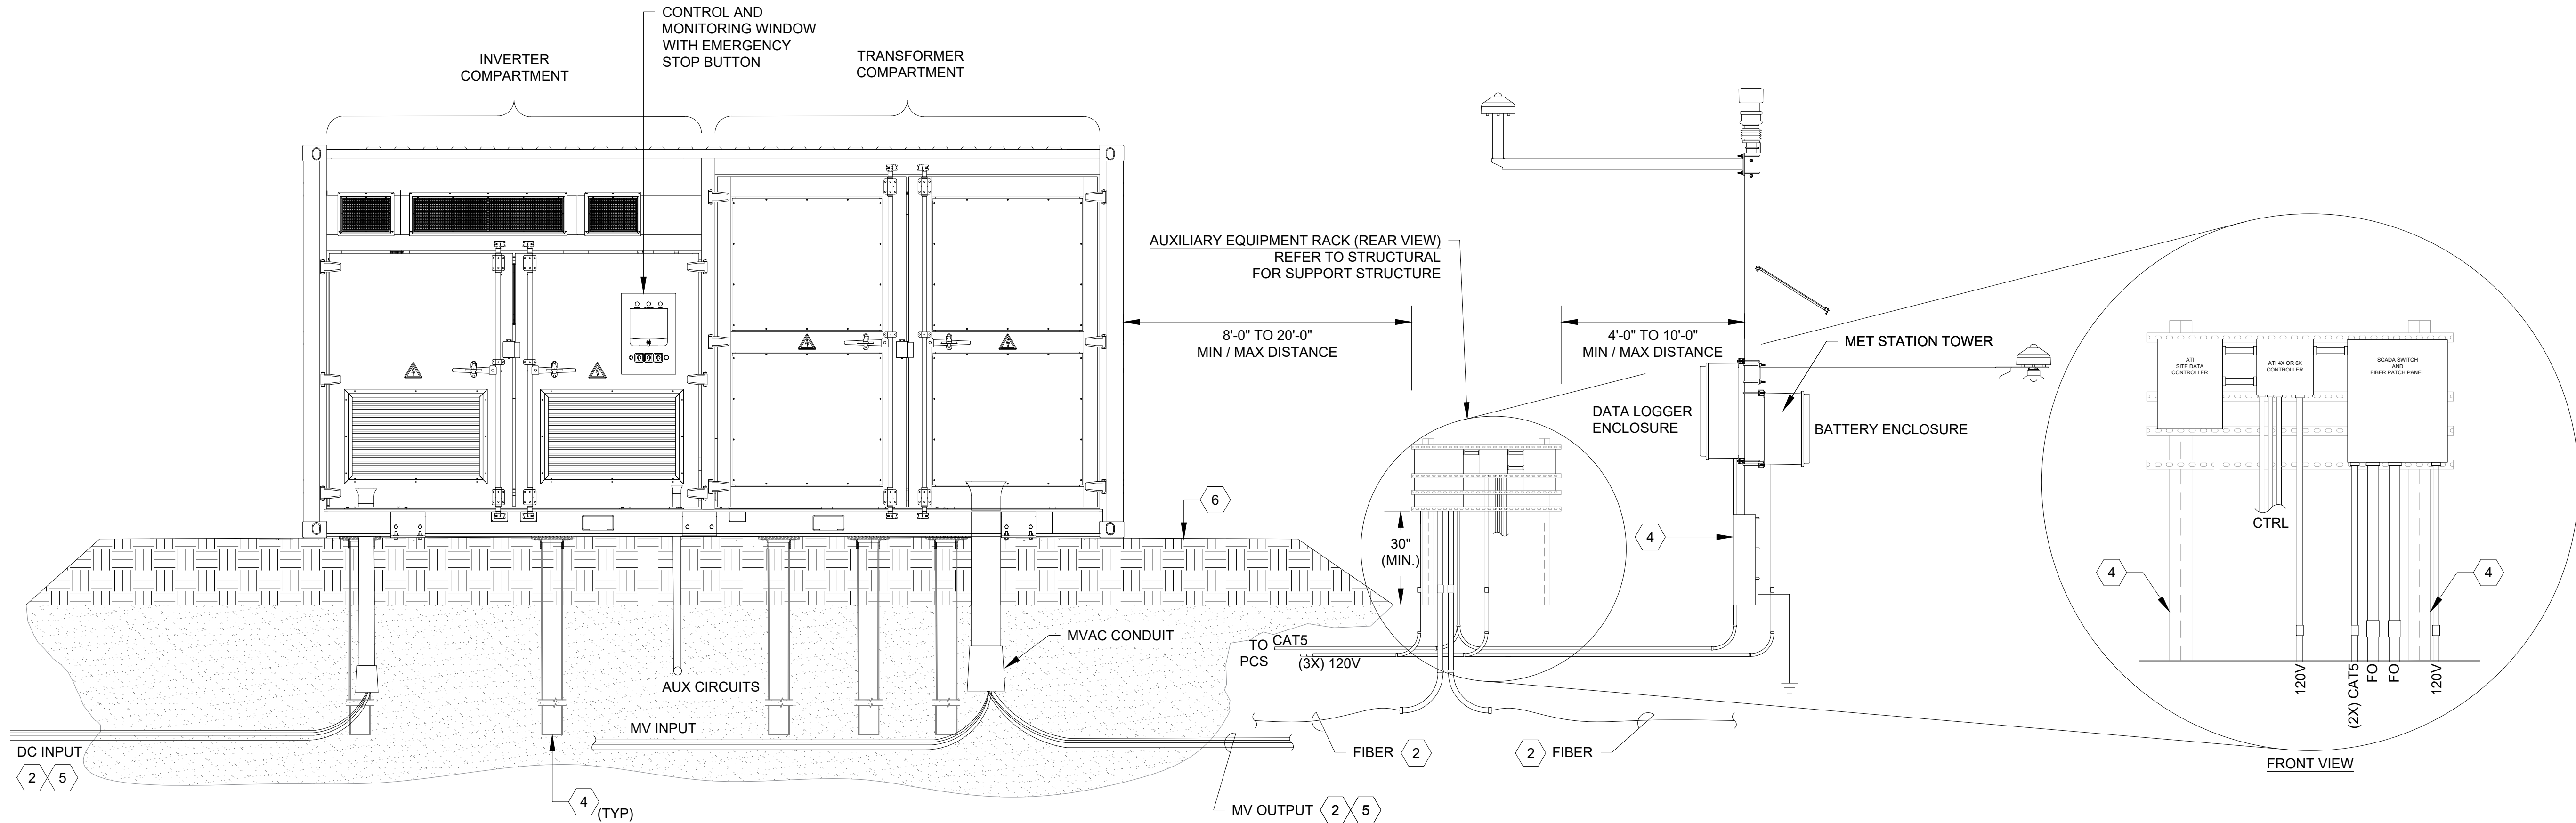


1 TYPICAL INVERTER SKID ELEVATION (WEST VIEW)
SCALE: NTS

2 TYPICAL AUXILIARY EQUIPMENT RACK
SCALE: NTS


- NOTES:
- DIMENSIONS SHOWN ARE APPROXIMATE. EQUIPMENT DIMENSIONS SHALL BE CONFIRMED IN THE FIELD WITH CERTIFIED EQUIPMENT DRAWINGS OR THE ACTUAL EQUIPMENT.
 - ENSURE ADEQUATE WORKING CLEARANCES PER NEC 110. HATCH AREAS REPRESENT WORKING CLEARANCES PER NEC 110.26 UNLESS NOTED OTHERWISE.
 - ENSURE MINIMUM BENDING RADIUS FOR ALL CONDUCTORS.
 - BELL ENDS SHALL BE PROVIDED ON CONDUIT ENDS.
 - CONTRACTOR SHALL SEAL ALL CONDUITS WITH APPROVED DUCT SEAL/ELECTRICAL PUTTY AFTER CONDUCTORS ARE IN PLACE.
- KEYED NOTES:
- INVERTER DC RECOMBINER CABINET IS ASYMMETRICAL, THERE ARE FACILITIES FOR FOURTEEN (14) CIRCUITS IN THE LEFT CABINET AND SEVEN (7) ON THE RIGHT. ALL CIRCUIT ROUTING SHOWN IS SCHEMATIC.
 - REFER TO TRENCH DETAILS ON E-660 FOR MINIMUM BURIAL DEPTH, MINIMUM SEPARATION AND COMPACTION REQUIREMENTS.
 - COORDINATE WITH CIVIL AND/OR STRUCTURAL PLANS TO ENSURE THAT SKID BERM OR WALKWAY IS NOT ENCR OACHED AND THAT ALL WORKING CLEARANCES ARE MAINTAINED.
 - SEE STRUCTURAL DRAWINGS FOR PILE AND FOUNDATION DETAILS.
 - BURIAL DEPTHS PER TRENCH DETAILS ON E-660. DEPTHS SHALL BE INCREASED AS REQUIRED WHERE CIRCUITS CROSS.
 - FINAL SKID FOUNDATION SKIRT/WALKWAY DETAILS TBD. DESIGN SHALL BE COORDINATED WITH CIVIL/STRUCTURAL ENGINEERING TO PROVIDE ADEQUATE ACCESS ON ALL SIDES PER NEC REQUIREMENTS.

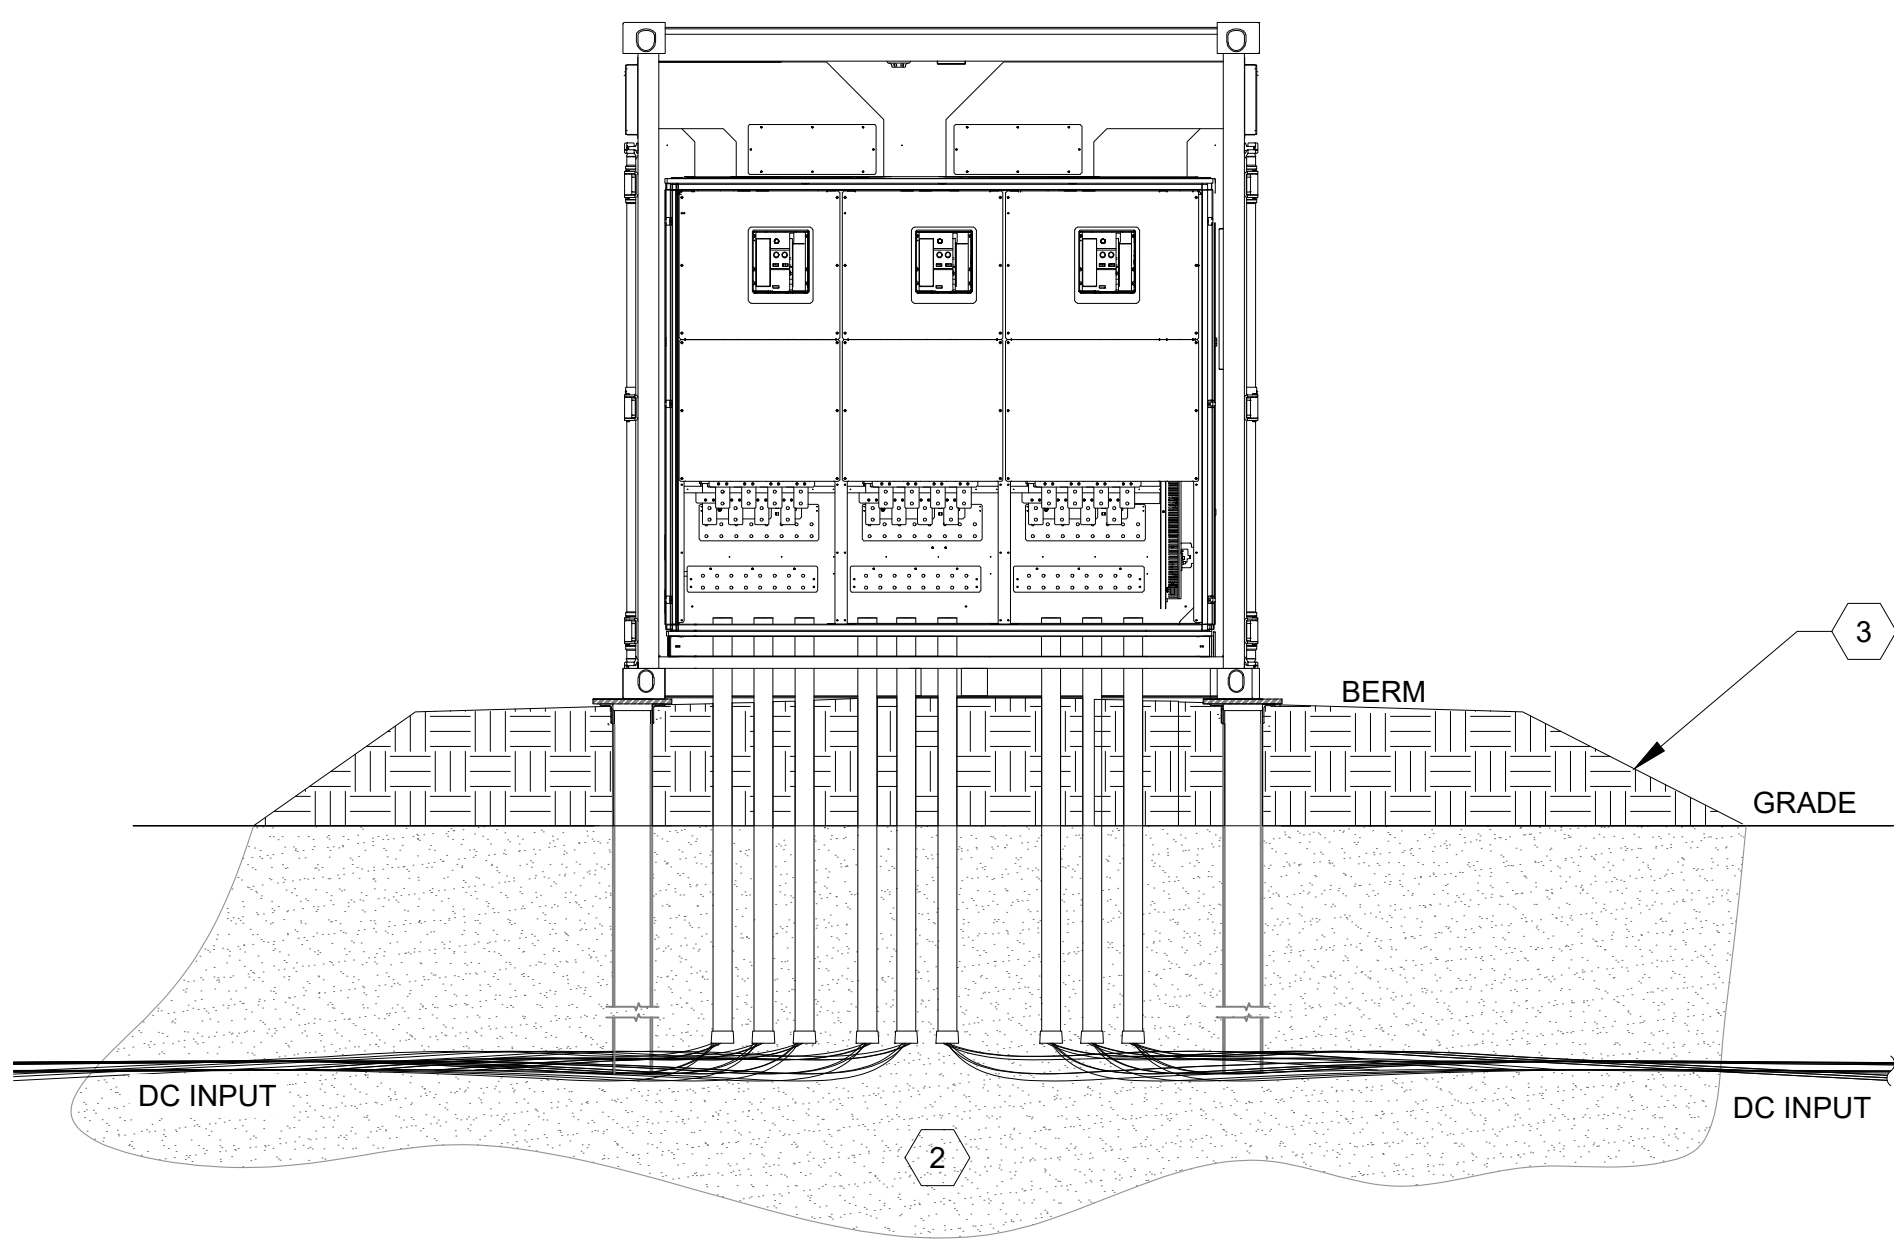

3 TYPICAL INVERTER SKID ELEVATION (SOUTH VIEW)
SCALE: NTS

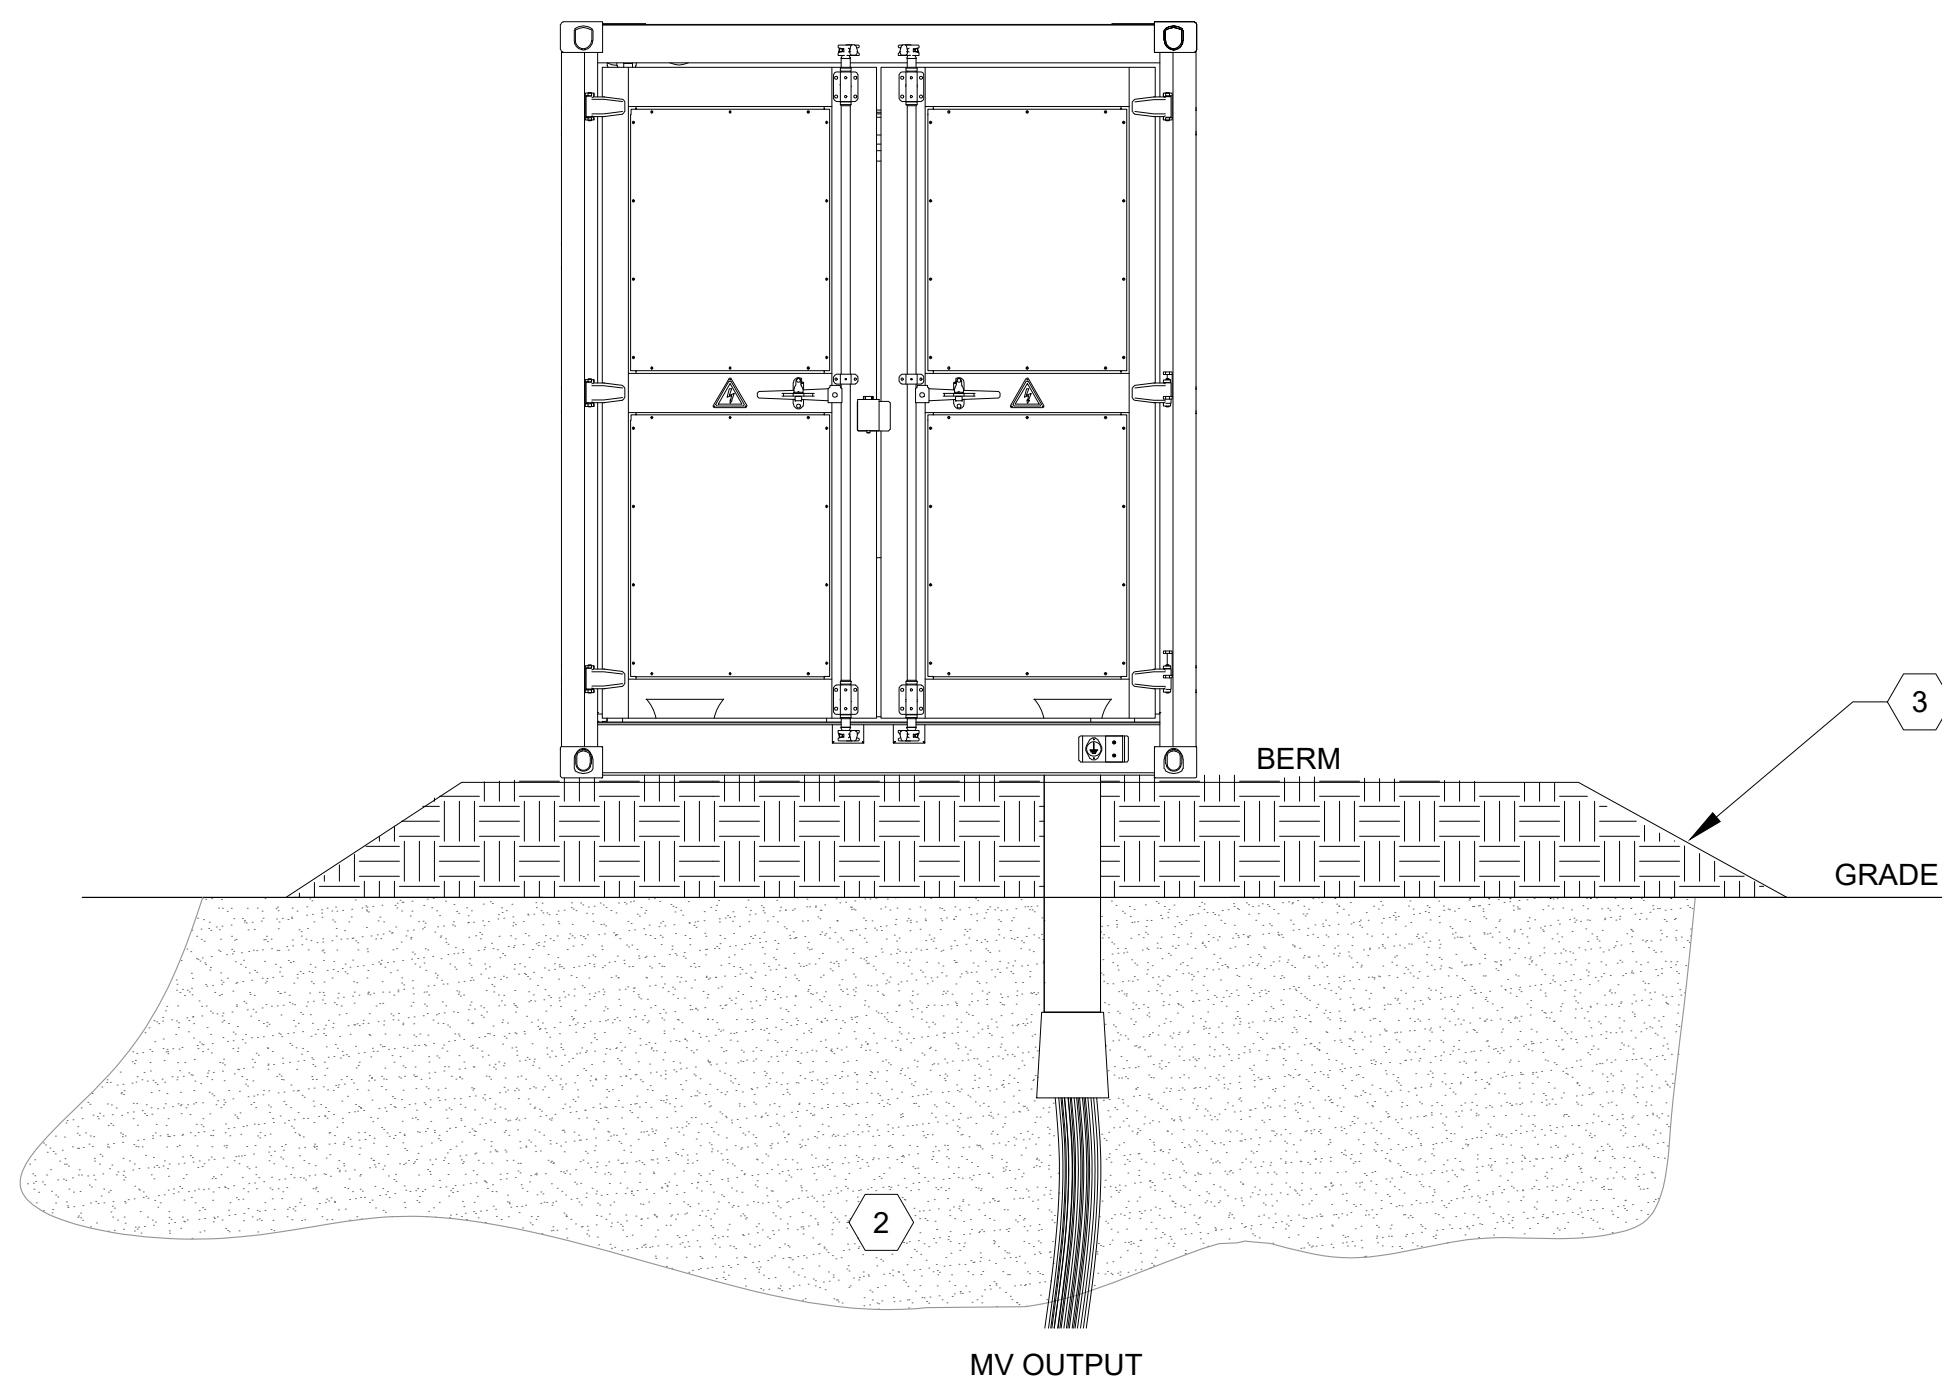


4 TYPICAL INVERTER SKID ELEVATION (NORTH VIEW)
SCALE: NTS

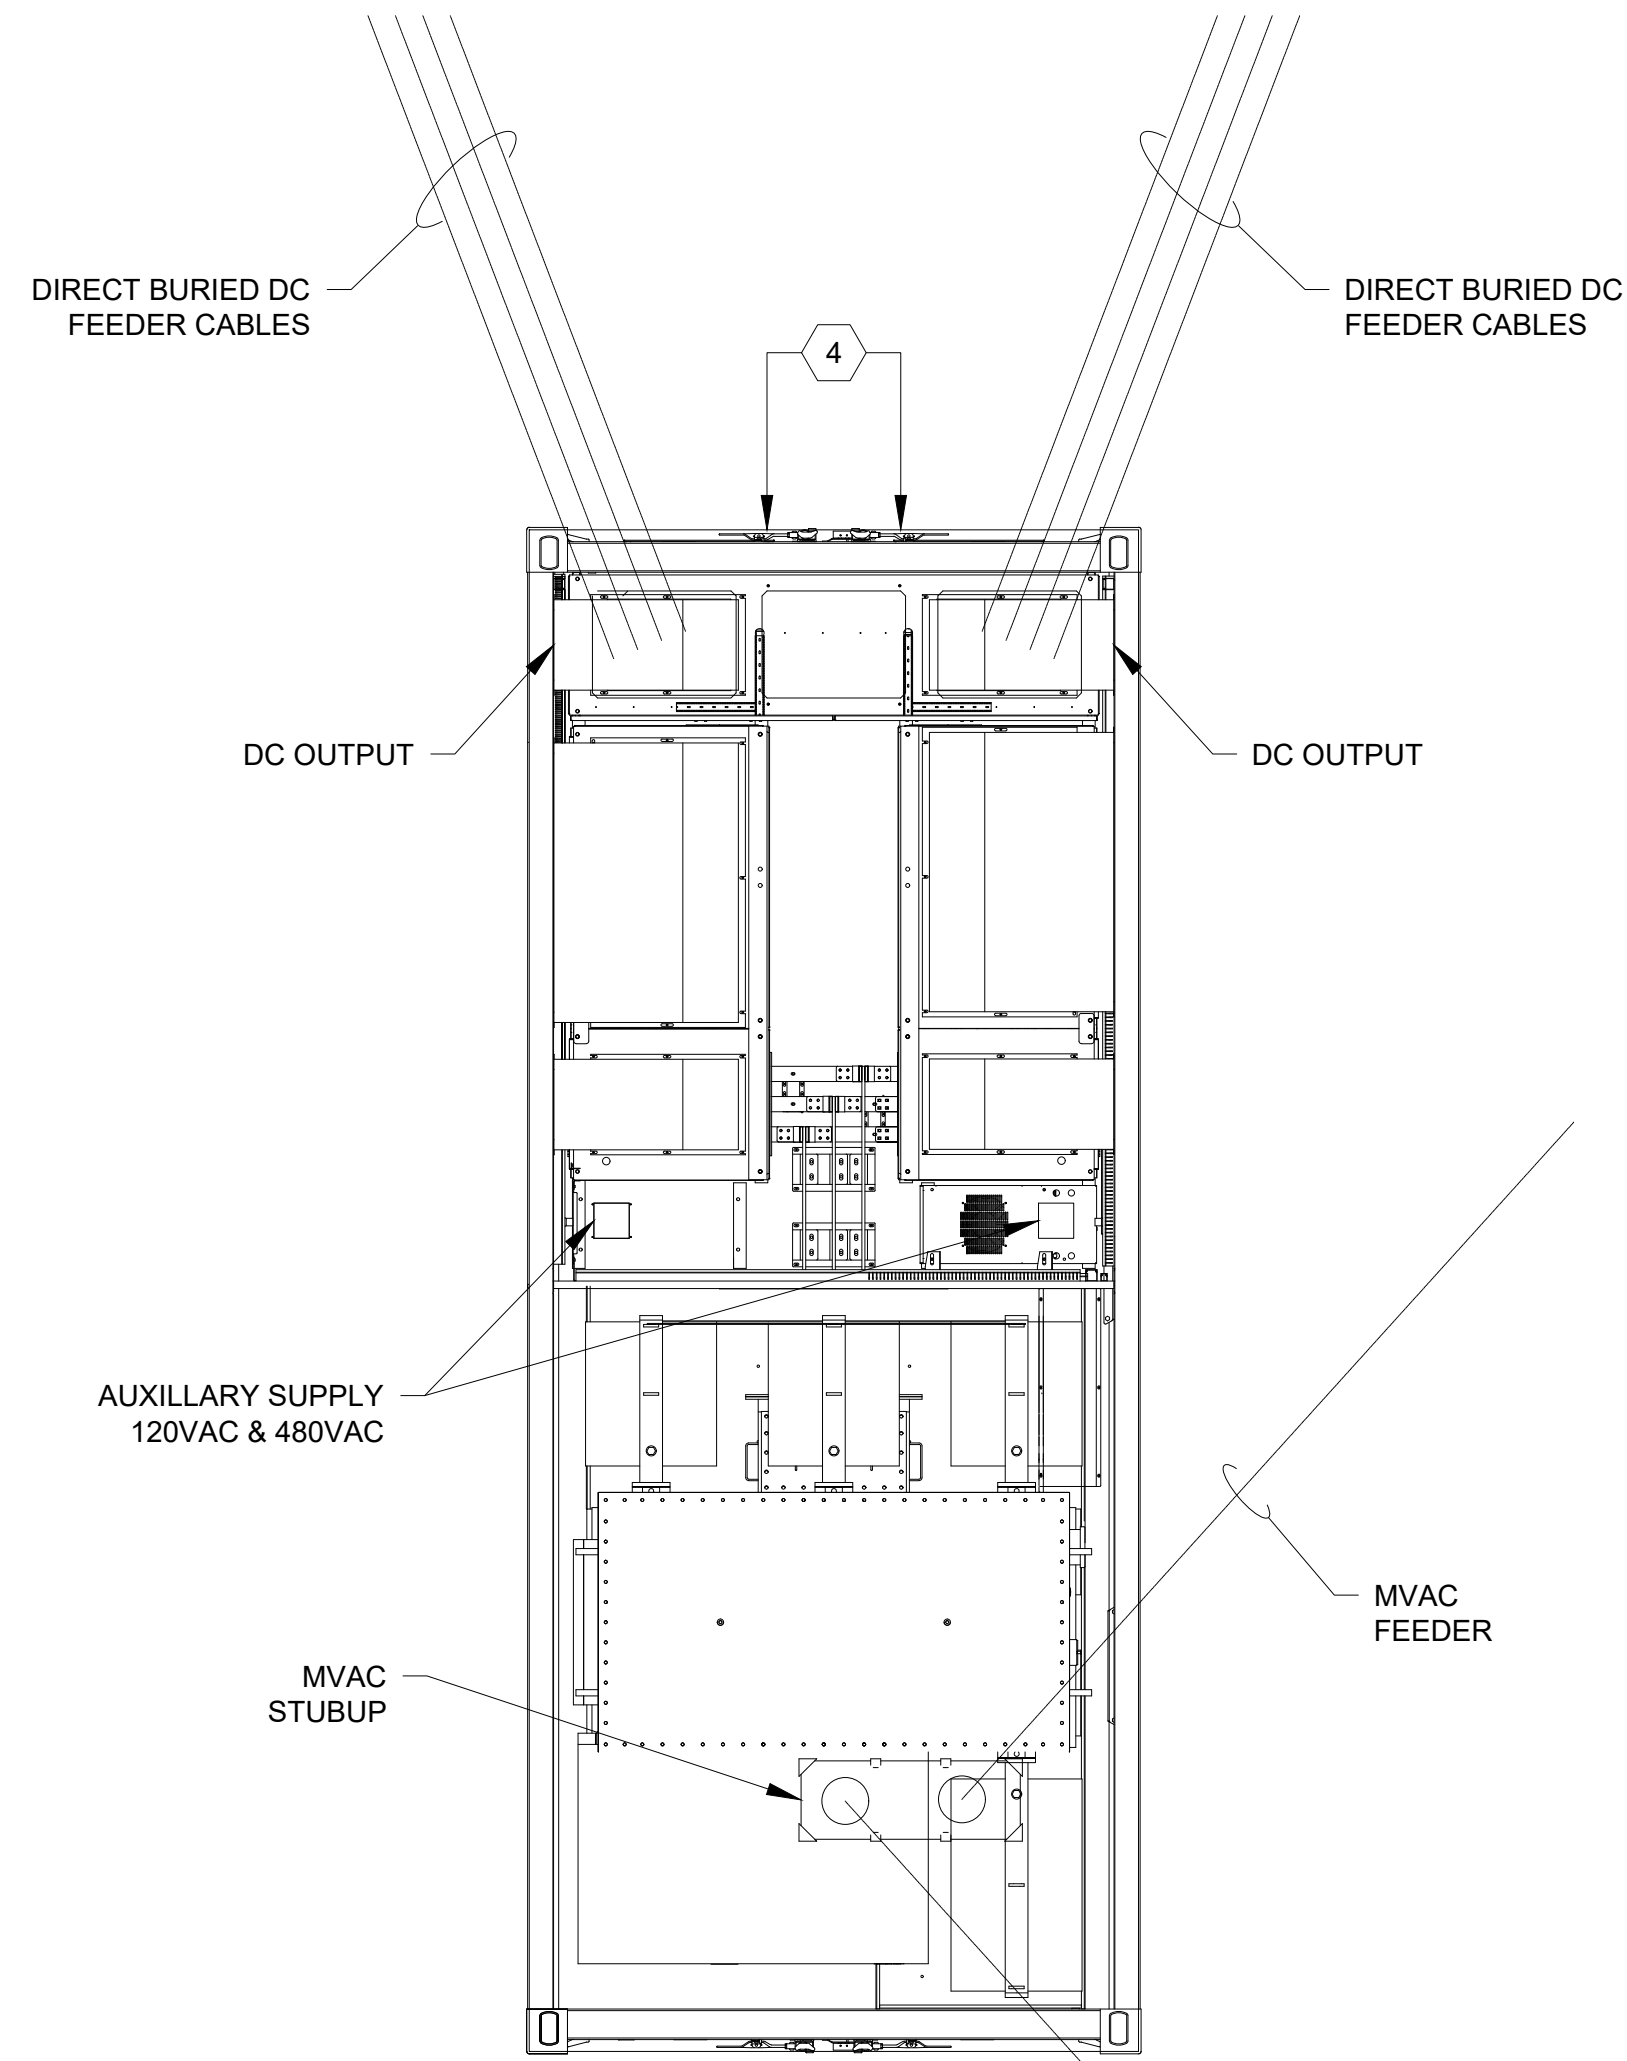


5 TYPICAL INVERTER SKID ELEVATION (BOTTOM VIEW)
SCALE: NTS

FastGrid FastGrid, LLC 225 E Germann Road Suite 301 Gilbert, AZ 85297		
REV	DESCRIPTION	DATE
4	RECORD DRAWINGS	06/08/2023
PROJECT NAME: EAGLE SHADOW MOUNTAIN PV SOLAR POWER GENERATION FACILITY		
PROJECT ADDRESS: I-15 CRYSTAL, NV CLARK COUNTY		
SEAL:	DATE: 10/16/2020	
	PROJECT #: 190067.03	
	DRAWN BY: NK	
	CHECKED BY: EL	
SHEET NAME: TYPICAL PCS & EQUIPMENT ELEVATIONS		
SHEET #:	REV #:	
E-652	4	

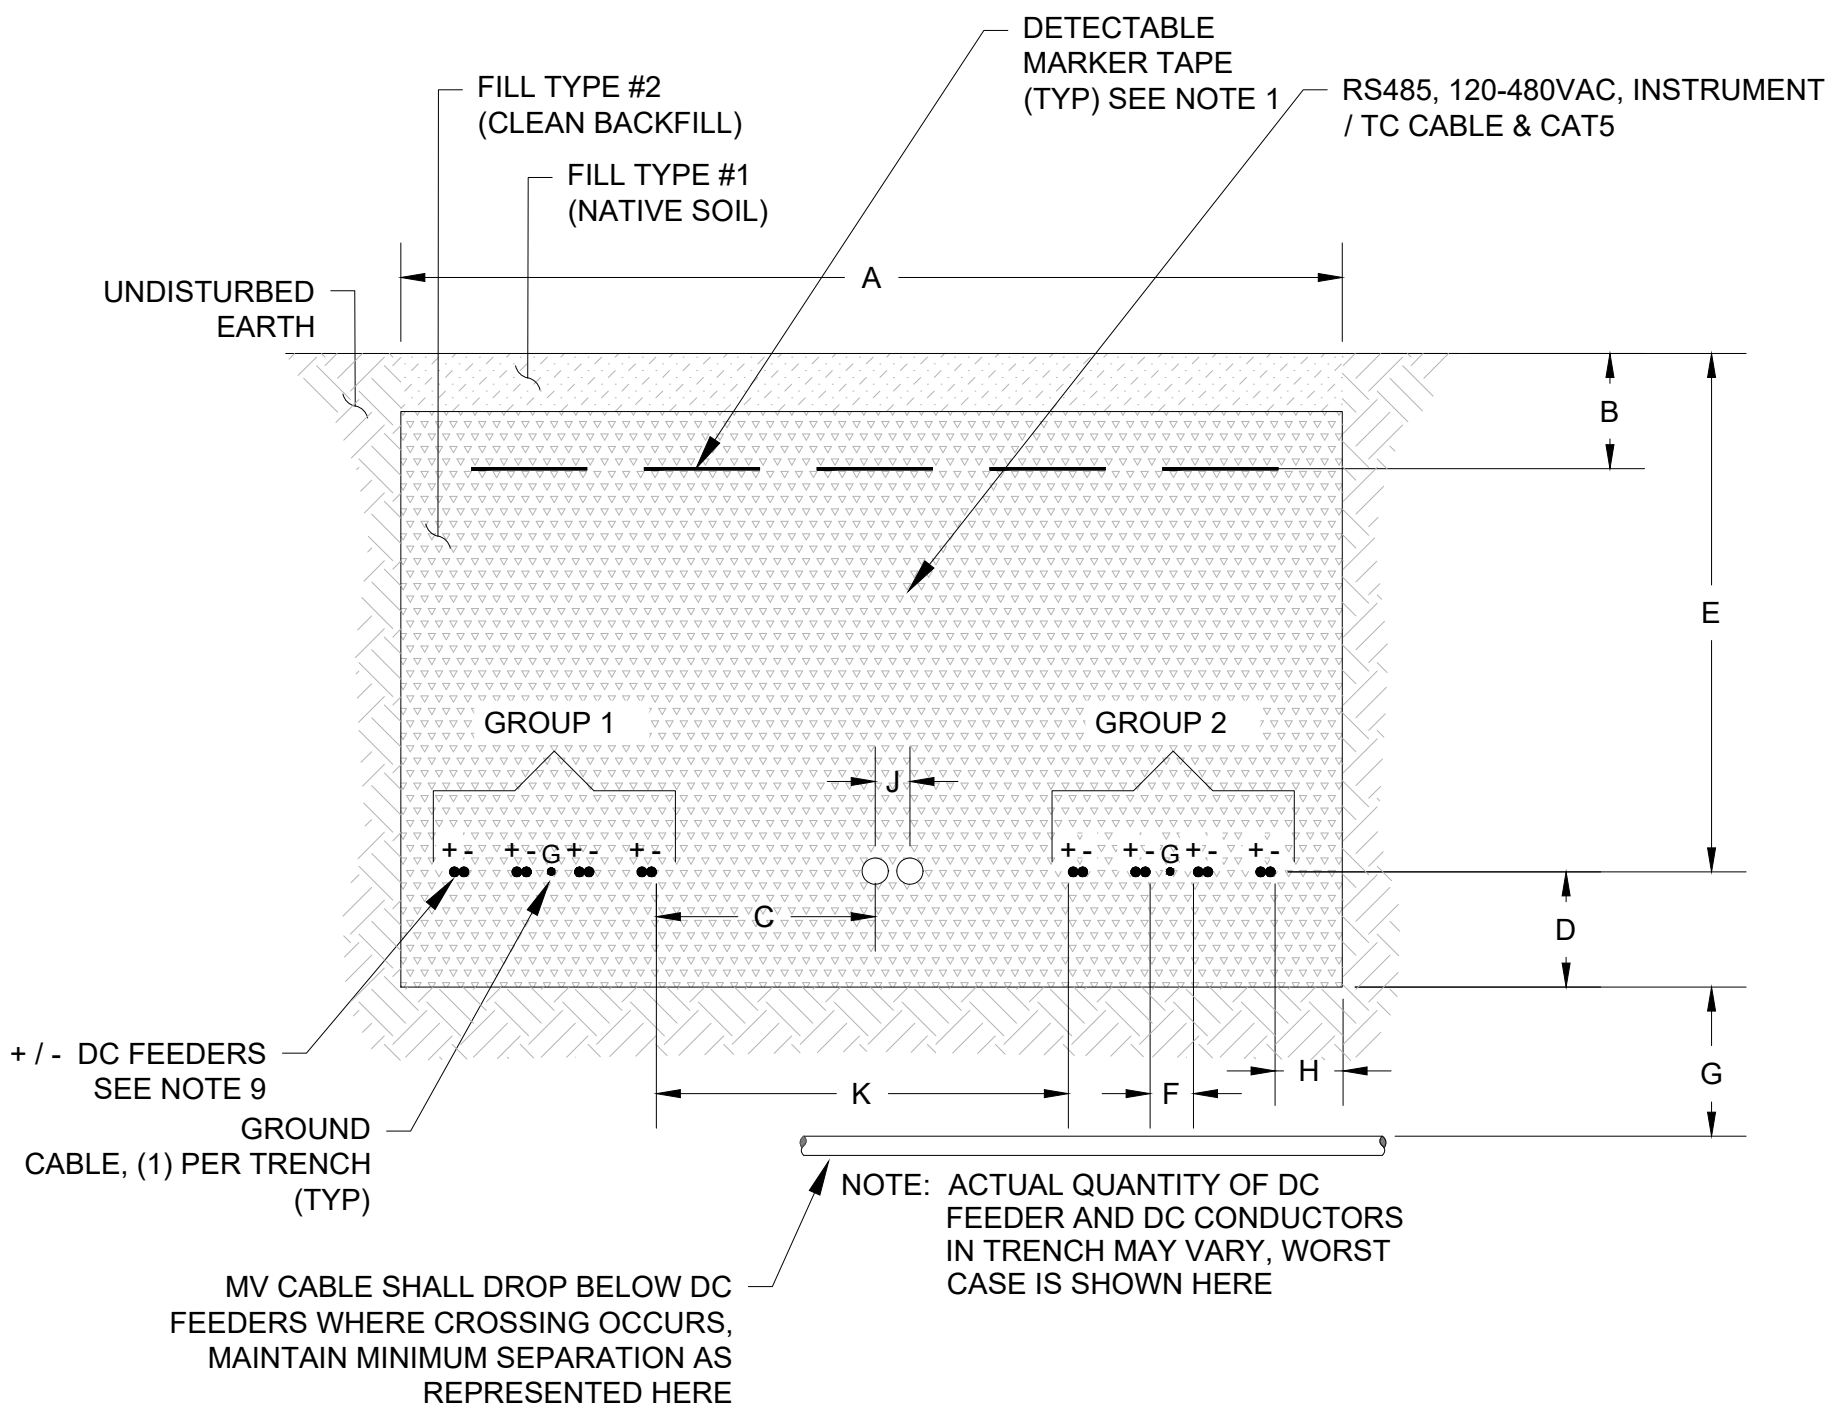

ITEM	DIMENSION
A	AS REQUIRED
B	12"
C	6"
D	6"
E	30"
F	4"
G	12"
H	4"
J	8"
K	24"

1 DC FEEDER TRENCH (TYPICAL)
SCALE: NTS

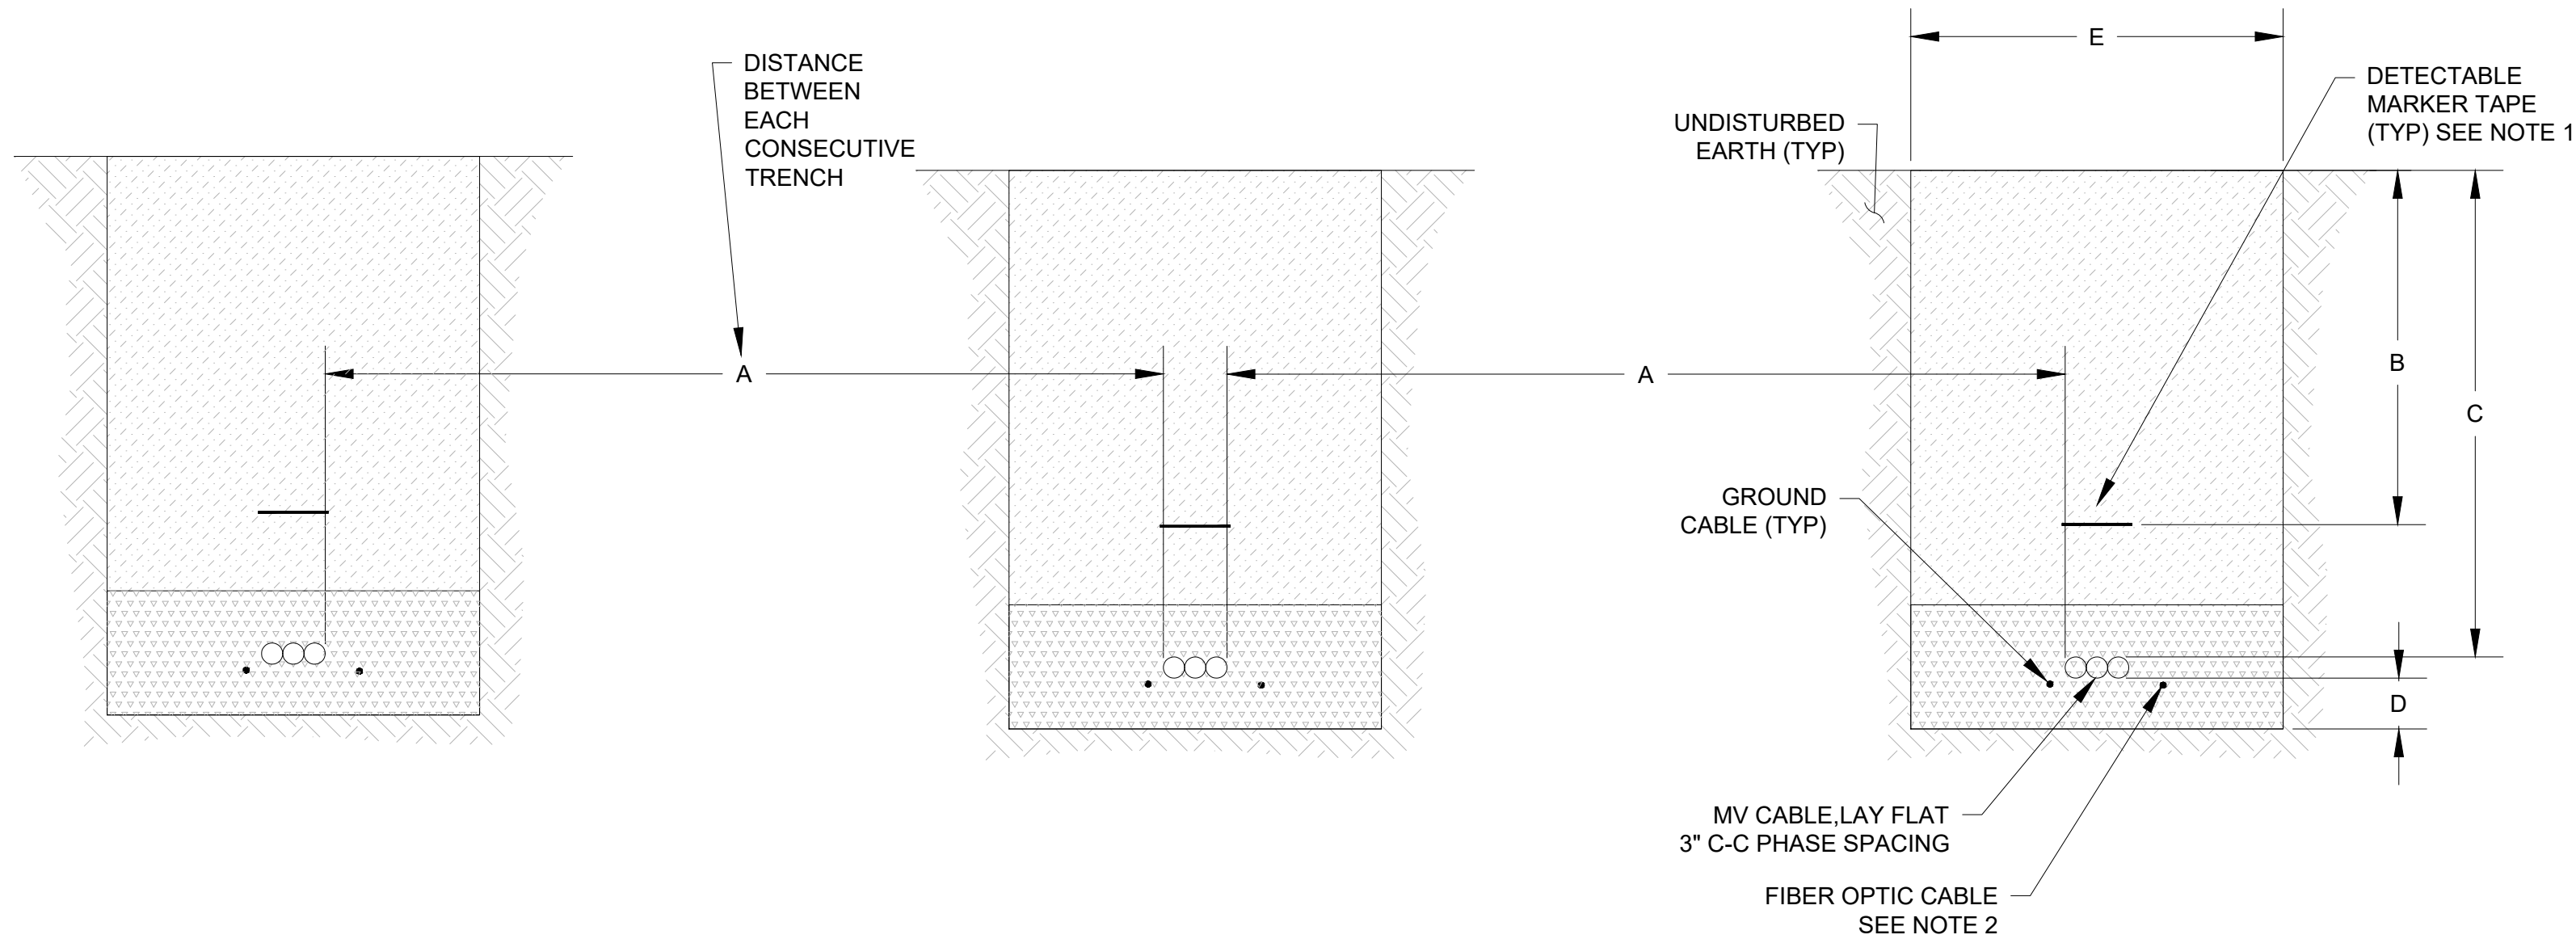

2 MV TRENCH SECTION (TYPICAL)
SCALE: NTS

ITEM	DIMENSION
A	42"
B	24"
C	36"
D	SEE NOTE BELOW
E	AS REQUIRED

NOTE: THE BED DEPTH MAY BE OMITTED IF THE TRENCH IS VISUALLY INSPECTED IN FULL AND ALL ROCKS OR OTHER COMPONENTS THAT COULD DAMAGE THE CABLES ARE REMOVED; OTHERWISE PROVIDE 3" BED.

LEGEND:

- UNDISTURBED EARTH
- CLEAN BACKFILL (FILL TYPE #1) SEE NOTE #7.1.
- CLEAN BACKFILL (FILL TYPE #2) SEE NOTE #7.2.

NOTES:

- INSTALL RED DETECTABLE MARKER TAPE IN ALL TRENCHES. PROVIDE SINGLE TAPE FOR EVERY 18" OF TRENCH WIDTH.
- MISCELLANEOUS CABLES INCLUDING FIBER OPTIC FEEDER MAY UTILIZE THE UNDERGROUND TRENCH SYSTEM WHERE APPLICABLE. SEE GENERAL NOTES SHEET E-001 FOR SPACING REQUIREMENTS WITH OTHER CABLING. FO CABLE MAY BE AT ANY DEPTH WITH OTHER CABLING.
- FOR AC FEEDER INFORMATION, REFERENCE SHEETS E-200 THROUGH E-206.
- ALL GROUND WIRE SHALL BE INSTALLED AT A MINIMUM DEPTH EQUAL TO FEEDER TYPE.
- TRENCHING AND CABLE INSTALLATION MUST BE COORDINATED TO AVOID ALL OBSTRUCTIONS. REFERENCE STRUCTURAL AND CIVIL DRAWINGS FOR EQUIPMENT LOCATION COORDINATES, GRADING, AND UNDERGROUND OBSTRUCTIONS.
- DIMENSIONS TO CABLE LAYERS ARE FROM FINISHED GRADE TO THE CENTER OF CABLES, EXCEPT WHERE NOTED.
- CLEAN FILL REQUIREMENTS:
TRENCHING:
7.1. TYPE 1: NATIVE SOIL, SHALL BE USED FOR BACKFILL WITH INTERLOCKED ARMOR CABLES.
7.2. TYPE 2: FILL SHALL BE CLEAN AND FREE OF ORGANIC MATERIAL CONTAINING PARTICLES NO LARGER THAN 3/4" IN DIAMETER IN THE AREA 6" ABOVE AND BELOW CABLES. COMPACTION SHALL BE GREATER THAN OR EQUAL TO 90% WITH 8" LOOSE LIFTS AND HAVE WITH-IN 2% OF OPTIMUM, SEE GEOTECHNICAL AND CIVIL PLANS.
- WHERE INSTRUMENTATION CABLES ARE TO BE INSTALLED USE FILL TYPE 2 IN THE AREA 6" ABOVE AND BELOW.
- DC FEEDERS AND CONDUCTORS SHOWN DEPICT THE LAYERS UTILIZED WITHIN THE UNDERGROUND TRENCH AND THE MINIMUM SPACING BETWEEN CABLES ONLY. CABLE QUANTITIES CAN INCREASE OR DECREASE WITHIN THE TRENCH AS CIRCUITS ARE ADDED OR BRANCH OFF. FOR ACTUAL DC FEEDER AND CONDUCTOR COUNT AND ADDITIONAL DC REFERENCE INFORMATION, REFERENCE ENLARGED PLANS AND SCHEDULES.



REV	DESCRIPTION	DATE
4	RECORD DRAWINGS	06/08/2023

PROJECT NAME:
**EAGLE SHADOW MOUNTAIN
PV SOLAR POWER
GENERATION FACILITY**


PROJECT ADDRESS:
**I-15
CRYSTAL, NV
CLARK COUNTY**

SEAL:	DATE: 10/16/2020
	PROJECT #: 190067.03
	DRAWN BY: NK
	CHECKED BY: EL

SHEET NAME:
TRENCH DETAILS


SHEET #: E-660	REV #: 4
--------------------------	--------------------


RECORD DRAWING

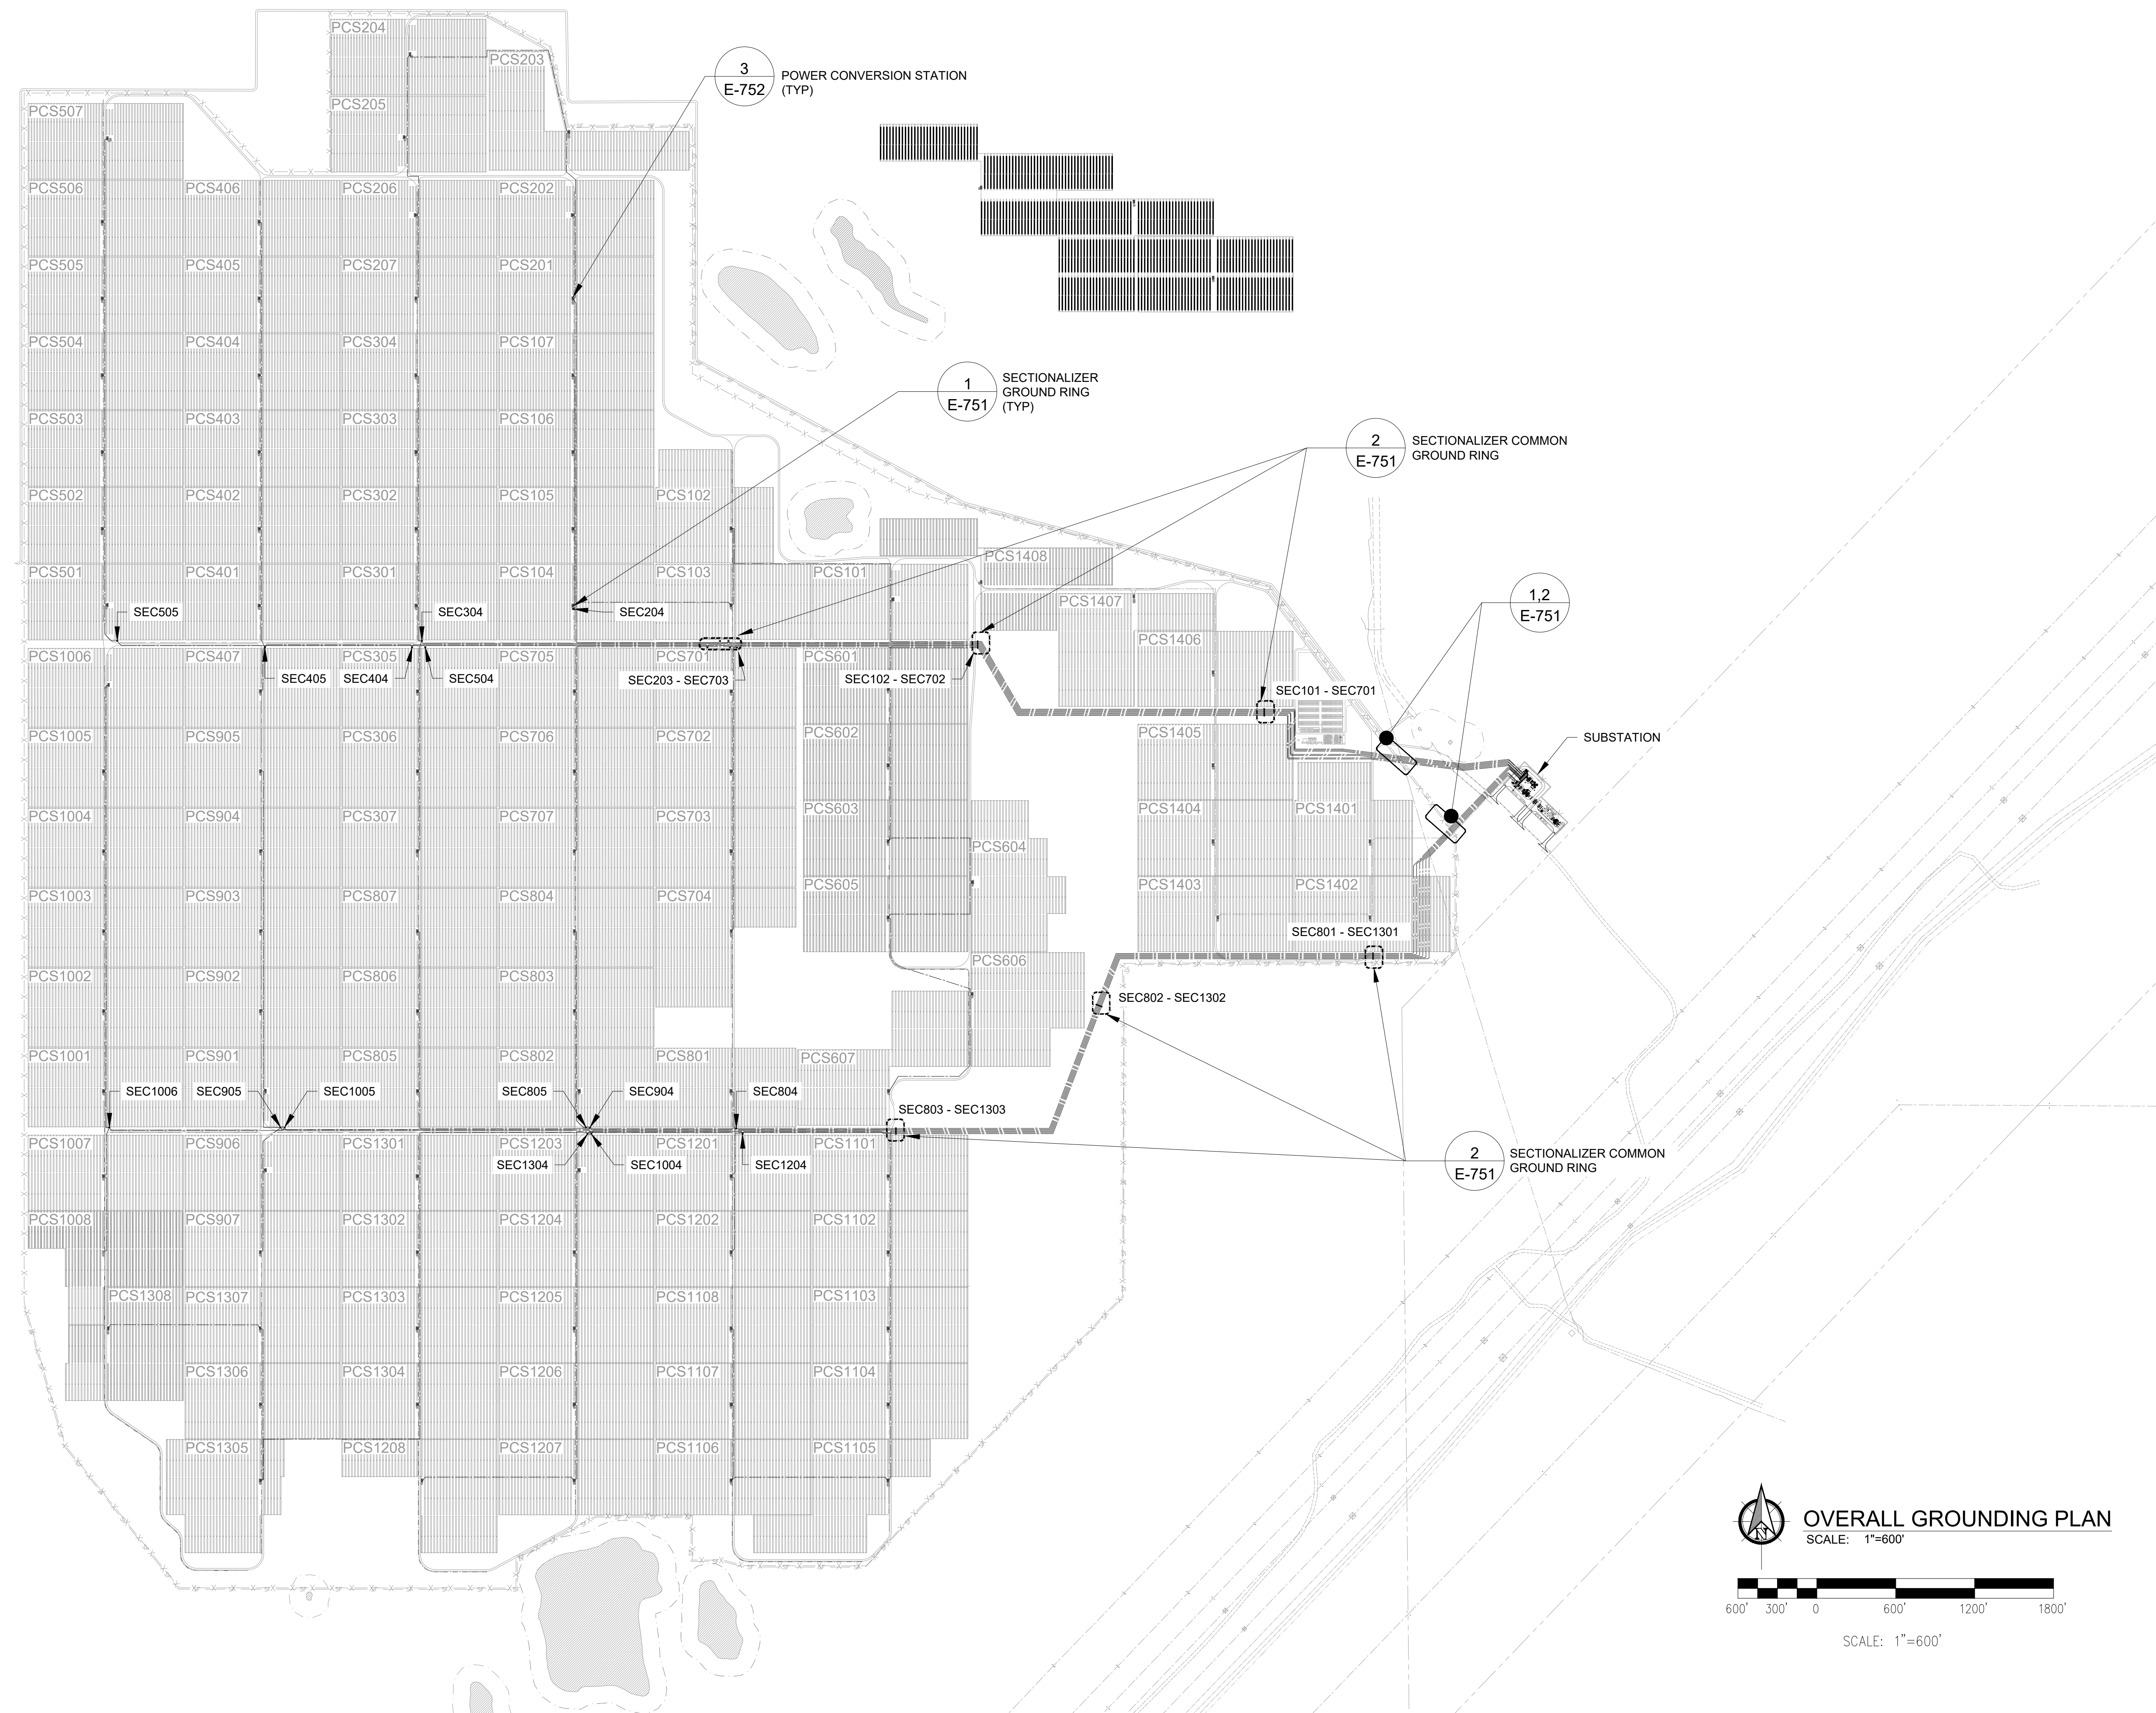


- NOTES:

1. WORK WITH-IN SUBSTATION IN ITS ENTIRETY IS BY OTHERS. LOCATION, SIZE, ETC. DEPICTED ON THESE PLANS IS FOR REFERENCE ONLY AND MAY NOT DEPICT ACTUAL FIELD CONDITIONS.
2. THIS DRAWING REPRESENTS THE OVERALL GROUNDING PLAN. IT DOES NOT INCLUDE ALL THE GROUNDING CONDUCTORS AND COMPONENTS REQUIRED FOR THE COMPLETE GROUNDING SYSTEM. FOR ADDITIONAL DETAILS AND GROUNDING INFORMATION REFERENCE SHEET E-751.
3. SECURITY FENCE GATES SHALL BE GROUNDED IN ACCORDANCE WITH THIS PLAN DRAWING AND RELATED DETAILS. REFERENCE SHEET E-751.
4. ANY FENCE SECTION OR GATE WITHIN 50' OF AN UNDERGROUND MV CABLE SHALL BE GROUNDED.

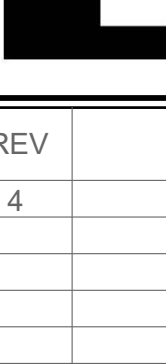 <div style="display: inline-block; vertical-align: middle;"> FastGrid <small>FastGrid, LLC 225 E Germann Road Suite 301 Gilbert, AZ 85297</small> </div>		
REV	DESCRIPTION	DATE
4	RECORD DRAWINGS	06/08/2020
G	MV REEL CORD	09/18/2020
PROJECT NAME:		
EAGLE SHADOW MOUNTAIN PV SOLAR POWER GENERATION FACILITY		
PROJECT ADDRESS:		
I-15 CRYSTAL, NV CLARK COUNTY		
SEAL:	DATE:	
	10/16/2020	
	PROJECT #:	
	190067.03	
	DRAWN BY:	
	TLR	
	CHECKED BY:	
	EL	
SHEET NAME:		
OVERALL GROUNDING PLAN		
SHEET #:	REV	#:
E-700		4

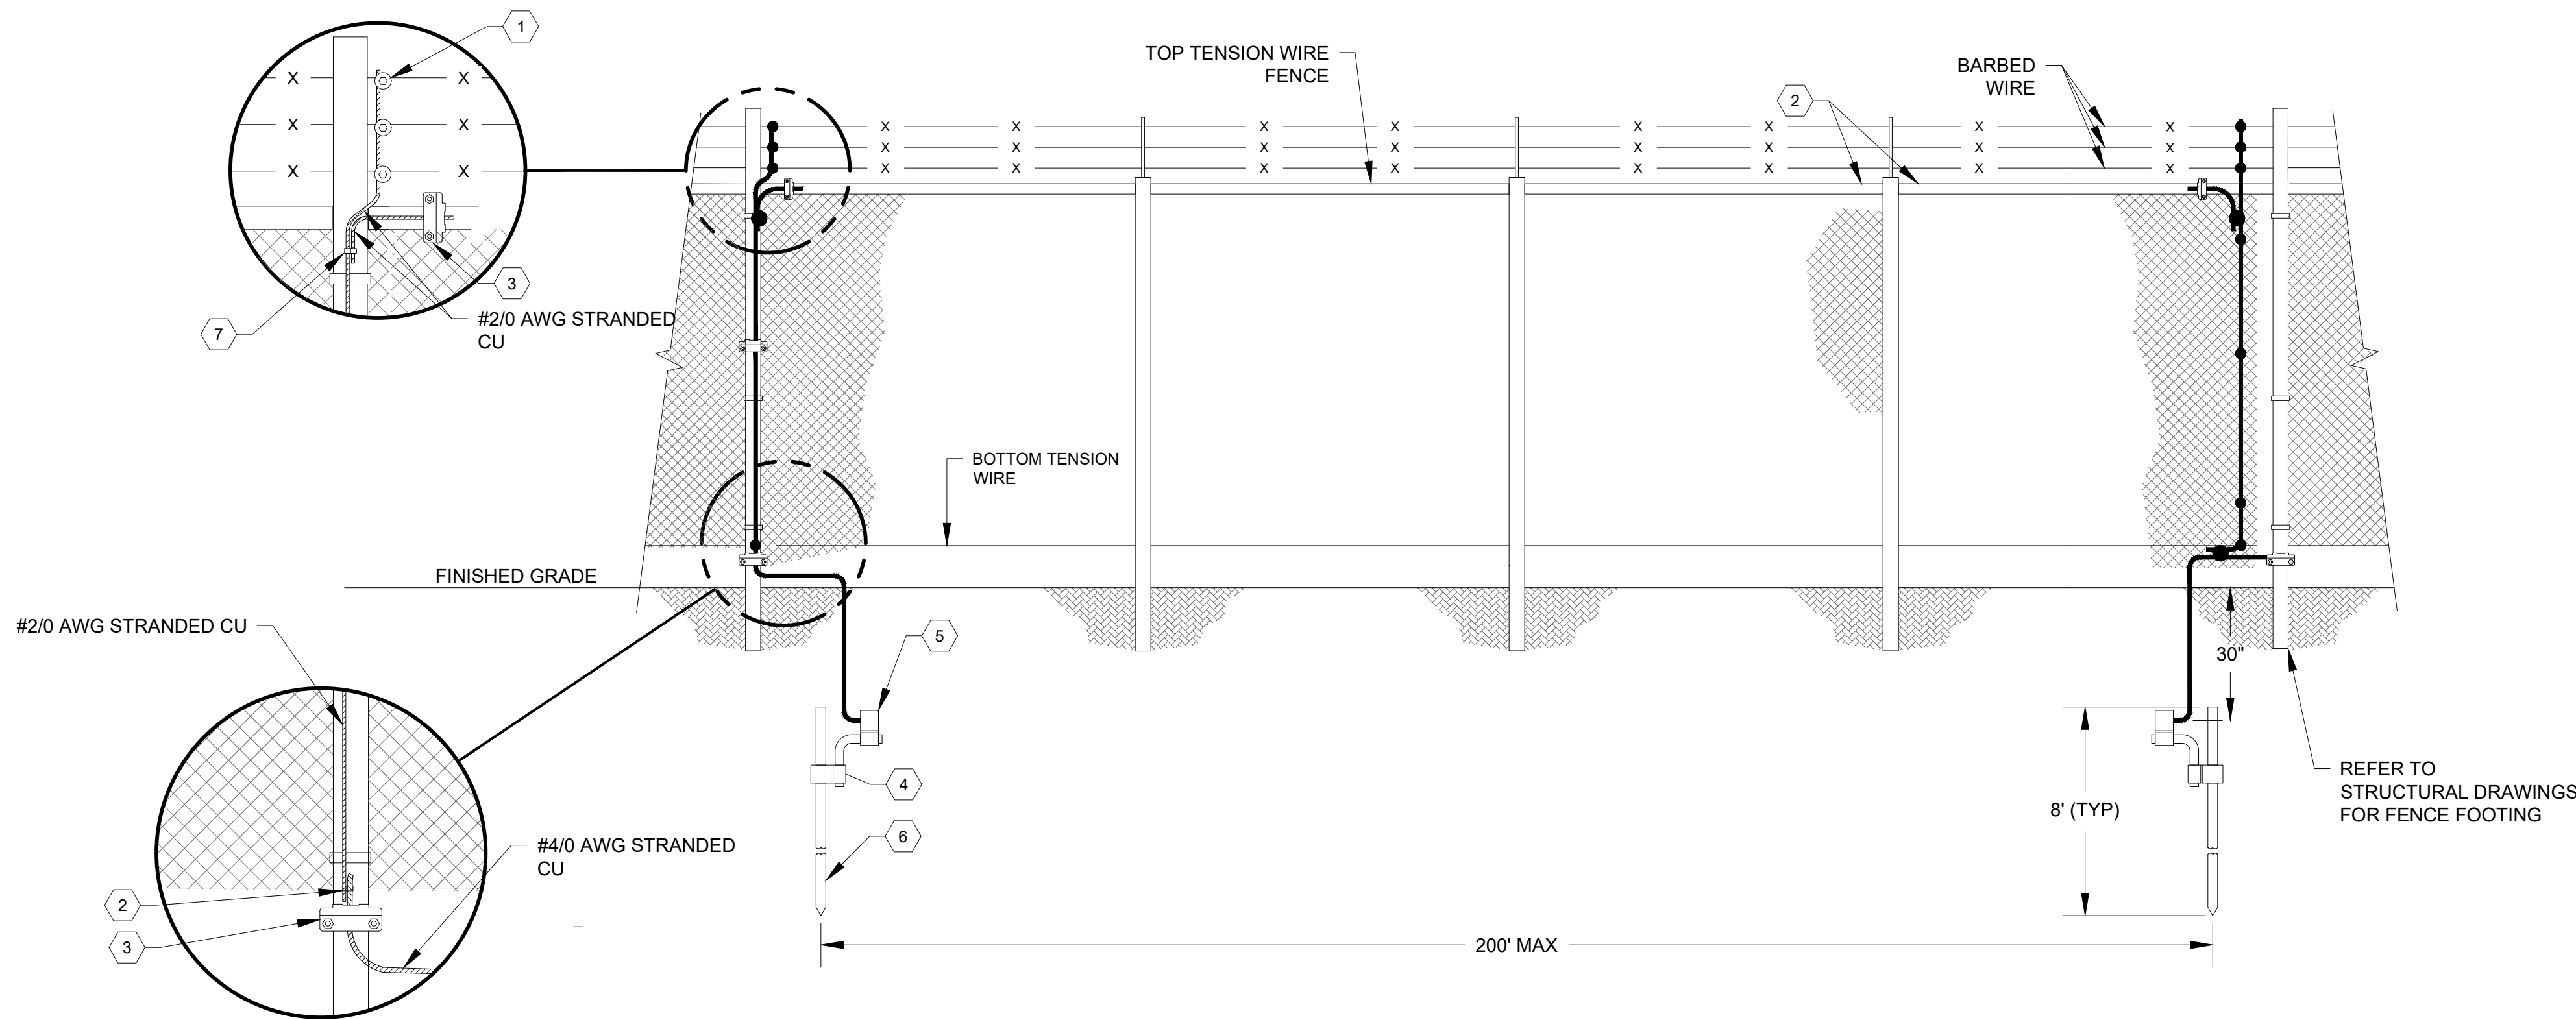

1 TYPICAL FENCE GROUNDING AT MV FEEDER CROSSING
SCALE: N.T.S.

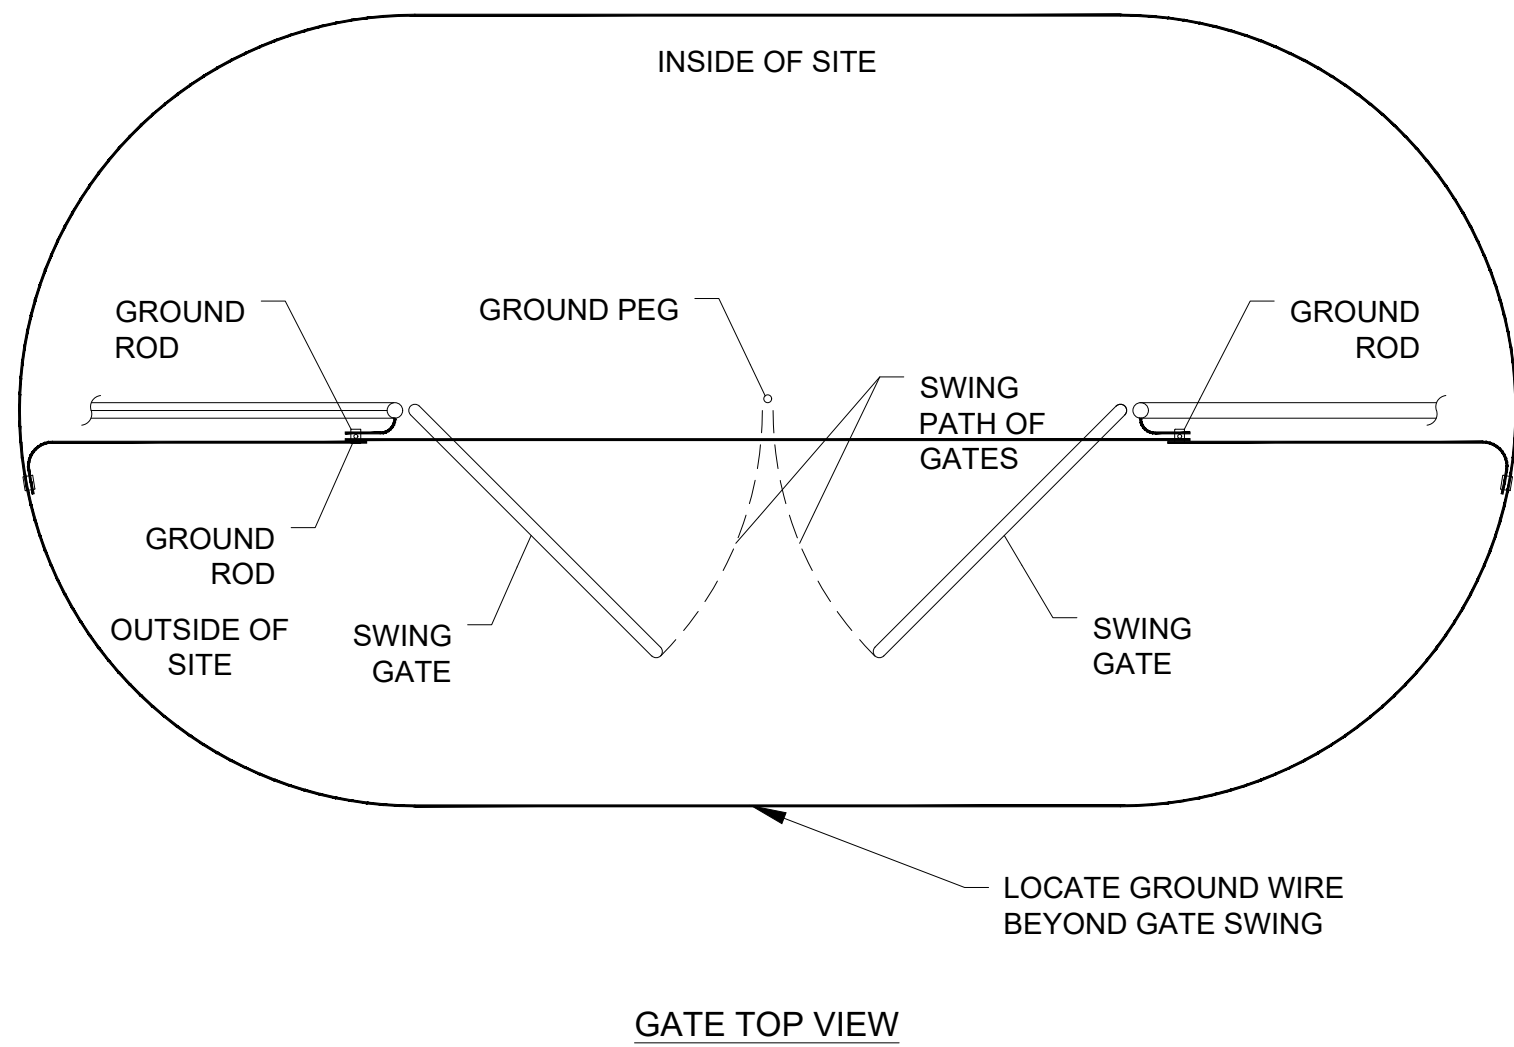

2 TYPICAL GATE GROUNDING
SCALE: N.T.S.

NOTES:

1. ALL UNDERGROUND CABLES SHALL BE SUITABLE FOR DIRECT BURIAL INSTALLATION.
2. FIBER OPTIC CABLE INSTALLATION MUST BE COORDINATED TO AVOID ALL OBSTRUCTIONS. REFERENCE STRUCTURAL AND CIVIL DRAWINGS FOR EQUIPMENT LOCATION COORDINATES, GRADING, AND UNDERGROUND OBSTRUCTIONS.
3. GROUND PERIMETER FENCE WITHIN 50' OF THE POINT WHERE THE MEDIUM-VOLTAGE CONDUCTORS CROSS UNDER THE FENCE.

BILL OF MATERIALS

X	DESCRIPTION	APPROVED VENDORS		
		MFR. CAT. NO.	MFR. CAT. NO.	MFR. CAT. NO.
1	GROUND CLAMP	BURNDY 'KS26'	ILSCO 'IK-2/0'	BLACKBURN '20H'
2	IRREVERSIBLE COMPRESSION GROUND TAP CONNECTOR - CONNECTING #4/0 CABLE TO #4/0 CABLE	BURNDY 'YGH29C29'	ILSCO 'ELT-3'	BLACKBURN 'CTP250250'
3	POST GROUNDING CONNECTOR	BURNDY 'GAR' SERIES	ILSCO 'GUB' SERIES	O-Z GEDNEY 'CG' SERIES
4	IRREVERSIBLE COMPRESSION GROUND TAP CONNECTOR - CONNECTING #4/0 TO GROUND ROD	BURNDY 'YGLR29C34'	ILSCO 'GUB-5'	BLACKBURN '54895L'
5	IRREVERSIBLE COMPRESSION GROUND TAP CONNECTOR - CONNECTING #4/0 CABLE TO #4/0 CABLE	BURNDY 'YGH29C29'	ILSCO 'ELT-3'	BLACKBURN 'CTP250250'
6	COPPER CLAD GROUND ROD 3/4" DIA. X 10'-0" LONG	ERITECH '613400'	HARGER '3410'	BLACKBURN '7510'
7	IRREVERSIBLE COMPRESSION GROUND TAP CONNECTOR - CONNECTING #2/0 CABLE TO #2/0 CABLE	BURNDY 'YGH29C29'	ILSCO 'ELT-2'	BLACKBURN 'CTP2020'



REV	DESCRIPTION	DATE
4	RECORD DRAWINGS	06/08/2023

PROJECT NAME:
**EAGLE SHADOW MOUNTAIN
PV SOLAR POWER
GENERATION FACILITY**

PROJECT ADDRESS:
**I-15
CRYSTAL, NV
CLARK COUNTY**

SEAL:	DATE: 10/16/2020
	PROJECT #: 190067.03
	DRAWN BY: NK
	CHECKED BY: EL

SHEET NAME:
FENCE GROUNDING DETAILS


SHEET #: E-751	REV #: 4
--------------------------	--------------------

RECORD DRAWING


PLOT BY: Brady Burgesson

SAVED BY: gregg looney

LOCATION: K:_09_PROJECTS\190067.03 - PRIMORIS - EAGLE SHADOW MOUNTAIN PV SOLAR POWER GENERATION FACILITY - FENCE GROUNDING DETAILS


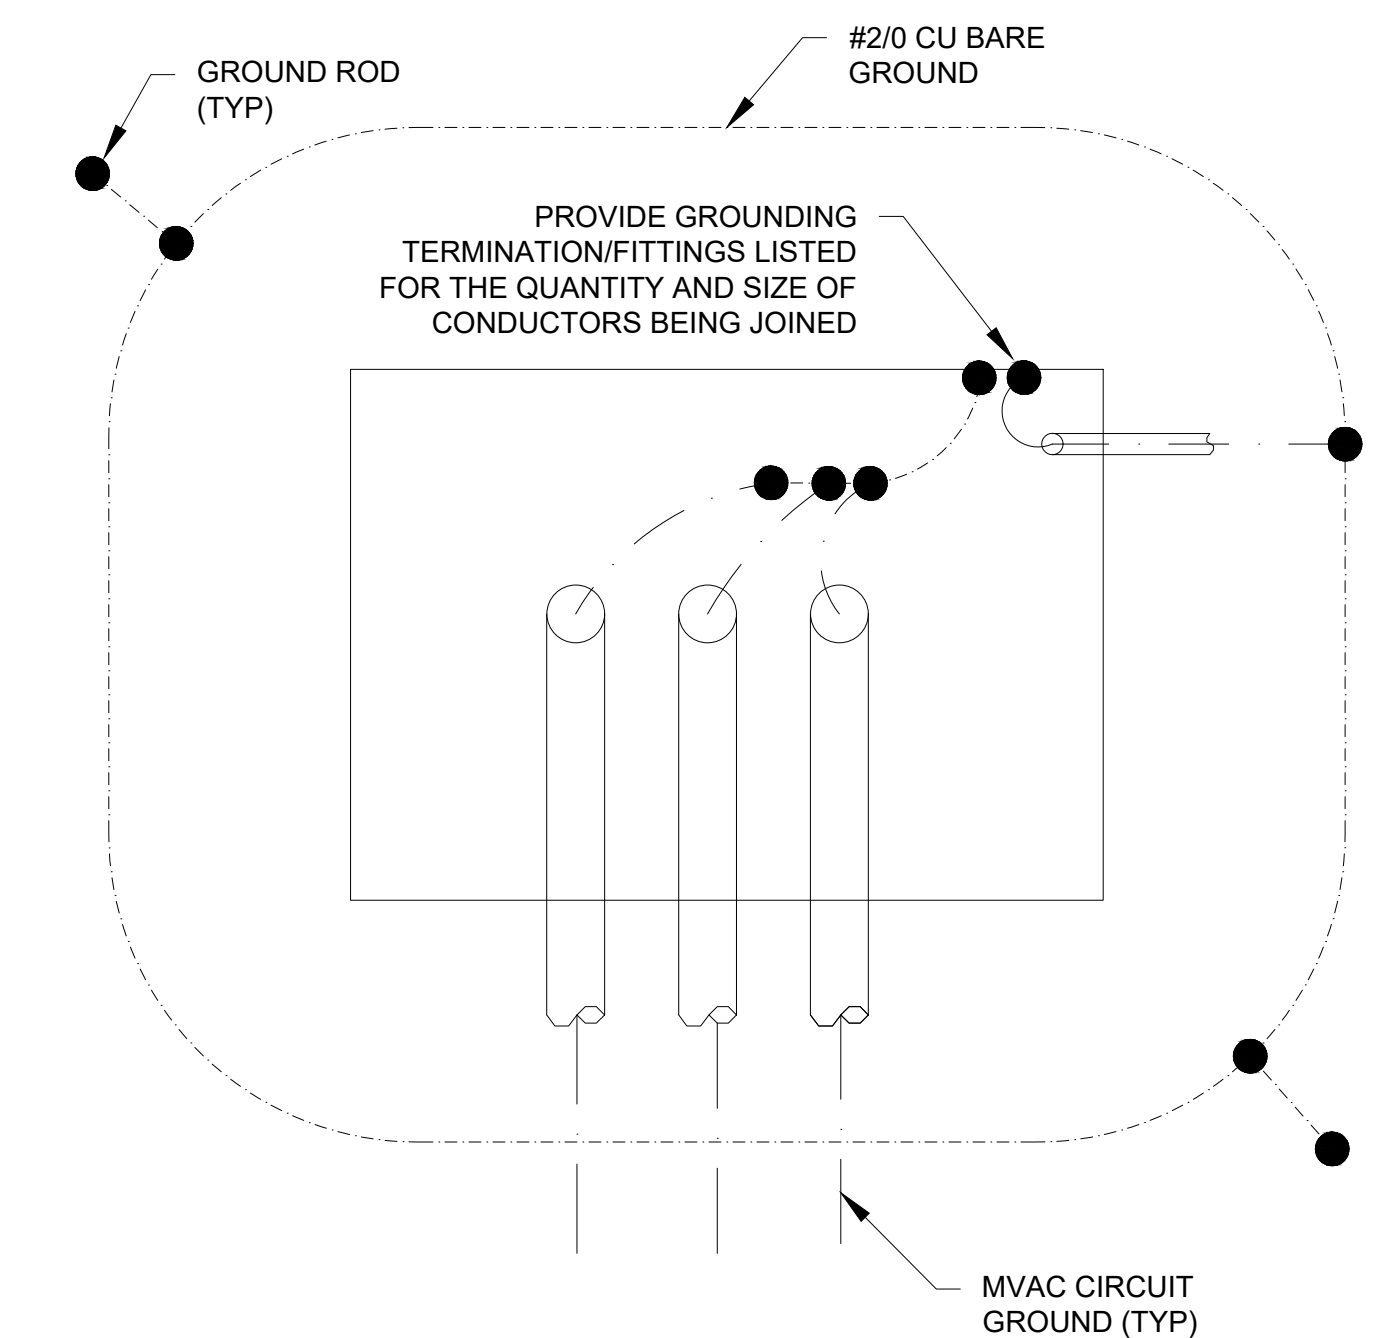


1 SINGLE MV SECTIONALIZER GROUNDING PLAN DETAIL
SCALE: N.T.S.

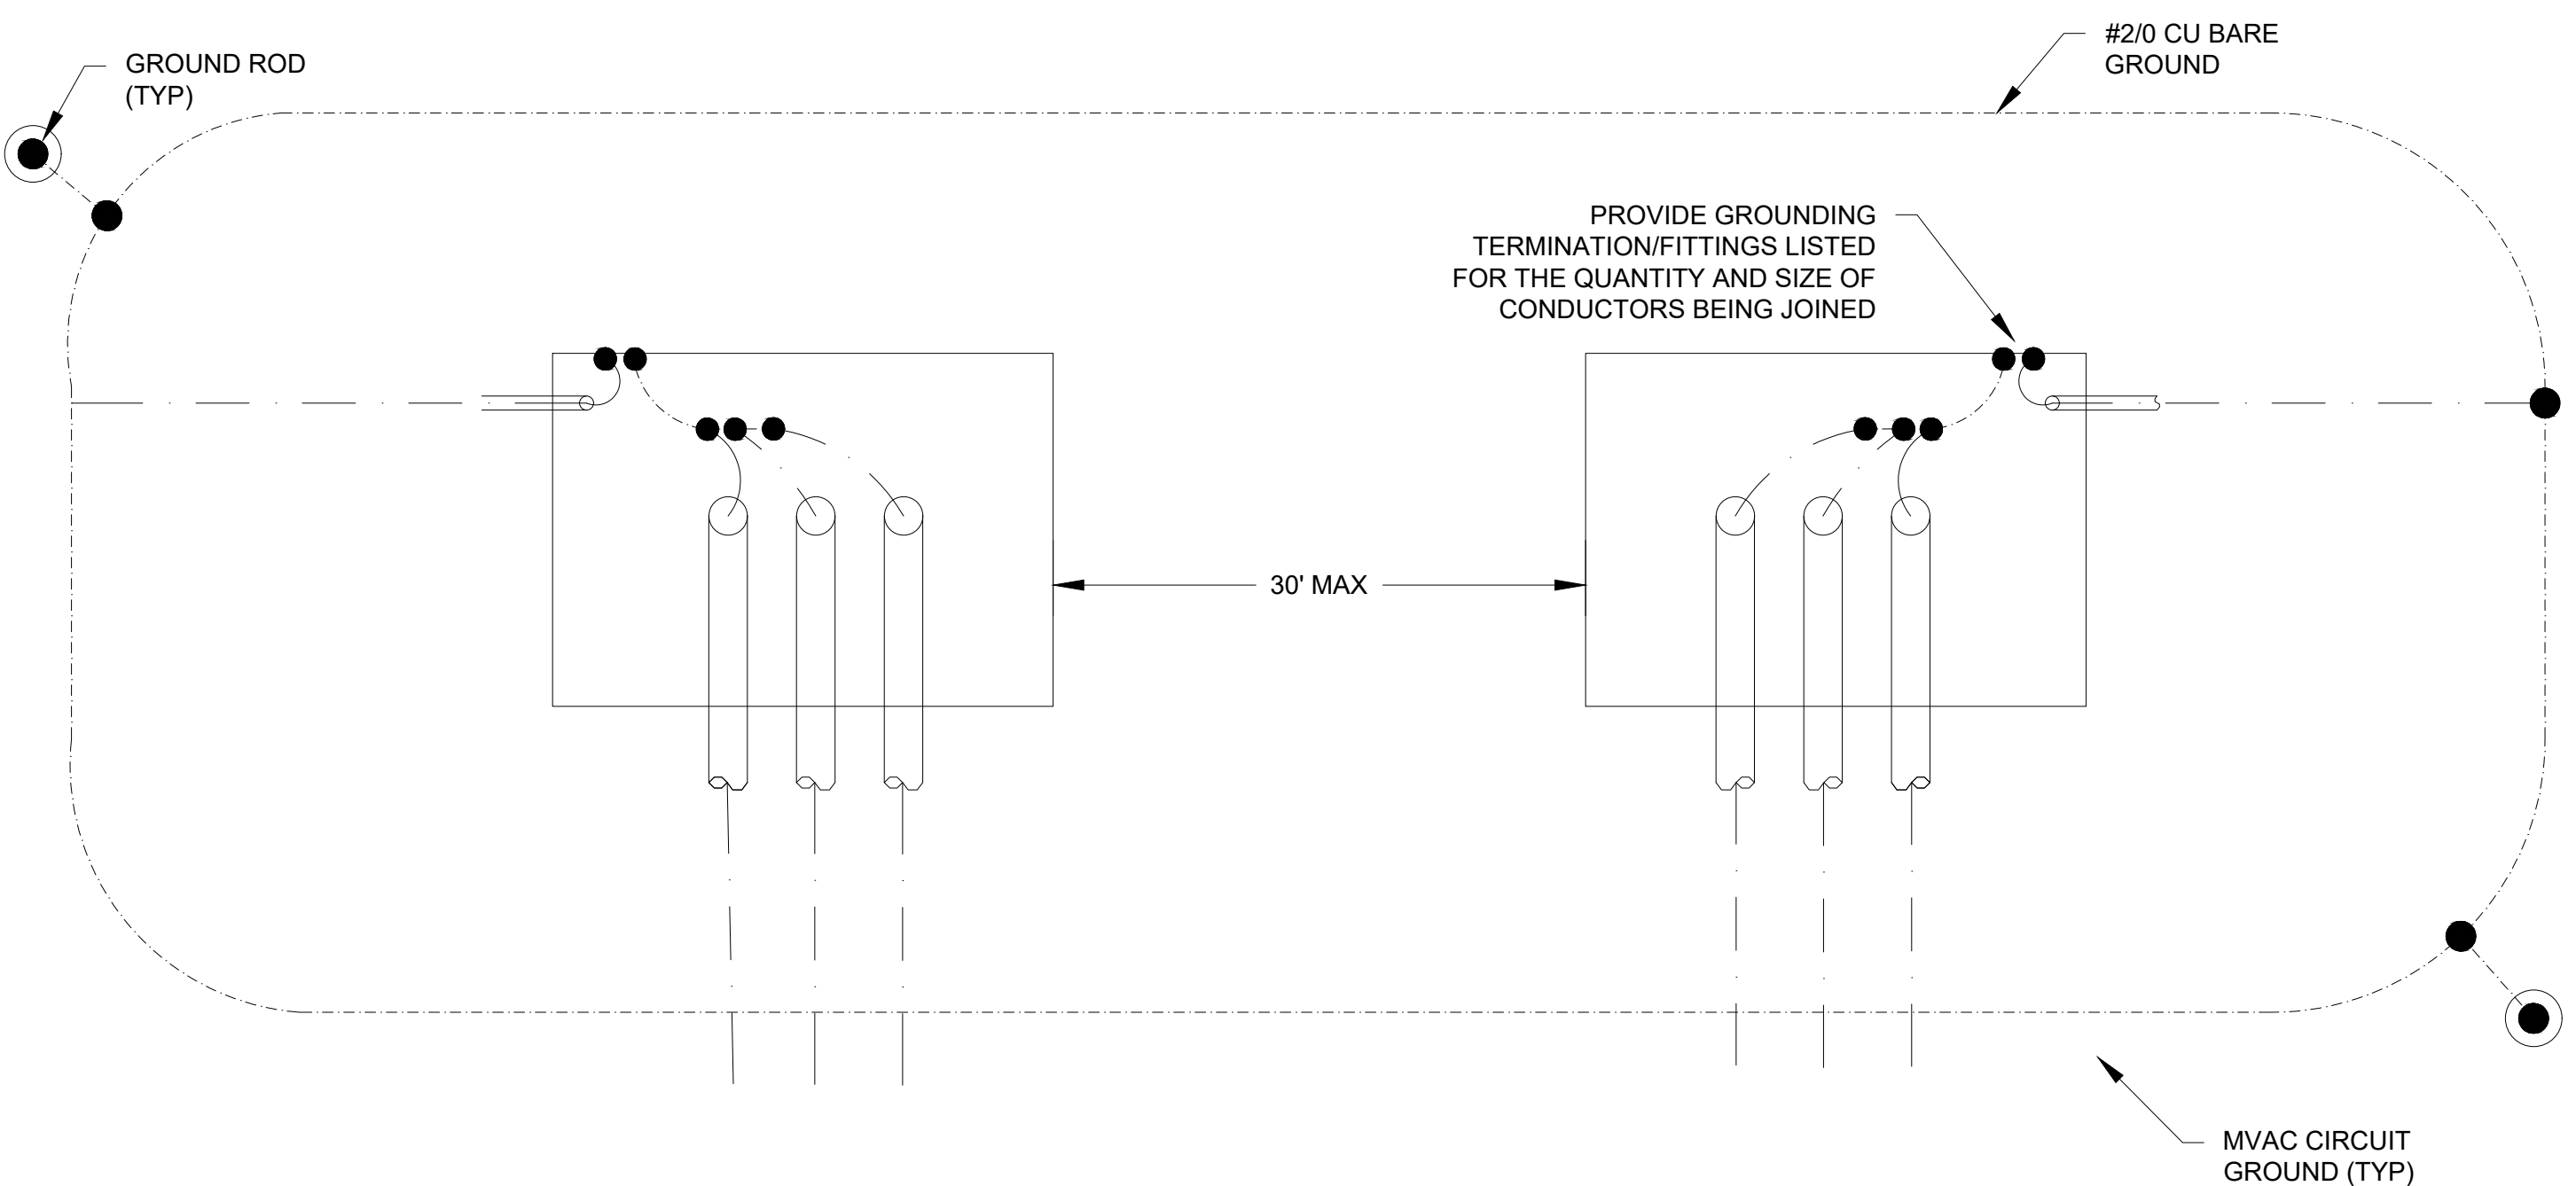


2 MV SECTIONALIZER COMMON GROUNDING PLAN DETAIL
SCALE: N.T.S.



- NOTES:
1. A COMMON GROUND RING AROUND ADJACENT SECTIONALIZERS IS ACCEPTABLE. EACH SECTIONALIZER WITHIN A COMMON GROUND RING SHALL BE BONDED PER THIS DETAIL.

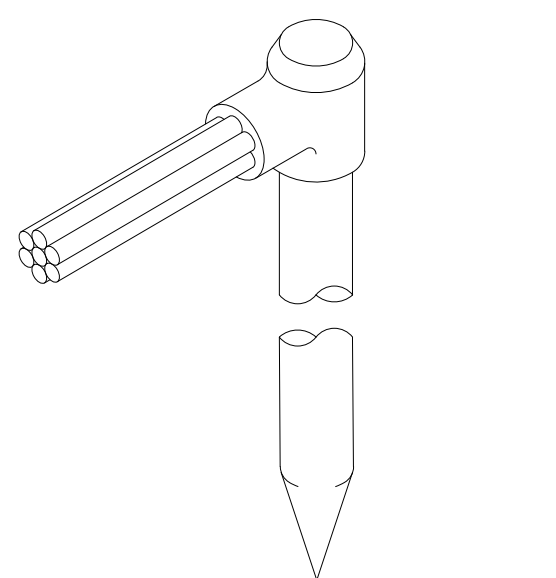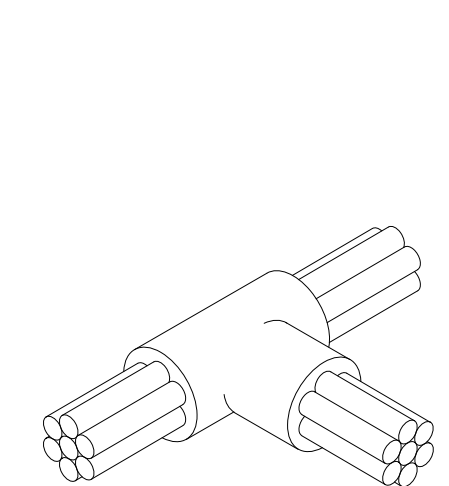

3 GROUND TAP DETAIL
SCALE: N.T.S.

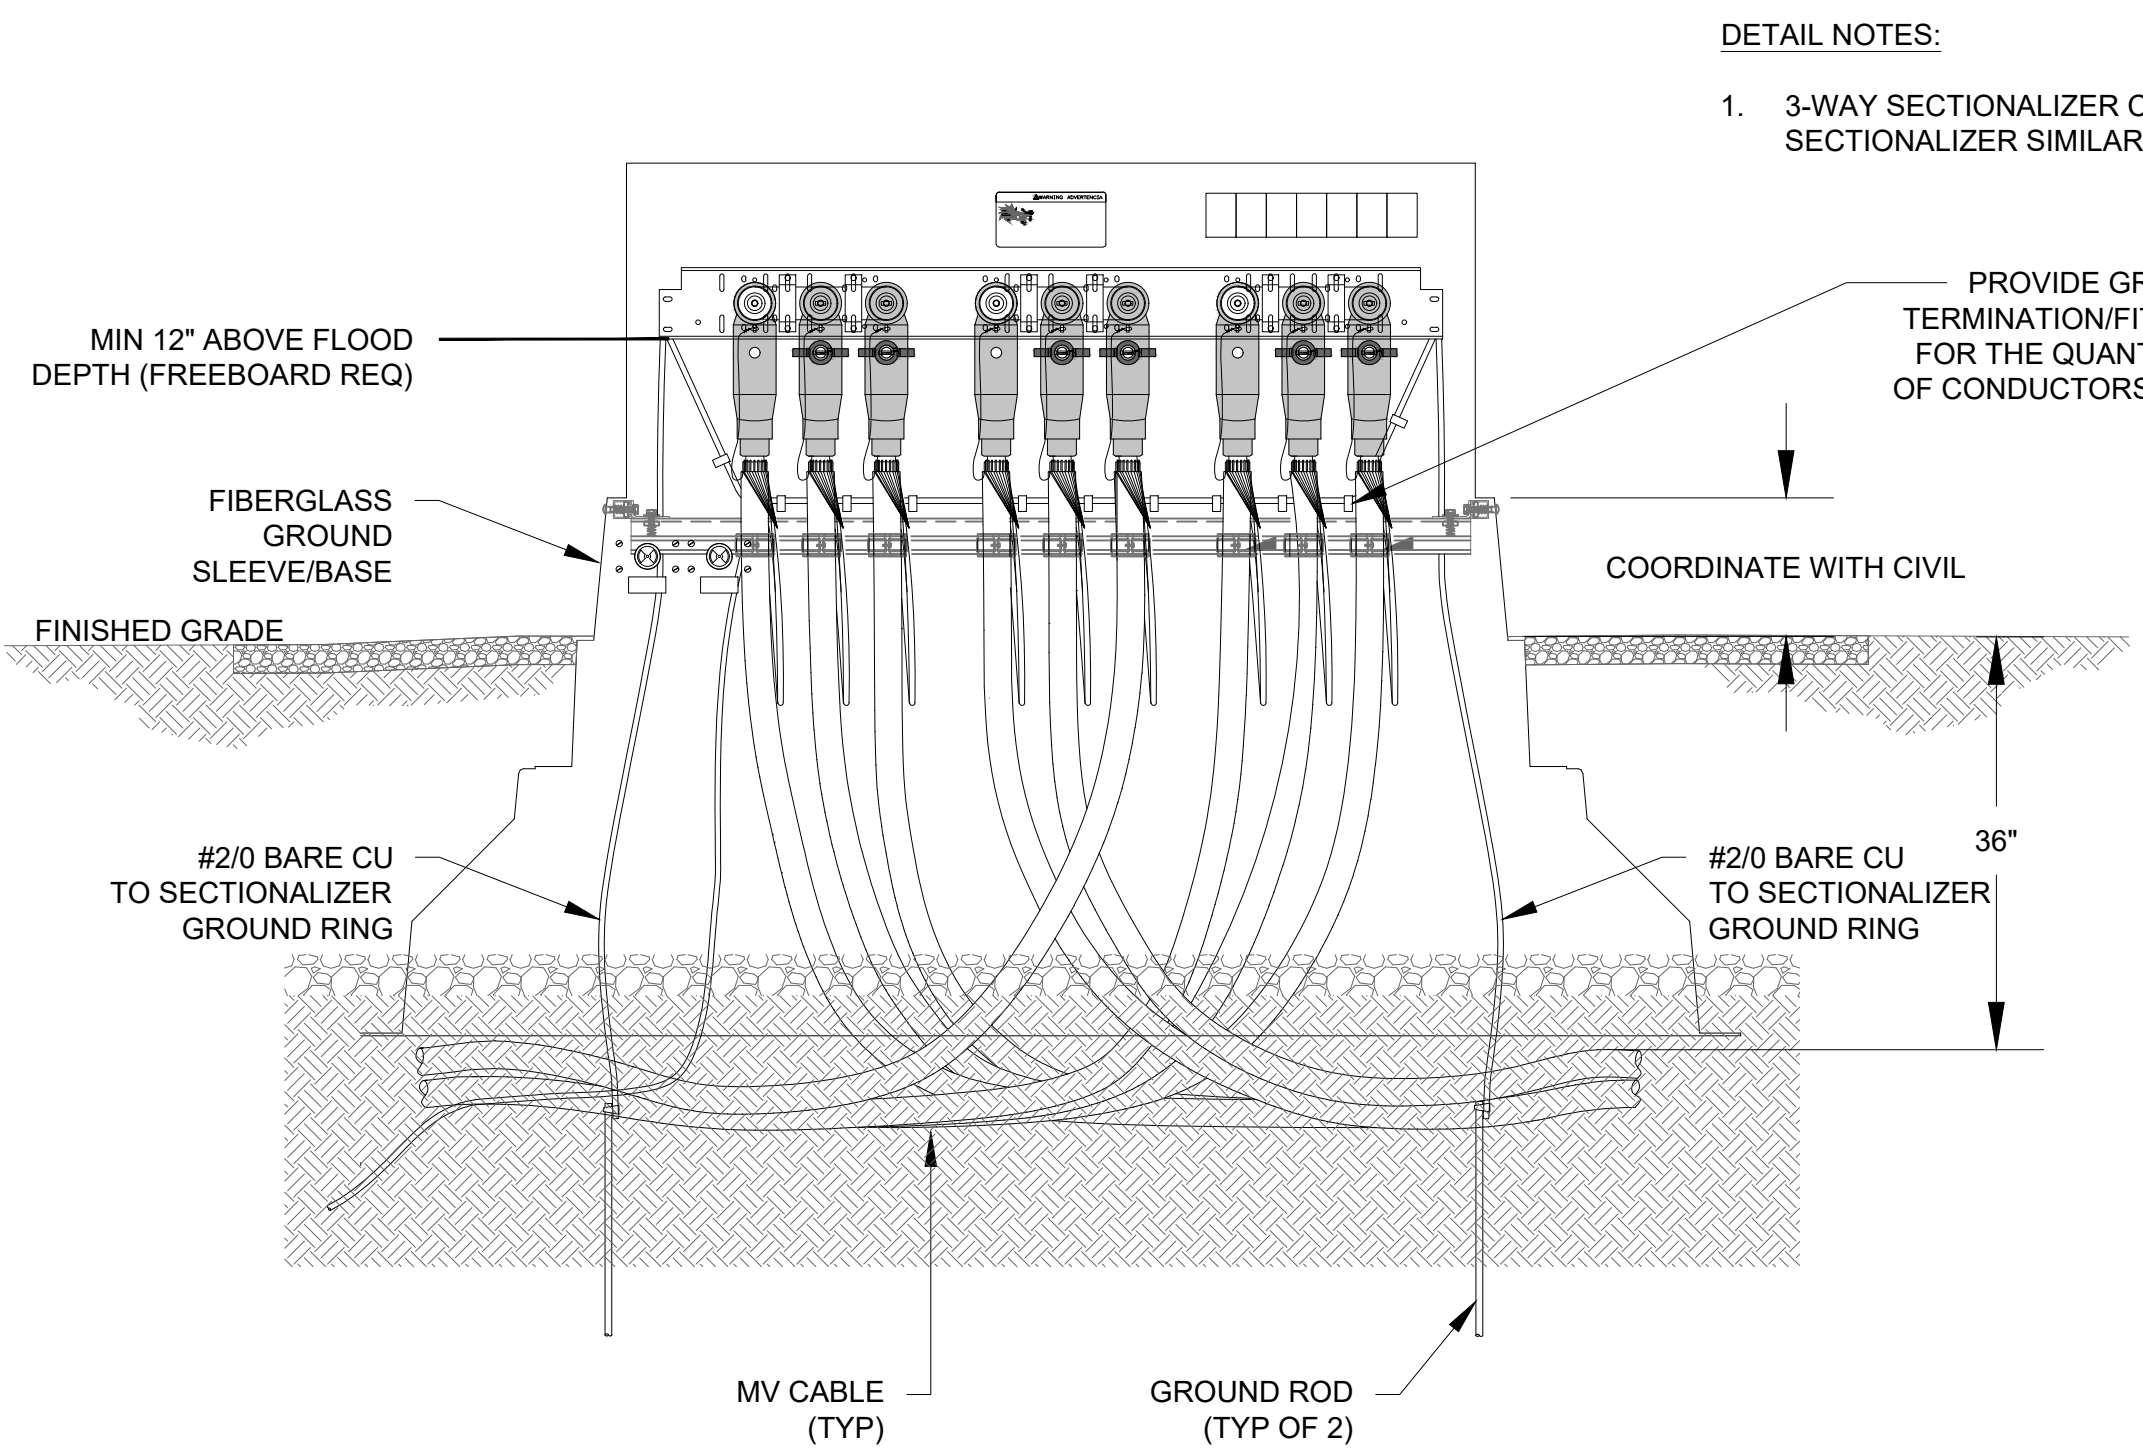

4 MV SECTIONALIZER GROUNDING ELEVATION DETAIL
SCALE: N.T.S.

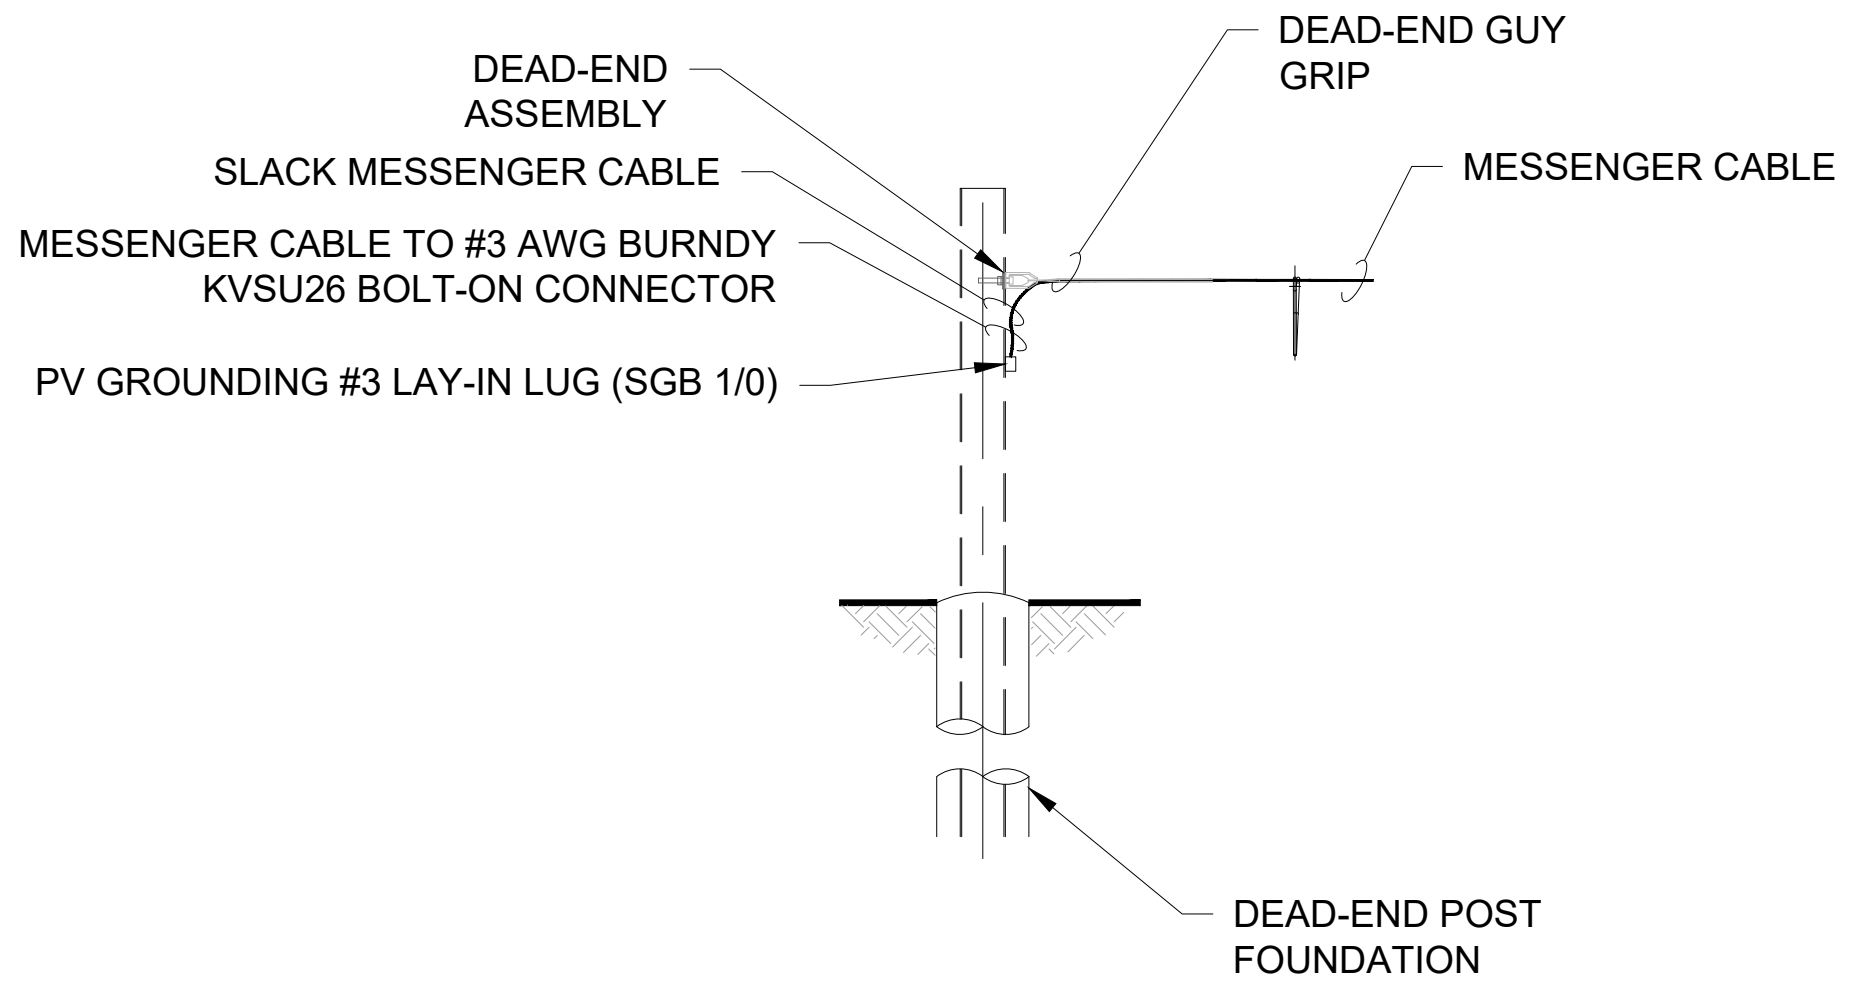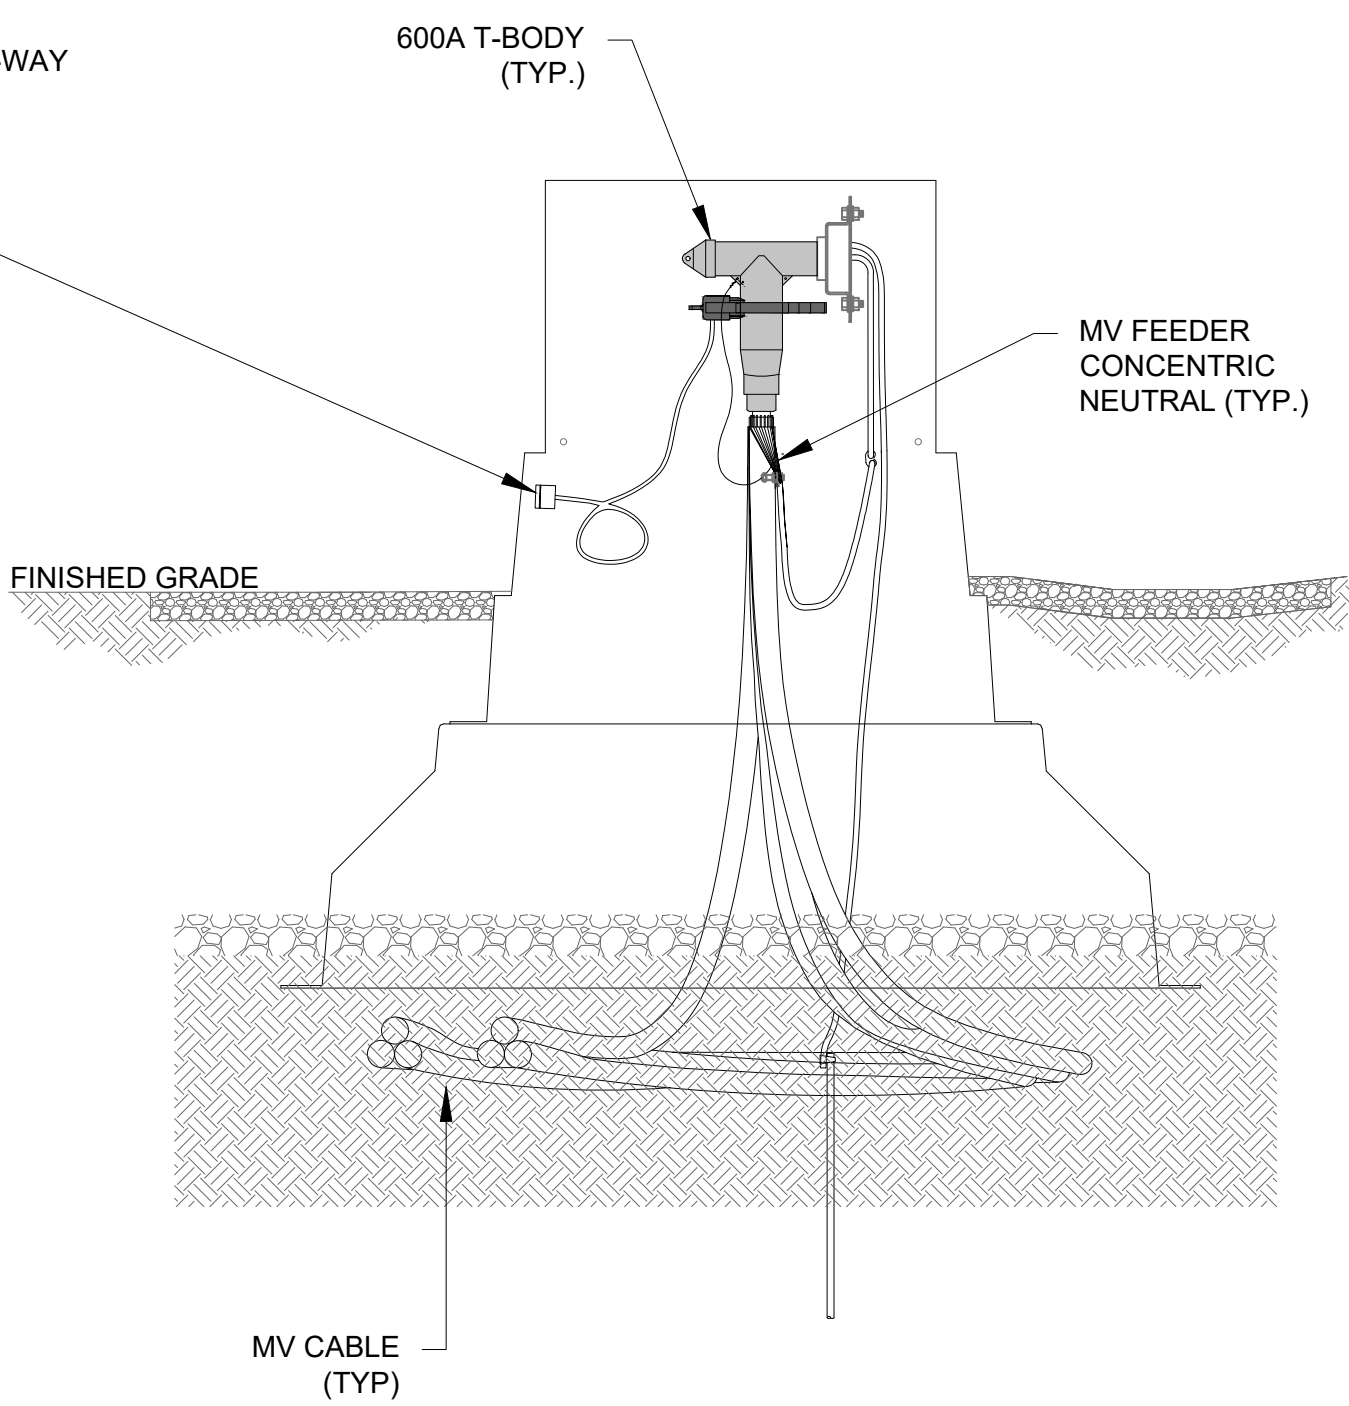

5 MESSENGER DEAD-END GROUNDING DETAIL
SCALE: N.T.S.

FastGrid

FastGrid, LLC
225 E Germann Road
Suite 301
Gilbert, AZ 85297

REV	DESCRIPTION	DATE
4	RECORD DRAWINGS	06/08/2023

PROJECT NAME:
**EAGLE SHADOW MOUNTAIN
PV SOLAR POWER
GENERATION FACILITY**

PROJECT ADDRESS:
**I-15
CRYSTAL, NV
CLARK COUNTY**

SEAL:

DATE:
10/16/2020

PROJECT #:
190067.03

DRAWN BY:
NK

CHECKED BY:
EL

SHEET NAME:
GROUNDING DETAILS

SHEET #:	REV #:
E-752	4



RECORD DRAWING

LOCATION: K:\09 PROJECTS\190067.03 - PRIMORIS - EAGLE SHADOW MOUNTAIN PV SOLAR POWER GENERATION FACILITY\DWG\E-752 GROUNDING DETAILS

SAVED BY: EridLoos

PLOT BY: Brady Burgesson

PLOT DATE: Thursday, June 08, 2023

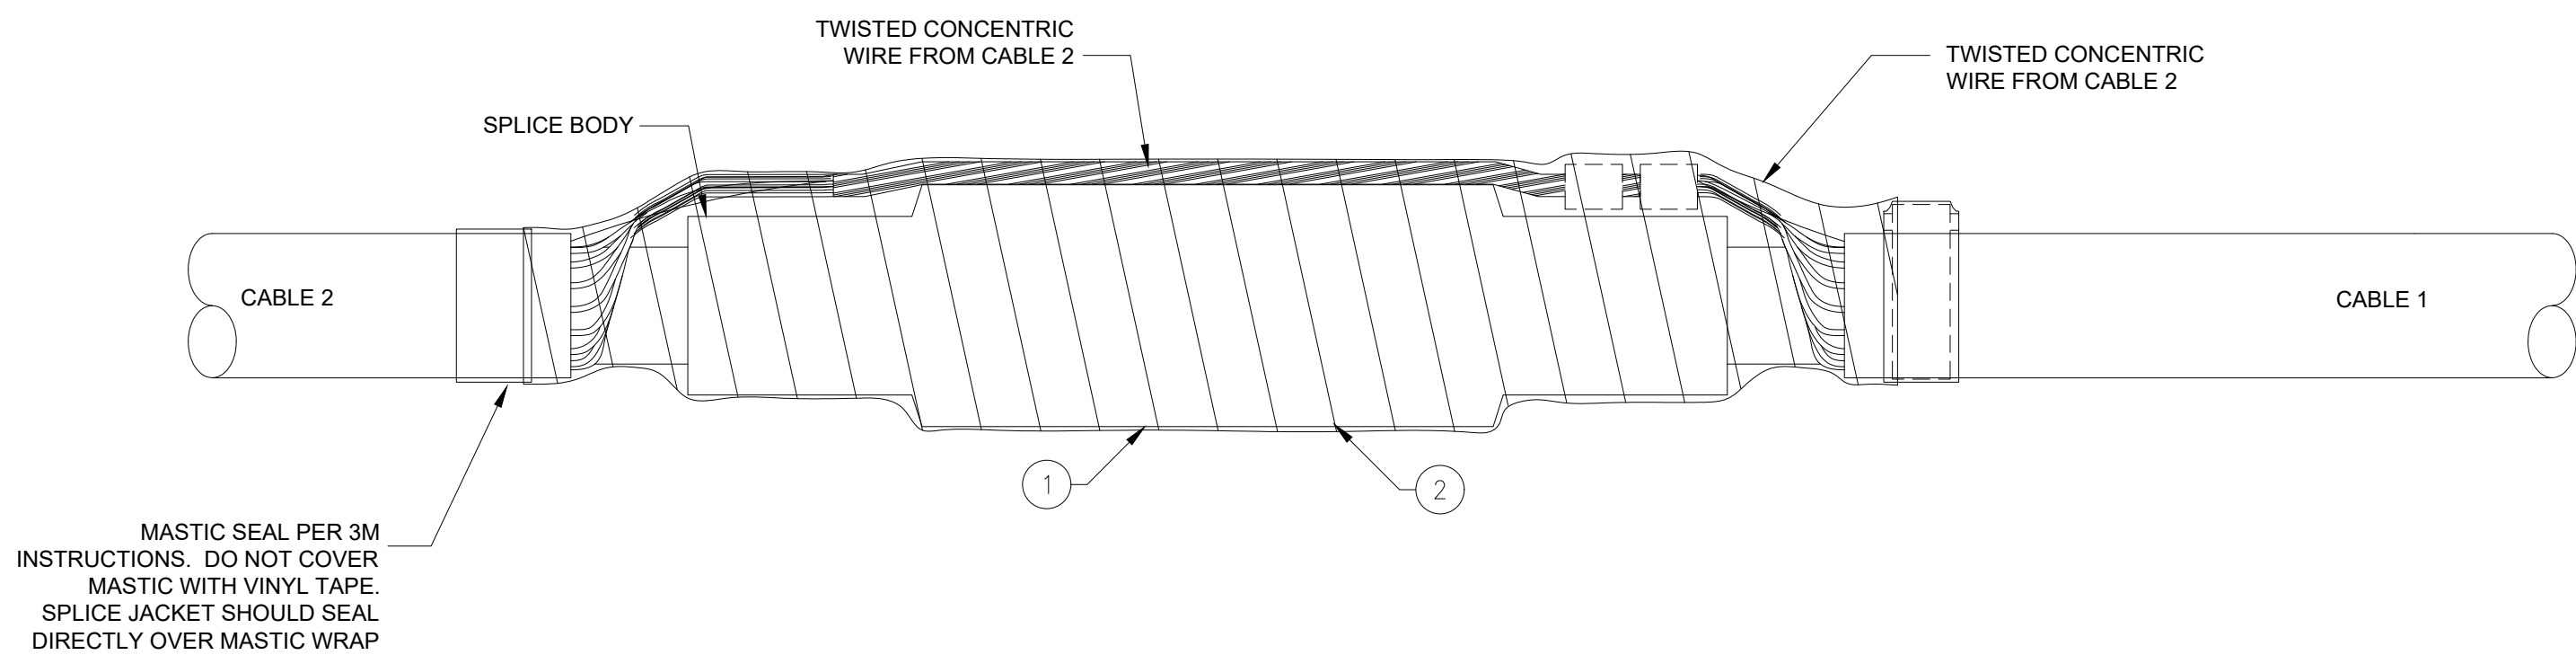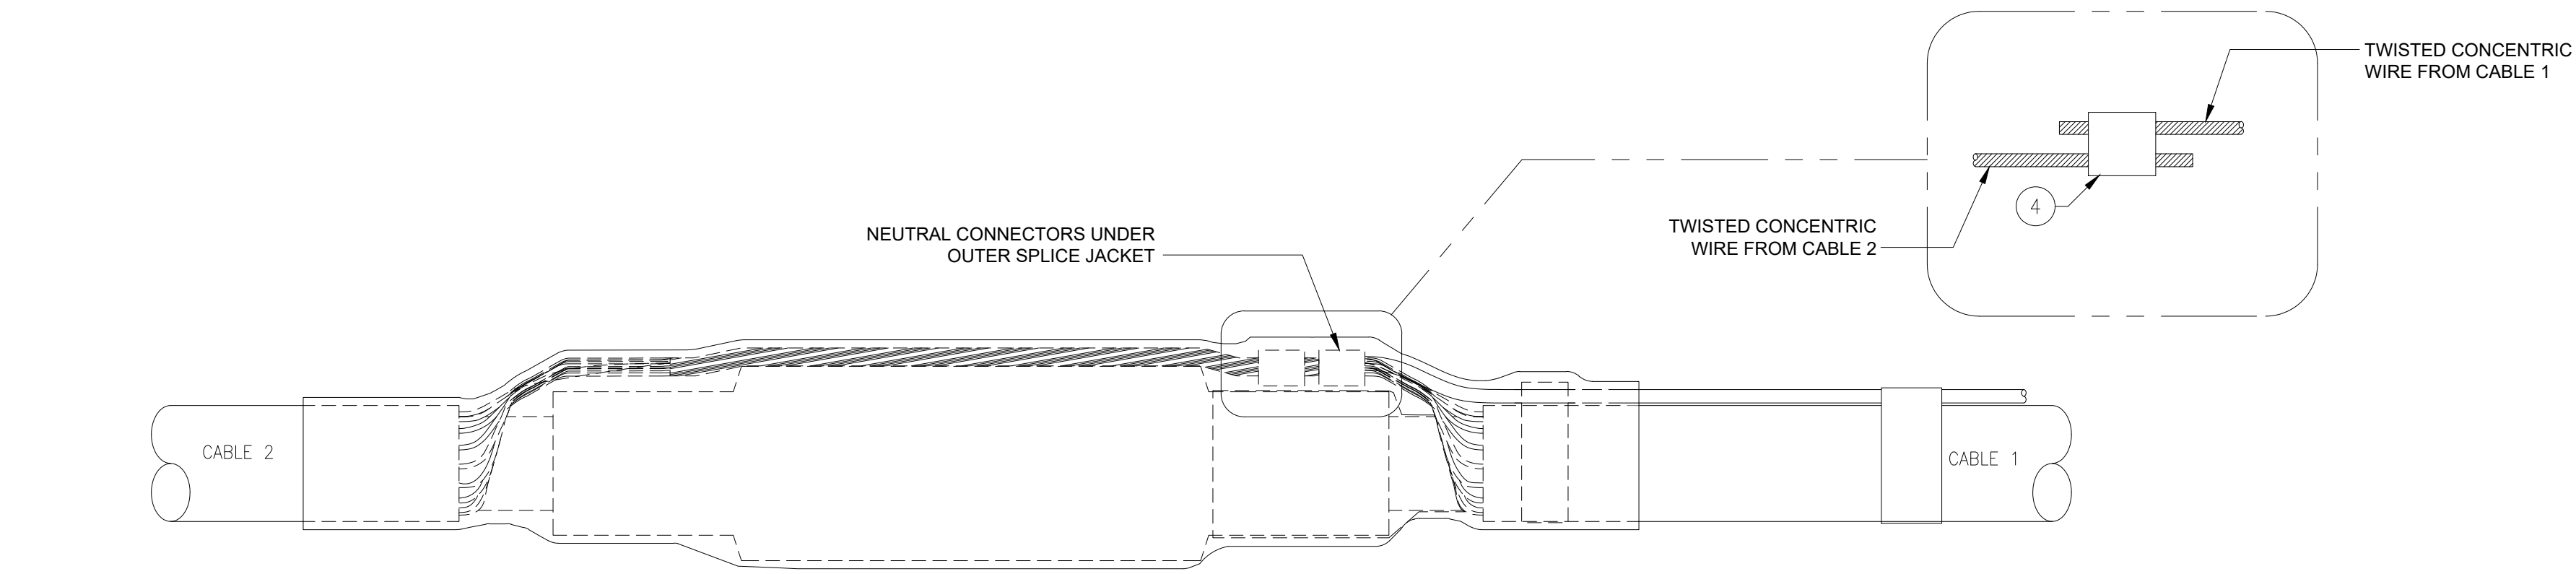


1 SPLICE AND NEUTRAL CONNECTIONS
SCALE: N.T.S.


GENERAL NOTES

- A. DETAIL IS SHOWN FOR REFERENCE ONLY WHEN A SPLICE MAY BE REQUIRED DUE TO UNFORESEEN CONSTRUCTION ACTIVITIES OR INSTALLATION ISSUES. ALL SPLICES MUST BE APPROVED BY THE ENGINEER OF RECORD AND THE OWNER PRIOR TO INSTALLATION.
- B. ALL EQUIPMENT SHALL BE UL LISTED OR UTILITY GRADE AND APPROVED BY OWNER. THE AHJ HAS FINAL JURISDICTIONAL AUTHORITY ON CODE APPLICATION AND COMPLIANCE.
- C. ALL CONSTRUCTION SHALL BE IN COMPLIANCE WITH THE NEC AND NESC.
- D. EXPOSED NON-CURRENT CARRYING METAL PARTS OF EQUIPMENT AND ENCLOSURES SHALL BE GROUNDED IN ACCORDANCE WITH NEC 250.134 AND 250.136(A).
- E. COMPRESSION MV LUGS ARE ACCEPTABLE.
- F. MARK EACH PRIMARY CABLE WITH BOTH PHASE IDENTIFICATION AND COLOR. INSTALL COLOR CODED TAPE PER BELOW:
- | PHASE | PRIMARY |
|-------|---------|
| A | BLACK |
| B | RED |
| C | BLUE |
- G. ABOVE GRADE CABLE MARKERS INSTALLED ABOVE MV SPLICE
- H. PROVIDE RECORD DOCUMENTATION OF GPS COORDINATES FOR SPLICE LOCATION

BILL OF MATERIAL			
ITEM	QTY	UNIT	DESCRIPTION
1	3	EA	SPLICE, CABLE, 35KV, 1/0 - 1250 KCMIL AL, SHEARBOLT
2	1	EA	TAPE, VINYL, 1.5" X 36YD
3	1	EA	MARKER BALL, DIRECT BURIED
4	3	EA	CONNECTOR, COMP GRD, #1-2/0 TO #1-2/0

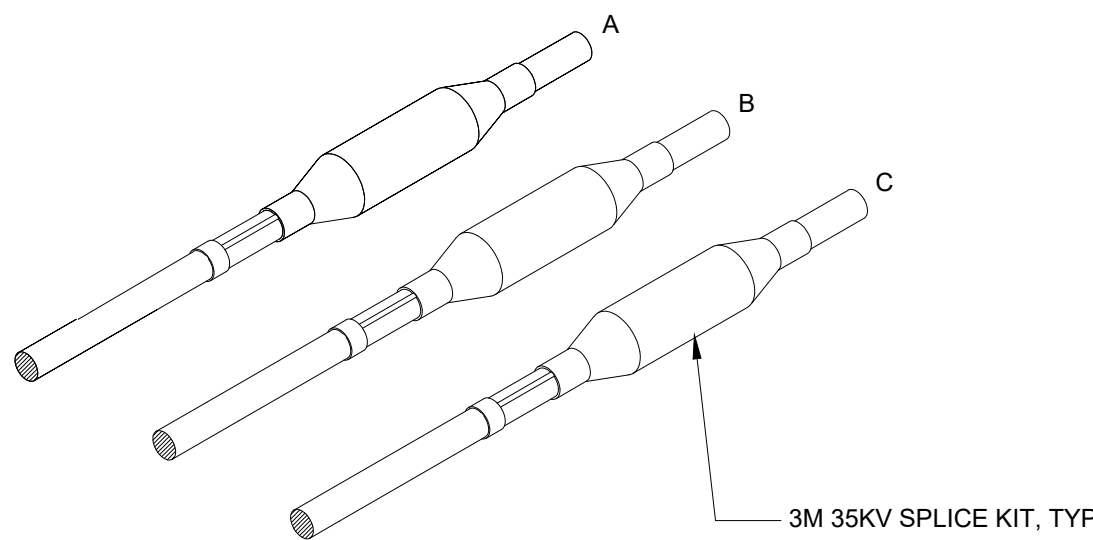

2 ISOMETRIC VIEW
SCALE: N.T.S.

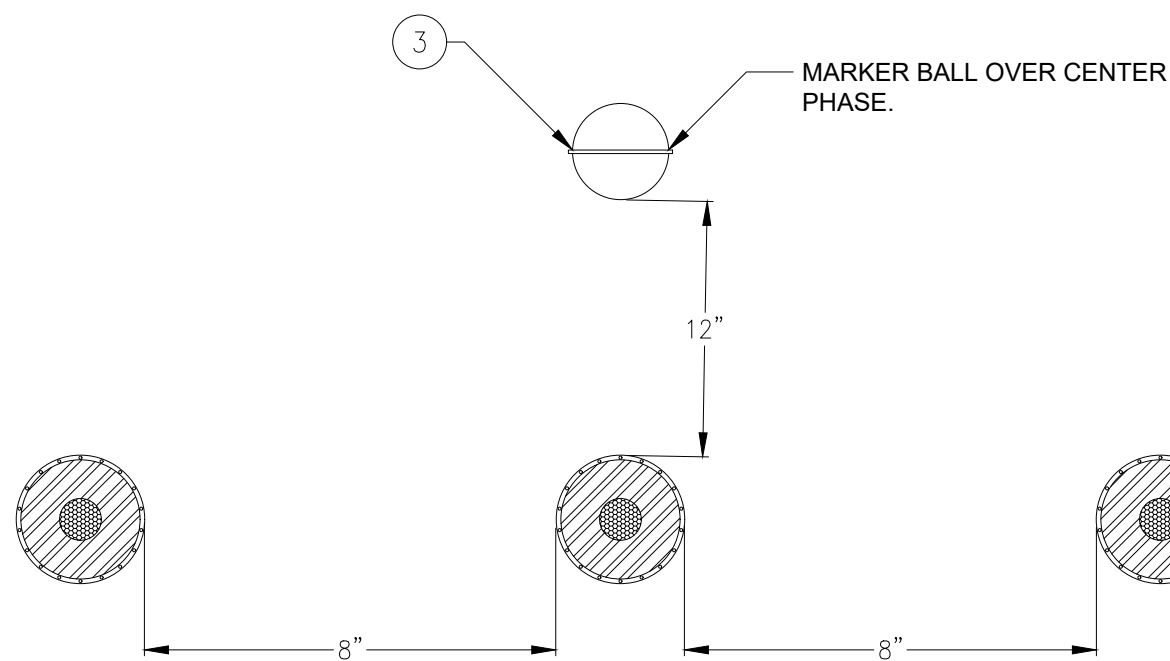

3 SECTION VIEW
SCALE: N.T.S.

FastGrid, LLC
225 E Germann Road
Suite 301
Gilbert, AZ 85297

REV	DESCRIPTION	DATE
4	RECORD DRAWINGS	06/08/2023

PROJECT NAME:
**EAGLE SHADOW MOUNTAIN
PV SOLAR POWER
GENERATION FACILITY**

PROJECT ADDRESS:
**I-15
CRYSTAL, NV
CLARK COUNTY**

SEAL:

DATE:
10/16/2020

PROJECT #:
190067.03

DRAWN BY:
GL

CHECKED BY:
EL

SHEET NAME:
MV SPLICE DETAILS

SHEET #:
E-753

REV #:
4


RECORD DRAWING

SUNGROW



SG3150U-MV New

Turnkey Station for North America 1500 Vdc System - MV Transformer Integrated

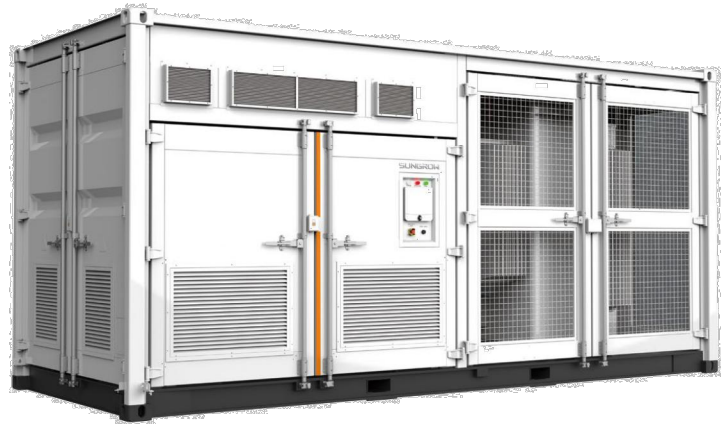

High Yield

- Advanced three-level technology, max. inverter efficiency 98.8%, inverter CEC efficiency 98.5 %
- Max. DC/AC ratio more than 1.5



Easy O&M

- Integrated current, voltage and MV parameters monitoring function for online analysis and fast trouble shooting
- Modular design, easy for maintenance
- Convenient external LCD



Saved Investment


- Low transportation and installation cost due to 20-foot container design
- 1500V DC system, low system cost
- Integrated MV transformer and LV auxiliary power supply




Grid Support

- Complies with UL 1741, UL 1741 SA, IEEE 1547, Rule 21 and NEC 2014/2017
- Grid support including LHVRT, LHFRT, active & reactive power control and power ramp rate control

Circuit Diagram

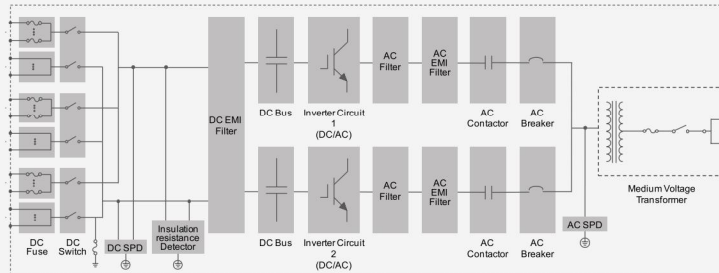

Inverter Efficiency Curve

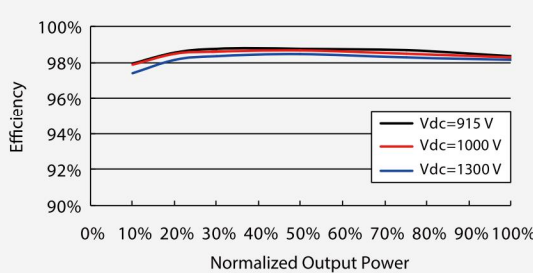

© 2018 Sungrow Power Supply Co., Ltd. All rights reserved.
Subject to change without notice. Version 1.2

SG3150U-MV

Input (DC)	SG3150U-MV
Max. PV input voltage	1500V
Min. PV input voltage / Startup input voltage	915 V / 955 V
MPP voltage range	915 – 1300 V
No. of independent MPP inputs	1
No. of DC inputs	18 – 24
Max. PV input current	3420 A
Max. DC short-circuit current	4800 A
PV array configuration	Negative grounding
Output (AC)	
AC output power	3150 kVA @ 45 °C (113 °F)
Max. inverter output current	2886 A
AC voltage range	34.5 kV
Nominal grid frequency / Grid frequency range	60 Hz / 55 – 65 Hz
THD	< 3 % (at nominal power)
DC current injection	< 0.5 % In
Power factor at nominal power / Adjustable power factor	> 0.99 / 0.8 leading – 0.8 lagging
Feed-in phases / Connection phases	3 / 3
Efficiency	
Inverter max. efficiency / Inverter CEC efficiency	98.8 % / 98.5 %
Transformer	
Transformer rated power	3150 kVA
Transformer max. power	3150 kVA
LV / MV voltage	0.63 kV / 34.5 kV
Transformer vector	Dy1
Transformer cooling type	ONAN (Oil Natural Air Natural)
Oil type	Mineral oil (PCB free) or degradable oil on request
Protection	
DC input protection	Load break switch + fuse
Inverter output protection	Circuit breaker
AC MV output protection	Load break switch + fuse
Overvoltage protection	DC Type II / AC Type II
Grid monitoring / Ground fault monitoring	Yes / Yes
Insulation monitoring	Optional
Overheat protection	Yes
General Data	
Dimensions (W*H*D)	6056*2896*2438 mm (238.5"*114.0"*96.0")
Weight	18 T (39683.2 lbs)
Degree of protection	NEMA 3R
Auxiliary power supply	120 Vac, 5 kVA / Optional: 480 Vac, 30 kVA
Operating ambient temperature range	-30 to 60 °C (> 45 °C derating) (-22 to 140 °F (> 113 °F derating))
Allowable relative humidity range (non-condensing)	0 – 95 %
Cooling method	Temperature controlled forced air cooling
Max. operating altitude	1000 m (standard) / > 1000 m (optional) (3280.8 ft (standard) / > 3280.8 ft (optional))
Display	Touch screen
Communication	Standard: RS485, Ethernet; Optional: optical fiber
Compliance	UL 1741, IEEE 1547, UL1741 SA, NEC 2014/2017, CSA C22.2 No.107.1-01
Grid support	Night SVG function (optional), LHVRT, LHFRT, active & reactive power control and power ramp rate control, Volt-var, Frequency-watt

© 2018 Sungrow Power Supply Co., Ltd. All rights reserved.
Subject to change without notice. Version 1.2



FastGrid, LLC
225 E Germann Road
Suite 301
Gilbert, AZ 85297

REV	DESCRIPTION	DATE
4	RECORD DRAWINGS	06/08/2023

PROJECT NAME:
**EAGLE SHADOW MOUNTAIN
PV SOLAR POWER
GENERATION FACILITY**

PROJECT ADDRESS:
**I-15
CRYSTAL, NV
CLARK COUNTY**



SEAL:	DATE: 10/16/2020
	PROJECT #: 190067.03
	DRAWN BY: TLR
	CHECKED BY: EL

SHEET NAME:
EQUIP SPECS - INVERTER

SHEET #: E-900	REV #: 4
--------------------------	--------------------

RECORD DRAWING

FOR REFERENCE ONLY

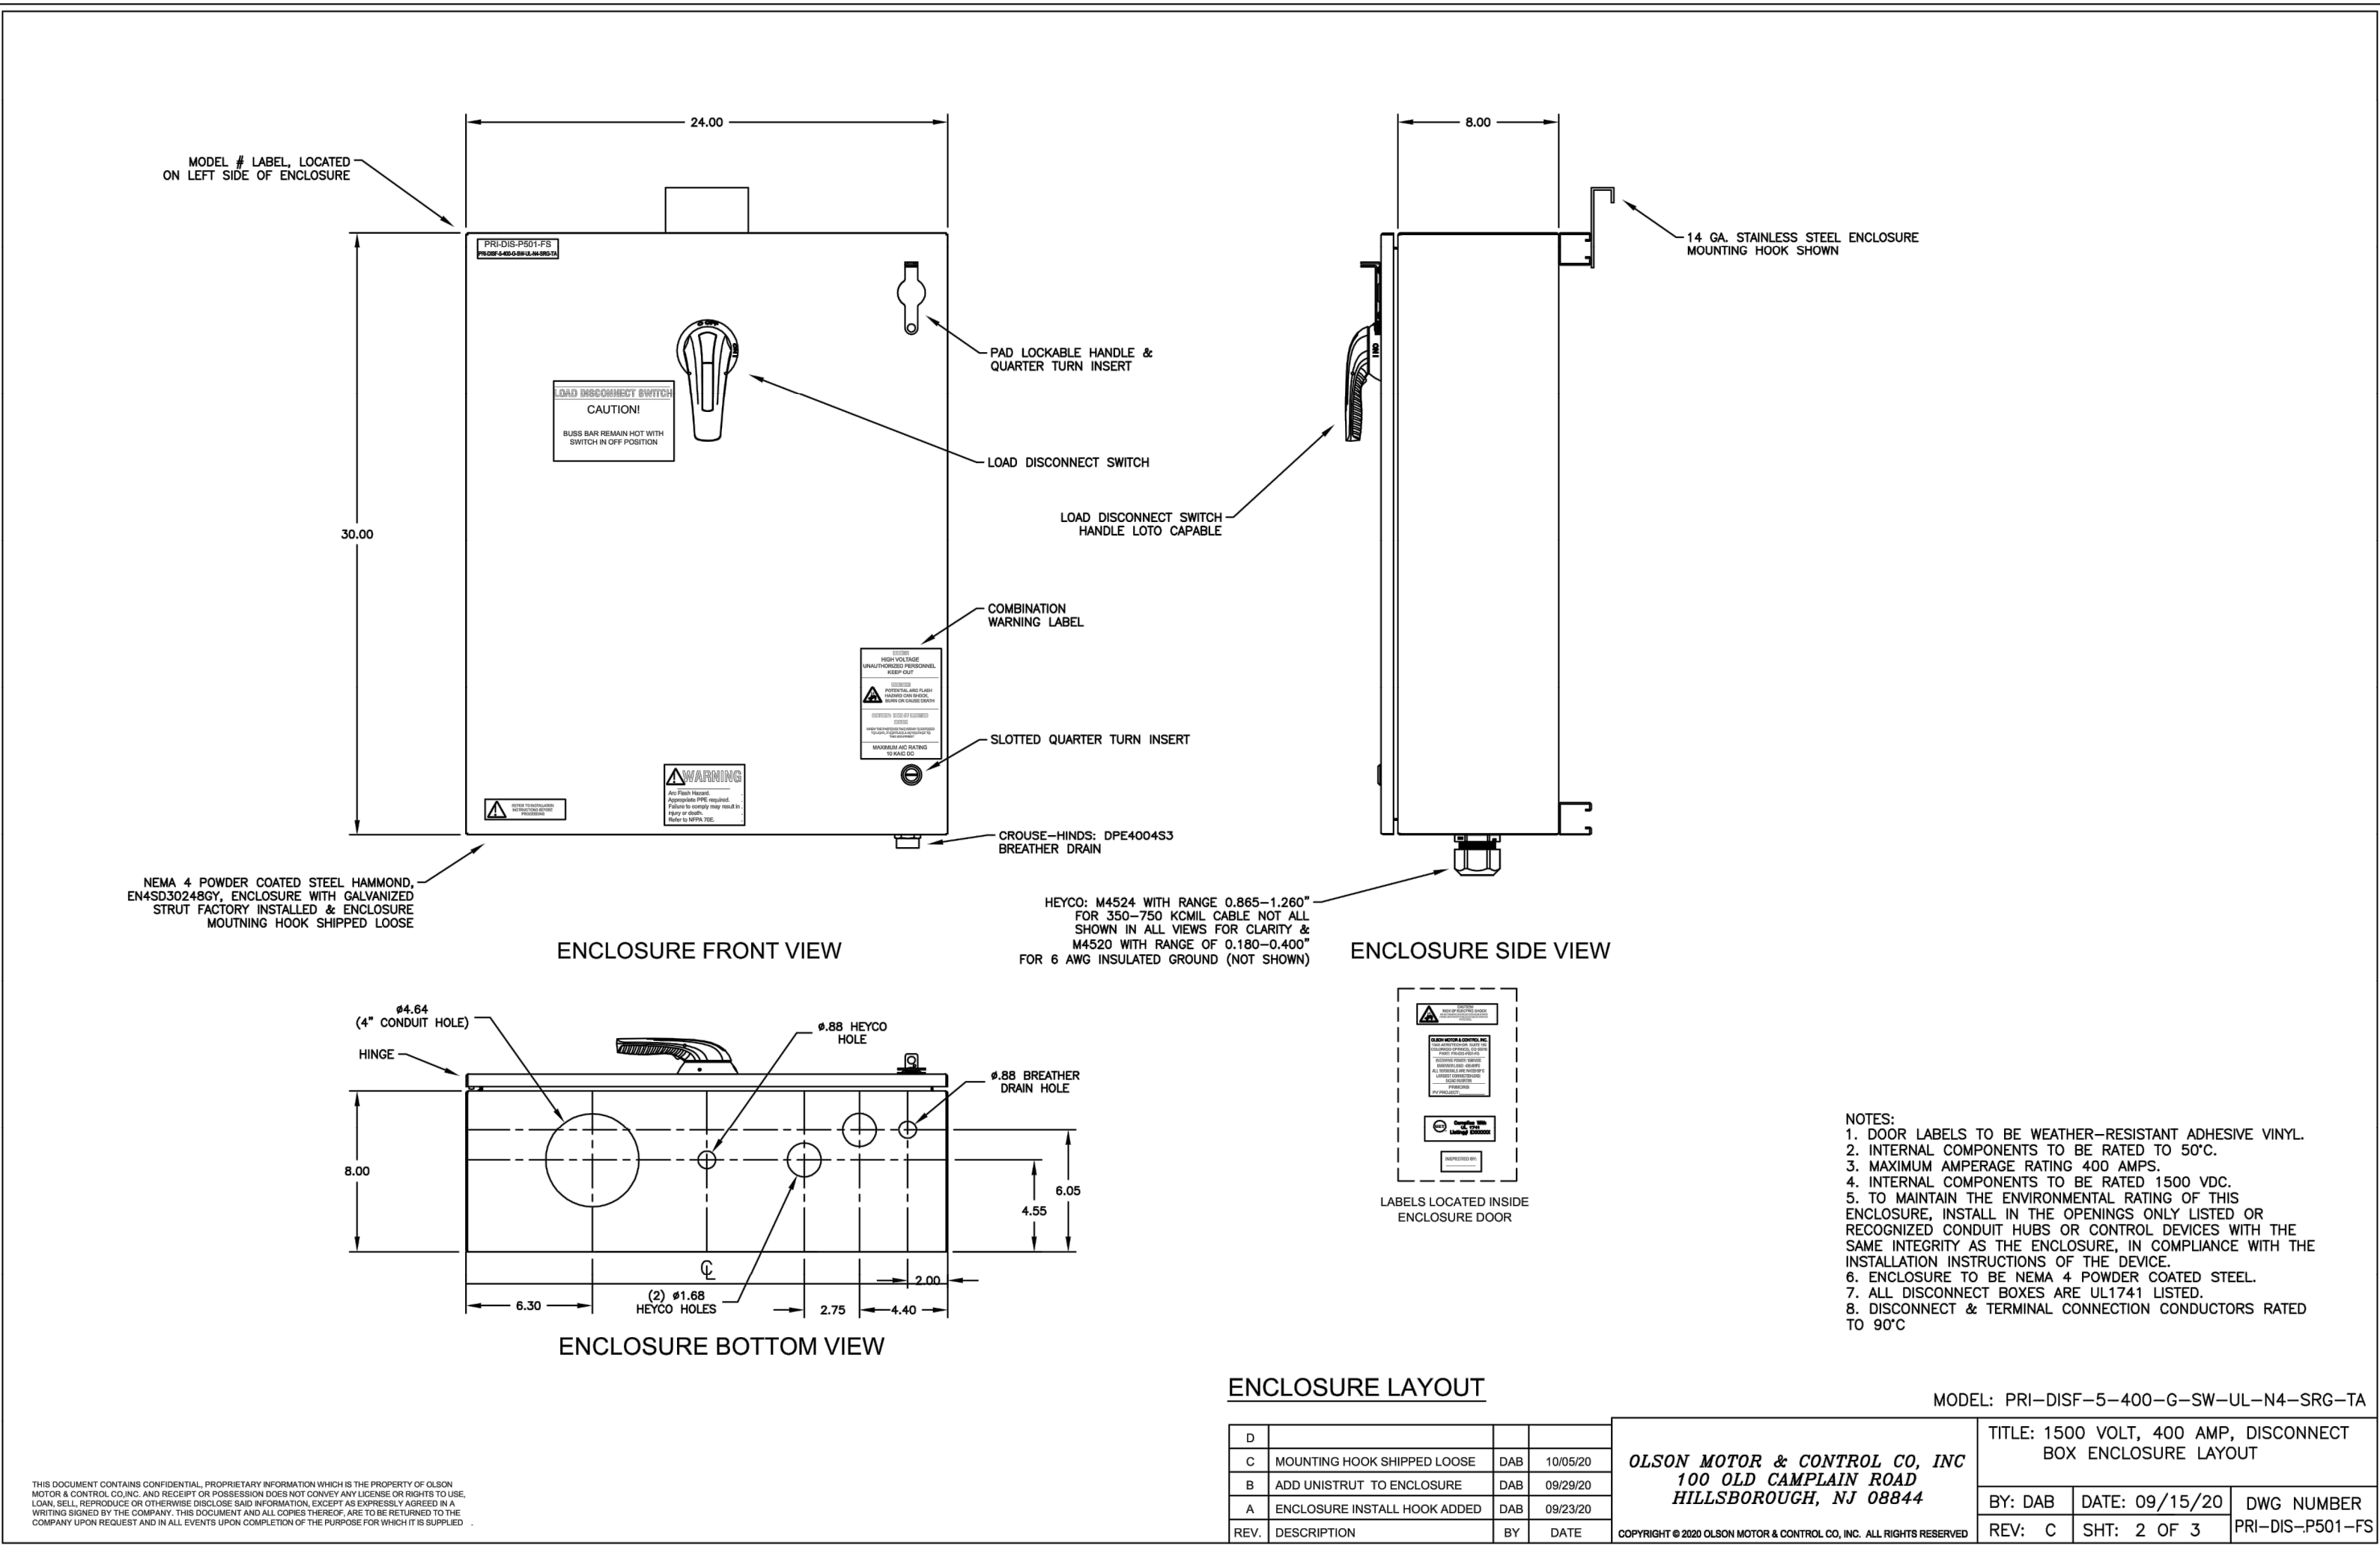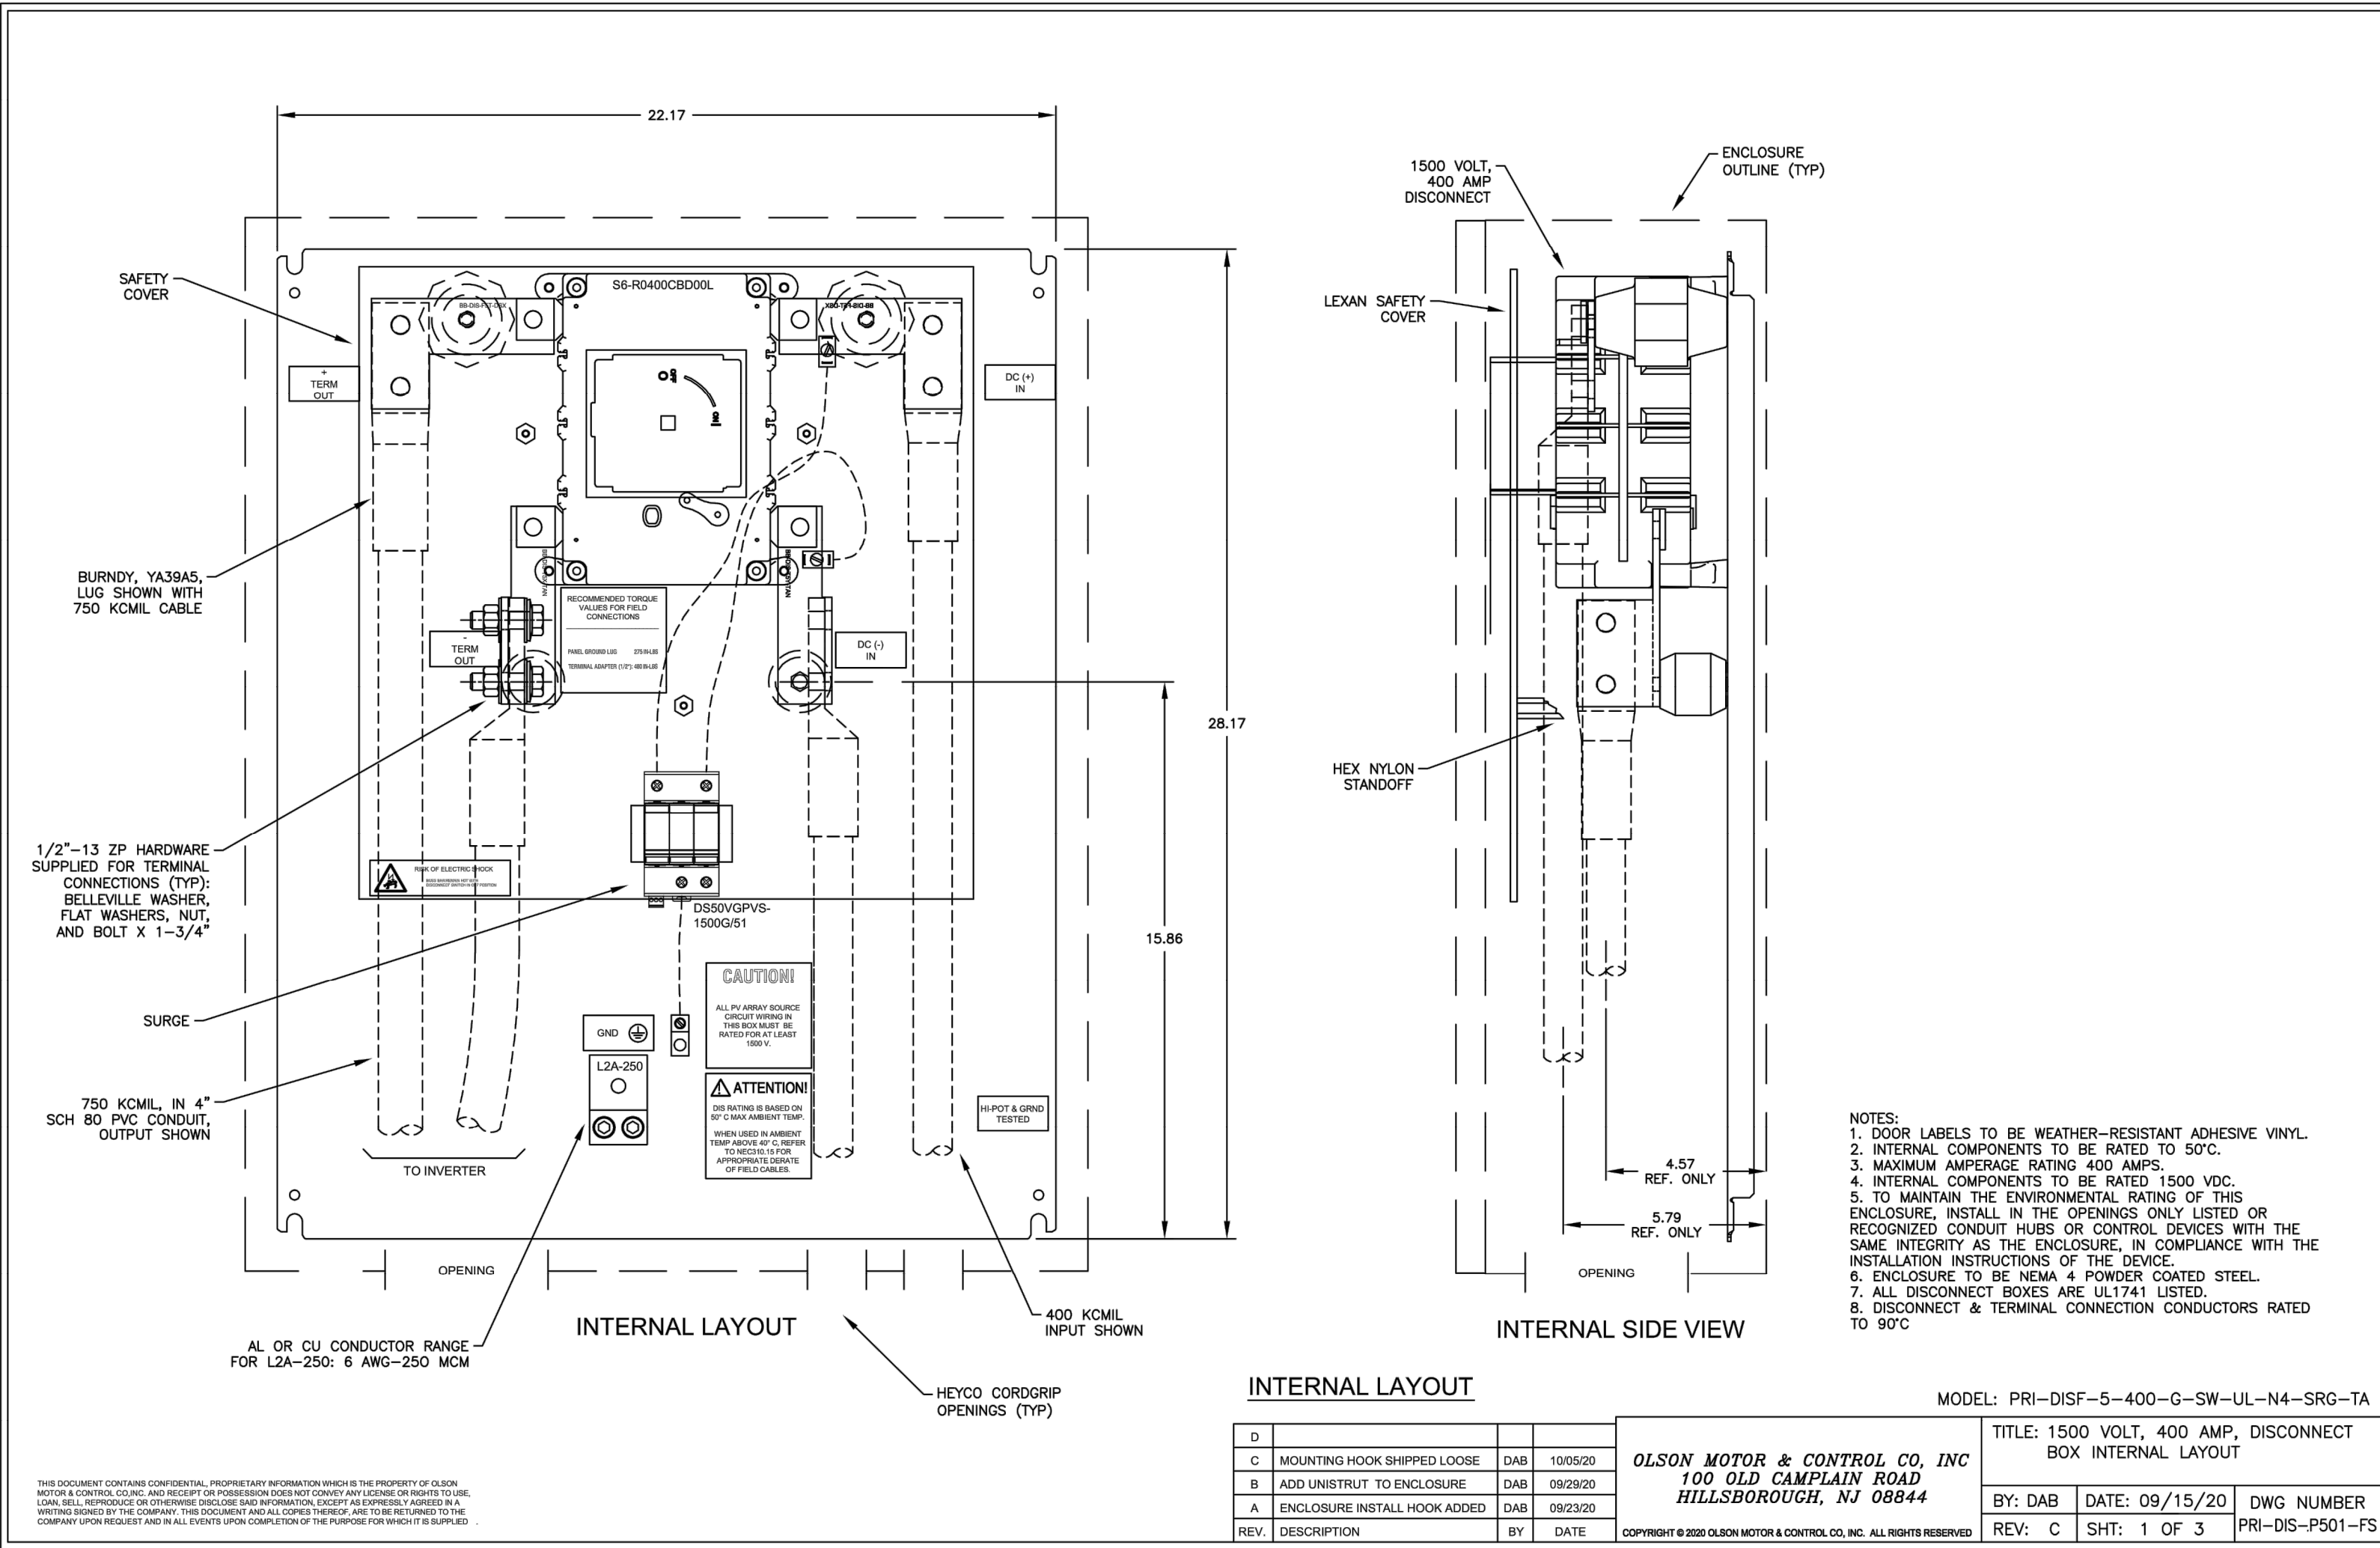

FastGrid, LLC
225 E Germann Road
Suite 301
Gilbert, AZ 85297

REV	DESCRIPTION	DATE
4	RECORD DRAWINGS	06/08/2023

PROJECT NAME:
EAGLE SHADOW MOUNTAIN
PV SOLAR POWER
GENERATION FACILITY

PROJECT ADDRESS:
I-15
CRYSTAL, NV
CLARK COUNTY

SEAL: DATE:
10/16/2020

PROJECT #:
190067.03

DRAWN BY:
NK

CHECKED BY:
EL

SHEET NAME:
EQUIP SPECS - LBD

SHEET #:
E-901

REV #:
4

7

6

5

4

3

2

1

FOR REFERENCE ONLY



RELIABILITY IS POWER.



DuraTrack® HZ v3

167×
fewer components than
competitive trackers

25,000+
Megawatt Years of Operation

ARRAY TECHNOLOGIES, INC.

3901 Midway Place NE
Albuquerque, NM 87109 USA

+1 505.881.7567
+1 855.TRACKPV (872.2578)
+1 505.881.7572

sales@arraytechinc.com
arraytechinc.com

THE MOST RELIABLE TRACKER UNDER THE SUN


HIGHEST POWER DENSITY.
Higher density means more power and more profit. DuraTrack HZ v3 offers the unique ability to maximize the power density of each site, boasting 6% more density than our closest competitor.

LEADING TERRAIN ADAPTABILITY.
Uneven terrain? Hill yes! Our flexibly linked architecture, with articulating driveline joints and forgiving tolerances, create the most adaptable system in market for following natural land contours and creates the greatest power generation potential from every site.

FEWER COMPONENTS. GREATER RELIABILITY.
Less is more. Array was founded on a philosophy of engineered simplicity. Minimizing potential failure points (167 times fewer components than competitors), DuraTrack HZ v3 consistently delivers higher reliability and superior uptime.

FAILURE-FREE WIND DESIGN.
DuraTrack HZ v3 was designed and field tested to withstand some of the harshest conditions on the planet. It is the only tracker on the market that reliably handles wind events with a fully integrated, fully automatic wind-load mitigation system.

ZERO SCHEDULED MAINTENANCE.
Three decades of solar tracker system design, engineering and testing has resulted in uncompromising reliability. Maintenance-free motors and gears, fewer moving parts, and industrial-grade components means maintenance-free energy generation.




DuraTrack® HZ v3

COST VERSUS VALUE

We believe value is more than the cost of a tracking system. It's about building with forgiving tolerances and fewer parts so construction crews can work efficiently. It means protecting your investment with a failure-free wind management system. It also includes increasing power density. But most of all, value is measured in operational uptime, or reliability.

THE GLOBAL LEADER IN RELIABILITY

Array has spent decades designing and perfecting the most reliable tracker on the planet. Fewer moving parts, stronger components and intelligent design that protects your investment in the harshest weather are but a few of the innovative differences that keep your system running flawlessly all day and you resting easy at night.



Array Technologies Inc. reserves the right to make specification changes without notice.

STRUCTURAL & MECHANICAL FEATURES/SPECIFICATIONS	
Tracking Type	Horizontal single axis
MW per Drive Motor	Up to 1.036800 MW DC using 360W crystalline
String Voltage	Up to 1,500V DC
Maximum Linked Rows	32
Maximum Row Size	90 modules crystalline, glass-on-glass, and bifacial; 240 modules First Solar 4; 72 modules First Solar 6
Drive Type	Rotating gear drive
Motor Type	2 HP, 3 PH, 480V AC
Motors per 1 MW DC	Less than 1
East-West / North-South Dimensions	Site / module specific
Array Height	54" standard, adjustable (48" min height above grade)
Ground Coverage Ratio (GCR)	Flexible, 28-45% typical, others supported on request
Terrain Flexibility	N-S tolerance: 0° - 8.5° standard, 15° optional Driveline: 40° in all directions
Modules Supported	Most commercially available, including frameless crystalline, thin film, and bifacial.
Tracking Range of Motion	± 52° standard, ± 62° optional
Operating Temperature Range	-30°F to 140°F (-34°C to 55°C)
Module Configuration	Single-in-portrait standard, including bifacial. Two-or-three in landscape (framed or frameless), four-in-landscape (thin film) also available.
Module Attachment	Single fastener, high-speed mounting clamps with integrated grounding. Traditional rails for crystalline in landscape, custom racking for thin film and frameless crystalline and bifacial per manufacturer specs.
Materials	HDO steel and aluminum structural members
Allowable Wind Load (IBC 2012)	135 mph, 3-second gust exposure C
Wind Protection	Passive mechanical system relieves wind and obstruction damage -- no power required


ELECTRONIC CONTROLLER FEATURES/SPECIFICATIONS	
Solar Tracking Method	Algorithm with GPS input
Control Electronics	MCU plus Central Controller
Data Feed	MODBUS over Ethernet to SCADA system
Night-time Slow	Yes
Tracking Accuracy	± 2" standard, field adjustable
Backtracking	Yes

INSTALLATION, OPERATION & MAINTENANCE	
PE Stamped Structural Calculations & Drawings	Yes
On-site Training & System Commissioning	Yes
Connection Type	Fully bolted connections, no welding
In-field Fabrication Required	No
Dry Slide Bearings & Articulating Driveline Connections	No lubrication required
Scheduled Maintenance	None required
Module Cleaning Compatibility	Robotic, Tractor, Manual

GENERAL	
Annual Power Consumption (kWh per 1 MW)	400 kWh per MW per year, estimated
Land Area Required per 1 MW	Approx. 4 to 4.5 acres per MW @ 33% GCR (site and design specific)
Energy Gain vs. Fixed-Tilt	Up to 25%, site specific
Warranty	10 year structural, 5 year drive & control components
Patent Numbers	US patent 8,459,249 US patent 9,281,778 US patent 9,581,678 B2 and patents pending
Codes and Standards	UL Certified (3703 & 2703), IEC 62817

REV 1.3 - 09.20.2018

RECORD DRAWING



FastGrid, LLC
225 E Germann Road
Suite 301
Gilbert, AZ 85297

REV	DESCRIPTION	DATE
4	RECORD DRAWINGS	06/08/2023

PROJECT NAME:

EAGLE SHADOW MOUNTAIN
PV SOLAR POWER
GENERATION FACILITY

PROJECT ADDRESS:

I-15
CRYSTAL, NV
CLARK COUNTY

SEAL:

DATE:
10/16/2020

PROJECT #:
190067.03

DRAWN BY:
LR

CHECKED BY:
EL

SHEET NAME:

EQUIP SPECS - TRACKER


SHEET #:	REV #:
E-903	4

LOCATION: K:_09_PROJECTS\190067.03 - PRIMORIS - EAGLE SHADOW MOUNTAIN\05 ENGINEERING\DWG\E-903 EQUIP SPECS - TRACKER


SAVED BY: Terri Rogers

PLOT BY: Brady Burgess

PLOT DATE: Thursday, June 08, 2023

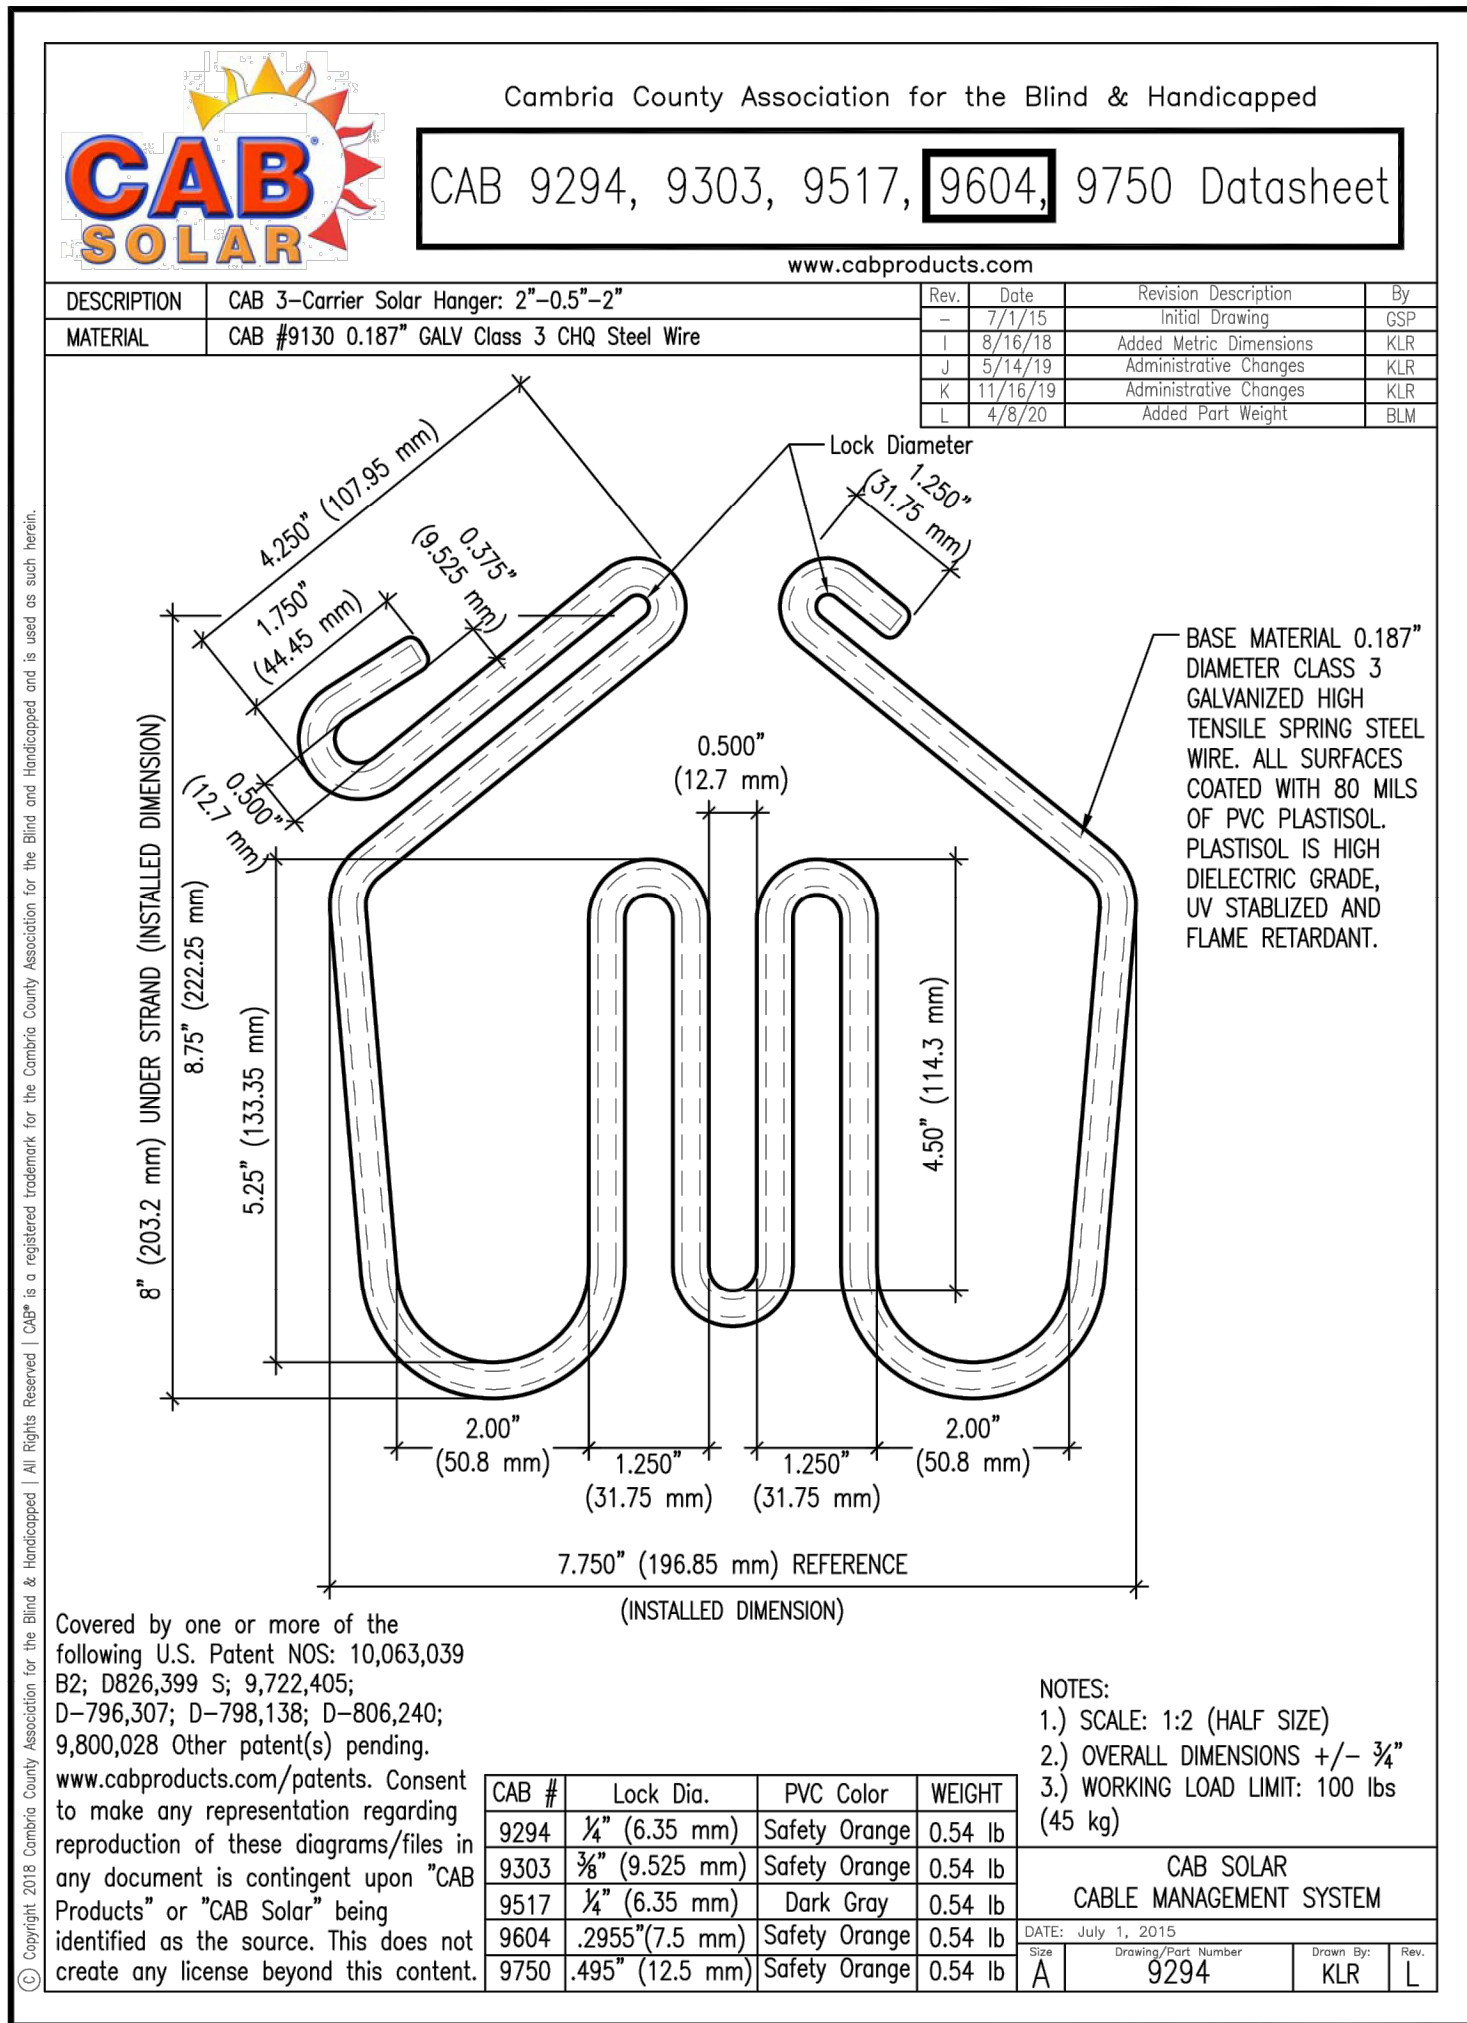

215 Centerview Drive, Suite 360 • Brentwood, TN 37027 • USA
<http://www.copperweld.com>
Office: +1.615.377.4200
Fax: +1.615.377.4167

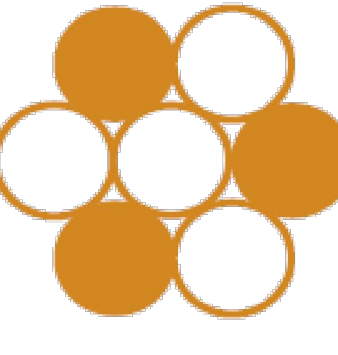Cable Description	COPPERWELD® COPPER - COPPER CLAD STEEL COMPOSITE 40% EHS 7X0985, TYPE K (Exceeds 3 AWG Copper fusing current at 30 cycles)																		
Cable Specifications	ASTM B227 – Standard Specification for Hard-Drawn Copper-Clad Steel Wire ASTM B229 – Standard Specification for Concentric-Lay-Stranded Copper and Copper-Clad Steel Composite Conductors																		
Catalog Number	55C7X0985KD																		
<div><div><div>Time/Fusing Current</div><table><tr><th>Seconds (kA)</th><th>Fusing Current</th></tr><tr><td>0.1</td><td>27.57</td></tr><tr><td>0.25</td><td>17.44</td></tr><tr><td>0.5</td><td>12.33</td></tr><tr><td>1</td><td>8.72</td></tr><tr><td>2</td><td>6.16</td></tr><tr><td>5</td><td>3.9</td></tr><tr><td>10</td><td>2.76</td></tr></table></div><div><p>TYPE K 3 COPPER + 4 COPPERWELD® COPPER CLAD STEEL</p></div></div>				Seconds (kA)	Fusing Current	0.1	27.57	0.25	17.44	0.5	12.33	1	8.72	2	6.16	5	3.9	10	2.76
Seconds (kA)	Fusing Current																		
0.1	27.57																		
0.25	17.44																		
0.5	12.33																		
1	8.72																		
2	6.16																		
5	3.9																		
10	2.76																		
PHYSICAL DATA	Diameter of Individual Wires	0.0985	inch																
	Number of Wires	7 (3-Copper + 4-CCS)																	
	Overall diameter	0.2955	inch																
	Cross Section of Area	67.92	Kcmil																
	Linear Weight	198.9	lb/1000 ft																
ELECTRICAL DATA	Minimum Break Load	5528	lbf																
	Max. Conductor DC Resistance at 20°C	0.2411	Ω/1000 ft																
	Conductivity – CCS wire	40	% IACS																
	Fusing current @ 30 cycles	11.13	kA																
<p>All materials contained in this document are the intellectual property of Copperweld Bimetallics, LLC., and protected by copyright laws. None of its content may not be reproduced, republished, distributed, transmitted, displayed, broadcast or otherwise exploited in any manner without the express prior written permission of Copperweld Bimetallics, LLC. For more information, contact engineering@copperweld.com. Note: Min Tensile Cu = 64,900 psi (ASTM B1); Min Tensile 40% CCS EHS = 156,000 psi (ASTM B227) Fusing current at 30 cycles is calculated using equation 37 of IEEE Standard 80. IEEE Guide for Safety in AC Substation Grounding.</p>																			

FastGrid, LLC
225 E Germann Road
Suite 301
Gilbert, AZ 85297

REV	DESCRIPTION	DATE
4	RECORD DRAWINGS	06/08/2023

PROJECT NAME:

EAGLE SHADOW MOUNTAIN
PV SOLAR POWER
GENERATION FACILITY

PROJECT ADDRESS:

I-15
CRYSTAL, NV
CLARK COUNTY


SEAL:	DATE: 10/16/2020
	PROJECT #: 190067.03
	DRAWN BY: LR
	CHECKED BY: EL

SHEET NAME:

EQUIP SPECS - CAB SYSTEM

SHEET #: E-904	REV #: 4
-------------------	-------------

RECORD DRAWING

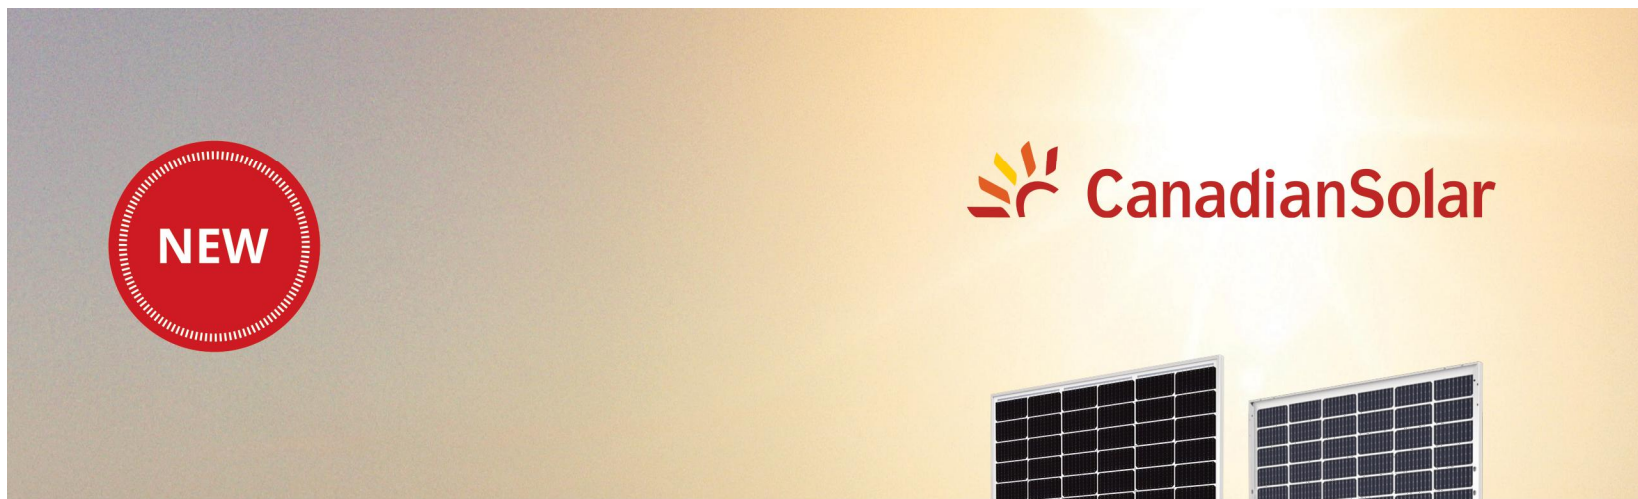

BiHiKu
SUPER HIGH POWER BIFACIAL MONO PERC MODULE
420 W ~ 445 W
UP TO 30% MORE POWER FROM THE BACK SIDE
CS3W-420 | 425 | 430 | 435 | 440 | 445MB-AG

MORE POWER

- EXTRA POWER** Up to 30% more power from the back side
- 24 % higher front side power than conventional modules
- Low NMOT: $41 \pm 3^\circ\text{C}$
- Low temperature coefficient (Pmax): $-0.35\% / ^\circ\text{C}$

BETTER SHADING TOLERANCE

- Better shading tolerance

MORE RELIABLE

- Lower internal current, lower hot spot temperature
- Minimizes micro-crack impacts
- Heavy snow load up to 5400 Pa, wind load up to 3600 Pa *

30 years linear power output warranty*

12 years enhanced product warranty on materials and workmanship*

*According to the applicable Canadian Solar Limited Warranty Statement.

MANAGEMENT SYSTEM CERTIFICATES*


ISO 9001:2015 / Quality management system
ISO 14001:2015 / Standards for environmental management system
OHSAS 18001:2007 / International standards for occupational health & safety
PRODUCT CERTIFICATES*
IEC 61215 / IEC 61730: VDE / CE / MCS / NEMETRO
UL 1703: CSA / IEC 61701: EDE / IEC 62716: VDE / IEC 60068-2-68: SGS
Take-e-way

* As there are different certification requirements in different markets, please contact your local Canadian Solar sales representative for the specific certificates applicable to the products in the region in which the products are to be used.

CANADIAN SOLAR (USA), INC. is committed to providing high quality solar products, solar system solutions and services to customers around the world. No. 1 module supplier for quality and performance/price ratio in IHS Module Customer Insight Survey. As a leading PV project developer and manufacturer of solar modules with over 40 GW deployed around the world since 2001.

* For detail information, please refer to Installation Manual.

CANADIAN SOLAR (USA), INC.
3000 Oak Road, Suite 400, Walnut Creek, CA 94597, USA | www.canadiansolar.com/na | sales.us@canadiansolar.com

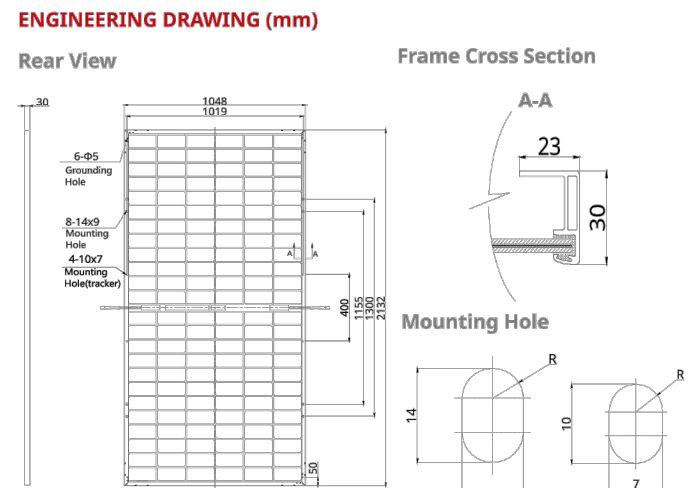

ELECTRICAL DATA | STC*

	Nominal	Max. Voltage (Vmp)	Operating Current (Imp)	Opt. Power (Wp)	Open Circuit Voltage (Voc)	Short Circuit Current (Isc)	Module Efficiency (%)
CS3W-420MB-AG	420 W	39.9 V	10.53 A	447.9	47.9 V	11.27 A	18.8%
Bifacial Gain**	5%	441 W	39.9 V	11.06 A	47.9 V	11.83 A	19.7%
	20%	504 W	39.9 V	11.58 A	47.9 V	12.40 A	20.7%
CS3W-425MB-AG	425 W	40.1 V	10.60 A	426.1	48.1 V	11.32 A	19.0%
Bifacial Gain**	5%	446 W	40.1 V	11.13 A	48.1 V	11.89 A	20.0%
	10%	468 W	40.1 V	11.66 A	48.1 V	12.45 A	20.9%
CS3W-430MB-AG	430 W	40.1 V	10.72 A	432.1	48.1 V	11.35 A	19.2%
Bifacial Gain**	5%	510 W	40.1 V	12.72 A	48.1 V	13.58 A	22.8%
	20%	553 W	40.1 V	13.78 A	48.1 V	14.72 A	24.8%
CS3W-435MB-AG	435 W	40.3 V	10.75 A	438.3	48.3 V	11.42 A	19.5%
Bifacial Gain**	5%	452 W	40.3 V	11.21 A	48.3 V	11.94 A	20.2%
	10%	473 W	40.3 V	11.75 A	48.3 V	12.51 A	21.2%
CS3W-440MB-AG	440 W	40.7 V	10.82 A	447.8	48.7 V	11.48 A	19.7%
Bifacial Gain**	5%	516 W	40.7 V	12.82 A	48.7 V	13.64 A	23.1%
	20%	549 W	40.7 V	13.89 A	48.7 V	14.78 A	25.1%
CS3W-445MB-AG	445 W	40.5 V	10.75 A	455.7	48.5 V	11.42 A	19.5%
Bifacial Gain**	5%	457 W	40.5 V	11.29 A	48.5 V	11.99 A	20.5%
	10%	479 W	40.5 V	11.83 A	48.5 V	12.56 A	21.4%
CS3W-450MB-AG	450 W	40.9 V	11.06 A	459.5	49.1 V	11.83 A	19.7%
Bifacial Gain**	5%	522 W	40.9 V	12.90 A	49.1 V	13.70 A	23.4%
	20%	566 W	40.9 V	13.98 A	49.1 V	14.85 A	25.3%
CS3W-440MB-AG	440 W	40.7 V	10.82 A	447.8	48.7 V	11.48 A	19.7%
Bifacial Gain**	5%	516 W	40.7 V	12.82 A	48.7 V	13.64 A	23.1%
	10%	549 W	40.7 V	13.89 A	48.7 V	14.78 A	25.1%
CS3W-445MB-AG	445 W	40.7 V	10.93 A	453.9	48.9 V	11.54 A	19.9%
Bifacial Gain**	5%	467 W	40.9 V	11.43 A	48.9 V	12.12 A	20.9%
	10%	490 W	40.9 V	11.98 A	48.9 V	12.69 A	21.9%
CS3W-450MB-AG	450 W	40.9 V	11.06 A	459.5	49.1 V	11.83 A	19.7%
Bifacial Gain**	5%	534 W	40.9 V	13.07 A	49.1 V	13.85 A	23.9%
	20%	579 W	40.9 V	14.16 A	49.1 V	15.00 A	25.9%


* Under Standard Test Conditions

* Under Standard Test Conditions (STC) of Irradiance of 1000 W/m², spectrum AM 1.5 and cell temperature of 25°C.
** Bifacial Gain: The additional gain from the back side compared to the power of the front side at the standard test condition. It depends on mounting structures, height, tilt angle etc.) and albedo of the ground.

ELECTRICAL DATA	Operating Temperature	-40°C ~ +85°C
	Max. System Voltage	1500 V (IEC/UL) or 1000 V (IEC/UL)
	Module Fire Performance	TYPE 3 (UL 1703)
	Max. Series Fuse Rating	25 A
	Application Classification	Class A
	Power Tolerance	0 ~ + 10 W
	Power Bifaciality*	70 %
	Power Bifaciality = Pmax _{back} / Pmax _{front}	Both Pmax _{back} and Pmax _{front} are tested under STC. Bifaciality tolerance: ± 5 %

* The specifications and key features contained in this datasheet may deviate slightly from our actual products due to the on-going innovation and product enhancement. Canadian Solar Inc. reserves the right to make necessary adjustment to the information described herein at any time without further notice.
Please be kindly advised that PV modules should be handled and installed by qualified persons who have professional skills and please carefully read the safety and installation instructions before using our PV modules.

CANADIAN SOLAR (USA), INC. May 2020 | All rights reserved | PV Module Datasheet v5.59_F26_J1_NA

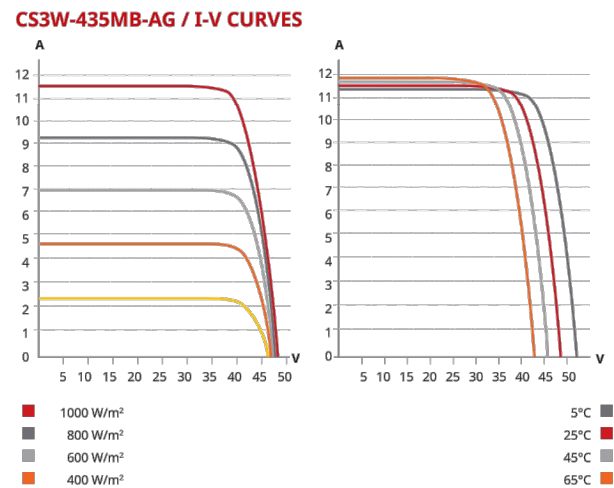

ELECTRICAL DATA | NMOT*

	Nominal Power (Pmax)	Opt. Voltage (Vmp)	Opt. Current (Imp)	Open Circuit Voltage (Voc)	Short Circuit Current (Isc)	Module Efficiency (%)
CS3W-420MB-AG	315 W	37.3 V	8.42 A	45.2 V	9.09 A	9.09 A
CS3W-425MB-AG	318 W	37.5 V	8.48 A	45.4 V	9.13 A	9.13 A
CS3W-430MB-AG	322 W	37.7 V	8.54 A	45.6 V	9.17 A	9.17 A
CS3W-435MB-AG	326 W	37.9 V	8.59 A	45.8 V	9.21 A	9.21 A
CS3W-440MB-AG	329 W	38.1 V	8.65 A	46 V	9.26 A	9.26 A
CS3W-445MB-AG	333 W	38.3 V	8.71 A	46.1 V	9.31 A	9.31 A

* Under Nominal Module Operating Temperature (NMOT), irradiance of 800 W/m², spectrum AM 1.5, ambient temperature 20°C, wind speed 1 m/s.

MECHANICAL DATA

Specification	Data
Cell Type	Mono-crystalline
Cell Arrangement	144 [2X (12 X 6)]
Dimensions	2132 X 1048 X 30 mm (83.9 X 41.3 X 1.2 in)
Weight	28.4 kg (62.6 lbs)
Front / Back Glass	2.0 mm heat strengthened glass
Frame	Anodized aluminium alloy
J-Box	IP68, 3 diodes
Cable	4.0 mm ² (IEC), 12 AWG (UL)
Cable Length (Including Connector)	Portrait: 400 mm (15.7 in) (+) / 280 mm (11.0 in) (-) Landscape: 1400 mm (55.1 in) leap-frog connection: 1850 mm (72.8 in)*
Connector	T4 series or MC4
Per Pallet	33 pieces
Per Container (40' HQ)	660 pieces or 561 pieces (only for US)

* For detailed information, please contact your local Canadian Solar sales and technical representatives.

TEMPERATURE CHARACTERISTICS

Specification	Data
Temperature Coefficient (Pmax)	-0.35 % / °C
Temperature Coefficient (Voc)	-0.27 % / °C
Temperature Coefficient (Isc)	0.05 % / °C
Nominal Module Operating Temperature	41 ± 3°C

PARTNER SECTION



Mono Multi Solutions

THE
DUOMAX^{tw}
BIFACIAL DUAL GLASS 144 CELL MULTI BUSBAR MODULE

144-Cell
MONOCRYSTALLINE MODULE

390-410W
POWER OUTPUT RANGE

20.2%
MAXIMUM EFFICIENCY

0~+5W
POSITIVE POWER TOLERANCE

Founded in 1997, Trina Solar is the world's leading total solution provider for solar energy. With local presence around the globe, Trina Solar is able to provide exceptional service to each customer in each market and deliver our innovative, reliable products with the backing of Trina as a strong, bankable brand. Trina Solar now distributes its PV products to over 100 countries all over the world. We are committed to building strategic, mutually beneficial collaborations with installers, developers, distributors and other partners in driving smart energy together.

Comprehensive Products and System Certificates


IEC61215/IEC61730/IEC61701/IEC62716
ISO 9001: Quality Management System
ISO 14001: Environmental Management System
ISO 14064: Greenhouse Gases Emissions Verification
OHSAS 18001: Occupational Health and Safety Management System



Trina solar

PRODUCTS
TSM-DEG15MC20(V)

POWER RANGE
390-410W

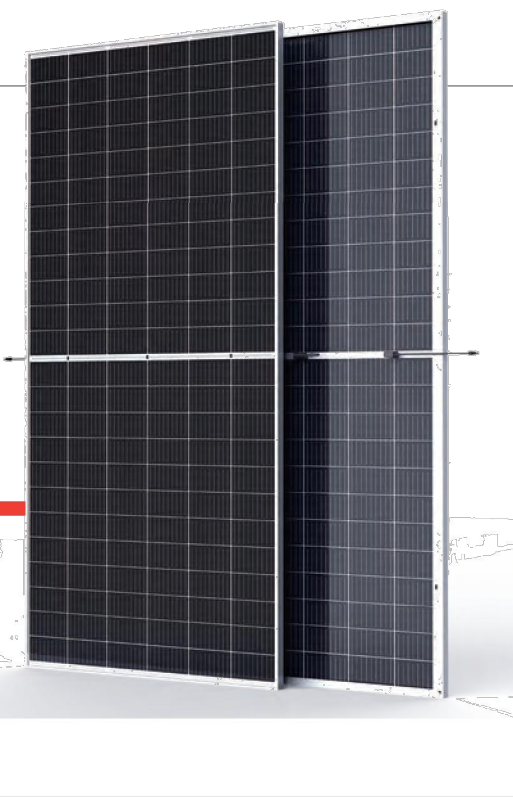

- High power output**
 - Up to 410W front power and 20.2% module efficiency with half-cut and MBB (Multi Busbar) technology enabling higher BOS savings
 - Lower resistance of half-cut cells ensures higher power

Certified to perform in highly challenging environments

- High PID resistance through cell process and module material control
- Resistant to salt, acid, sand, and ammonia
- Proven to be reliable in high temperature and humidity areas
- Certified to the best fire class A
- Minimizes micro-crack and snail trails
- Certified to 5400 Pa positive load and 2400 Pa negative load


High energy generation, low LCOE

- Up to 25% additional power gain from back side, depending on the albedo
- Excellent 3rd party validated IAM and low light performance with cell process and module material optimization
- Low temp coefficient (-0.35%) and NMOT increases energy production
- Better anti-shading performance and lower operating temperature
- Higher power from same installation footprint as standard modules

Easy to install, wide application

- Frame design enables compatibility with standard installation methods
- Deployable for ground mounted utility, carports, and agricultural projects
- Safe and easy to transport, handle, and install like normal framed modules





Trina Solar's DUOMAX Performance Warranty

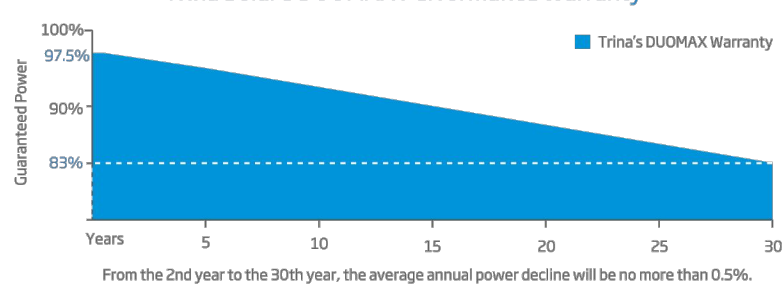

DUOMAX^{tw}

BIFACIAL DUAL GLASS 144 HALF-CELL MBB MODULE

DIMENSIONS OF PV MODULE (mm)

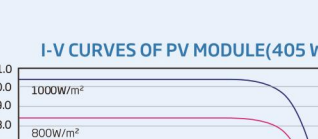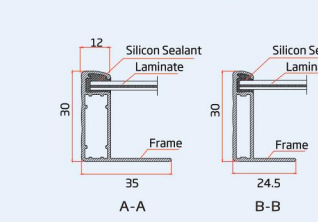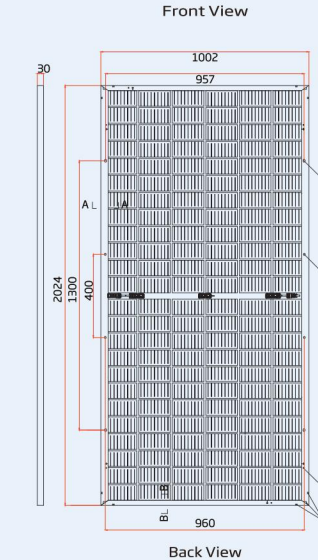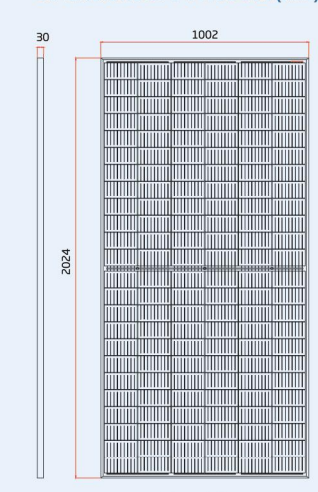

Peak Power Watts-P _{max} (Wp)*	390	395	400	405	410
Power Output Tolerance-P _{max} (W)	0 ~ +5				
Maximum Power Voltage-V _{mp} (V)	40.2	40.5	40.8	41.1	41.4
Maximum Power Current-I _{mp} (A)	9.71	9.76	9.81	9.86	9.91
Open Circuit Voltage-V _{oc} (V)	48.5	48.7	48.9	49.1	49.3
Short Circuit Current-I _{sc} (A)	10.25	10.29	10.33	10.37	10.41
Module Efficiency η _m (%)	19.2	19.5	19.7	20.0	20.2

STC Irradiance 1000W/m², Cell Temperature 25°C, Air Mass AM1.5
Measuring tolerance: ± 0.5%

ELECTRICAL DATA (NMOT)

Maximum Power-P _{max} (Wp)	295	299	302	306	310
Maximum Power Voltage-V _{mp} (V)	37.7	38.0	38.3	38.6	38.9
Maximum Power Current-I _{mp} (A)	7.82	7.86	7.90	7.93	7.97
Open Circuit Voltage-V _{oc} (V)	45.7	45.9	46.1	46.3	46.5
Short Circuit Current-I _{sc} (A)	8.26	8.29	8.33	8.36	8.39

NMOT Irradiance at 800W/m², Ambient Temperature 20°C, Wind Speed 1m/s

Electrical characteristics with different rear side power gains (referenced specifically to 405 Wp front)**

Maximum Power-P _{max} (Wp)	425	446	466	486	506
Maximum Power Voltage-V _{mp} (V)	41.1	41.1	41.1	41.1	41.1
Maximum Power Current-I _{mp} (A)	10.35	10.85	11.34	11.83	12.33
Open Circuit Voltage-V _{oc} (V)	49.2	49.3	49.4	49.5	49.6
Short Circuit Current-I _{sc} (A)	10.89	11.41	11.93	12.44	12.96
Pmax gain	5%	10%	15%	20%	25%

Power Bifaciality: 70±5%

MECHANICAL DATA

Solar Cells	Monocrystalline
Cell Orientation	144 cells (6 × 24)
Module Dimensions	2024 × 1002 × 30 mm (79.69 × 39.45 × 1.18 inches)
Weight	26.0 kg (57.3 lb)
Front Glass	2.0 mm (0.08 inches), High Transmission, AR Coated Heat Strengthened Glass
Encapsulant material	POE/EVA
Back Glass	2.0 mm (0.08 inches), Heat Strengthened Glass (White Grid Glass)
Frame	30mm (1.18 inches) Anodized Aluminium Alloy
J-Box	IP 68 rated
Cables	Photovoltaic Technology Cable 4.0 mm ² (0.006 inches ²) Portrait: 280/280 mm (11.03/11.02 inches) Landscape: 1500/1300 mm (74.80/74.80 inches)
Connector	Trina TS4

TEMPERATURE RATINGS

NMOT (Nominal Module Operating Temperature)	41°C (±3°C)
Temperature Coefficient of P _{max}	-0.35%/°C
Temperature Coefficient of V _{oc}	-0.25%/°C
Temperature Coefficient of I _{sc}	0.04%/°C

(Do not connect Fuse in Combiner Box with two or more strings in parallel connection)

WARRANTY

10 year Product Workmanship Warranty	PACKAGING CONFIGURATION
30 year Power Warranty	Modules per box: 35 pieces
	Modules per 40' container: 770 pieces

(Please refer to product warranty for details)

** Back-side power gain varies depending upon the specific project albedo

CAUTION: READ SAFETY AND INSTALLATION INSTRUCTIONS BEFORE USING THE PRODUCT.
© 2019 Trina Solar Limited. All rights reserved. Specifications included in this datasheet are subject to change without notice.
Version number: TSM_DEG15MC20_EN_2020_A www.trinasolar.com

RECORD DRAWING


FastGrid			FastGrid, LLC 225 E Germann Road Suite 301 Gilbert, AZ 85297		
REV	DESCRIPTION	DATE			
4	RECORD DRAWINGS	06/08/2023			
PROJECT NAME: EAGLE SHADOW MOUNTAIN PV SOLAR POWER GENERATION FACILITY					
PROJECT ADDRESS: I-15 CRYSTAL, NV CLARK COUNTY					
SEAL:		DATE: 10/16/2020			
		PROJECT #: 190067.03			
		DRAWN BY: CLH			
		CHECKED BY: EL			
SHEET NAME: EQUIP SPECS - MODULES					
SHEET #:		E-905		REV #: 4	

SAVED BY: chad.hightland

LOCATION: K:_09_PROJECTS\190067.03 - PRIMORS - EAGLE SHADOW MOUNTAIN\ENGINEERING\DWG-EQUIP SPECS - MODULES

PLOT BY: Brady Bugeson
PLOT DATE: Thursday, June 08, 2023


FOR REFERENCE ONLY

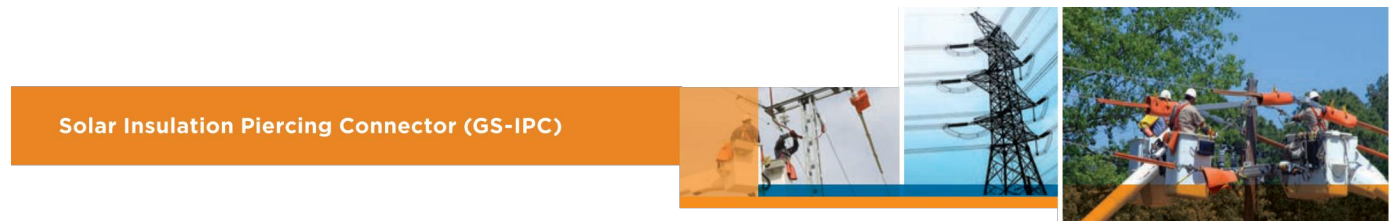

Solar Insulation Piercing Connector (GS-IPC)

TAPPING CONNECTOR FOR MID-SPAN APPLICATION


Description	Part Number	Application Range Main Side	Application Range Tap Side	Max Current Load	Weight
GS-IPC-4U	2182993-1	#8 to #4 AWG	#12 to #10 AWG	63 Amps	0.5 lbs
GS-IPC-500U	2182994-1	350 and 500 kcmil	#10 to #6 AWG	168 Amps	1.15 lbs

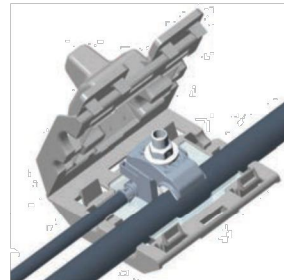

GS-IPC-500U

DEAD-END CONNECTOR FOR END SEAL APPLICATION

Description	Part Number	Application Range Main Side	Application Range Tap Side	Max Current Load	Weight
GS-IPC-4U-ES	2182993-2	#8 to #4 AWG	#12 to #10 AWG	63 Amps	0.6 lbs
GS-IPC-500U-ES	2182994-2	350 and 500 kcmil	#10 to #6 AWG	168 Amps	1.3 lbs

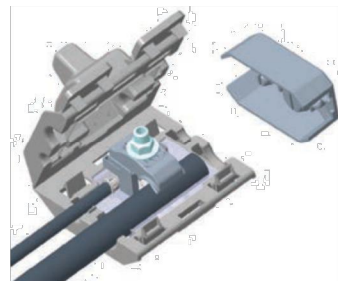


GS-IPC-500U-ES



te.com/energy
© 2020 TE Connectivity. All Rights Reserved. EPP-CP-005-0037-GS-IPC-04/20-EN

FOR MORE INFORMATION:
TE Technical Support Centers

USA: +1 800 327 6996
Brazil: +55 11-2703-6023
Mexico: +52 55-706-0800
South America: +57 1-319-8962
BeneLux: +32 16-508-6935
France: +33 (0) 38-658-3230
Germany/Switzerland: +49 (0) 89-408-9903
Italy: +39 335-854-3453
Middle East/Africa: +971 4-217-7020
Russia: +7 495-790-790-2-200
Spain/Portugal: +34 912-681-885
UK: +44 18078-707-500
China: +86 400-820-6015

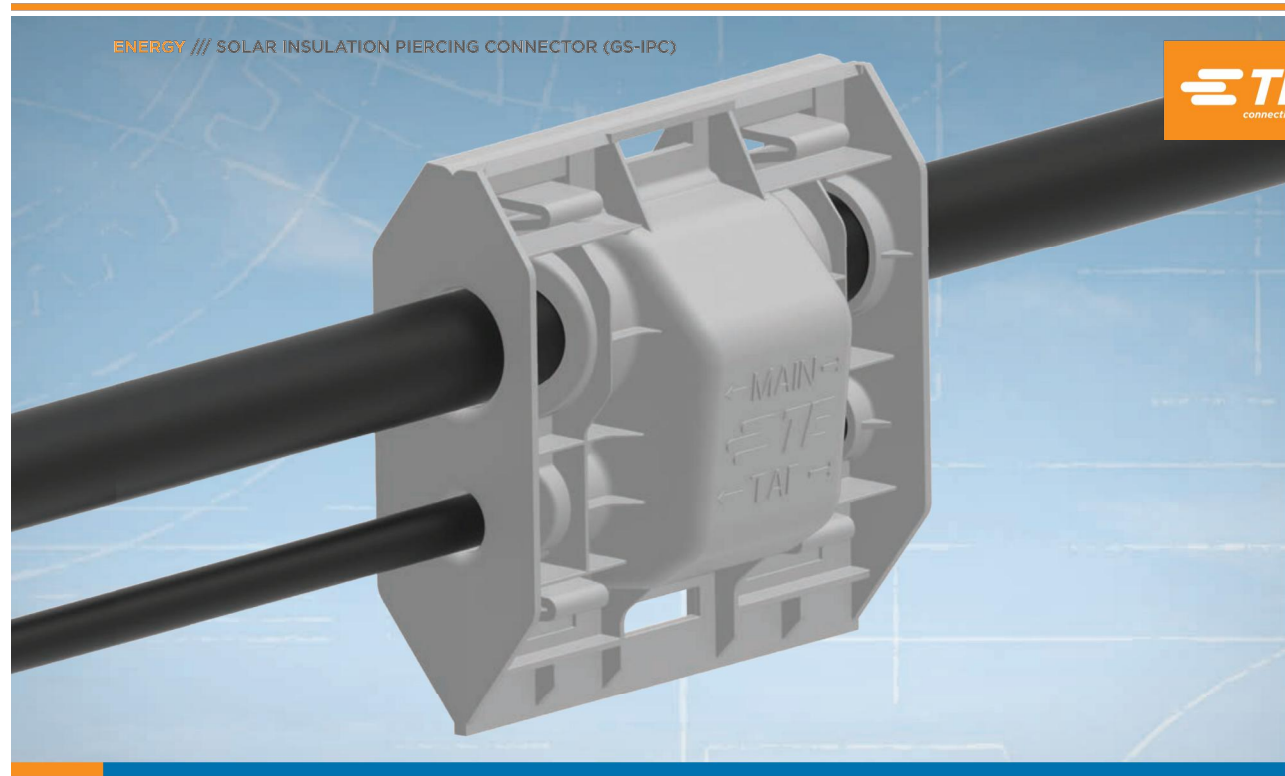

SOLAR INSULATION PIERCING CONNECTOR
WITH POWERGEL-FILLED COVER FOR PV CABLES UP TO 1.5 kV DC

KEY FEATURES

- cUL certified product
- Extremely low leakage current
- Suitable for outdoor and direct buried applications
- No insulation cutback required
- One-piece connector block with shear bolt technology, halogen-free, and UV-resistant
- Flame retardant - V0 classification
- Use as a tap connector on a mid-span or on a dead-end application
- Adjusts to connection spacing on site with convenient flexibility

TE Connectivity's (TE) Solar Insulation Piercing Connector with a Powergel-filled cover (GS-IPC) offers protection, insulation and high quality sealing for fast, easy and safe cable connections of PV cables ranging from #10 to 500 Kcmil. Size transitions or transitions from copper to aluminum are also possible. Suitable for direct buried and overhead applications.

The GS-IPC enclosure, with its revolutionary Powergel sealant, protects and seals the connection quickly and easily, saving both time and effort. Our Powergel sealant is rated to 90°C continuous temperature and is halogen-free with an extended shelf life.


No insulation cutback is required thanks to the insulation piercing technology (IPC). Shear bolts always guarantee the optimum contact force without the use of a torque wrench or other special tools.

The housing is UV-stable and impact-resistant, and comes with a robust hinge and latching mechanism which help to protect against humidity and water.

These connectors have been successfully tested to UL 486A-486B, CSA C22.2 No. 65-03 and applicable UL6703 tests as listed by Underwriters Laboratories Inc., File No. E13288.

Customers can count on consistent, high quality products, driven by TE's proven innovation and backed by our extraordinary customer support.

ENERGY /// SOLAR INSULATION PIERCING CONNECTOR (GS-IPC)

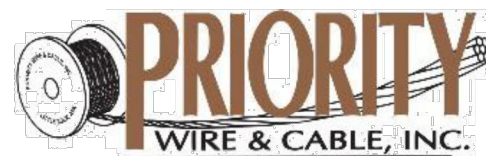

Section 1200
PV Wire

Spec# 1200-01
Revised: 08/26/2019
Sales Specification

ALUMINUM PV PHOTOVOLTAIC CABLE 1000V/2000V (UL)
Cross-Linked Polyethylene Insulated

Applications: For use in interconnection wiring of grounded and ungrounded photovoltaic power systems.

Construction: Compact or compressed round stranded 8000 series aluminum alloy RHH/RHW-2 conductors, per ASTM B800, B836, & B901. Black cross-linked polyethylene (XLPE) insulation. Designed to operate not over 2000V.

Industry Listings & Standards:

UL Listed PV Wire under UL44, UL1581 and UL4703 Photovoltaic Wires
-40°C to 90°C Wet or Dry
VW-1 rated per UL1581
Sunlight Resistant
Direct Burial**

AL PV Cable 1KV/2KV							
Part Number	Size	Strand	Min. Avg. Insulation Thickness	Nominal O.D.	Allowable Ampacity*	Approximate Weight	DC Resistance @20°C
	AWG		(mils)	(mils)	90°C	lbs/ft	Ω/ft
8-01ALPV-2KV	8	7	85	312	45	47	1.0500
6-01ALPV-2KV	6	7	85	339	55	56	0.6610
4-01ALPV-2KV	4	7	85	383	75	76	0.4160
2-01ALPV-2KV	2	7	85	438	100	107	0.2620
1-01ALPV-2KV	1	18	105	509	115	143	0.2060
1/0-01ALPV-2KV	1/0	18	105	546	135	171	0.1650
2/0-01ALPV-2KV	2/0	18	105	586	150	203	0.1310
3/0-01ALPV-2KV	3/0	18	105	633	175	245	0.1030
4/0-01ALPV-2KV	4/0	18	105	685	205	295	0.0821
250-01ALPV-2KV	250	35	120	760	230	353	0.0695
300-01ALPV-2KV	300	35	120	810	260	411	0.0579
350-01ALPV-2KV	350	35	120	856	280	467	0.0496
400-01ALPV-2KV	400	35	120	899	305	525	0.0434
500-01ALPV-2KV	500	35	120	976	350	622	0.0348
600-01ALPV-2KV	600	58	135	1083	385	758	0.0290
700-01ALPV-2KV	700	58	135	1147	425	836	0.0248
750-01ALPV-2KV	750	58	135	1178	435	813	0.0232
900-01ALPV-2KV	900	58	135	1269	480	1062	0.0193
1000-01ALPV-2KV	1000	58	135	1330	500	1180	0.0174
1250-01ALPV-2KV	1250	58	155	1505	545	1458	0.0142

Note: * Allowable Ampacities shown are for general use as specified by the National Electric Code, 2017 Edition, Section 310-15(B)(16). Based on ambient temperature of 30°C. **DIR BUR to be marked on 6AWG and larger.

Cable Marking: PRIORITY WIRE <AWG or KCMIL(mm2)> PV WIRE (UL) E340884 AL AA-8000 COMPACT STRAND XLPE RHH RHW-2 1KV/2KV 90°C -40°C SUN RES DIR BUR VW-1<YEAR> <SEQ FT> <Factory ID>

Red and Black Jacket

1-800-945-5542

© Priority Wire & Cable, Little Rock, AR PWC-August 26, 2019

A Viakable Company

TITLE:
AL CPR, TR-XLPE 35 kV 100% I.L., C.N, XLPE JACKET 3ERS

DRAWN BY:
O.R.G

APPROVED BY:
W.R.M

DRAWING No.:
(371) UD / MV-105

SPECIFICATION / STANDARD
UL 1072

REV:
1

1.- COMPRESSED ALUMINUM CONDUCTOR, CLASS B.
2.- SEMICONDUCTING TAPE (ONLY FOR 1250 KCMIL CONDUCTOR).
3.- EXTRUDED CONDUCTOR SHIELD.
4.- EXTRUDED INSULATION SHIELD.
5.- CONCENTRIC NEUTRAL COPPER CONDUCTOR.
6.- XLPE JACKET WITH THREE EXTRUDED RED STRIPES.

MARKING:
CME WIRE AND CABLE E102545 (UL) _____ AWG/kcmil AL 345.0 MILS TRXLP 35 KV 100% INSUL. LEVEL TYPE MV-105 _DATE_ (SEQUENTIAL MARKING IN FEET)

SIZE AWG/kcmil	No. STRANDS	CONDUCTOR DIAMETER (mils)	INSULATION THICKNESS (mils)	DIAMETER OVER INSULATION (mils)	CONCENTRIC NEUTRAL WIRE	JACKET THICKNESS (mils)	OVERALL DIAMETER APPROX. (mils)	TOTAL WEIGHT APPROX LBS/MFT
4/0	19	512	345	1254	13W16AWG (1/3NE)	50	1550	995
500	37	789	345	1541	18W14AWG (1/3NE)	80	1957	1768
750	61	968	345	1730	17W12AWG (1/3NE)	80	2180	2265
1250	91	1251	345	2059	18W10AWG (1/3NE)	80	2541	3310

NOTE:
THE ABOVE DATA ARE APPROXIMATE AND SUBJECT TO NORMAL MANUFACTURING TOLERANCES.

FastGrid, LLC
225 E Germann Road
Suite 301
Gilbert, AZ 85297

REV	DESCRIPTION	DATE
	RECORD DRAWINGS	06/08/2023

PROJECT NAME:
**EAGLE SHADOW MOUNTAIN
PV SOLAR POWER
GENERATION FACILITY**

PROJECT ADDRESS:
**I-15
CRYSTAL, NV
CLARK COUNTY**

SEAL:

DATE:
10/16/2020

PROJECT #:
190067.03

DRAWN BY:
LR

CHECKED BY:
EL

SHEET NAME:
EQUIP SPECS - CABLING

SHEET #:
E-907

REV #:
-

AS BUILT




PLOT DATE: Thursday, June 08, 2023

PLOT BY: Brady Burgesson




SAVED BY: Leon Reese

LOCATION: K:_09 PROJECTS\190067.03 - PRIMORS - EAGLE SHADOW MOUNTAIN PV SOLAR POWER GENERATION FACILITY - CABLING



FOR REFERENCE ONLY

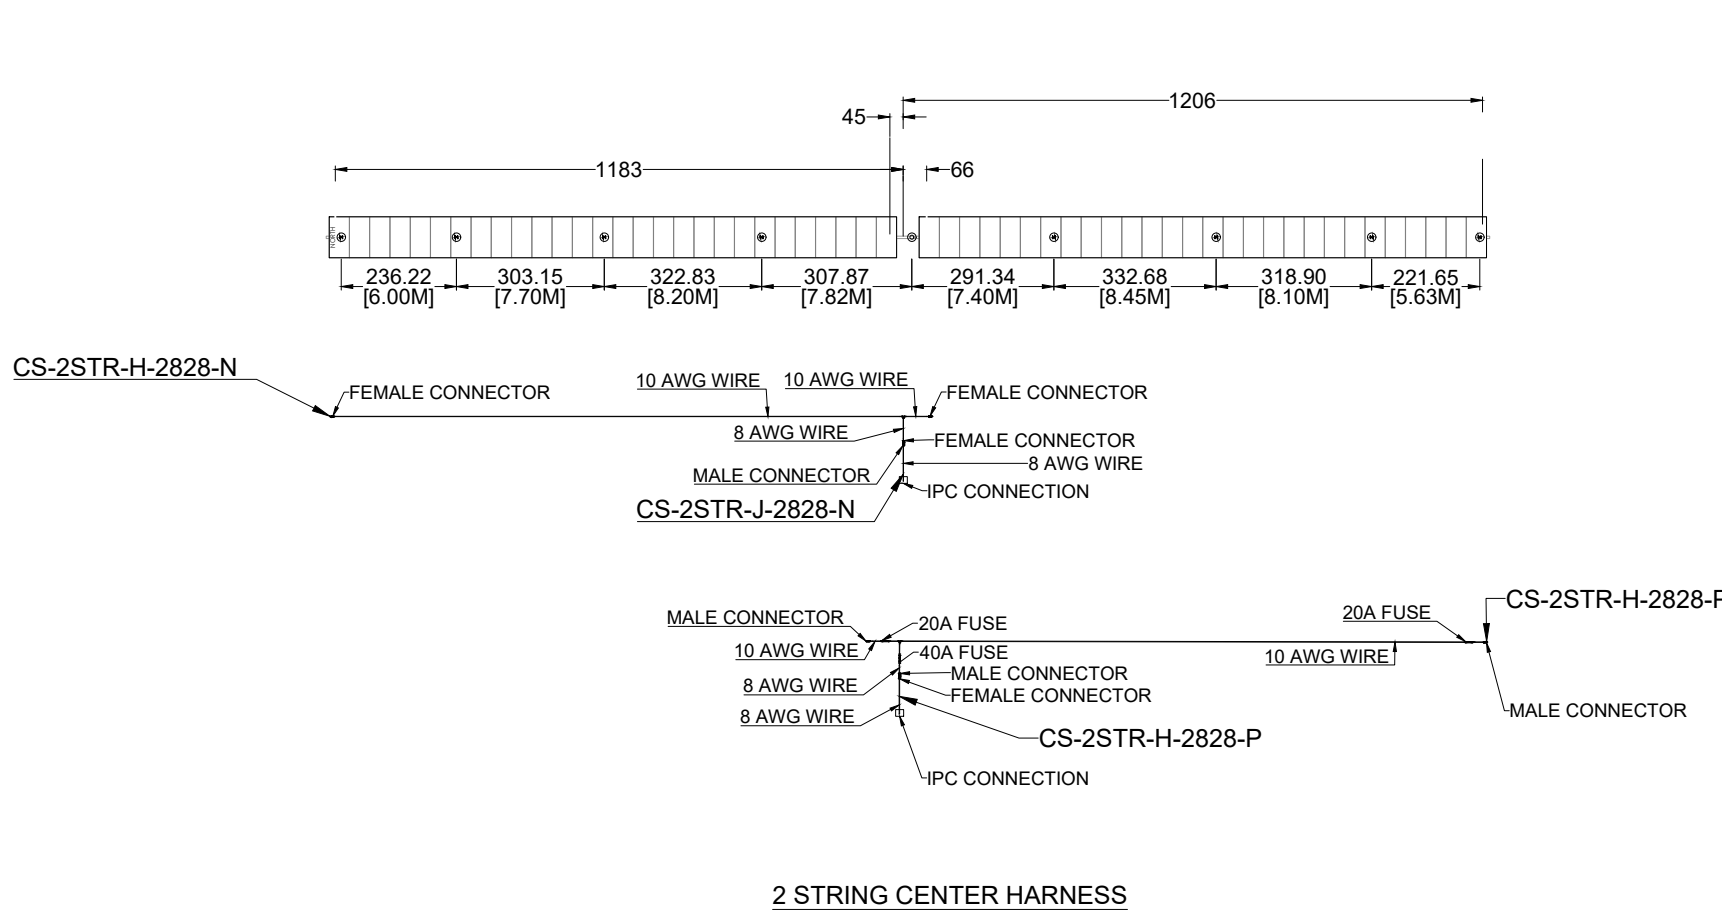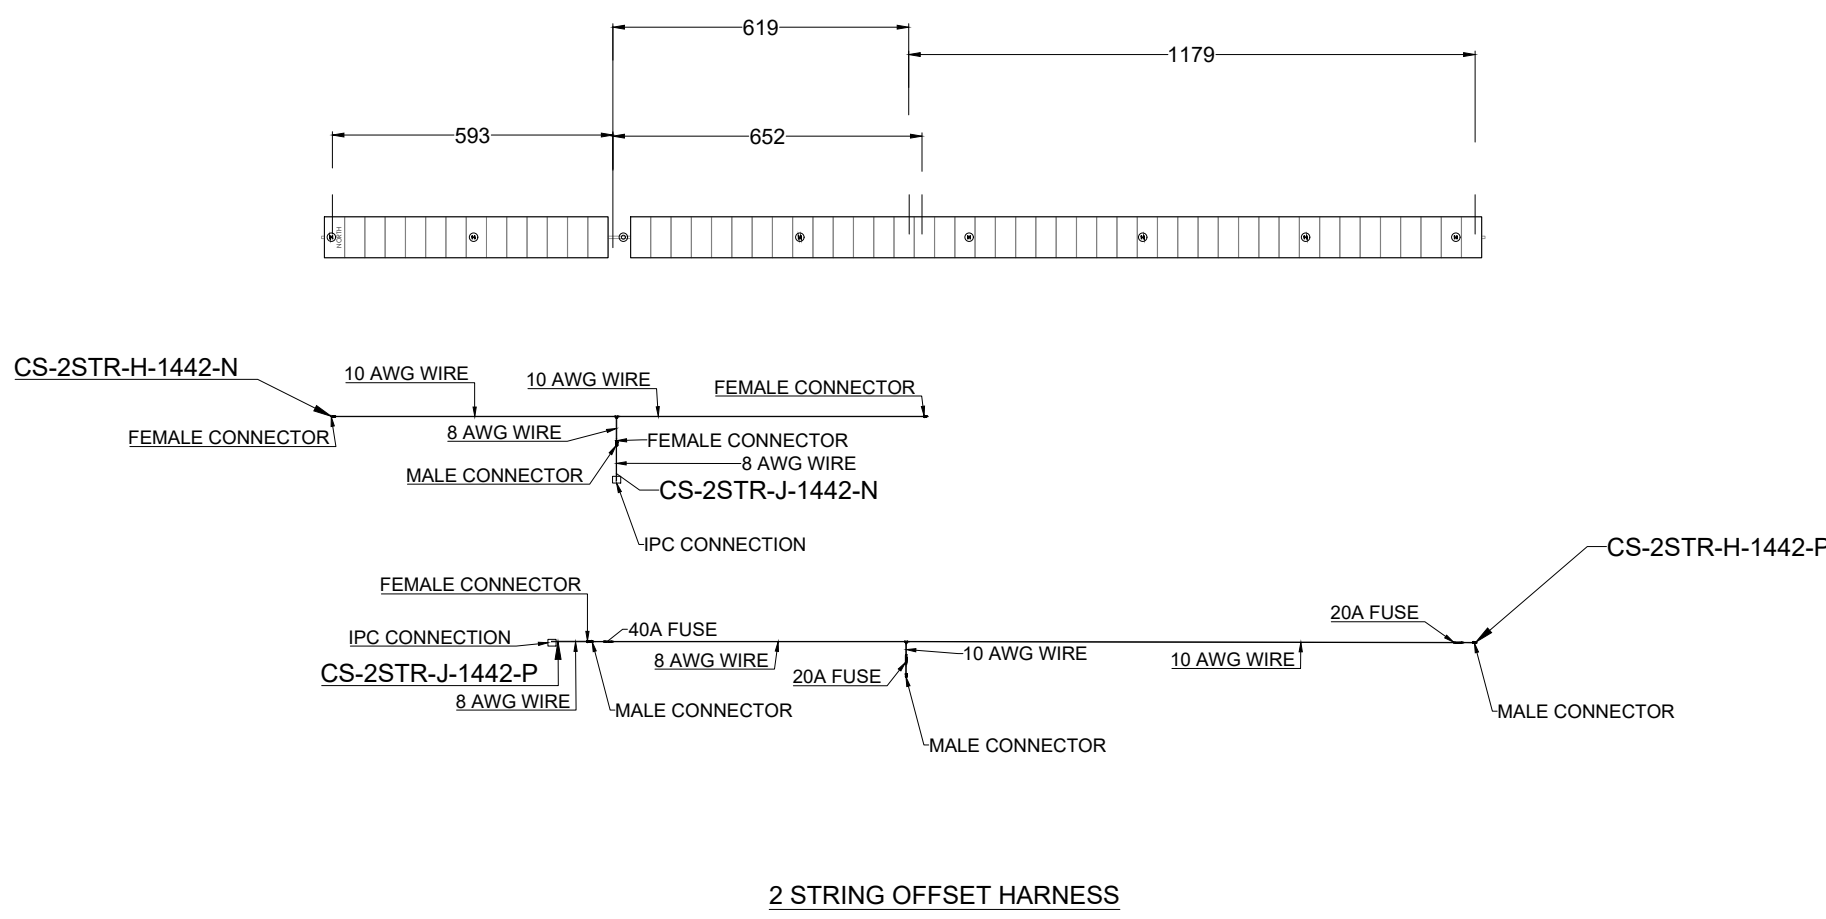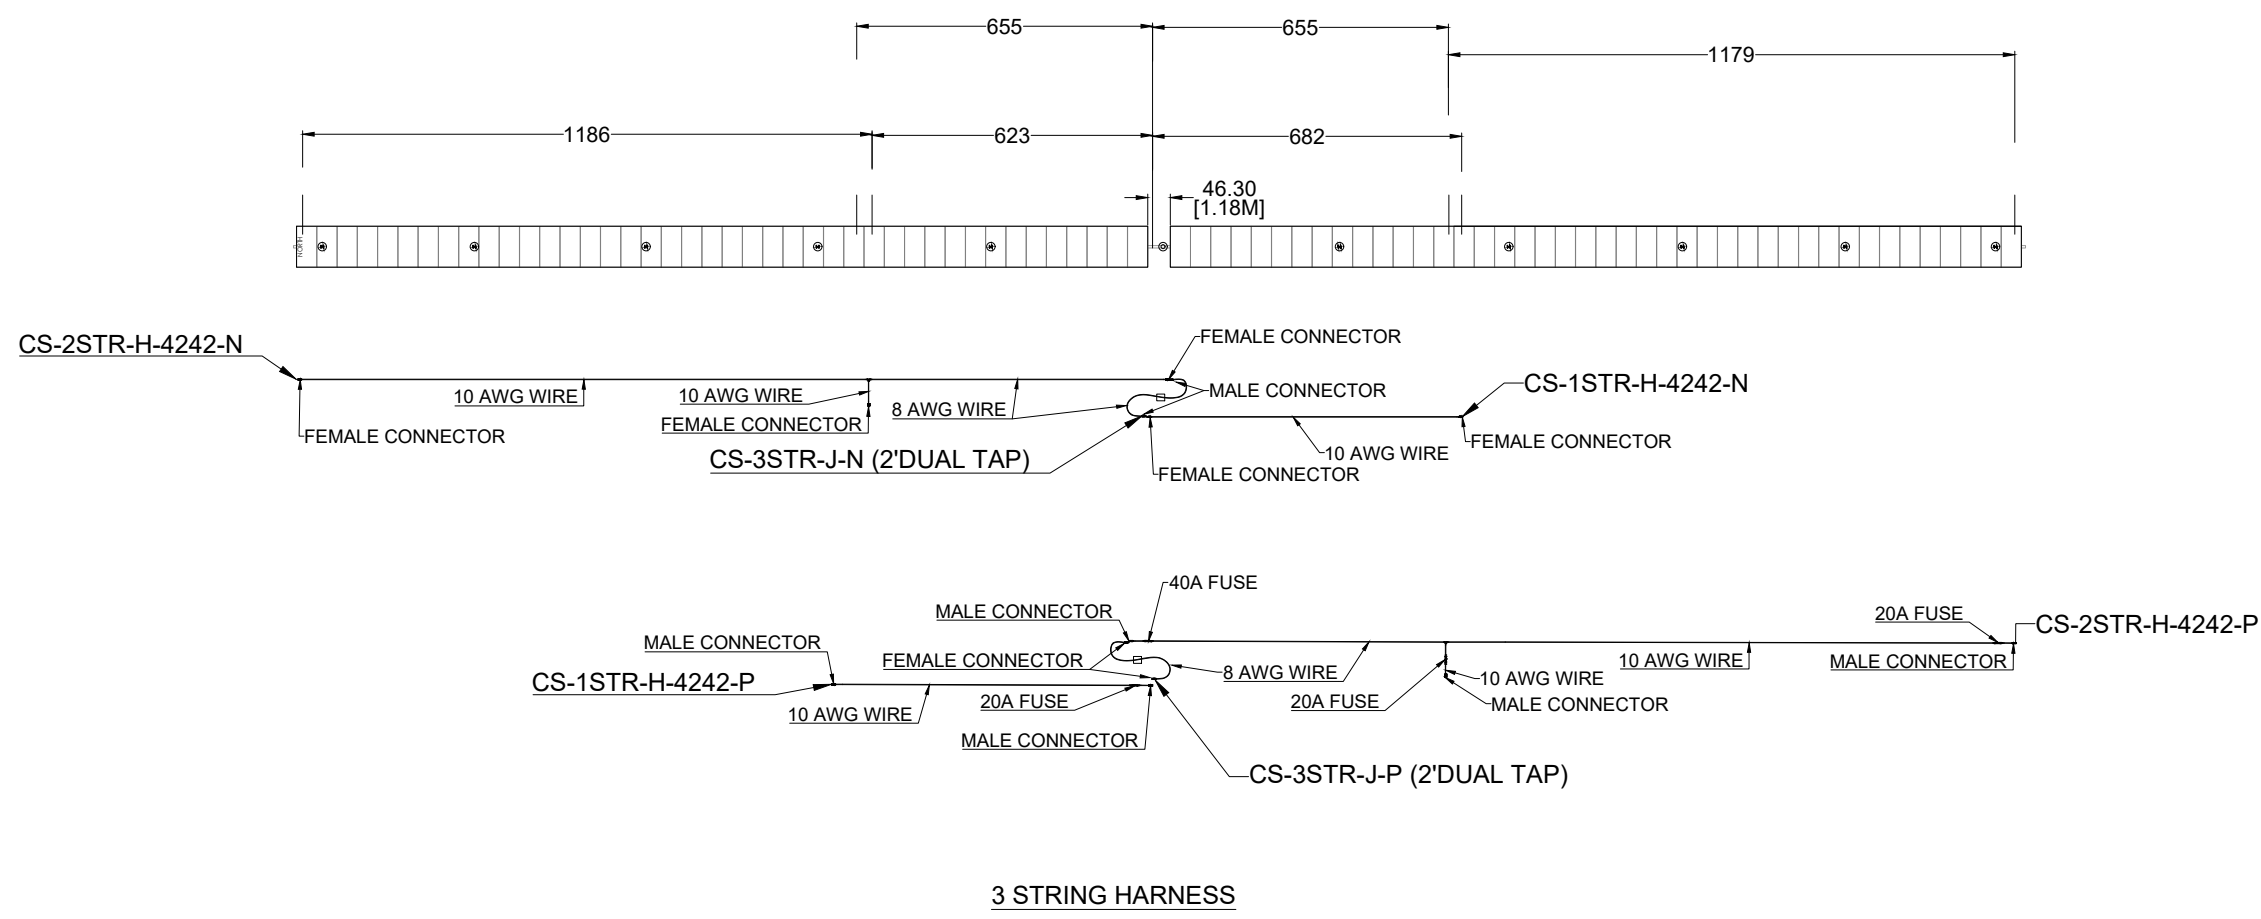

1 CANADIAN SOLAR HARNESS LAYOUTS
SCALE: N.T.S.

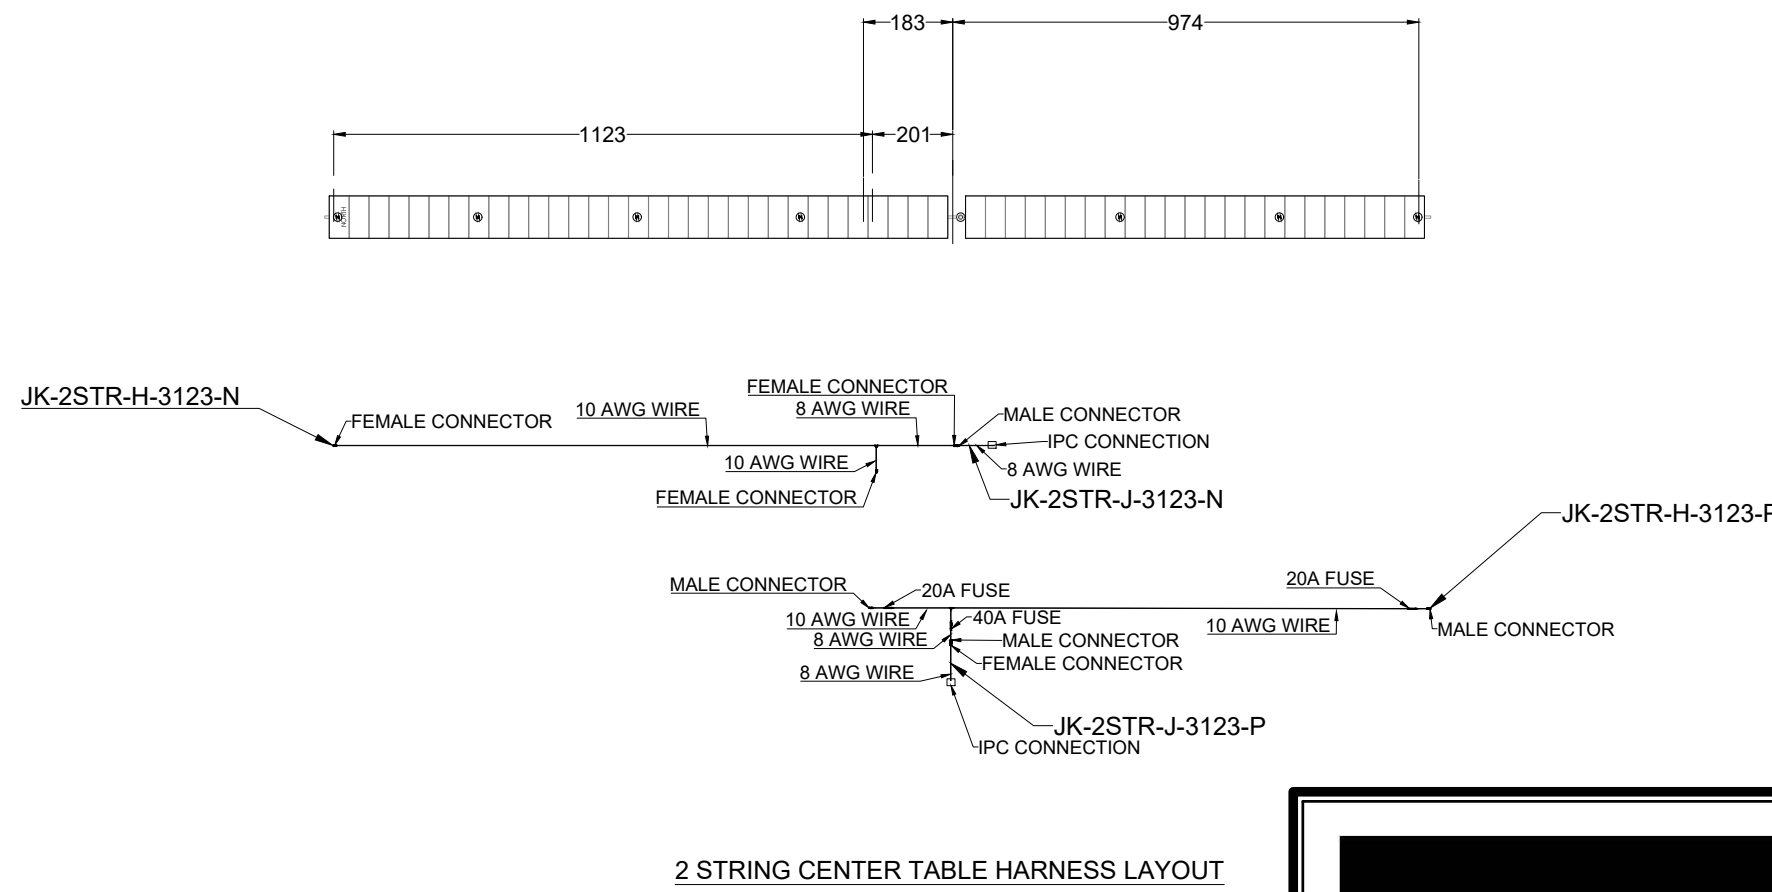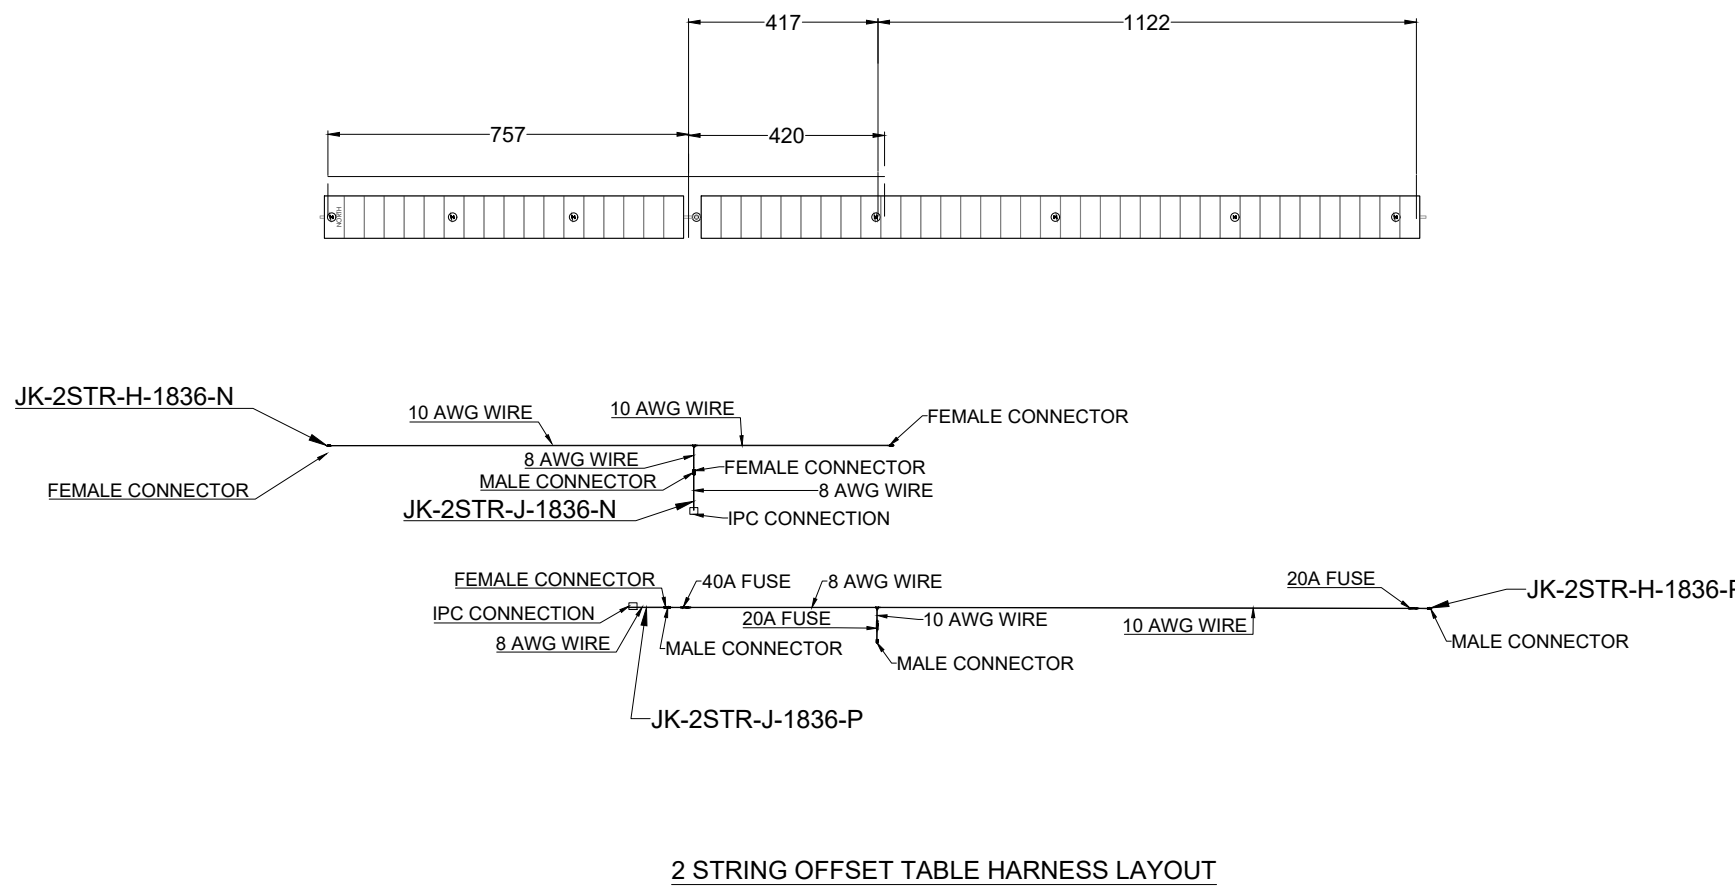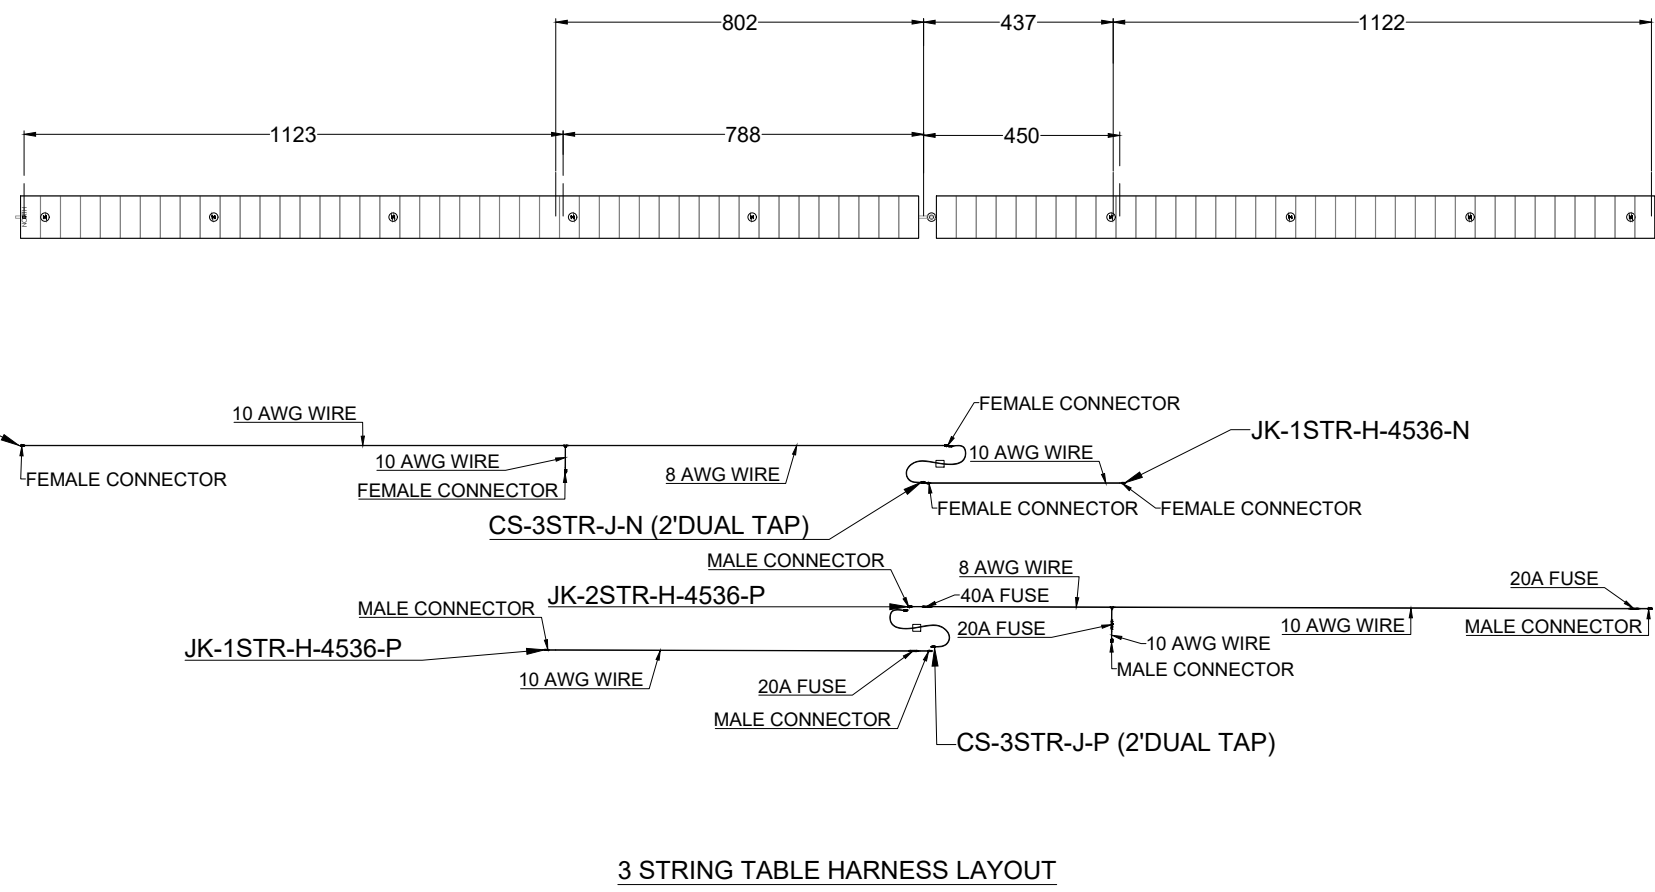

2 JINKO HARNESS LAYOUTS
SCALE: N.T.S.

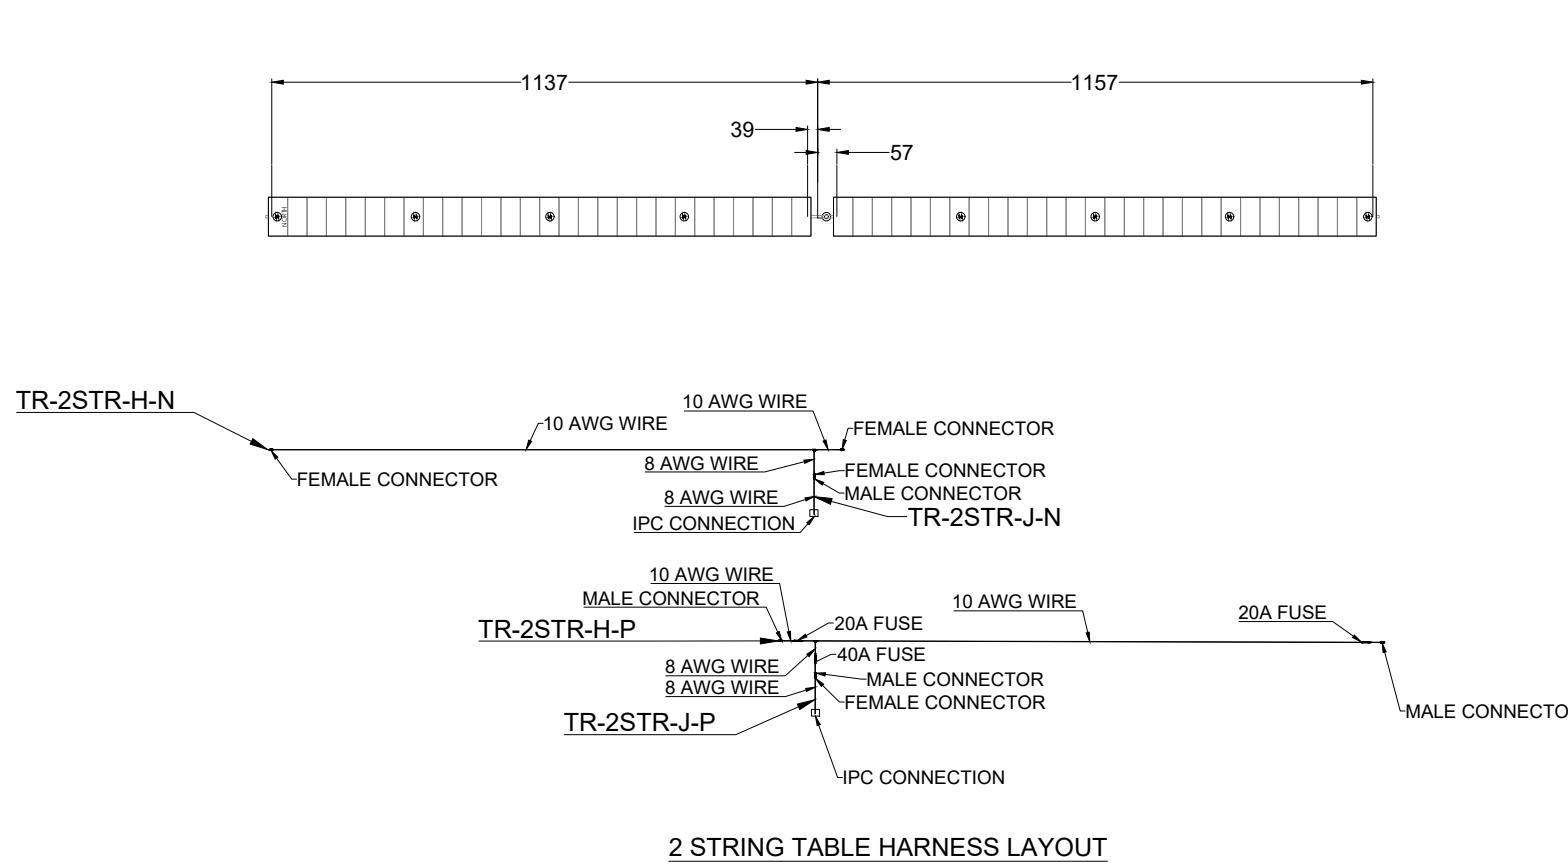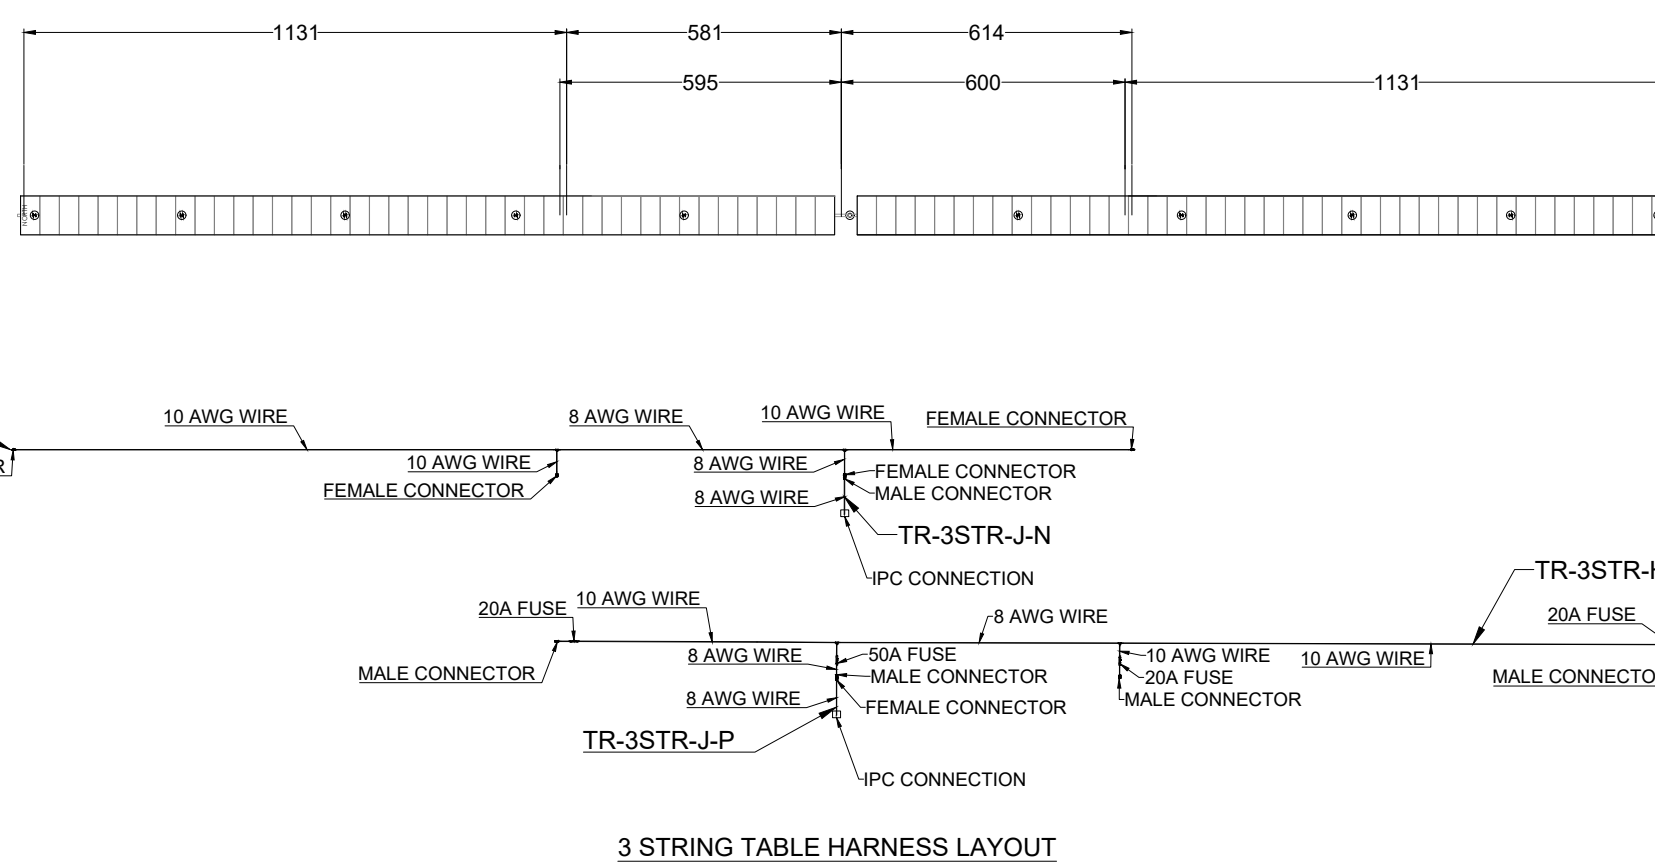

GENERAL NOTES:

- A. ALL CONNECTORS SHALL MATCH THE MODULE CONNECTORS EXACTLY. THE USE OF 'MC4 COMPATIBLE' OR 'MC4 COMPARABLE' CONNECTORS INS NOT ALLOWED ABSENT A UL REPORT AND MODULE MANUFACTURER LETTER INDICATING THEYARE ACCEPTABLE TO USE.
- B. REFER TO SHOP DRAWING DETAILS FOR ADDITIONAL INFORMATION FOR EACH HARNESS. LAYOUTS SHOWN HERE ARE IN COORDINATION WITH TE CONNECTIVITY.
- C. ALL HARNESS EQUIPMENT SHALL BE UL LISTED FOR 1500VDC. ALL CONDUCTORS SHALL BE COPPER, 2KV PV-WIRE.

3 TRINA HARNESS LAYOUTS
SCALE: N.T.S.

FastGrid

FastGrid, LLC
225 E Germann Road
Suite 301
Gilbert, AZ 85297

REV	DESCRIPTION	DATE
4	RECORD DRAWINGS	06/08/2023

PROJECT NAME:

EAGLE SHADOW MOUNTAIN
PV SOLAR POWER
GENERATION FACILITY

PROJECT ADDRESS:

I-15
CRYSTAL, NV
CLARK COUNTY

SEAL:

DATE:
10/16/2020
PROJECT #:
190067.03
DRAWN BY:
LR
CHECKED BY:
EL

SHEET NAME:

EQUIP SPECS - DC HARNESS

SHEET #:

E-908

REV #:

4

AS BUILT

FOR REFERENCE ONLY

ALTOS Lite(TM) Loose Tube, Gel-Free, Single-Jacket, Single-Armored Cable, 24 fiber, Single-mode (OS2), max. attenuation 0.35 dB/km Part #: 024EUC-T4100D20



ALTOS® Lite Loose Tube, Gel-Free, Single-Jacket, Single-Armored Cable 24 F, Single-mode (OS2)

CORNING

Part Number:
024EUC-T4100D20

Corning ALTOS® Lite gel-free, single-jacket, single-armored cables are designed for campus backbones in direct-buried installations. The loose tube design provides stable and highly reliable transmission parameters for a variety of voice, data, video and imaging applications. These cables also provide high-fiber density within a given cable diameter while allowing flexibility to suit many system configurations.

The single armored construction provides additional crush and rodent protection with a high-strength ripcord under the armor for easy stripping. Gel-free means the cables are fully waterblocked using craft-friendly, water-swellaable materials which make cable access simple and require no clean up. The flexible, craft-friendly buffer tubes are easy to route in closures, and the SZ-stranded, loose tube design isolates fibers from installation and environmental rigors while allowing easy mid-span access. These cables have a medium density polyethylene jacket that is rugged, durable and easy to strip.

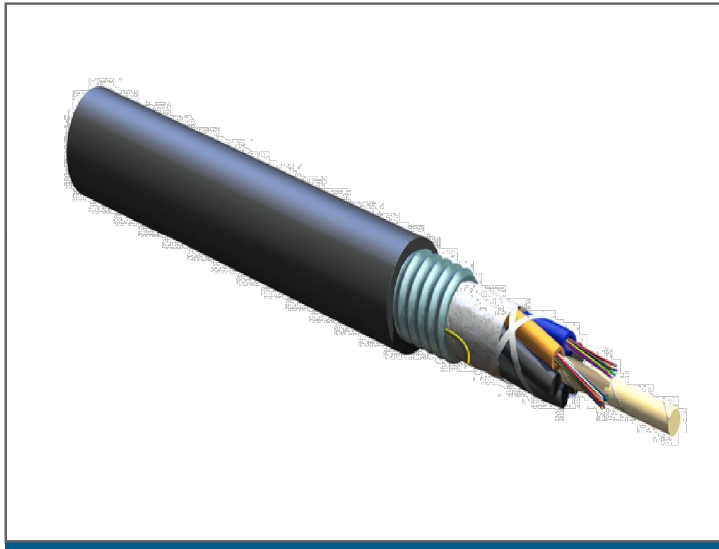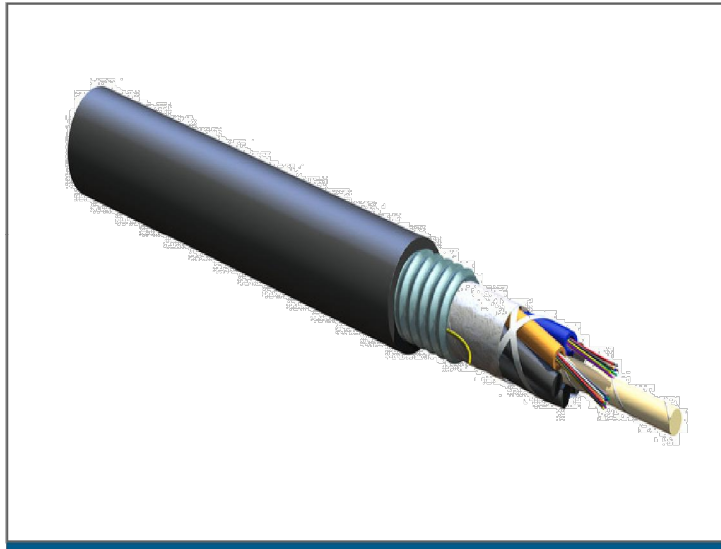

ALTOS® Lite Loose Tube, Gel-Free, Single-Jacket, Single-Armored Cable 24 F, Single-mode (OS2)

CORNING

Specifications

Mechanical Specifications	
Max. Tensile Strength, Long-Term	890 N
Max. Tensile Strength, Short-Term	2700 N
Min. Bend Radius Installation	182 mm
Min. Bend Radius Operation	121 mm
Nominal Outer Diameter	12.1 mm

Cable Design	
Central Element	Dielectric
Fiber Count	24
Buffer Tube Color Coding	Blue, Orange
Number of Ripcords	2
Outer Jacket Color	Black
Outer Jacket Material	Polyethylene (PE)
Tensile Strength Elements and/or Armoring - Layer 1	Corrugated steel tape armor
Buffer Tube Color	Blue, Orange
Buffer Tube Diameter	2.5 mm
Number of Active Tubes	2
Number of Filling Elements	4
Number of Tube Positions	6
Tape	Water-swellaable
Fiber Coloring	Blue, Orange, Green, Brown, Slate, White, Red, Black, Yellow, Violet, Rose, Aqua
Fibers per Tube	12

Environmental Conditions	
Temperature Range, Installation	-30 °C to 70 °C (-22 °F to 158 °F)

ALTOS® Lite Loose Tube, Gel-Free, Single-Jacket, Single-Armored Cable 24 F, Single-mode (OS2)

CORNING

Environmental Conditions	
Temperature Range, Storage	-40 °C to 70 °C (-40 °F to 158 °F)
Temperature Range, Operation	-40 °C to 70 °C (-40 °F to 158 °F)

General Specifications	
Environment	Outdoor
Cable Type	Loose Tube
Product Type	Armored
Fiber Category	Single-mode (OS2)
Application	Aerial , Direct Buried , Duct

Ordering Information	
Weight	129 kg/km

Standards	
RoHS	Free of hazardous substances according to RoHS 2011/65/EU
Common Installations	Outdoor lashed aerial, duct and direct-buried, indoor when installed according to National Electrical Code® (NEC®) Article 770
Design and Test Criteria	ANSI/ICEA S-87-640



Corning Optical Communications LLC • 4200 Corning Place • Charlotte, NC • 28216 • United States
800-743-2675 • FAX: 828-325-5060 • International: +1-828-901-5000 • www.corning.com/opcomm

A complete listing of the trademarks of Corning Optical Communications is available at www.corning.com/opcomm/emea/trademarks. Corning Optical Communications is ISO 9001 and ISO 14001 certified. © 2020 Corning Optical Communications. All rights reserved.

FastGrid

FastGrid, LLC

225 E Germann Road

Suite 301

Gilbert, AZ 85297

REV	DESCRIPTION	DATE
	RECORD DRAWINGS	06/08/2023

PROJECT NAME:

EAGLE SHADOW MOUNTAIN
PV SOLAR POWER
GENERATION FACILITY

PROJECT ADDRESS:

I-15
CRYSTAL, NV
CLARK COUNTY

SEAL:

DATE:
10/16/2020

PROJECT #:
190067.03

DRAWN BY:
LR

CHECKED BY:
EL

SHEET NAME:

EQUIP SPECS - FIBER OPTIC

SHEET #:

E-909

REV #:

-

AS BUILT